



Elizabeth Comfort
Finance Director

Department of Finance

Public Services Building
2051 Kaen Road, Suite 490 | Oregon City, OR 97045

April 3, 2025

BCC Agenda Date/Item: _____

Board of County Commissioners
Clackamas County

Approval of a Public Improvement Contract with Fabulous Floors for flooring at the Lake Road Health Center.
Contract Value is \$225,572 for 2 months. Funding is through health center charges and fees.
No County General Funds are involved.

Previous Board Action/Review	N/A		
Performance Clackamas	Build (maintain) a strong infrastructure. Ensure a safe, healthy and secure communities.		
Counsel Review	Yes	Procurement Review	Yes
Contact Person	Loren Frigault	Contact Phone	971-401-1104

EXECUTIVE SUMMARY: The aim of this project is to build a facility that supports H3S and provides an accessible and safe space where the public can receive a variety of outpatient counseling and treatment services for both mental health and substance use needs. Currently, the Lake Road Health Center is undergoing a significant remodel to accommodate these demands. The interior walls of the building have recently been drywalled and new flooring will be an essential addition to complete the revitalization of the center once the walls have been painted.

RECOMMENDATION: Staff respectfully recommends that the Board approve and sign this contract with Fabulous Flooring, LLC for the Flooring and Vinyl Base at the Lake Road Health Center Construction Project.

Respectfully submitted,

Elizabeth Comfort

Elizabeth Comfort
Director Finance

For Filing Use Only



CLACKAMAS COUNTY
PUBLIC IMPROVEMENT CONTRACT
Contract #1178

This Public Improvement Contract (the "Contract"), is made by and between the Clackamas County, a political subdivision of the State of Oregon ("Owner"), and **Fabulous Floors, LLC** (the "Contractor"), both collectively the "Parties". This Contract shall become effective on the date this Contract has been signed by all the Parties and shall expire upon completion the completion of all obligations under the terms of this Contract unless terminated earlier by the Parties.

All capitalized terms in this Contract shall have the meanings identified in the Clackamas County General Conditions for Public Improvement Contracts (10/13/2021) ("General Conditions") referenced within the Instructions to Bidders.

Project Name: **2024-105 Lake Road Health Center Flooring Project**

1. Contract Price, Contract Documents and Work.

The Contractor hereby agrees to perform all Work described in, and reasonably inferred from, the Contract Documents. In consideration of the Contractor performing the Work in accordance with the terms of the Contract, the Owner agrees to pay the Contractor the sum of **Two Hundred Twenty-Five Thousand Five Hundred Seventy-Two Dollars (\$225,572.00)** (the "Contract Price"). Payment will be made in accordance with the terms and conditions provided in the Contract Documents. The Contract Price is the amount contemplated by the Base Bid, as indicated in the accepted Bid.

The following documents are incorporated by reference in this Contract and made a part hereof:

- Notice of Contract Opportunity
- Supplemental Instructions to Bidders
- Bid Form
- Clackamas County General Conditions
- Prevailing Wage Rates
- Plans, Specifications and Drawings
- Instructions to Bidders
- Bid Bond
- Performance Bond and Payment Bond
- Supplemental General Conditions
- Payroll and Certified Statement Form

2. Representatives.

Contractor has named Lilly McNeill as its Authorized Representative to act on its behalf. Owner designates, or shall designate, its Authorized Representative as indicated below (check one):

Unless otherwise specified in the Contract Documents, the Owner designates Loren Frigault as its Authorized Representative in the administration of this Contract. The above-named individual shall be the initial point of contact for matters related to Contract performance, payment, authorization, and to carry out the responsibilities of the Owner.

Name of Owner's Authorized Representative shall be submitted by Owner in a separate writing.

3. Key Persons.

The Contractor's personnel identified below shall be considered Key Persons and shall not be replaced during the project without the written permission of Owner, which shall not be unreasonably withheld. If the Contractor intends to substitute personnel, a request must be given to Owner at least 30 days prior to the intended time of substitution. When replacements have been approved by Owner, the Contractor shall provide a transition period of at least 10 working days during which the original and replacement personnel shall be

working on the project concurrently. Once a replacement for any of these staff members is authorized, further replacement shall not occur without the written permission of Owner. The Contractor's project staff shall consist of the following personnel:

Project Executive: Lilly McNeill shall be the Contractor's project executive, and will provide oversight and guidance throughout the project term.

Project Manager: Mike Jensen shall be the Contractor's project manager and will participate in all meetings throughout the project term.

Job Superintendent: Lilly McNeill shall be the Contractor's on-site job superintendent throughout the project term.

4. Contract Dates.

The Contractor agrees to complete the Work in accordance with the following key dates:

COMMENCEMENT DATE: Upon Issuance of Notice to Proceed

SUBSTANTIAL COMPLETION DATE: May 15, 2025

FINAL COMPLETION DATE: May 30, 2025

Time is of the essence for this Contract. It is imperative that the Work in this Contract reach Substantial Completion and Final Completion by the above specified dates.

5. Reserved.

6. Insurance Certificates.

In accordance with Section G.3.5 of the General Conditions, Contractor shall furnish proof of the required insurance naming Clackamas County as an additional insured. Insurance certificates may be returned with the signed Contract or may be emailed to the County Contract Analyst.

7. Tax Compliance.

The Contractor shall comply with all federal, state and local laws, regulation, executive orders and ordinances applicable to this Contract. Contractor represents and warrants that it has complied, and will continue to comply throughout the duration of this Contract and any extensions, with all tax laws of this state or any political subdivision of this state, including but not limited to ORS 305.620 and ORS chapters 316, 317, and 318. Any violation of this section shall constitute a material breach of this Contract and shall entitle County to terminate this Contract, to pursue and recover any and all damages that arise from the breach and the termination of this Contract, and to pursue any or all of the remedies available under this Contract or applicable law.

8. Confidential Information.

Contractor acknowledges that it and its employees or agents may, in the course of performing their responsibilities under this Contract, be exposed to or acquire information that is confidential to Owner. Any and all information of any form obtained by Contractor or its employees or agents in the performance of this Contract shall be deemed confidential information of Owner ("Confidential Information"). Contractor agrees to hold Confidential Information in strict confidence, using at least the same degree of care that Contractor uses in maintaining the confidentiality of its own confidential information, and not to copy, reproduce, sell, assign, license, market, transfer or otherwise dispose of, give, or disclose Confidential Information to third parties or use Confidential Information for any purpose unless specifically authorized in writing under this Contract.

9. Counterparts.

This Contract may be executed in several counterparts, all of which when taken together shall constitute an agreement binding on all Parties, notwithstanding that all Parties are not signatories to the same counterpart. Each copy of the Contract so executed shall constitute an original.

10. Integration.

All provisions of state law required to be part of this Contract, whether listed in the General or Special Conditions or otherwise, are hereby integrated and adopted herein. Contractor acknowledges the obligations thereunder and that failure to comply with such terms is a material breach of this Contract.

The Contract Documents constitute the entire agreement between the parties. There are no other understandings, agreements or representations, oral or written, not specified herein regarding this Contract. Contractor, by the signature below of its authorized representative, hereby acknowledges that it has read this Contract, understands it, and agrees to be bound by its terms and conditions.

11. Compliance with Applicable Law. Contractor shall comply with all federal, state, county, and local laws, ordinances, and regulations applicable to the Work to be done under this Contract including, but not limited to, compliance with the prohibitions set forth in ORS 652.220, compliance of which is a material element of this Contract and failure to comply is a material breach that entitles County to exercise any rights and remedies available under this Contract including, but not limited to, termination for default.

12. Responsibility for Taxes. Contractor is solely responsible for payment of any federal, state, or local taxes required as a result of the Contract or the Work including, but not limited, to payment of the corporate activity tax imposed under enrolled HB 3427 (2019 Oregon regular legislative session). Contractor may not include its federal, state, or local tax obligations as part of the cost to perform the Work.

Signature Page Follows

In witness whereof, Owner executes this Contract and the Contractor does execute the same as of the day and year first above written.

Contractor DATA:

Fabulous Floors, LLC
20756 High Desert Ct.
Bend, Oregon 97701

Contractor CCB # 224424 Expiration Date: 2/14/2025

Oregon Business Registry # 1465419-90 Entity Type: FLLC

State of Formation: Delaware

Payment information will be reported to the IRS under the name and taxpayer ID# provided by the Contractor. Information must be provided prior to contract approval. Information not matching IRS records could subject Contractor to 28 percent backup withholding.

Fabulous Floors, LLC

Clackamas County

Michael Willis

2/26/2025

Authorized Signature

Date

Date

Michael Willis / President

Name / Title Printed

Recording Secretary

APPROVED AS TO FORM

Amanda Velt

County Counsel

3/12/2025

Date



CLACKAMAS COUNTY PUBLIC IMPROVEMENT CONTRACT OPPORTUNITY

Table of Contents

Section B-1	Notice of Public Improvement Contract Opportunity
Section B-2	Instructions to Bidders
Section B-3	Supplemental Instructions to Bidders
Section B-4	Bid Bond
Section B-5	Bid Form
Section B-6	Public Improvement Contract
Section B-7	Supplemental General Conditions
Section B-8	General Conditions
Section B-9	Performance Bond
Section B-10	Payment Bond
Section B-11	Project Information, Plans, Specifications and Drawings



CLACKAMAS COUNTY
NOTICE OF PUBLIC IMPROVEMENT CONTRACT OPPORTUNITY

INVITATION TO BID #2024-105
Lake Road Health Center Flooring Project
December 3, 2024

Clackamas County (“County”) through its Board of County Commissioners is accepting sealed bids for the **Lake Road Health Center Flooring Project** until **January 7, 2025, 2:00 PM**, Pacific Time, (“Bid Closing”) at the following location:

Bidding Documents can be downloaded from the state of Oregon procurement website (“OregonBuys”) at the following address: <https://oregonbuys.gov/bso/view/login/login.xhtml>, Document No.S-C01010-00012201.

Prospective Bidders will need to sign in to download the information and that information will be accumulated for a Plan Holder's List. Prospective Bidders are responsible for obtaining any Addenda from Website listed above.

Submitting Proposals: Bid Locker

Proposals will only be accepted electronically thru a secure online bid submission service, **Bid Locker**. *Email submissions to Clackamas County email addresses will no longer be accepted.*

- A. Completed proposal documents must arrive electronically via Bid Locker located at <https://bidlocker.us/a/clackamascounty/BidLocker>.
- B. Bid Locker will electronically document the date and time of all submissions. Completed documents must arrive by the deadline indicated in Section 1 or as modified by Addendum. **LATE PROPOSALS WILL NOT BE ACCEPTED.**
- C. Proposers must register and create a profile for their business with Bid Locker in order to submit for this project. It is free to register for Bid Locker.
- D. Proposers with further questions concerning Bid Locker may review the Vendor's Guide located at <https://www.clackamas.us/how-to-bid-on-county-projects> .

Engineers Estimate: \$250,000.00

Contact Information

Procurement Process and Technical Questions: Tralee Whitley at Twhitley@clackamas.us .

A **Non-Mandatory Pre-Bid Conference** will be conducted on **December 17, 2024 at 10:00 AM**. Bidders shall meet with County representatives at the site located at **6605 SE Lake Road, Milwaukie, Oregon** for that purpose. Attendance will be documented through a sign-in sheet prepared by the County representative.

Bids will be opened and publicly read aloud at the above Delivery address after the Bid Closing. Bid results will also be posted to the OregonBuys listing shortly after the opening.

Prevailing Wage

Prevailing Wage Rates requirements apply to this Project because the maximum compensation for all Owner-contracted Work is more than \$50,000. Contractor and all subcontractors shall comply with the

provisions of ORS 279C.800 through 279C.870, relative to Prevailing Wage Rates. The Bureau of Labor and Industries (BOLI) wage rates and requirements set forth in the following BOLI booklet (and any listed amendments to that booklet), which are incorporated herein by reference, apply to the Work authorized under this Agreement:

PREVAILING WAGE RATES for Public Works Contracts in Oregon, July 5, 2024 and amended on October 5, 2024 which can be downloaded at the following web address:, which can be downloaded at the following web address: http://www.oregon.gov/boli/WHD/PWR/Pages/pwr_state.aspx
The Work will take place in Clackamas County, Oregon.

Clackamas County encourages bids from Minority, Women, and Emerging Small Businesses.



CLACKAMAS COUNTY PUBLIC IMPROVEMENT CONTRACT

INSTRUCTIONS TO BIDDERS

Clackamas County Local Contract Review Board Rules ("LCRB Rules") govern this procurement process. LCRB Rules may be found at:

http://www.clackamas.us/code/documents/appendix_c.pdf. The Instructions to Bidders is applicable to the procurement process for Clackamas County, or any component unit thereof identified on the Notice of Public Improvement Contract Opportunity, herein after referred to as the "Owner."

Article 1. Scope of Work

The work contemplated under this contract with the Owner, includes all labor, materials, transportation, equipment and services necessary for, and reasonably incidental to, the completion of all construction work in connection with the project described in the Project Manual which includes, but is not necessarily limited to, the Notice of Public Improvement Contract Opportunity, Instructions to Bidders, Supplemental Instructions to Bidders, Bid Form, Bid Bond, Public Improvement Contract Form, Performance Bond, Payment Bond, Clackamas County General Conditions for Public Improvement Contracts (10/13/2021), Supplemental General Conditions, and Plans, Specifications and Drawings.

Article 2. Examination of Site and Conditions

Before making a Bid, the Bidder shall examine the site of the work and ascertain all the physical conditions in relation thereto. The Bidder shall also make a careful examination of the Project Manual including the plans, specifications, and drawings and other contract documents, and shall be fully informed as to the quality and quantity of materials and the sources of supply of the materials. Failure to take these steps will not release the successful Bidder from entering into the contract nor excuse the Bidder from performing the work in strict accordance with the terms of the contract at the

price established by the Bid.

The Owner will not be responsible for any loss or for any unanticipated costs, which may be suffered by the successful Bidder, as a result of such Bidder's failure to be fully informed in advance with regard to all conditions pertaining to the work and the character of the work required, including site conditions. No statement made by an elected official, officer, agent, or employee of the Owner in relation to the physical or other conditions pertaining to the site of the work will be binding on the Owner, unless covered by the Project Manual or an Addendum.

Article 3. Interpretation of Project Manual and Approval of Materials Equal to Those Provided in the Specifications

If any Bidder contemplating submitting a Bid for the proposed contract is in doubt as to the true meaning of any part of the plans, specifications or forms of contract documents, or detects discrepancies or omissions, such Bidder may submit to the Architect (read "Engineer" throughout in lieu of Architect as appropriate) a written request for an interpretation thereof at least ten (10) calendar days prior to the date set for the Bid Closing.

When a prospective Bidder seeks approval of a particular manufacturer's material, process or item of equal value, utility or merit other than that designated by the Architect in the Project Manual, the Bidder may submit to the Architect a written request for approval of such substitute at least ten (10) calendar days prior to the date set for the Bid Closing. The prospective Bidder submitting the request will be responsible for its prompt delivery.

Requests of approval for a substitution from that specified shall be accompanied by samples, records of performance, certified copies of tests by

impartial and recognized laboratories, and such other information as the Architect may request.

To establish a basis of quality, certain processes, types of machinery and equipment or kinds of materials may be specified in the Project Manual either by description of process or by designating a manufacturer by name and referring to a brand or product designation or by specifying a kind of material. Whenever a process is designated or a manufacturer's name, brand or item designation is given, or whenever a process or material covered by patent is designated or described, it shall be understood that the words "or approved equal" follow such name, designation or description, whether in fact they do so or not.

Any interpretation of the Project Manual or approval of manufacturer's material will be made only by an Addendum duly issued. All Addenda will be posted to the OregonBuys listing and will become a part of the Project Manual. The Owner will not be responsible for any other explanation or interpretation of the Project Manual nor for any other approval of a particular manufacturer's process or item for any Bidder.

When the Architect approves a substitution by Addendum, it is with the understanding that the Contractor guarantees the substituted article or material to be equal or better than the one specified.

Article 4. Security to Be Furnished by Each Bidder

Each Bid must be accompanied by either 1) a cashier's check or a certified check drawn on a bank authorized to do business in the State of Oregon, or 2) a Bid bond described hereinafter, executed in favor of the Owner, for an amount equal to ten percent (10%) of the total amount Bid as a guarantee that, if awarded the contract, the Bidder will execute the contract and provide a performance bond and payment bond as required. The successful Bidder's check or Bid bond will be retained until the Bidder has entered into a contract satisfactory to Owner and furnished a one hundred percent (100%) performance bond and one hundred percent (100%) payment bond. The Owner

reserves the right to hold the Bid security as described in Article 10 hereof. Should the successful Bidder fail to execute and deliver the contract as provided for in Article 12 hereof, including a satisfactory performance bond and payment bond within twenty (20) calendar days after the Bid has been accepted by the Owner, then the contract award made to such Bidder may be considered canceled and the Bid security may be forfeited as liquidated damages at the option of the Owner. The date of the acceptance of the Bid and the award of the contract as contemplated by the Project Manual shall mean the date of acceptance specified in the Notice of Intent to Award.

Article 5. Execution of Bid Bond

Should the Bidder elect to utilize a Bid bond as described in Article 4 in order to satisfy the Bid security requirements, such form must be completed in the following manner:

- A. Bid bonds must be executed on the County forms, which will be provided to all prospective Bidders by the Owner.
- B. The Bid bond shall be executed on behalf of a bonding company licensed to do business in the State of Oregon.
- C. In the case of a sole individual, the bond need only be executed as principal by the sole individual. In the case of a partnership, the bond must be executed by at least one of the partners. In the case of a corporation, the bond must be executed by stating the official name of the corporation under which is placed the signature of an officer authorized to sign on behalf of the corporation followed by such person's official capacity, such as president, etc. The corporation seal should then be affixed to the bond.
- D. The name of the surety must be stated in the execution over the signature of its duly authorized attorney-in-fact and accompanied by the seal of the surety corporation.

Article 6. Execution of the Bid Form

Each Bid shall be made in accordance with: (i) the sample Bid Form accompanying these instructions; (ii) the appropriate signatures for a sole individual, partnership, corporation or limited liability corporation shall be added as noted in Article 5C above; (iii) numbers pertaining to base Bids shall be stated both in writing and in figures; and (iv) the Bidder's address shall be typed or printed.

The Bid Form relates to Bids on a specific Project Manual. Only the amounts and information asked for on the Bid Form furnished will be considered as the Bid. Each Bidder shall Bid upon the work exactly as specified and provided in the Bid Form. The Bidder shall include in the Bid a sum to cover the cost of all items contemplated by the Contract. The Bidder shall Bid upon all alternates that may be indicated on the Bid Form. When Bidding on an alternate for which there is no charge, the Bidder shall write the words "No Charge" in the space provided on the Bid Form. If one or more alternates are shown on the Bid Form, the Bidder shall indicate whether each is "add" or "deduct."

Article 7. Prohibition of Alterations to Bid

Bids that are incomplete, or contain ambiguities or have differing conditions required by the Bidder, including requested changes or exceptions to the Public Improvement Contract form or other portions of the Project Manual, may be rejected in Owner's sole and absolute discretion.

Article 8. Submission of Bid

Each Bid shall be sealed in an envelope, properly addressed to the Owner, showing on the outside of the envelope the name of the Bidder and the name of the project. Bids will be received at the time and place stated in the Notice of Public Improvement Contract Opportunity.

Article 9. Bid Closing and Opening of Bids

All Bids must be received by the Owner at the place and time set for the Bid Closing. Any Bids received after the scheduled Bid Closing time for

receipt of Bids will be rejected.

At the time of opening and reading of Bids, each Bid received will be publicly opened and read aloud, irrespective of any irregularities or informalities in such Bids.

Generally, Bid results will be posted to the OregonBuys Website within a couple hours of the opening.

Article 10. Acceptance or Rejection of Bids by Owner

Unless all Bids are rejected, the Owner will award a contract based on the lowest responsive Bid from a responsible Bidder. If that Bidder does not execute the contract, it will be awarded to the next lowest responsible Bidder or Bidders in succession.

The Owner reserves the right to reject all Bids and to waive minor informalities. The procedures for contract awards shall be in compliance with the provisions of the LCRB Rules in effect at that time.

The Owner reserves the right to hold the Bid and Bid security of the three lowest Bidders for a period of thirty (30) calendar days from and after the time of Bid opening pending award of the contract. Following award of the contract the Bid security of the three lowest Bidders may be held twenty (20) calendar days pending execution of the contract. All other Bids will be rejected and Bid security will be returned.

In determining the lowest Bidder, the Owner reserves the right to take into consideration any or all authorized base Bids as well as alternates or combinations indicated in the Bid Form.

If no Bid has been accepted within thirty (30) calendar days after the opening of the Bids, each of the three lowest Bidders may withdraw the Bid submitted and request the return of the Bid security.

Article 11. Withdrawal of Bid

At any time prior to the Bid Closing, a Bidder may withdraw its Bid. This will not preclude the

submission of another Bid by such Bidder prior to the time set for the Bid Closing.

After the time set for the Bid Closing, no Bidder will be permitted to withdraw its Bid within the time frames specified in Article 10 for award and execution, except as provided for in that Article.

Article 12. Execution of Contract, Performance Bond and Payment Bond

The Owner will provide the successful Bidder with contract forms within seven (7) calendar days after the completion of the award protest period. The Bidder is required to execute the contract forms as provided, including a performance bond and a payment bond from a surety company licensed to do surety business in the State of Oregon, within seven (7) calendar days after receipt of the contract forms. The contract forms shall be delivered to the Owner in the number called for and to the location as instructed by the Owner.

Article 13. Recyclable Products

Contractors will use recyclable products to the maximum extent economically feasible in the performance of the Contract.

Article 14. Clarification or Protest of the Solicitation Document or Specifications

Any request for clarification or protest of the solicitation document or specifications must be submitted in the manner provided for in the applicable section of the LCRB Rules to the Procurement Representative referenced in the Notice of Public Improvement Contract Opportunity.

A protest of the Solicitation Document must be received within seven (7) business days of the issuance of the Bid or within three (3) business days of issuance of an addendum.

Requests for clarification may be submitted no less than five (5) business days prior to the Bid Closing Date.

Article 15. Protest of Intent to Award

Owner will name the apparent successful Bidder in a "Notice of Intent to Award" letter. Identification of the apparent successful Bidder is procedural only and creates no right in the named Bidder to the award of the contract. Competing Bidders will be notified by publication of the Notice of Intent to Award on the OregonBuys Website of the selection of the apparent successful Bidder(s) and Bidders shall be given seven (7) calendar days from the date on the "Notice of Intent to Award" letter to review the file at the Procurement Division office and file a written protest of award, pursuant to C-049-0450. Any award protest must be in writing and must be delivered by email, hand delivery, or mail to the Procurement Division Director at: Procurement Division, 2051 Kaen Road, Oregon City, OR 97045.

Article 16. Disclosure of First-Tier Subcontractors

Within two (2) working hours after the Bid Closing, all Bidders shall submit to the County a disclosure form identifying any first-tier subcontractors (those entities that would be contracting directly with the prime contractor) that will be furnishing labor and materials on the contract, if awarded, whose subcontract value would be equal to or greater than: (a) Five percent (5%) of the total contract price, but at least \$15,000; or (b) \$350,000, regardless of the percentage of the total contract price.

Disclosures may be submitted with the Bid or may be hand delivered to the Bid Closing address or emailed to the Contract Information Analyst listed on the Notice of Contract Opportunity.



**CLACKAMAS COUNTY
PUBLIC IMPROVEMENT CONTRACT**

SUPPLEMENTAL INSTRUCTIONS TO BIDDERS

Project Name BID# 2024-105 Lake Road Health Center Flooring Project

The following modify the Clackamas County “Instructions to Bidders” for this Project. Where a portion of the Instructions to Bidders has been modified by these Supplemental Instructions to Bidders, the unaltered portions shall remain in effect.

1. **Non-Mandatory Pre-Bid Conference** will be conducted on **December 17, 2024 at 10:00 AM**. Bidders shall meet with County representatives at 6605 SE Lake Road, Milwaukie, Oregon for that purpose. Attendance will be documented through a sign-in sheet prepared by the County representative.
2. **Electronic Submissions:** The County is requiring all bids for this project be electronically submitted. Complete Bids (including all attachments) will only be accepted electronically thru a secure online bid submission service, Bid Locker. Email submissions to Clackamas County email addresses will no longer be accepted.
<https://bidlocker.us/a/clackamascounty/BidLocker>.

Bids will be publicly read aloud via the computer application, Zoom. Bidders will be allowed to video conference or listen by phone to the bid results. The projects Zoom meeting can be accessed via the information below:

ZOOM LINKS

Join Zoom Meeting

<https://clackamascounty.zoom.us/j/86946410387>

Meeting ID: 869 4641 0387

One tap mobile

+14086380968,,86946410387# US (San Jose) 16694449171,,86946410387# US

Dial by your location

- +1 408 638 0968 US (San Jose)
- +1 669 444 9171 US
- +1 669 900 6833 US (San Jose)
- +1 719 359 4580 US
- +1 253 205 0468 US
- +1 253 215 8782 US (Tacoma)
- +1 346 248 7799 US (Houston)
- +1 689 278 1000 US
- +1 301 715 8592 US (Washington DC)
- +1 305 224 1968 US
- +1 309 205 3325 US
- +1 312 626 6799 US (Chicago)

- +1 360 209 5623 US
- +1 386 347 5053 US
- +1 507 473 4847 US
- +1 564 217 2000 US
- +1 646 876 9923 US (New York)
- +1 646 931 3860 US

Meeting ID: 869 4641 0387

Find your local number: <https://clackamascounty.zoom.us/u/kbNmJGqgz8>

**The Apparent Low bid results will be posted to the projects OregonBuys listing as soon as possible following the bid opening.

3. **Good Faith Effort:** Clackamas County encourages participation in contracts by Historically Underrepresented Businesses. “Historically Underrepresented Businesses” are State of Oregon-certified and self-identified minority, women and emerging small business as well as firms that are certified federally or by another state or entity with substantially similar requirements as the State of Oregon.

Bidders must perform Good Faith Effort (defined below) and submit **Form 1 and Form 2** for the Bidders Bid to be considered responsive. **Form 1 and Form 2** must be submitted within two (2) hours after the Closing Date and Time. Form 1 and Form 2 may be submitted to either the Contact Information Analyst listed on Notice of Contract Opportunity or via the <https://bidlocker.us/a/clackamascounty/BidLocker> listing.

“Good Faith Effort” is a requirement of a prime contractor to reach out to at least three Historically Underrepresented Business Subcontractors for each division of work that will be subcontracted out and to complete the required forms. If fewer than three Historically Underrepresented Business Subcontractors are reasonably available for a particular division of work, the Bidder must specifically note the reason for there being fewer than three contacts. The outreach should be performed with sufficient time to give the subcontractors at least 5 calendar days to respond to the opportunity. Form 3, which documents the actual amount of subcontractors on the project, must be submitted with the project final pay application. Compliance with the Good Faith Effort and submission of Forms 1, 2 and 3 is a contractual requirement for final payment.

The sufficiency of the documentation or the performance of Good Faith Effort shall be in the sole and absolute determination of Clackamas County. Only those Bidders that Clackamas County has determined have not sufficiently performed Good Faith Effort shall have protest rights of the determination for such Bidder. No Bidder shall have protest rights of the sufficiency of any other Bidder completing Good Faith Effort.

**GOOD FAITH EFFORT
SUBCONTRACTOR AND SELF-PERFORMED WORK LIST
(FORM 1)**

Prime Contractor Name: **Fabulous Floors LLC**

Total Contract Amount: **225,572⁰⁰**

Project Name: **BID#2024-105 Lake Road Health Center Flooring Project**

PRIME SELF-PERFORMING: Identify below ALL GFE Divisions of Work (DOW) to be self-performed. Good Faith Efforts are otherwise required.

<u>DOW BIDDER WILL SELF-PERFORM (GFE not required)</u>	

PRIME CONTRACTOR SHALL DISCLOSE AND LIST ALL SUBCONTRACTORS, including those Minority-owned, Woman-owned, and Emerging Small Businesses ("M/W/ESB") that you intend to use on the project. Delivery via bid locker <https://bidlocker.us/a/clackamascounty/BidLocker> within 2 hours of the BID/Quote Closing Date/Time.

<u>LIST ALL SUBCONTRACTORS BELOW</u> Use <u>correct legal name</u> of Subcontractor (No Assumed Business Names)	Division of Work (Painting, electrical, landscaping, etc.) List ALL DOW performed by Subcontractors	DOLLAR AMOUNT OF SUBCONTRACT	If Certified or self-reporting MBE/WBE/ESB Subcontractor		
			MBE	WBE	ESB
Name Meticulous Deconstruction Address 8940 N Bradford St City/St/Zip Portland, OR 97203 Phone# 831-588-4541 OCCB# 225553	Division of Work (Painting, electrical, landscaping, etc.) List ALL DOW performed by Subcontractors Floor removal Base, cpt LVT	27758 ⁰⁰	<input type="checkbox"/>	<input checked="" type="checkbox"/>	<input type="checkbox"/>
Name Linear Floor Installers LLC Address 33788 Berg Rd City/St/Zip Warren, OR 97053 Phone# 971-757-5808 OCCB# 224923	Division of Work (Painting, electrical, landscaping, etc.) List ALL DOW performed by Subcontractors Prep & Floor Install	59,673 ⁰⁰	<input type="checkbox"/>	<input type="checkbox"/>	<input type="checkbox"/>
Name Address City/St/Zip Phone# OCCB#			<input type="checkbox"/>	<input type="checkbox"/>	<input type="checkbox"/>
Name Address City/St/Zip Phone# OCCB#			<input type="checkbox"/>	<input type="checkbox"/>	<input type="checkbox"/>

**CLACKAMAS COUNTY
GOOD FAITH EFFORT
M/W/ESB CONTACT / BIDS RECEIVED LOG
(FORM 2)**

Prime Contractor:

Project: BID#2024-105 Lake Road Health Center Flooring Project

Prime Contractor must contact or endeavor to contact at least 3 M/W/ESB Subcontractors for each Division of Work. Prime Contractor shall record its contacts with M/W/ESB Subcontractors through use of this log (or equivalent) entering all required information. All columns shall be completed where applicable. Additional forms may be copied if needed.

NAME OF M/W/ESB SUBCONTRACTOR	Divisions of Work (Painting, electrical, landscaping, etc.)	Date Solicitation Letter / Fax Sent	PHONE CONTACT		BID ACTIVITY Check Yes or No			REJECTED BIDS (if bid received & not used)		Notes
			Date of Call	Person Receiving Call	Will Bid	Bid Received	Bid Used	Bid Amount	Reason Not Used (Price, Scope or Other. If Other, explain in Notes>>)	
Meticulous Deconstruction 8940 N Bradford St Portland, OR 97203	floor removal		1-7-25	Brianna Ivy	<input checked="" type="checkbox"/> Yes <input type="checkbox"/> No	<input checked="" type="checkbox"/> Yes <input type="checkbox"/> No	<input checked="" type="checkbox"/> Yes <input type="checkbox"/> No	21,758.00		woman owned
PFI - Portland	Install		1-6-25 1-7-25	no answer	<input type="checkbox"/> Yes <input checked="" type="checkbox"/> No	<input type="checkbox"/> Yes <input checked="" type="checkbox"/> No	<input type="checkbox"/> Yes <input checked="" type="checkbox"/> No		Would not return call	
Interstate	Install		1-7-25	no answer	<input type="checkbox"/> Yes <input checked="" type="checkbox"/> No	<input type="checkbox"/> Yes <input checked="" type="checkbox"/> No	<input type="checkbox"/> Yes <input checked="" type="checkbox"/> No		not certified	
					<input type="checkbox"/> Yes <input type="checkbox"/> No	<input type="checkbox"/> Yes <input type="checkbox"/> No	<input type="checkbox"/> Yes <input type="checkbox"/> No			
CLACKAMAS COUNTY
PUBLIC IMPROVEMENT CONTRACT

BID BOND

Project Name: # 2024-105 Lake Road Health Center Flooring Project

We, Fabulous Floors, LLC, as "Principal,"
(Name of Principal)

and Fidelity and Deposit Company of Maryland, an IL Corporation,
(Name of Surety)

authorized to transact Surety business in Oregon, as "Surety," hereby jointly and severally bind ourselves, our respective heirs, executors, administrators, successors and assigns to pay unto Clackamas County ("Obligee") the sum of (\$10%)

Ten Percent of Total Amount Bid dollars.

WHEREAS, the condition of the obligation of this bond is that Principal has submitted its proposal or bid to an agency of the Obligee in response to Obligee's procurement document (No. *) for the project identified above which proposal or bid is made a part of this bond by reference, and Principal is required to furnish bid security in an amount equal to ten (10%) percent of the total amount of the bid pursuant to the procurement document.

*S-C01010-00012201

NOW, THEREFORE, if the Obligee shall accept the bid of the Principal and the Principal shall enter into a Contract with the Obligee in accordance with the terms of such bid, and give such bond or bonds as may be specified in the bidding or Contract Documents with good and sufficient surety for the faithful performance of such Contract and for the prompt payment of labor and material furnished in the prosecution thereof, or in the event of the failure of the Principal to enter such Contract and give such bond or bonds, if the Principal shall pay to the Obligee the difference not to exceed the penalty hereof between the amount specified in said bid and such larger amount for which the Obligee may in good faith contract with another party to perform the Work covered by said bid, then this obligation shall be null and void, otherwise to remain in full force and effect.

IN WITNESS WHEREOF, we have caused this instrument to be executed and sealed by our duly authorized legal representatives this 7th day of January, 2025.

Principal: Fabulous Floors, LLC

Surety: Fidelity and Deposit Company of Maryland

By: Mark W-
Signature

By: Attorney-In-Fact Jennifer L. Clampert

Controller
Official Capacity

By: J Clampert
Name

Attest: Kerry Klein
Corporation Secretary

1299 Zurich Way, 10th Floor
Address



Schaumburg IL 60196-1056
City State Zip

847-605-6000 866-947-1075
Phone Fax

**ZURICH AMERICAN INSURANCE COMPANY
COLONIAL AMERICAN CASUALTY AND SURETY COMPANY
FIDELITY AND DEPOSIT COMPANY OF MARYLAND
POWER OF ATTORNEY**

KNOW ALL MEN BY THESE PRESENTS: That the ZURICH AMERICAN INSURANCE COMPANY, a corporation of the State of New York, the COLONIAL AMERICAN CASUALTY AND SURETY COMPANY, a corporation of the State of Illinois, and the FIDELITY AND DEPOSIT COMPANY OF MARYLAND a corporation of the State of Illinois (herein collectively called the "Companies"), by Robert D. Murray, Vice President, in pursuance of authority granted by Article V, Section 8, of the By-Laws of said Companies, which are set forth on the reverse side hereof and are hereby certified to be in full force and effect on the date hereof, do hereby nominate, constitute, and appoint **Ashlea MCC AUGHEY, Jennifer L. CLAMPERT, Nicole L. MCCOLLAM, Amy COONTS, Brandi J. TETLEY, Danielle WARING, Michael LISCHER JR., David DONDLINGER, Lindsey MINUTILLO all of Denver, Colorado**, its true and lawful agent and Attorney-in-Fact, to make, execute, seal and deliver, for, and on its behalf as surety, and as its act and deed: **any and all bonds and undertakings**, and the execution of such bonds or undertakings in pursuance of these presents, shall be as binding upon said Companies, as fully and amply, to all intents and purposes, as if they had been duly executed and acknowledged by the regularly elected officers of the ZURICH AMERICAN INSURANCE COMPANY at its office in New York, New York., the regularly elected officers of the COLONIAL AMERICAN CASUALTY AND SURETY COMPANY at its office in Owings Mills, Maryland., and the regularly elected officers of the FIDELITY AND DEPOSIT COMPANY OF MARYLAND at its office in Owings Mills, Maryland., in their own proper persons.

The said Vice President does hereby certify that the extract set forth on the reverse side hereof is a true copy of Article V, Section 8, of the By-Laws of said Companies, and is now in force.

IN WITNESS WHEREOF, the said Vice-President has hereunto subscribed his/her names and affixed the Corporate Seals of the said ZURICH AMERICAN INSURANCE COMPANY, COLONIAL AMERICAN CASUALTY AND SURETY COMPANY, and FIDELITY AND DEPOSIT COMPANY OF MARYLAND, this 5th day of April, A.D. 2024.



ATTEST:
**ZURICH AMERICAN INSURANCE COMPANY
COLONIAL AMERICAN CASUALTY AND SURETY COMPANY
FIDELITY AND DEPOSIT COMPANY OF MARYLAND**

By: Robert D. Murray
Vice President

By: Dawn E. Brown
Secretary

**State of Maryland
County of Baltimore**

On this 5th day of April, A.D. 2024, before the subscriber, a Notary Public of the State of Maryland, duly commissioned and qualified, **Robert D. Murray, Vice President and Dawn E. Brown, Secretary** of the Companies, to me personally known to be the individuals and officers described in and who executed the preceding instrument, and acknowledged the execution of same, and being by me duly sworn, deposeth and saith, that he/she is the said officer of the Company aforesaid, and that the seals affixed to the preceding instrument are the Corporate Seals of said Companies, and that the said Corporate Seals and the signature as such officer were duly affixed and subscribed to the said instrument by the authority and direction of the said Corporations.

IN TESTIMONY WHEREOF, I have hereunto set my hand and affixed my Official Seal the day and year first above written.

Genevieve M. Maison

GENEVIEVE M. MAISON
NOTARY PUBLIC
BALTIMORE COUNTY, MD
My Commission Expires JANUARY 27, 2025



EXTRACT FROM BY-LAWS OF THE COMPANIES

"Article V, Section 8, Attorneys-in-Fact. The Chief Executive Officer, the President, or any Executive Vice President or Vice President may, by written instrument under the attested corporate seal, appoint attorneys-in-fact with authority to execute bonds, policies, recognizances, stipulations, undertakings, or other like instruments on behalf of the Company, and may authorize any officer or any such attorney-in-fact to affix the corporate seal thereto; and may with or without cause modify or revoke any such appointment or authority at any time."

CERTIFICATE

I, the undersigned, Vice President of the ZURICH AMERICAN INSURANCE COMPANY, the COLONIAL AMERICAN CASUALTY AND SURETY COMPANY, and the FIDELITY AND DEPOSIT COMPANY OF MARYLAND, do hereby certify that the foregoing Power of Attorney is still in full force and effect on the date of this certificate; and I do further certify that Article V, Section 8, of the By-Laws of the Companies is still in force.


This Power of Attorney and Certificate may be signed by facsimile under and by authority of the following resolution of the Board of Directors of the ZURICH AMERICAN INSURANCE COMPANY at a meeting duly called and held on the 15th day of December 1998.

RESOLVED: "That the signature of the President or a Vice President and the attesting signature of a Secretary or an Assistant Secretary and the Seal of the Company may be affixed by facsimile on any Power of Attorney...Any such Power or any certificate thereof bearing such facsimile signature and seal shall be valid and binding on the Company."

This Power of Attorney and Certificate may be signed by facsimile under and by authority of the following resolution of the Board of Directors of the COLONIAL AMERICAN CASUALTY AND SURETY COMPANY at a meeting duly called and held on the 5th day of May, 1994, and the following resolution of the Board of Directors of the FIDELITY AND DEPOSIT COMPANY OF MARYLAND at a meeting duly called and held on the 10th day of May, 1990.

RESOLVED: "That the facsimile or mechanically reproduced seal of the company and facsimile or mechanically reproduced signature of any Vice-President, Secretary, or Assistant Secretary of the Company, whether made heretofore or hereafter, wherever appearing upon a certified copy of any power of attorney issued by the Company, shall be valid and binding upon the Company with the same force and effect as though manually affixed.

IN TESTIMONY WHEREOF, I have hereunto subscribed my name and affixed the corporate seals of the said Companies, this 7th day of January, 2025.

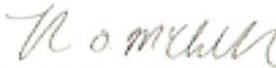A handwritten signature in black ink that appears to read "Thomas O. McClellan".

Thomas O. McClellan

Vice President

TO REPORT A CLAIM WITH REGARD TO A SURETY BOND, PLEASE SUBMIT A COMPLETE DESCRIPTION OF THE CLAIM INCLUDING THE PRINCIPAL ON THE BOND, THE BOND NUMBER, AND YOUR CONTACT INFORMATION TO:

Authenticity of this bond can be confirmed at bondvalidator.zurichna.com or 410-559-8790

Zurich Surety Claims
1299 Zurich Way
Schaumburg, IL 60196-1056
reportsclaims@zurichna.com
800-626-4577



ADDENDUM
Electronic Seals Approved for Surety Bonds

To ensure business continuity during the COVID-19 pandemic, Zurich American Insurance Company and its related companies authorize their Attorneys-in-Fact within all 50 U.S. States, territories and possessions, to affix an electronic seal to all bond documents as if it were a raised corporate seal.

Effective this 2nd day of April, 2020.

Zurich American Insurance Company
Fidelity and Deposit Company of Maryland
Colonial American Insurance Company

A handwritten signature in black ink, appearing to read 'Robert D. Murray'.

Robert D. Murray
Executive Vice President
Head of Surety





CLACKAMAS COUNTY
PUBLIC IMPROVEMENT CONTRACT

BID FORM

PROJECT: BID# 2024-105 Lake Road Health Center Flooring Project
BID CLOSING: January 7, 2025, 2:00 PM, Pacific Time
BID OPENING: January 7, 2025, 2:05 PM, Pacific Time

FROM: Fabulous Floors, LLC
Bidder's Name (must be full legal name, not ABN/DBA)

TO: <https://bidlocker.us/a/clackamascounty/BidLocker>

1. Bidder is (*check one of the following and insert information requested*):

a. An individual; or

b. A partnership registered under the laws of the State of _____; or

c. A corporation organized under the laws of the State of _____; or

d. A limited liability corporation organized under the laws of the State of Texas _____;

and authorized to do business in the State of Oregon hereby proposes to furnish all material and labor and perform all work hereinafter indicated for the above project in strict accordance with the Contract Documents for the Basic Bid as follows:

Two hundred twenty five thousand, five hundred and seventy two dollars \$225,572.00

and the Undersigned agrees to be bound by the following documents:

- Notice of Public Improvement Contract Opportunity
- Instructions to Bidders
- Bid Bond
- Public Improvement Contract Form
- Clackamas County General Conditions
- Prevailing Wage Rates
- Plans, Specifications and Drawings
- Supplemental Instructions to Bidders
- Bid Form
- Performance Bond and Payment Bond
- Supplemental General Conditions
- Payroll and Certified Statement Form

• ADDENDA numbered N/A through _____, inclusive (*fill in blanks*)

2. The Undersigned proposes to add to or deduct from the Base Bid indicated above the items of work relating to the following Alternate(s) as designated in the Specifications: **N/A**

3. The Undersigned proposes to add to or deduct from the Base Bid indicated above the items or work relating to the following Unit Price(s) as designated in the Specifications, for which any adjustments in the Contract amount will be made in accordance with Section D of the Clackamas County General Conditions: **provide attached bid schedule with bid**

4. The work shall be completed within the time stipulated and specified in the Contract Documents.

5. Accompanying herewith is Bid Security which is equal to ten percent (10%) of the total amount of the Basic Bid, plus the total sum of all Alternatives (if any).

6. The Undersigned agrees, if awarded the Contract, to execute and deliver to Clackamas County, within twenty (20) calendar days after receiving the Contract forms, a Contract Form, and a satisfactory Performance Bond and Payment Bond each in an amount equal to one hundred percent (100%) of the Contract sum, using forms provided by the Owner. The surety requested to issue the Performance Bond and Payment Bond will be:

Fidelity and Deposit Company of Maryland
(name of surety company - not insurance agency)

The Undersigned hereby authorizes said surety company to disclose any information to the Owner concerning the Undersigned's ability to supply a Performance Bond and Payment Bond each in the amount of the Contract.

7. The Undersigned further agrees that the Bid Security accompanying the Bid is left in escrow with Clackamas County; that the amount thereof is the measure of liquidated damages which the Owner will sustain by the failure of the Undersigned to execute and deliver the above-named Contract Form, Performance Bond and Payment Bond, each as published, and that if the Undersigned defaults in either executing the Contract Form or providing the Performance Bond and Payment Bond within twenty (20) calendar days after receiving the Contract forms, then the Bid Security shall become the property of the Owner at the Owner's option; but if the Bid is not accepted within thirty (30) calendar days of the time set for the opening of the Bids, or if the Undersigned executes and timely delivers said Contract Form, Performance Bond and Payment Bond, the Bid Security shall be returned.

8. The Undersigned certifies that: (i) This Bid has been arrived at independently and is being submitted without collusion with and without any agreement, understanding, or planned common course of action with any other vendor of materials, supplies, equipment or services described in the invitation to bid designed to limit independent bidding or competition; and (ii) the contents of the Bid have not been communicated by the Undersigned or its employees or agents to any person not an employee or agent of the Undersigned or its surety on any Bond furnished with the Bid and will not be communicated to such person prior to the official opening of the Bid.

9. The undersigned **HAS**, **HAS NOT** (*check one*) paid unemployment or income taxes in Oregon within the past 12 months and **DOES**, **DOES NOT** (*check one*) a business address in Oregon. The undersigned acknowledges that, if the selected bidder, that the undersigned will have to pay all applicable taxes and register to do business in the State of Oregon before executing the Contract Form.

10. The Undersigned agrees, if awarded a contract, to comply with the provisions of ORS 279C.800 through 279C.870 pertaining to the payment of the prevailing rates of wage.

11. Contractor's CCB registration number is 224424. As a condition to submitting a bid, a Contractor must be registered with the Oregon Construction Contractors Board in accordance with ORS 701.035 to 701.055, and disclose the registration number. Failure to register and disclose the number will make the bid unresponsive and it will be rejected, unless contrary to federal law.

12. The successful Bidder hereby certifies that all subcontractors who will perform construction work as described in ORS 701.005(2) were registered with the Construction Contractors Board in accordance with ORS 701.035 to 701.055 at the time the subcontractor(s) made a bid to work under the contract.

13. The successful Bidder hereby certifies that, in compliance with the Worker's Compensation Law of the State of Oregon, its Worker's Compensation Insurance provider is Ima, Inc, Policy No. WC928758758154, and that Contractor shall submit Certificates of Insurance as required.

14. Contractor's Key Individuals for this project (supply information as applicable):
Project Executive: Lilly McNeill, Cell Phone: 541-280-8020,
Project Manager: Mike Jensen, Cell Phone: 541-550-0673,
Job Superintendent: Lilly McNeill, Cell Phone: 541-280-8020,
Project Engineer: _____, Cell Phone: _____.

15. The Undersigned certifies that it has not discriminated against minority, women, or emerging small businesses in obtaining any subcontracts for this project.

16. The Undersigned certifies that it has a drug testing program in accordance with ORS 279C.505.

REMINDER: Bidder must submit the below First-Tier Subcontractor Disclosure Form.

By signature below, Contractor agrees to be bound by this Bid.

NAME OF FIRM	<u>Fabulous Floors, LLC</u>
ADDRESS	<u>20756 High Desert Ct.</u>
	<u>Bend, OR 97701</u>
TELEPHONE NO	<u>541-550-7015 / 541-280-8020 (Cell)</u>
EMAIL	<u>Lilly@fabfloors.com / sharon@fabfloors.com</u>
SIGNATURE 1)	<u>Sole Individual</u>

or 2)

Partner

or 3)


Sharon McNeil

Authorized Officer or Employee of Corporation

***** END OF BID *****

Lake Road Health Center - Flooring

Bidder will complete the Work in accordance with the Contract Documents for the following price(s):

Lake Road Health Center Remodel

BID#

No.	Item	Quantity	Unit of Measure	Unit Price or Lump Sum Price Figures	Total Amount
1	Mobilization	1	Lump Sum		\$ 5625.00 -
2	Installation	1	Lump Sum		\$ 87,481.00 -
3	Materials	1	Lump Sum		\$ 132,516.00 -
					\$ -
TOTAL BID LRHC Remodel				\$ 225,572.00	-

ADDITIVE / ALTERNATE

No.	Item	Quantity	Unit of Measure	Unit Price or Lump Sum Price Figures	Total
1A					\$ -

Name of Firm Fabulous Floors, LLC

Name (Print) Lilly McNeill

Signature Lilly McNeill

Date 1-7-25

FIRST-TIER SUBCONTRACTOR DISCLOSURE FORM
PROJECT: Lake Road Health Center Flooring Project

BID OPENING: January 7, 2025, 2:00 PM, Pacific Time

Failure to submit this Form by the disclosure deadline will result in a nonresponsive bid.

INSTRUCTIONS:

This First-Tier Subcontractor Disclosure Form (“Form”) must be submitted and received at the location specified in the Notice of Public Improvement Contract Opportunity on the advertised Bid Closing, and within two working hours after the advertised Bid Closing Time.

Proposals will only be accepted electronically thru a secure online bid submission service, **Bid Locker**. *Email submissions to Clackamas County email addresses will no longer be accepted.*

- A. Completed proposal documents must arrive electronically via Bid Locker located at <https://bidlocker.us/a/clackamascounty/BidLocker>.
- B. Bid Locker will electronically document the date and time of all submissions. Completed documents must arrive by the deadline indicated in Section 1 or as modified by Addendum. **LATE PROPOSALS WILL NOT BE ACCEPTED.**
- C. Proposers must register and create a profile for their business with Bid Locker in order to submit for this project. It is free to register for Bid Locker.
- D. Proposers with further questions concerning Bid Locker may review the Vendor’s Guide located at <https://www.clackamas.us/how-to-bid-on-county-projects> .

Subcontractor lists may be submitted with the bid in the same envelope or email at the Bid Closing date and time. Subcontractor lists **MUST** be submitted within **two (2) hours** of the Bid Closing date and time.

List below the name of each subcontractor that will be furnishing labor, or labor and materials, for which disclosure is required, the category of work that the subcontractor will be performing, and the dollar value of the subcontract. Enter **“NONE”** if the value of the project bid is less than \$100,000 or there are no subcontractors that need to be disclosed. ATTACH ADDITIONAL SHEETS IF NECESSARY.

	SUBCONTRACTOR NAME	DOLLAR VALUE	CATEGORY OF WORK
1.	<u>Linear Floors</u>	<u>59,673.00</u>	<u>Install</u>
2.	<u>Meticulous Deconstruction</u>	<u>27,158.00</u>	<u>flooring removal</u>
3.			
4.			
5.			
6.			

The above listed first-tier subcontractor(s) are providing labor, or labor and material, with a Dollar Value equal to or greater than:

- a) 5% of the total Contract Price, but at least \$15,000. If the Dollar Value is less than \$15,000 do not list the subcontractor above; or
- b) \$350,000 regardless of the percentage of the total Contract Price.

Firm Name: Fabulous Floors, LLC

Bidder Signature: L. J. L. Phone # 541-280-8020



**CLACKAMAS COUNTY
PUBLIC IMPROVEMENT CONTRACT
SUPPLEMENTAL GENERAL CONDITIONS**

PROJECT: #2024-105 Lake Road Health Center Flooring Project

The following modifies the November 21, 2024 Clackamas County General Conditions for Public Improvement Contracts (“County General Conditions”) for this Contract. Except as modified below, all other terms and conditions of the County General Conditions shall remain in effect.

1. Good Faith Effort

As a condition of Contractor being awarded a Contract for this Project, Contractor must complete Good Faith Effort outreach and documentation as described in the Supplemental Instructions to Bidders of the Solicitation Document.

The Contractor may not change who is performing each Division of Work identified in Form 1 of the Good Faith Effort without the express written advance approval of Owner. This includes substituting identified subcontractors, self-performance of a Division of Work that was identified to be performed by a subcontractor, or the Contractor subcontracting a Division of Work that was identified to be self-performed by the Contractor.

Contractor shall be required to submit the completed Form 3 with its final pay application as a condition of final payment.



CLACKAMAS COUNTY GENERAL CONDITIONS FOR PUBLIC IMPROVEMENT CONTRACTS

November 21, 2024

INSTRUCTIONS: The attached **Clackamas County General Conditions for Public Improvement Contracts** ("County General Conditions") apply to all designated Public Improvement contracts. Changes to the County General Conditions (including any additions, deletions or substitutions) should only be made by attaching Public Improvement Supplemental General Conditions. The text of these County General Conditions should not otherwise be altered.

TABLE OF SECTIONS

SECTION A - GENERAL PROVISIONS

- A.1 DEFINITION OF TERMS
- A.2 SCOPE OF WORK
- A.3 INTERPRETATION OF CONTRACT DOCUMENTS
- A.4 EXAMINATION OF PLANS, SPECIFICATIONS, AND PROJECT
- A.5 INDEPENDENT CONTRACTOR STATUS
- A.6 RETIREMENT SYSTEM STATUS AND TAXES
- A.7 GOVERNMENT EMPLOYMENT STATUS

SECTION B - ADMINISTRATION OF THE CONTRACT

- B.1 OWNER'S ADMINISTRATION OF THE CONTRACT
- B.2 CONTRACTOR'S MEANS AND METHODS
- B.3 MATERIALS AND WORKMANSHIP
- B.4 PERMITS
- B.5 COMPLIANCE WITH GOVERNMENT REGULATIONS
- B.6 SUPERINTENDENCE
- B.7 INSPECTION
- B.8 SEVERABILITY
- B.9 ACCESS TO RECORDS
- B.10 WAIVER
- B.11 SUBCONTRACTS AND ASSIGNMENT
- B.12 SUCCESSORS IN INTEREST
- B.13 OWNER'S RIGHT TO DO WORK
- B.14 OTHER CONTRACTS

SECTION C - WAGES AND LABOR

- C.1 MINIMUM WAGES RATES ON PUBLIC WORKS
- C.2 PAYROLL CERTIFICATION AND FEE REQUIREMENTS, ADDITIONAL RETAINAGE
- C.3 PROMPT PAYMENT AND CONTRACT CONDITIONS
- C.4 PAYMENT FOR MEDICAL CARE
- C.5 HOURS OF LABOR

SECTION D - CHANGES IN THE WORK

- D.1 CHANGES IN THE WORK
- D.2 DELAYS
- D.3 CLAIMS REVIEW PROCESS

SECTION E - PAYMENTS

- E.1 SCHEDULE OF VALUES
- E.2 APPLICATIONS FOR PAYMENT
- E.3 PAYROLL CERTIFICATION REQUIREMENT
- E.4 DUAL PAYMENT SOURCES
- E.5 RETAINAGE
- E.6 FINAL PAYMENT

SECTION F - PROJECT SITE CONDITIONS

- F.1 USE OF PREMISES
- F.2 PROTECTION OF WORKERS, PROPERTY, AND THE PUBLIC
- F.3 CUTTING AND PATCHING
- F.4 CLEANING UP
- F.5 ENVIRONMENTAL CONTAMINATION
- F.6 ENVIRONMENTAL CLEAN-UP

SECTION G - INDEMNITY, BONDING AND INSURANCE

- G.1 RESPONSIBILITY FOR DAMAGES/INDEMNITY
- G.2 PERFORMANCE AND PAYMENT SECURITY, PUBLIC WORKS BOND
- G.3 INSURANCE

SECTION H - SCHEDULE OF WORK

- H.1 CONTRACT PERIOD
- H.2 SCHEDULE
- H.3 PARTIAL OCCUPANCY OR USE

SECTION I - CORRECTION OF WORK

- I.1 CORRECTIONS OF WORK BEFORE FINAL PAYMENT
- I.2 WARRANTY WORK

SECTION J - SUSPENSION AND/OR TERMINATION OF THE WORK

- J.1 OWNER'S RIGHT TO SUSPEND THE WORK
- J.2 CONTRACTOR'S RESPONSIBILITIES
- J.3 COMPENSATION FOR SUSPENSION
- J.4 OWNER'S RIGHT TO TERMINATE CONTRACT
- J.5 TERMINATION FOR CONVENIENCE, NON-APPROPRIATION OF FUNDS, OR FORCE MAJEURE
- J.6 ACTION UPON TERMINATION

SECTION K - CONTRACT CLOSE-OUT

- K.1 RECORD DOCUMENTS
- K.2 OPERATION AND MAINTENANCE MANUALS
- K.3 COMPLETION NOTICES
- K.4 TRAINING
- K.5 EXTRA MATERIALS
- K.6 ENVIRONMENTAL CLEAN-UP
- K.7 CERTIFICATE OF OCCUPANCY
- K.8 OTHER CONTRACTOR RESPONSIBILITIES
- K.9 SURVIVAL

SECTION L- GENERAL PROVISIONS

- L.1 NO THIRD PARY BENEFICIARIES
- L.2 SEVERABILITY
- L.3 ACCESS TO RECORDS
- L.4 WAIVER
- L.5 SUCCESSORS IN INTEREST
- L.6 GOVERNING LAW
- L.7 APPLICABLE LAW
- L.8 NON-EXCLUSIVE RIGHTS & REMEDIES
- L.9 INTERPRETATION
- L.10 DEBT LIMITATION
- L.11 LITIGATION
- L.12 SURVIVAL
- L.13 ACCESS TO RECORDS
- L.14 WAIVER
- L.15 NO ATTORNEY FEES

**CLACKAMAS COUNTY GENERAL CONDITIONS
FOR PUBLIC IMPROVEMENT CONTRACTS**
(“County General Conditions”)

**SECTION A
GENERAL PROVISIONS**

A.1 DEFINITION OF TERMS

In the Contract Documents the following terms shall be as defined below:

APPLICABLE LAWS, means all federal, state and local laws, codes, rules, regulations and ordinances, as amended applicable to the Work, to the Contract, or to the parties individually.

APPROVED BY CONTRACTING AGENCY, for purposes of ORS 279C.570(2), means the date a progress payment is approved by the Clackamas County Treasurer’s office.

ARCHITECT/ENGINEER, means the Person appointed by the Owner to make drawings and specifications and, to provide contract administration of the Work contemplated by the Contract to the extent provided herein or by supplemental instruction of Owner (under which Owner may delegate responsibilities to the Architect/Engineer), in accordance with ORS Chapter 671 (Architects) or ORS Chapter 672 (Engineers) and administrative rules adopted thereunder.

AVOIDABLE DELAYS, mean any delays other than Unavoidable Delays, and include delays that otherwise would be considered Unavoidable Delays but that: (a) Could have been avoided by the exercise of care, prudence, foresight, and diligence on the part of the Contractor or its Subcontractors; (b) Affect only a portion of the Work and do not necessarily prevent or delay the prosecution of other parts of the Work nor the completion of the whole Work within the Contract Time; (c) Do not impact activities on the accepted critical path schedule; and (d) Are associated with the reasonable interference of other contractors employed by the Owner that do not necessarily prevent the completion of the whole Work within the Contract Time.

BIDDER, means a bidder in connection with Instructions to Bidders or a proposer in connection with a Request for Proposals, or Solicitation Document. May also be referenced as “Offeror,” “Quoter” or “Proposer” based on the type of Solicitation Document.

CHANGE ORDER, means a written order which, when fully executed by the Parties to the Contract, constitutes a change to the Contract Documents. Change Orders shall be issued in accordance with the changes provisions in Section D and, if applicable, establish a Contract Price or Contract Time adjustment. A Change Order shall not be effective until executed by both parties.

CLAIM, means a demand by Contractor pursuant to Section D.3 for review of the denial of Contractor’s initial request for an adjustment of Contract terms, payment of money, extension of Contract Time or other relief, submitted in accordance with the requirements and within the time limits established for review of Claims in these County General Conditions.

CONTRACT, means the written agreement between the Owner and the Contractor comprised of the Contract Documents which describe the Work to be done and the obligations between the parties.

CONTRACT DOCUMENTS, means the Contract, County General Conditions, Supplemental General Conditions if any, Plans, Specifications, the accepted Offer, Solicitation Document and addenda thereto, Instructions to Offerors, and Supplemental Instructions to Offerors.

CONTRACT PERIOD, as set forth in the Contract Documents, means the total period of time beginning with the full execution of a Contract

and, if applicable, the issuance of a Notice to Proceed and concluding upon Final Completion.

CONTRACT PRICE, means the total price reflected in the Contract.

CONTRACT TIME, means any incremental period of time allowed under the Contract to complete any portion of the Work as reflected in the Project schedule.

CONTRACTOR, means the Person awarded the Contract for the Work contemplated.

DAYS, are calendar days, including weekdays, weekends and holidays, unless otherwise specified.

DEFECTIVE WORK, means Work that is not completed in accordance with the Specifications or the requirements of the Contract.

DIRECT COSTS, means, unless otherwise provided in the Contract Documents: the cost of materials, including sales tax and the cost of delivery; cost of labor which shall only include the applicable prevailing wage and fringe benefit (if applicable, and if paid to or on behalf of the employee) rate plus a maximum of a twelve percent (12%) markup on the prevailing wage (but not the fringe benefit) to cover Contractor’s labor burden including but not limited to social security, Medicare, unemployment insurance, workers’ compensation insurance, sick leave pay; substantiated Project cost increases for specific insurance (including, without limitation, Builder’s Risk Insurance and Builder’s Risk Installation Floater) or bond premiums; rental cost of equipment, and machinery required for execution of the Work; and the additional costs of field personnel directly attributable to the Work; travel expense reimbursement only if specifically authorized and only to the extent allowable under the County Contractor Travel Reimbursement Policy, hereby incorporated by reference.

FINAL COMPLETION, means the final completion of all requirements under the Contract, including Contract Closeout as described in Section K but excluding Warranty Work as described in Section I.2, and the final payment and release of all retainage, if any.

FORCE MAJEURE, means an act, event or occurrence caused by fire, riot, war, acts of God, terrorism, nature, sovereign, or public enemy, strikes, freight embargoes or any other act, event or occurrence that is beyond the control of the party to the Contract who is asserting Force Majeure.

NOTICE TO PROCEED, means the official written notice from the Owner stating that the Contractor is to proceed with the Work defined in the Contract Documents.

OFFER, means a bid in connection with Instructions to Bidders or a proposal in connection with a Request for Proposals, or Solicitation Document to do the work stated in the Solicitation Document at the price quoted. May also be referenced as “Bid,” “Quote,” or “Proposal” based on the type of Solicitation Document.

OVERHEAD, means those items which may be included in the Contractor’s markup (general and administrative expense and profit) and that shall not be charged as Direct Cost of the Work, including without limitation such Overhead expenses as wages or salary of personnel above the level of foreman (i.e., superintendents and project managers), labor rates and fringe benefits above the applicable prevailing wage and fringe benefit (if applicable, and if paid to or on behalf of the employee), Contractor’s labor burden for fringe benefit if paid to the employee, expenses of Contractor’s offices and supplies at the Project Site (e.g. job trailer) and at Contractor’s principal place of business and including expenses of personnel staffing the Project Site office and Contractor’s principal place of business, and Commercial General Liability Insurance and Automobile Liability Insurance.

OWNER, means, Clackamas County or any component unit thereof including Clackamas County Development Agency, Clackamas County Service District No. 1, Surface Water Management Agency of Clackamas County, Tri-City Service District, Water Environment Services, North Clackamas Parks and Recreation District, Clackamas County Extension & 4-H Service District, Library Service District of Clackamas County, Enhanced Law Enforcement District, and Clackamas County Service District No. 5. Owner may elect, by written notice to Contractor, to delegate certain duties to more than one agent, including without limitation, to an Architect/Engineer. However, nothing in these County General Conditions is intended to abrogate the separate design professional responsibilities of Architects under ORS Chapter 671 or of Engineers under ORS Chapter 672.

PERSON, means a natural person or entity doing business as a sole proprietorship, a partnership, a joint venture, a corporation, a limited liability company or partnership, a nonprofit, a trust, or any other entity possessing the legal capacity to contract.

PLANS, means the drawings which show the location, type, dimensions, and details of the Work to be done under the Contract.

PRODUCT DATA, means illustrations, standard schedules, performance charts, instructions, brochures, diagrams and other information furnished by the Contractor to illustrate materials or equipment for some portion of the Work.

PROJECT, means the total undertaking to be accomplished for Owner by architects/engineers, contractors, and other others, including planning, study, design, construction, testing, commissioning, start-up, of which the Work to be performed under the Contract Documents is a part.

PROJECT SITE, means the specific real property on which the Work is to be performed, including designated contiguous staging areas, that is identified in the Plans, Specifications and Drawings.

PUNCH LIST, means the list of Work yet to be completed or deficiencies which need to be corrected in order to achieve Final Completion of the Contract.

RECORD DOCUMENT, means the as-built Plans, Specifications, testing and inspection records, product data, samples, manufacturer and distributor/supplier warranties evidencing transfer of ownership to Owner, operational and maintenance manuals, shop drawings, correspondence, certificate(s) of occupancy, and other documents listed in Subsection B.9.1 of these County General Conditions, recording all Services performed.

SAMPLES, means physical examples which illustrate materials, equipment or workmanship and establish standards by which the Work will be judged.

SHOP DRAWINGS, means drawings, diagrams, schedules and other data specially prepared for the Work by the Contractor or a Subcontractor (including any subsubcontractor), manufacturer, supplier, or distributor to illustrate some portion of the Work.

SOLICITATION DOCUMENT, means an Invitation to Bid, Request for Proposals, Request for Quotes, or other written document issued by Owner that outlines the required Specifications necessary to submit an Offer.

SPECIFICATION, means any description of the physical or functional characteristics of the Work, or of the nature of a supply, service or construction item included in the Solicitation Document. Specifications may include a description of any requirement for inspecting, testing or preparing a supply, service or construction item for delivery and the quantities or qualities of materials to be furnished under the Contract. Specifications generally will state the results or products to be obtained and may, on occasion, describe the method and manner of doing the

Work to be performed. Specifications may be incorporated by reference and/or may be attached to the Contract.

SUBCONTRACTOR, means a Person having a direct contract with the Contractor, or another Subcontractor of any tier, to perform one or more items of the Work.

SUBSTANTIAL COMPLETION, means the date when the Owner accepts in writing the construction, alteration or repair constituting the Work or any designated portion thereof as having reached that state of completion when it may be used or occupied for its intended purpose. Substantial Completion of facilities with operating systems occurs only after thirty (30) continuous Days of successful, trouble-free operation of the operating systems as provided in Section K.3.2.

SUBSTITUTIONS, means items that in function, performance, reliability, quality, and general configuration are the same or better than the product(s) specified. Substitutions also means the performance of the Work by a labor force other than what is submitted in the Offer.

SUPPLEMENTAL GENERAL CONDITIONS, means those conditions that remove from, add to, or modify these County General Conditions. Public Improvement Supplemental General Conditions may be included in the Solicitation Document or may be a separate attachment to the Contract.

UNAVOIDABLE DELAYS, mean delays other than Avoidable Delays that are: (a) to the extent caused by any actions of the Owner, or any other employee or agent of the Owner, or by a separate contractor employed by the Owner; (b) to the extent caused by any Project Site conditions which differ materially from the conditions that would normally be expected to exist and inherent to the construction activities defined in the Contract Documents; or (c) to the extent caused by Force Majeure acts, or events or occurrences.

WORK, means the furnishing of all materials, equipment, labor, transportation, services, incidentals, those permits and regulatory approvals not provided by the owner necessary to successfully complete any individual item or the entire Contract and the carrying out of duties and obligations imposed by the Contract Documents for the Project.

A.2 SCOPE OF WORK

The Work contemplated under the Contract includes all labor, materials, transportation, equipment and services for, and incidental to, the completion of all work in connection with the Project described in the Contract Documents. The Contractor shall perform all Work necessary so that the Project can be legally occupied and fully used for the intended use as set forth in the Contract Documents.

A.3 INTERPRETATION OF CONTRACT DOCUMENTS

A.3.1 Unless otherwise specifically defined in the Contract Documents, words which have well-known technical meanings or construction industry meanings are used in the Contract Documents in accordance with such recognized meanings. Contract Documents are intended to be complementary. Whatever is called for in one, is interpreted to be called for in all. However, in the event of conflicts or discrepancies among the Contract Documents, interpretations will be based on the following descending order of precedence:

- (a) The Contract and any amendments thereto, including Change Orders, with those of later date having precedence over those of an earlier date;
- (b) The Supplemental General Conditions;
- (c) County General Conditions;
- (d) Plans and Specifications;
- (e) The Solicitation Document, and any addenda thereto.

A.3.2 In the case of an inconsistency between Plans and Specifications or within either document not clarified by addendum, the better quality or greater quantity of Work shall be provided in accordance with the Owner's interpretation in writing as determined in Owners sole discretion.

A.3.3 If the Contractor finds discrepancies in, or omissions from the Contract Documents, or if the Contractor is in doubt as to their meaning, the Contractor shall at once notify the Owner. Matters concerning and interpretation of requirements of the Contract Documents will be decided by the Owner in the Owner's sole discretion, who may delegate that duty in some instances to the Architect/Engineer. Responses to Contractor's requests for interpretation of Contract Documents will be made in writing by Owner (or the Architect/Engineer) within any time limits agreed upon or otherwise with reasonable promptness. Contractor shall not proceed without direction in writing from the Owner (or Architect/Engineer).

A.3.4 References to standard specifications, manuals, codes of any technical society, organization or association, to the laws or regulations of any governmental authority, whether such reference be specific or by implication, shall mean the latest standard specification, manual, code, laws or regulations in effect in the jurisdiction where the Project Site is located on the first published date of the Solicitation Document, except as may be otherwise specifically stated.

A.4 EXAMINATION OF PLANS, SPECIFICATIONS, AND PROJECT SITE

A.4.1 It is understood that the Contractor, before submitting an Offer, has made a careful examination of the Contract Documents; has become fully informed as to the quality and quantity of materials and the character of the Work required; and has made a careful examination of the location and conditions of the Work and the sources of supply for materials. The Owner will in no case be responsible for any loss or for any unanticipated costs that may be suffered by the Contractor as a result of the Contractor's failure to acquire full information in advance in regard to all conditions pertaining to the Work. No oral agreement or conversation with any officer, agent, or personnel of the Owner, or with the Architect/Engineer either before or after the execution of the Contract, shall affect or modify any of the terms or obligations herein contained. Contractor shall at all times be responsible for all utility locates regardless of the ownership of such utility infrastructure or service.

A.4.2 Should the Plans or Specifications fail to particularly describe the materials, kind of goods, or details of construction of any aspect of the Work, Contractor shall have the duty to make inquiry of the Owner and Architect/Engineer as to what is required prior to performance of the Work. Absent Specifications to the contrary, the materials or processes that would normally be used to produce first quality finished Work shall be considered a part of the Contract requirements.

A.4.3 Any design errors or omissions noted by the Contractor shall be reported promptly to the Owner, including without limitation, any nonconformity with Applicable Laws.

A.4.4 If the Contractor believes that adjustments to cost or Contract Time are involved because of clarifications or instructions issued by the Owner (or Architect/Engineer) in response to the Contractor's notices or requests for information, the Contractor must submit a written request to the Owner, setting forth the nature and specific extent of the request, including all time and cost impacts against the Contract as soon as possible, but no later than thirty (30) Days after receipt by Contractor of the clarifications or instructions issued. If the Owner denies Contractor's request for additional compensation, additional Contract Time, or other relief

that Contractor believes results from the clarifications or instructions, the Contractor may proceed to file a Claim under Section D.3, Claims Review Process. If the Contractor fails to perform the obligations of Sections A.4.1 to A.4.3, the Contractor shall pay such costs and damages to the Owner as would have been avoided if the Contractor had performed such obligations.

A.4.5 If the Contractor believes that adjustments to cost or Contract Time are involved because of an Unavoidable Delay caused by differing Project Site conditions, the Contractor shall notify the Owner immediately of differing Project Site conditions before the area has been disturbed. The Owner will investigate the area and make a determination as to whether or not the conditions differ materially from either the conditions stated in the Contract Documents or those which could reasonably be expected in execution of this particular Contract. If Contractor and the Owner agrees that a differing Project Site condition exists, any adjustment to compensation or Contract Time will be determined based on the process set forth in Section D.2.2 for adjustments to or deletions from Work. If the Owner disagrees that a differing Project Site condition exists and denies Contractor's request for additional compensation or Contract Time, Contractor may proceed to file a Claim under Section D.3, Claims Review Process.

A.5 INDEPENDENT CONTRACTOR STATUS

The service or services to be performed under the Contract are those of an independent contractor as defined in ORS 670.600. Contractor represents and warrants that it is not an officer, employee or agent of the Owner as those terms are used in ORS 30.265.

A.6 RETIREMENT SYSTEM STATUS AND TAXES

Contractor represents and warrants that it is not a contributing member of the Public Employees' Retirement System and will be responsible for any federal or state taxes applicable to payment received under the Contract. Contractor will not be eligible for any benefits from these Contract payments of federal Social Security, employment insurance, workers' compensation or the Public Employees' Retirement System, except as a self-employed individual. Unless the Contractor is subject to backup withholding, Owner will not withhold from such payments any amount(s) to cover Contractor's federal or state tax obligations.

A.7 GOVERNMENT EMPLOYMENT STATUS

A.7.1 If this payment is to be charged against federal funds, Contractor represents and warrants that it is not currently employed by the Federal Government. This does not preclude the Contractor from holding another contract with the Federal Government.

SECTION B **ADMINISTRATION OF THE CONTRACT**

B.1 OWNER'S ADMINISTRATION OF THE CONTRACT

B.1.1 The Owner shall administer the Contract as described in the Contract Documents throughout the term of the Contract, including the one-year period for correction of Work. The Owner will act as provided in the Contract Documents, unless modified in writing in accordance with other provisions of the Contract. In performing these tasks, the Owner may rely on the Architect/Engineer or other agents to perform some or all of these tasks.

B.1.2 The Owner may visit the Project Site at intervals appropriate to the stage of the Contractor's operations (1) to become generally familiar with and to keep the Owner informed about the progress and quality of the portion of the Work completed, (2) to endeavor to guard the Owner against defects and deficiencies in the Work, and (3) to determine in general if Work is being performed in a manner indicating that the Work, when fully completed, will be in accordance with the Contract Documents. The Owner will not

make exhaustive or continuous on-Project Site inspections to check the quality or quantity of the Work. Unless otherwise required in a Change Order, the Owner will neither have control over or charge of, nor be responsible for the construction means, methods, techniques, sequences or procedures, or for the safety precautions and programs in connection with the Work.

B.1.3 Except as otherwise provided in the Contract Documents or when direct communications have been specifically authorized, the Owner and Contractor shall communicate with each other within a reasonable time frame about matters arising out of or relating to the Contract. Communications by and with the Architect/Engineer's consultants shall be through the Architect/Engineer. Communications by and with Subcontractors and material suppliers shall be through the Contractor. Communications by and with separate contractors shall be through the Owner.

B.1.4 Based upon the Architect/Engineer's evaluations of the Contractor's Application for Payment, or unless otherwise stipulated by the Owner, the Architect/Engineer will review and certify the amounts due the Contractor and will issue Certificates for Payment in such amounts.

B.2 CONTRACTOR'S MEANS AND METHODS; MITIGATION OF IMPACTS

B.2.1 The Contractor shall supervise and direct the Work, using the Contractor's best skill and attention. The Contractor shall be solely responsible for and have control over construction means, methods, techniques, sequences and procedures and for coordinating all portions of the Work under the Contract, unless the Contract Documents give other specific instructions concerning these matters. If the Contract Documents give specific instructions concerning construction means, methods, techniques, sequences or procedures, the Contractor shall evaluate the Project Site safety thereof and, except as stated below, shall be fully and solely responsible for the Project Site safety of such means, methods, techniques, sequences or procedures.

B.2.2 The Contractor is responsible to protect and maintain the Work during the course of construction and to mitigate any adverse impacts to the Project, including those caused by authorized changes, which may affect cost, schedule, or quality.

B.2.3 The Contractor is responsible for the actions of all its personnel, laborers, suppliers, agents, and Subcontractors on the Project. The Contractor shall enforce strict discipline and good order among Contractor's employees and other persons carrying out the Work. The Contractor shall not permit employment of persons who are unfit or unskilled for the tasks assigned to them.

B.3 MATERIALS AND WORKMANSHIP

B.3.1 The intent of the Contract Documents is to provide for the construction and completion of every detail of the Work described. All Work shall be performed in a professional manner and, unless the means or methods of performing a task are specified elsewhere in the Contract Documents, Contractor shall employ methods that are generally accepted and used by the industry, in accordance with industry standards.

B.3.2 The Contractor is responsible to perform the Work as required by the Contract Documents. Defective Work shall be corrected at the Contractor's sole expense and within a reasonable time frame.

B.3.3 Work done and materials furnished may be subject to inspection and/or observation and testing by the Owner to determine if they conform to the Contract Documents. Inspection of the Work by the Owner does not relieve the Contractor of responsibility for the Work in accordance with the Contract Documents.

B.3.4 Contractor shall furnish adequate facilities, as required, for the Owner to have safe access to the Work including without limitation walkways, railings, ladders, tunnels, and platforms. Producers, suppliers, and fabricators shall also provide proper facilities and access to their facilities.

B.3.5 The Contractor shall furnish Samples of materials for testing by the Owner and include the cost of the Samples in the Contract Price.

B.4 PERMITS

Contractor shall obtain and pay for all necessary permits, licenses and fees, except for those specifically excluded in the Supplemental General Conditions, as required for the project. Contractor shall be responsible for all violations of the law. Contractor shall give all requisite notices to public authorities.

B.5 COMPLIANCE WITH GOVERNMENT REGULATIONS

B.5.1 Contractor shall comply with Applicable Laws, as amended pertaining to the Work and the Contract. Failure to comply with such requirements shall constitute a breach of Contract and shall be grounds for Contract termination. Without limiting the generality of the foregoing, Contractor expressly agrees to comply with the following, as applicable and as may be amended from time to time:

- (i) Title VI and VII of Civil Rights Act of 1964, as amended; (ii) Section 503 and 504 of the Rehabilitation Act of 1973, as amended; (iii) the Health Insurance Portability and Accountability Act of 1996; (iv) the Americans with Disabilities Act of 1990, as amended; (v) ORS Chapter 659A; as amended; (vi) all regulations and administrative rules established pursuant to any applicable laws; and (vii) all other applicable requirements of federal, state, county or other local government entity statutes, rules and regulations.

B.5.2 Contractor shall comply with all applicable requirements of federal and state civil rights and rehabilitation statutes, rules and regulations, and

- (a) Contractor shall not discriminate against Disadvantaged, Minority, Women or Emerging Small Business enterprises, as those terms are defined in ORS 200.005, or a business enterprise that is owned or controlled by or that employs a disabled veteran, as that term is defined in ORS 408.225, in the awarding of subcontracts.
- (b) Contractor shall maintain, in current and valid form, all licenses and certificates required by Applicable Laws or the Contract when performing the Work.

B.5.3 Contractor shall certify that it shall not accept a bid from Subcontractors to perform Work unless such Subcontractors are registered with the Construction Contractors Board in accordance with ORS 701.021 at the time they submit their bids to the Contractor.

B.5.4 Contractor shall certify that each landscape contracting business, as defined in ORS 671.520(2), performing Work under the Contract holds a valid landscape construction professional license issued pursuant to ORS 671.560.

B.5.5 The following notice is applicable to Contractors who perform excavation Work. ATTENTION: Oregon law requires you to follow rules adopted by the Oregon Utility Notification Center. Those rules are set forth in OAR 952-001-0010 through OAR 952-001-0090. You may obtain copies of the rules by calling the center at (877) 668-4001.

B.5.6 Failure to comply with any or all of the requirements of B.5.1 through B.5.5 shall be a material breach of Contract and constitute

grounds for Contract termination. Damages or costs resulting from such noncompliance shall be the responsibility of Contractor.

B.5.7 The Contractor shall include in each subcontract those provisions required under ORS 279C.580.

B.5.8 Contractor shall comply with ORS 652.220, compliance of which is a material element of this Contract and failure to comply is a material breach that entitles County to exercise any rights and remedies available under this Contract including, but not limited to, termination for default.

B.6 SUPERINTENDENCE

Contractor shall keep on the Project Site, during the progress of the Work, a competent superintendent and any necessary assistants who shall be satisfactory to the Owner and who shall represent the Contractor on the Project Site. Directions given to the superintendent by the Owner shall be confirmed in writing to the Contractor.

B.7 INSPECTION

B.7.1 Owner shall have access to the Work at all times.

B.7.2 Inspection of the Work will be made by the Owner at its discretion. The Owner will have authority to reject Work that does not conform to the Contract Documents in the Owner's sole discretion. Any Work found to be not in conformance with the Contract Documents, in the discretion of the Owner, shall be removed and replaced at the Contractor's expense.

B.7.3 Contractor shall make or obtain at the appropriate time all tests, inspections and approvals of portions of the Work required by the Contract Documents or by Applicable Laws or orders of public authorities having jurisdiction. Unless otherwise provided, the Contractor shall make arrangements for such tests, inspections and approvals with an independent testing laboratory or entity acceptable to the Owner, or with the appropriate public authority, and shall bear all related costs of tests, inspections and approvals. Tests or inspections conducted pursuant to the Contract Documents shall be made promptly to avoid unreasonable delay in the Work. The Contractor shall give the Owner timely notice of when and where tests and inspections are to be made so that the Owner may be present for such procedures. Required certificates of testing, inspection or approval shall, unless otherwise required by the Contract Documents, be secured by the Contractor and promptly delivered to the Owner.

B.7.4 As required by the Contract Documents, Work done or material used without required inspection or testing and/or without providing timely notice to the Owner may be ordered removed at the Contractor's expense.

B.7.5 If directed to do so by Owner or other permitting authority any time before the Work is accepted, the Contractor shall uncover portions of the completed Work for inspection. After inspection, the Contractor shall restore such portions of Work to the standard required by the Contract. If the Work uncovered is unacceptable or was done without required testing or inspection or sufficient notice to the Owner, the uncovering and restoration shall be done at the Contractor's expense. If the Work uncovered is acceptable and was done with sufficient notice to the Owner, the uncovering and restoration will be paid for pursuant to a Change Order.

B.7.6 If any testing or inspection reveals failure of the portions of the Work to comply with requirements established by the Contract Documents, all costs made necessary by such failure, including those of repeated procedures and compensation for the Owner's and Architect/Engineer's services and expenses, shall be at the Contractor's expense.

B.7.7 In Owner's sole discretion, it may authorize other interested parties to inspect the Work affecting their interests or property. Their right to inspect shall not make them a party to the Contract and shall not interfere with the rights of the parties of the Contract. Instructions or orders of such parties shall be transmitted to the Contractor, through the Owner.

B.8 SUBCONTRACTS AND ASSIGNMENT

B.8.1 Contractor shall require each Subcontractor, to the extent of the Work to be performed by the Subcontractor, to be bound by the terms and conditions of these General Conditions and Supplemental General Conditions, and to assume toward the Contractor all of the obligations and responsibilities which the Contractor assumes toward the Owner thereunder, unless (1) the same are clearly inapplicable to the subcontract at issue because of legal requirements or industry practices, or (2) specific exceptions are requested by Contractor and approved in writing by Owner. Where appropriate, Contractor shall require each Subcontractor to enter into similar agreements with sub-subcontractors at any level.

B.8.2 At Owner's request, Contractor shall submit to Owner prior to their execution either Contractor's form of subcontract, or the subcontract to be executed with any particular Subcontractor. If Owner disapproves such form, Contractor shall not execute the form until the matters disapproved are resolved to Owner's satisfaction. Owner's review, comment upon or approval of any such form shall not relieve Contractor of its obligations under this Agreement or be deemed a waiver of such obligations of Contractor.

B.8.3 Contractor shall not assign, sell, or transfer its rights, or delegate its responsibilities under the Contract, in whole or in part, without the prior written approval of the Owner. No such written approval shall relieve Contractor of any obligations of the Contract, and any transferee shall be considered the agent of the Contractor and bound to perform in accordance with the Contract Documents. Contractor shall remain liable as between the original parties to the Contract as if no assignment had occurred.

B.9 OWNER'S RIGHT TO DO WORK

Owner reserves the right to perform other or additional work at or near the Project Site with other agents than those of the Contractor. If such work takes place within or next to the Project Site, Contractor shall coordinate work with the other contractors or agents, cooperate with all other contractors or forces, carry out the Work in a way that will minimize interference and delay for all agents involved, place and dispose of materials being used so as not to interfere with the operations of another, and join the Work with the work of the others in an acceptable manner and perform it in proper sequence to that of the others. The Owner will resolve any disagreements that may arise between or among Contractor and the other contractors over the method or order of doing all work (including the Work). In case of unavoidable interference, the Owner will establish work priority (including the Work) in the Owner's sole discretion.

B.10 OTHER CONTRACTS

In all cases and at any time, the Owner has the right to execute other contracts related to or unrelated to the Work of the Contract. The Contractor of the Contract shall fully cooperate with any and all other contractors without additional cost to the Owner in the manner described in Section B.13.

B.11 ALLOWANCES

B.11.1 The Contractor shall include in the Contract Price all allowances stated in the Contract Documents. Items covered by allowances

shall be supplied for such amounts and by such persons or entities as the Owner may direct.

B.11.2 Unless otherwise provided in the Contract Documents:

- (a) when finally reconciled, allowances shall cover the cost of the Contractor's materials and equipment delivered at the Project Site and all required taxes, less applicable trade discounts;
- (b) Contractor's costs for unloading and handling at the Project Site, labor, installation costs, Overhead, profit and other expenses contemplated for stated allowance amounts shall be included in the Contract Price but not in the allowances;
- (c) whenever costs are more than or less than allowances, the Contract Price shall be adjusted accordingly by Change Order. The amount of the Change Order shall reflect (i) the difference between actual costs and the allowances under Section B.17.2(a) and (ii) changes in Contractor's costs under Section B.17.2(b);
- (d) Unless Owner requests otherwise, Contractor shall provide to Owner a proposed fixed price for any allowance work prior to its performance.

B.12 SUBMITTALS, SHOP DRAWINGS, PRODUCT DATA AND SAMPLES

B.12.1 The Contractor shall prepare and keep current, for the Architect's/Engineer's approval (or for the approval of Owner if approval authority has not been delegated to the Architect/Engineer), a schedule and list of submittals which is coordinated with the Contractor's construction schedule and allows the Architect/Engineer reasonable time to review submittals. Owner reserves the right to finally approve the schedule and list of submittals. Submittals include, without limitation, Shop Drawings, Product Data, and Samples.

B.12.2 Shop Drawings, Product Data, Samples and similar submittals are not Contract Documents. The purpose of their submittal is to demonstrate for those portions of the Work for which submittals are required by the Contract Documents the way by which the Contractor proposes to conform to the information given and the design concept expressed in the Contract Documents. Review of submittals by the Architect/Engineer is not conducted for the purpose of determining the accuracy and completeness of other details such as dimensions and quantities, or for substantiating instructions for installation or performance of equipment or systems, or for approval of safety precautions or, unless otherwise specifically stated by the Architect/Engineer, of any construction means, methods, techniques, sequences or procedures, all of which remain the responsibility of the Contractor as required by the Contract Documents. The Architect/Engineer's review of the Contractor's submittals shall not relieve the Contractor of its obligations under the Contract Documents. The Architect/Engineer's approval of a specific item shall not indicate approval of an assembly of which the item is a component. Informational submittals upon which the Architect/Engineer is not expected to take responsive action may be so identified in the Contract Documents. Submittals which are not required by the Contract Documents may be returned by the Architect/Engineer without action.

B.12.3 The Contractor shall review for compliance with the Contract Documents, approve and submit to the Architect/Engineer Shop Drawings, Product Data, Samples and similar submittals required by the Contract Documents with reasonable promptness and in such sequence as to cause no delay in the Work or in the activities of the Owner or of separate contractors. Submittals which are not marked as reviewed for compliance with the Contract Documents

and approved by the Contractor may be returned by the Architect/Engineer without action.

B.12.4 By approving and submitting Shop Drawings, Product Data, Samples and similar submittals, the Contractor represents that the Contractor has determined and verified materials, field measurements and field construction criteria related thereto, or will do so, and has checked and coordinated the information contained within such submittals with the requirements of the Work and of the Contract Documents.

B.12.5 The Contractor shall perform no portion of the Work for which the Contract Documents require submittal and review of Shop Drawings, Product Data, Samples or similar submittals until the respective submittal has been approved by the Architect/Engineer.

B.12.6 The Work shall be in accordance with approved submittals except that the Contractor shall not be relieved of responsibility for deviations from requirements of the Contract Documents by the Architect/Engineer's review or approval of Shop Drawings, Product Data, Samples or similar submittals unless the Contractor has specifically informed the Architect/Engineer in writing of such deviation at the time of submittal and (i) the Architect/Engineer has given written approval to the specific deviation as a minor change in the Work, or (ii) a Change Order has been executed by Owner authorizing the deviation. The Contractor shall not be relieved of responsibility for errors or omissions in Shop Drawings, Product Data, Samples or similar submittals by the Architect/Engineer's review or approval thereof.

B.12.7 In the event that Owner elects not to have the obligations and duties described under this Section B.18 performed by the Architect/Engineer, or in the event no Architect/Engineer is employed by Owner on the Project, all obligations and duties assigned to the Architect/Engineer hereunder shall be performed by the Owner.

B.13 SUBSTITUTIONS

The Contractor may make Substitutions only with the written consent of the Owner, after evaluation by the Owner and only in accordance with a Change Order. Substitutions shall be subject to the requirements of the Solicitation Document. By making requests for Substitutions, the Contractor represents that the Contractor has personally investigated the proposed substitute product; represents that the Contractor will provide the same warranty for the Substitution that the Contractor would for the product originally specified unless approved otherwise; certifies that the cost data presented is complete and includes all related costs under the Contract including redesign costs, and waives all claims for additional costs related to the Substitution which subsequently become apparent; and will coordinate the installation of the accepted Substitution, making such changes as may be required for the Work to be completed in all respects.

B.14 USE OF PLANS AND SPECIFICATIONS

Plans, Specifications and related Contract Documents furnished to Contractor by Owner or Owner's Architect/Engineer shall be used solely for the performance of the Work under the Contract. Contractor and its Subcontractors and suppliers are authorized to use and reproduce applicable portions of such documents appropriate to the execution of the Work, but shall not claim any ownership or other interest in them beyond the scope of the Contract, and no such interest shall attach. Unless otherwise indicated, all common law, statutory and other reserved rights, in addition to copyrights, are retained by Owner.

SECTION C
WAGES AND LABOR

C.1 PREVAILING WAGE RATES ON PUBLIC WORKS

Contractor shall comply fully with the provisions of ORS 279C.800 through 279C.870. Pursuant to ORS 279C.830(1)(d), Contractor shall pay workers at not less than the specified minimum hourly rate of wage, and shall include that requirement in all subcontracts. If the Work is subject to both the state prevailing wage rate law and the federal Davis-Bacon Act, Contractor shall pay the higher of the applicable state or federal prevailing rate of wage. Contractor shall provide written notice to all workers of the number of hours per day and days per week such workers may be required to work.

C.2 PAYROLL CERTIFICATION AND FEE REQUIREMENTS

C.2.1 In accordance with ORS 279C.845, the Contractor and every Subcontractor shall submit written certified statements to the Owner on the form prescribed by the Commissioner of the Bureau of Labor and Industries ("BOLI"), certifying the hourly rate of wage paid each worker which the Contractor or the Subcontractor has employed on the Project and further certifying that no worker employed on the Project has been paid less than the prevailing rate of wage or less than the minimum hourly rate of wage specified in the Contract, which certificate and statement shall be verified by the oath of the Contractor or the Subcontractor that the Contractor or Subcontractor has read the certified statement, that the Contractor or Subcontractor knows the contents of the certified statement, and, that to the Contractor's or Subcontractor's best knowledge and belief, the certified statement is true. The certified statements shall set out accurately and completely the payroll records for the prior week, including the name and address of each worker, the worker's correct classification, rate of pay, daily and weekly number of hours worked, deductions made, and actual wages paid. Certified statements for each week during which the Contractor or Subcontractor has employed a worker on the Project shall be submitted once a month, by the fifth (5th) business day of the following month. The Contractor and Subcontractors shall preserve the certified statements for a period of ten (10) years from the date of completion of the Contract.

C.2.2 Pursuant to ORS 279C.845(7), the Owner shall retain 25 percent of any amount earned by the Contractor on the Project until the Contractor has filed the certified statements required by section C.2.1. The Owner shall pay to the Contractor the amount retained under this subsection within 14 days after the Contractor files the required certified statements, regardless of whether a Subcontractor has failed to file certified statements.

C.2.3 Pursuant to ORS 279C.845(8), the Contractor shall retain 25 percent of any amount earned by a first-tier Subcontractor on this Project until the first-tier Subcontractor has filed with the Owner the certified statements required by C.2.1. Before paying any amount retained under this subsection, the Contractor shall verify that the first-tier Subcontractor has filed the certified statement. Within 14 days after the first-tier Subcontractor files the required certified statement the Contractor shall pay the first-tier Subcontractor any amount retained under this subsection.

C.2.4 In accordance with statutory requirements and administrative rules promulgated by the Commissioner of the Bureau of Labor and Industries, the fee required by ORS 279C.825(1) will be paid by Owner to the Commissioner.

C.3 PROMPT PAYMENT AND CONTRACT CONDITIONS

C.3.1 As a condition to Owner's performance hereunder, the Contractor shall:

C.3.1.1 Make payment promptly, as due, to all persons supplying to Contractor labor or materials for the prosecution of the Work provided for in the Contract.

C.3.1.2 Pay all contributions or amounts due the State Industrial Accident Fund or successor program from such Contractor or Subcontractor incurred in the performance of the Contract.

C.3.1.3 Not permit any lien or claim to be filed or prosecuted against the Owner on account of any labor or material furnished. Contractor will not assign any claims that Contractor has against Owner, or assign any sums due by Owner, to Subcontractors, suppliers, or manufacturers, and will not make any agreement or act in any way to give Subcontractors a claim or standing to make a claim against the Owner.

C.3.1.4 Pay to the Department of Revenue all sums withheld from employees pursuant to ORS 316.167.

C.3.2 If Contractor fails, neglects or refuses to make prompt payment of any claim for labor or services furnished to the Contractor of a Subcontractor by any person in connection with the Project as such claim becomes due, the proper officer(s) representing the Owner may pay the claim and charge the amount of the payment against funds due or to become due Contractor under the Contract. Payment of claims in this manner shall not relieve the Contractor or the Contractor's surety from obligation with respect to any unpaid claims.

C.3.3 Contractor shall include in each subcontract for property or services entered into by the Contractor and a first-tier subcontractor, including a material supplier, for the purpose of performing a construction contract, a payment clause that obligates the Contractor to pay the first-tier Subcontractor for satisfactory performance under its subcontract within ten (10) Days out of such amounts as are paid to the Contractor by the Owner under such contract.

C.3.4 If the Contractor or a first-tier subcontractor fails, neglects or refuses to pay a person that provides labor or materials in connection with the Contract within 30 days after receiving payment from the contracting agency or a contractor, the Contractor or first-tier subcontractor owes the person the amount due plus interest charges that begin at the end of the 10-day period within which payment is due under ORS 279C.580 (4) and that end upon final payment, unless payment is subject to a good faith dispute as defined in ORS 279C.580. The rate of interest on the amount due is nine percent per annum. The amount of interest may not be waived.

C.3.5 If the Contractor or a subcontractor fails, neglects or refuses to make payment to a person furnishing labor or materials in connection with the Contract, the person may file a complaint with the Construction Contractors Board, unless payment is subject to a good faith dispute as defined in ORS 279C.580.

C.3.6 All employers, including Contractor, that employ subject workers who work under the Contract in the State of Oregon shall comply with ORS 656.017 and provide the required Workers' Compensation coverage, unless such employers are exempt under ORS 656.126. Contractor shall ensure that each of its Subcontractors complies with these requirements.

C.3.7 In accordance with ORS 279C.570, for all subcontracts that exceed \$500,000 that the Contractor withholds retainage, the Contractor shall place amounts deducted as retainage into an interest-bearing escrow account. Interest on the retainage amount accrues from the

date the payment request is approved until the date the retainage is paid to the Subcontractor to which it is due.

C.4 PAYMENT FOR MEDICAL CARE

As a condition to Owner's performance hereunder, Contractor shall promptly, as due, make payment to any person, co-partnership, association or corporation furnishing medical, surgical, and hospital care or other needed care and attention, incident to sickness or injury, to the employees of the Contractor, of all sums of which the Contractor agrees to pay for the services and all moneys and sums that the Contractor collected or deducted from the wages of employees under any law, contract or agreement for the purpose of providing or paying for the services.

C.5 HOURS OF LABOR

As a condition to Owner's performance hereunder, no person shall be employed to perform Work under the Contract for more than ten (10) hours in any one day or forty (40) hours in any one week, except in cases of necessity, emergency or where public policy absolutely requires it. In such instances, Contractor shall pay the employee at least time and a half pay:

- (a) For all overtime in excess of eight (8) hours a day or forty (40) hours in any one week when the work week is five consecutive Days, Monday through Friday; or
- (b) For all overtime in excess of ten (10) hours a day or forty (40) hours in any one week when the work week is four consecutive Days, Monday through Friday; and
- (c) For all Work performed on Saturday and on any legal holiday specified in ORS 279C.540.

This Section C.5 will not apply to Contractor's Work under the Contract to the extent Contractor is currently a party to a collective bargaining agreement with any labor organization.

This Section C.5 shall not excuse Contractor from completion of the Work within the time required under the Contract.

SECTION D CHANGES IN THE WORK

D.1 CHANGES IN WORK

D.1.1 The terms of the Contract shall not be waived, altered, modified, supplemented or amended in any manner whatsoever, without prior written agreement and then only after any necessary approvals have been obtained. A Change Order is required to modify the Contract, which shall not be effective until its execution by the parties to the Contract and all approvals required by public contracting laws have been obtained.

D.1.2 It is mutually agreed that changes in Plans, quantities, or details of construction may be necessary or desirable during the course of construction. Within the general scope of the Contract, the Owner may at any time, without notice to the sureties and without impairing the Contract, require changes it deems necessary or desirable within the scope of this Project and consistent with this Section D.1. All changes to the Work shall be documented and Change Orders shall be executed under the conditions of the Contract Documents. Such changes may include, but are not limited to:

- (a) Modification of specifications and design.
- (b) Increases or decreases in quantities.
- (c) Increases or decreases to the amount of Work.
- (d) Addition or elimination of any Work item.
- (e) Change in the duration of the Project.

- (f) Acceleration or delay in performance of Work.
- (g) Deductive changes.

Deductive changes are those that reduce the scope of the Work, and shall be made by mutual agreement whenever feasible. In cases of suspension or partial termination under Section J, Owner reserves the right to unilaterally impose a deductive change and to self-perform such Work, for which the provisions of Section B.13 (Owner's Right to Do Work) shall then apply. Adjustments in compensation shall be made under Section D.1.3, in which costs for deductive changes shall be based upon a Direct Costs adjustment together with the related percentage markup specified for profit, Overhead and other indirect costs, unless otherwise agreed to by Owner.

D.1.3 The Owner and Contractor agree that adjustments to or deletions from the Work shall be administered and compensated according to the following:

- (a) Unit Pricing: Unit pricing may be utilized at the Owner's option when unit prices or solicitation alternates were provided that established the cost for adjustments to Work, and a binding obligation exists under the Contract on the parties covering the terms and conditions of the adjustment to Work.
- (b) Fixed Fee: If the Owner elects not to utilize unit pricing, or in the event that unit pricing is not available or appropriate, fixed pricing may be used for adjustments to or deletions from the Work. In fixed pricing, the basis of payments or total price shall be agreed upon in writing between the parties to the Contract, and shall be established before the Work is done whenever feasible. Notwithstanding the foregoing, the mark-ups set forth in Section D.1.3(c) shall be utilized in establishing fixed pricing, and such mark-ups shall not be exceeded. Cost and price data relating to adjustments to or deletions from the Work shall be supplied by Contractor to Owner upon request, but Owner shall be under no obligation to make such requests.
- (c) Time and Material: In the event that unit pricing and fixed pricing are not utilized, then adjustments to or deletions from the Work shall be performed on a cost reimbursement basis for Direct Costs. Such Work shall be compensated on the basis of the actual, reasonable and allowable cost of labor, equipment, and material furnished on the Work performed. The Contractor or Subcontractor who performs the Work shall be allowed to add up to ten percent (10%) markup to the Direct Costs as full compensation for profit, Overhead and other indirect costs for Work performed with the Contractor's or Subcontractor's own agents

Each ascending tier Subcontractor or the Contractor that did not perform the Work, will be allowed to add up to five percent (5%) supplemental markup on the Direct Costs of the Work (but not the above allowable markups) covered by a Change Order. No additional markup shall be permitted for any third tier or greater descending Subcontractor.

Example: \$20,000 of Direct Costs Work performed by a 2nd Tier Subcontractor

	Markup	Allowed Total Fee Plus Markup
General Contractor	5%	\$1,000.00
1 st Tier Sub Contractor	5%	\$1,000.00
2 nd Tier Sub Contractor	10%	\$22,000.00

- (d) Payments made to the Contractor shall be complete compensation for Overhead, profit, and all costs that were incurred by the Contractor or by other agents furnished by the Contractor, including Subcontractors, for adjustments to or deletions from the Work pursuant to a Change Order. Owner may establish a maximum cost for additional Work under this Section D.1.3, which shall not be exceeded for reimbursement without additional written

authorization from Owner in the form of a Change Order. Contractor shall not be required to complete such additional Work without additional authorization.

D.1.4 Any necessary adjustment of Contract Time that may be required as a result of adjustments to or deletions from the Work must be agreed upon by the parties before the start of the revised Work unless Owner authorizes Contractor to start the revised Work before agreement on Contract Time adjustment.

Contractor shall submit any request for additional compensation (and additional Contract Time if Contractor was authorized to start Work before an adjustment of Contract Time was approved) as soon as possible but no later than thirty (30) Days after receipt of Owner's request for additional Work. If Contractor's request for additional compensation or adjustment of Contract Time is not made within the thirty (30) Day time limit, Contractor's requests pertaining to that additional Work shall be barred. The thirty (30) Day time limit for making requests shall not be extended for any reason, including without limitation Contractor's claimed inability to determine the amount of additional compensation or adjustment of Contract Time, unless an extension is granted in writing by Owner. If the Owner denies Contractor's request for additional compensation or adjustment of Contract Time, Contractor may proceed to file a Claim under Section D.3, Claims Review Process. No other reimbursement, compensation, or payment will be made, except as provided in Section D.1.5 for impact claims.

D.1.5 If any adjustment to Work under Section D.1.3 causes an increase or decrease in the Contractor's cost of, or the Contract Time required for the performance of any other part of the Work under the Contract, Contractor shall submit a written request to the Owner, setting forth the nature and specific extent of the request, including all time and cost impacts against the Contract as soon as possible, but no later than thirty (30) Days after receipt of Owner's request for adjustments to or deletions from the Work by Contractor.

The thirty (30) Day time limit applies to claims of Subcontractors, suppliers, or manufacturers who may be affected by Owner's request for adjustments to or deletions from the Work and who request additional compensation or an extension of Contract Time to perform; Contractor has responsibility for contacting its Subcontractors, suppliers, or manufacturers within the thirty (30) Day time limit, and including their requests with Contractor's requests. If the request involves Work to be completed by Subcontractors, or materials to be furnished by suppliers or manufacturers, such requests shall be submitted to the Contractor in writing with full analysis and justification for the adjustments to compensation and Contract Time requested. The Contractor shall analyze and evaluate the merits of the requests submitted by Subcontractors, suppliers, and manufacturers to Contractor prior to including those requests and Contractor's analysis and evaluation of those requests with Contractor's requests for adjustments to compensation or Contract Time that Contractor submits to the Owner. Failure of Subcontractors, suppliers, manufacturers or others to submit their requests to Contractor for inclusion with Contractor's requests submitted to Owner within the time period and by the means described in this section shall constitute a waiver of these Subcontractor claims. The Owner will not consider direct requests or claims from Subcontractors, suppliers, manufacturers or others not a party to the Contract. The consideration of such requests and claims under this section does not give any Person, not a party to the Contract the right to bring a claim against Owner, whether in this claims process, in litigation, or in any dispute resolution process.

If the Owner denies the Contractor's request for adjustment to compensation or Contract Time, the Contractor may proceed to file a Claim under Section D.3, Claims Review Process.

D.1.6 No request or Claim by the Contractor for additional costs or an adjustment of Contract Time shall be allowed if made after receipt of final payment application under the Contract. Final payment application must be made by Contractor within the time required under Section E.6.4.

D.1.7 It is understood that changes in the Work are inherent in construction of this type. The number of changes, the scope of those changes, and the effect they have on the progress of the original Work cannot be defined at this time. The Contractor agrees that it will work in good faith with Owner to undertake changes, when agreed upon by execution of a Change Order. Each change will be evaluated for extension of Contract Time and increase or decrease in compensation based on its own merit.

D.2 DELAYS

D.2.1 Contractor shall not be entitled to additional compensation or additional Contract Time for Avoidable Delays.

D.2.2 In the event of Unavoidable Delays, Contractor may be entitled to the following:

- (a) Contractor may be entitled to additional compensation or additional Contract Time, or both, for Unavoidable Delays described in Section D.2.1.2 (a) and (b).
- (b) Contractor may be entitled to additional Contract Time for Unavoidable Delays described in Section D.2.1.2(c) and (d).

In the event of any requests for additional compensation or additional Contract Time, or both, as applicable, arising under this Section D.2.2 for Unavoidable Delays, other than requests for additional compensation or additional Contract Time for differing Project Site conditions for which a review process is established under Section A.4.5, Contractor shall submit a written notification of the delay to the Owner within two (2) Days of the occurrence of the cause of the delay. This written notification shall state the cause of the potential delay, the Project components impacted by the delay, and the anticipated additional Contract Time extension or the additional compensation, or both, as applicable, resulting from the delay. Within seven (7) Days after the cause of the delay has been mitigated, or in no case more than thirty (30) Days after the initial written notification, the Contractor shall submit to the Owner, a complete and detailed request for additional compensation or additional Contract Time, or both, as applicable, resulting from the delay. If the Owner denies Contractor's request for additional compensation or adjustment of Contract Time, the Contractor may proceed to file a Claim under Section D.3, Claims Review Process.

If Contractor does not timely submit the notices required under this Section D.2, Contractor's Claim shall be barred.

D.3 CLAIMS REVIEW PROCESS

D.3.1 All Contractor Claims shall be referred to the Owner for review. Contractor's Claims, including Claims for adjustments to compensation or Contract Time, shall be submitted in writing by Contractor to the Owner within five (5) Days after a denial of Contractor's initial request for an adjustment of Contract terms, payment of money, extension of Contract Time or other relief, provided that such initial request has been submitted in accordance with the requirements and within the time limits established in these County General Conditions. Within thirty (30) Days after the initial Claim, Owner shall receive from Contractor a complete and detailed description of the Claim (the "Detailed Notice") that includes all information required by Section D.3.2. Unless the Claim is made in accordance with these time requirements, it shall be barred.

D.3.2 The Detailed Notice of the Claim shall be submitted in writing by Contractor and shall include all information, records and documentation necessary for the Owner to properly and completely evaluate the claim, including, but not limited to a detailed, factual statement of the basis of the Claim, pertinent dates, Contract provisions which support or allow the Claim, reference to or copies of any documents which support the Claim, the dollar value of the Claim, and the Contract Time adjustment requested for the Claim. If the Claim involves Work to be completed by Subcontractors, the Contractor will analyze and evaluate the merits of the Subcontractor claim prior to forwarding it and that analysis and evaluation to the Owner. The Owner will not consider direct claims from Subcontractors, suppliers, manufacturers, or others not a party to the Contract. Contractor agrees that it will make no agreement, covenant, or assignment, nor will it commit any other act that will permit or assist any Subcontractor, supplier, manufacturer, or other to directly or indirectly make a claim against Owner.

D.3.3 The Owner, through the Architect/Engineer (or other employee or agent assigned by the Owner) will review all Claims and take one or more of the following preliminary actions within ten (10) Days of receipt of the Detailed Notice of a Claim: (1) request additional supporting information from the Contractor; (2) inform the Contractor and Owner in writing of the time required for adequate review and response; (3) reject the Claim in whole or in part and identify the reasons for rejection; (4) recommend approval of all or part of the Claim; (5) arrange a meeting with the Contractor for formal review of the Claim; or (6) propose an alternate resolution.

D.3.4 Once the Engineer or Project Manager determines the Owner is in receipt of a properly submitted claim, the Engineer or Project Manager may arrange a meeting, as agreed by the parties, with the Contractor in order to present the claim for formal review and discussion. A person authorized by the Contractor to execute Change Orders on behalf of the Contractor must be present and attend all claim meetings.

D.3.5 The Owner's decision, through the Architect/Engineer (or other employee or agent assigned by the Owner), shall be final and binding on the Contractor unless appealed by written notice to the Owner within fifteen (15) Days of receipt of the decision. The Contractor must present written documentation supporting the Claim within fifteen (15) Days of the notice of appeal. After receiving the appeal documentation, the Owner, through the appropriate department director, shall review the materials and render a decision within thirty (30) Days after receiving the appeal documents.

D.3.6 If, at any step in the claim decision or review process, the Contractor fails to promptly submit requested information or documentation that the Owner deems necessary to analyze the claim, the Contractor is deemed to have waived its right to further review, and the Claim will not be considered properly filed and preserved.

D.3.7 Both parties agree to exercise their best efforts in good faith to resolve all disputes within sixty (60) Days of the issuance of the appeal in Section D. 3.4 above. If the parties are unable to resolve their issues through mediation or otherwise, either party may seek redress through all available remedies in equity or in law.

D.3.8 Unless otherwise directed by Owner, Contractor shall proceed with the Work while any Claim, or mediation or litigation arising from a Claim, is pending. Regardless of the review period or the final decision of the Owner, the Contractor shall continue to diligently pursue the Work as identified in the Contract Documents. In no case is the Contractor justified or allowed to cease or delay Work, in whole or in part, without a written stop work order from the Owner.

SECTION E PAYMENTS

E.1 SCHEDULE OF VALUES

The Contractor shall submit, by or before the pre-construction conference (as described in Section H.1.3), a schedule of values ("Schedule of Values") for the Contract Work. This schedule shall provide a breakdown of values for the Contract Work and will be the basis for progress payments. The breakdown shall demonstrate reasonable, identifiable, and measurable components of the Work. Unless objected to by the Owner, this schedule shall be used as the basis for reviewing Contractor's applications for payment. If objected to by Owner, Contractor shall revise the schedule of values and resubmit the same for approval of Owner.

E.2 APPLICATIONS FOR PAYMENT

E.2.1 Owner shall make progress payments on the Contract monthly as Work progresses, in accordance with the requirements of this Section E.2 and ORS 279C.570. Applications for payment shall be based upon estimates of Work completed and the Schedule of Values. As a condition precedent to Owner's obligation to pay, all applications for payment shall be approved by the Owner. A progress payment shall not be considered acceptance or approval of any Work or waiver of any defects therein. Owner shall pay to Contractor interest in accordance with ORS 279C.570 for overdue invoices, not including retainage, due the Contractor. Overdue invoices will be those that have not been paid within the earlier of:

- (a) Thirty (30) days after receipt of the invoice; or
- (b) Fifteen (15) days after the payment is approved by the County.

Notwithstanding the foregoing, in instances when an application for payment is filled out incorrectly, or when there is any defect or impropriety in any submitted application or when there is a good faith dispute, Owner shall so notify the Contractor within fifteen (15) Days stating the reason or reasons the application for payment is defective or improper or the reasons for the dispute. A defective or improper application for payment, if corrected by the Contractor within seven (7) Days of being notified by the Owner, shall not cause a payment to be made later than specified in this section unless interest is also paid. Payment of interest will be postponed when payment on the principal is delayed because of disagreement between the Owner and the Contractor.

Owner reserves the right, instead of requiring the Contractor to correct or resubmit a defective or improper application for payment, to reject the defective or improper portion of the application for payment and pay the remainder of the application for such amounts which are correct and proper.

Owner, upon written notice to the Contractor, may elect to make payments to the Contractor only by means of Electronic Funds Transfers ("EFT") through Automated Clearing House ("ACH") payments. If Owner makes this election, the Contractor shall arrange for receipt of the EFT/ACH payments.

E.2.2 Contractor shall submit to the Owner an application for each payment and, if required, receipts or other vouchers showing payments for materials and labor including payments to Subcontractors. Contractor shall include in its application for payment a schedule of the percentages of the various parts of the Work completed, based on the Schedule of Values which shall aggregate to the payment application total, and shall include, on the face of each copy thereof, a certificate in substantially the following form:

"I, the undersigned, hereby certify that the above bill is true and correct, and the payment therefore, has not been received.

Signed: _____
Dated: _____"

E.2.3 Generally, applications for payment will be accepted only for materials that have been installed. Under special conditions, applications for payment for stored materials will be accepted at Owner's sole discretion. Such a payment, if made, will be subject to the following conditions:

- (a) The request for stored material shall be submitted at least thirty (30) Days in advance of the application for payment on which it appears. Applications for payment shall be entertained for major equipment, components or expenditures only.
- (b) The Contractor shall submit applications for payment showing the quantity and cost of the material stored.
- (c) The material shall be stored in a bonded warehouse and Owner shall be granted the right to access the material for the purpose of removal or inspection at any time during the Contract Period.
- (d) The Contractor shall name the Owner as co-insured on the insurance policy covering the full value of the property while in the care and custody of the Contractor until it is installed. A certificate noting this coverage shall be issued to the Owner.
- (e) Payments shall be made for materials and equipment only. The submitted amount in the application for payment shall be reduced by the cost of transportation from the storage site to the Project Site and for the cost of an inspector to verify delivery and condition of the goods at the storage site. The cost of storage and inspection shall be borne solely by the Contractor.
- (f) Within sixty (60) Days of the application for payment, the Contractor shall submit evidence of payment covering the material and/or equipment stored and of payment for the storage site.
- (g) Payment for stored materials and/or equipment shall in no way indicate acceptance of the materials and/or equipment or waive any rights under the Contract for the rejection of the Work or materials and/or equipment not in conformance with the Contract Documents.
- (h) All required documentation shall be submitted with the respective application for payment.

E.2.4 The Owner reserves the right to withhold all or part of a payment, or may nullify in whole or part any payment previously made, to such extent as may be necessary in the Owner's opinion to protect the Owner from loss because of:

- (a) Work that is defective and not remedied, or that has been demonstrated or identified as failing to conform with Applicable Laws or the Contract Documents;
- (b) third party claims filed or evidence reasonably indicating that such claims will likely be filed unless security acceptable to the Owner is provided by the Contractor;
- (c) failure of the Contractor to make payments properly to Subcontractors or for labor, materials or equipment (in which case Owner may issue checks made payable jointly to Contractor and such unpaid persons under this provision, or directly to Subcontractors and suppliers at any level under Section C.3.2);

- (d) reasonable evidence that the Work cannot be completed for the unpaid balance of the Contract Price;
- (e) damage to the Work, Owner or Owner's agent;
- (f) reasonable evidence that the Work will not be completed within the Contract Time required by the Contract, and that the unpaid balance would not be adequate to cover actual or liquidated damages for the anticipated delay;
- (g) failure to carry out the Work in accordance with the Contract Documents; or
- (h) assessment of liquidated damages, when withholding is made for offset purposes.

E.2.5 Subject to the provisions of the Contract Documents, the amount of each progress payment shall be computed as follows:

- (a) Take that portion of the Contract Price properly allocable to completed Work as determined by multiplying the percentage completion of each portion of the Work by the share of the total Contract Price allocated to that portion of the Work in the Schedule of Values, less retainage as provided in Section E.5. Pending final determination of cost to the Owner of changes in the Work, no amounts for changes in the Work can be included in applications for payment until the Contract Price has been adjusted by a Change Order;
- (b) Add that portion of the Contract Price properly allocable to materials and equipment delivered and suitably stored at the Project Site for subsequent incorporation in the completed construction (or, if approved in advance by the Owner pursuant to Section E.2.3, suitably stored off the Project Site at a location agreed upon in writing), less retainage as provided in Section E.5;
- (c) Subtract the aggregate of previous payments made by the Owner; and
- (d) Subtract any amounts for which the Owner has withheld or nullified payment as provided in the Contract Documents.

E.2.6 Contractor's applications for payment shall not include requests for payment for portions of the Work for which the Contractor does not intend to pay to a Subcontractor or material supplier.

E.2.7 The Contractor warrants to Owner that title to all Work covered by an application for payment will pass to the Owner no later than the time of payment. The Contractor further warrants that upon submittal of an application for payment all Work for which payments are received from the Owner shall be free and clear of liens, claims, security interests or encumbrances in favor of the Contractor, Subcontractors, material suppliers, or other persons or entities making a claim by reason of having provided financing, labor, materials and equipment relating to the Work.

E.2.8 If Contractor disputes any determination by Owner with regard to any application for payment, Contractor nevertheless shall continue to expeditiously perform the Work. No payment made hereunder shall be or be construed to be final acceptance or approval of that portion of the Work to which such partial payment relates or shall relieve Contractor of any of its obligations hereunder.

E.3 PAYROLL CERTIFICATION REQUIREMENT

Owner's receipt of payroll certification pursuant to Section C.2 of the Contract shall be a condition precedent to Owner's obligation to pay any progress payments or final payment otherwise due.

E.4 DUAL PAYMENT SOURCES

Contractor shall not be compensated for Work performed under the Contract from any state agency other than the agency that is a party to the Contract.

E.5 RETAINAGE

E.5.1 Retainage shall be withheld and released in accordance with the requirements set forth in Local Contract Review Board Rules or the applicable County standard.

E.5.1.1 Owner may reserve as retainage from any progress payment an amount not to exceed five percent of the payment. As Work progresses, Owner may reduce the amount of retainage on or may eliminate retainage on any remaining monthly Contract payments after fifty (50) percent of the Work under the Contract is completed if, in the Owner's discretion, such Work is progressing satisfactorily. Elimination or reduction of retainage shall be allowed only upon written application by the Contractor, which application shall include written approval of Contractor's surety; except that when the Work is ninety-seven and a half percent (97.5%) completed in Owner's estimation, the Owner may, at its discretion and without application by the Contractor, reduce the retained amount to hundred (100) percent of the value of the Work remaining to be done. Upon receipt of written application by the Contractor, Owner shall respond in writing within a reasonable time.

E.5.1.2 If retainage is withheld, unless the Contractor requests and the Owner accepts a form of retainage described in options (a) or (b) below, the Owner (except as otherwise provided below for a contract of \$500,000 or less), will deposit the retainage in an interest-bearing escrow account as required by ORS 279C.570(2). The Contractor shall execute such documentation and instructions respecting the interest-bearing escrow account as the Owner may require to protect its interests, including but not limited to a provision that no funds may be paid from the account to anyone without the Owner's advance written authorization. For a Contract over \$500,000, if the Contractor requests that the Owner deposit the retainage in an interest-bearing account under ORS 279C.560(5), the Owner will use an interest-bearing escrow account as stated above. For a Contract of \$500,000 or less, if the Contractor requests that the Owner deposit the retainage in an interest-bearing account under ORS 279C.560(5), the Owner will use an interest-bearing account (in a bank, savings bank, trust company or savings association) as provided under ORS 279C.450(5).

In accordance with the provisions of ORS 279C.560, Local Contract Review Board Rules, or the applicable County standard, unless the Owner finds in writing that accepting bonds, securities or other instruments described in option (a) below or a security bond described in option (b) below poses an extraordinary risk that is not typically associated with the bond, security or instrument, the Owner will approve the Contractor's written request:

- a. to be paid amounts which would otherwise have been retained from progress payments where Contractor has deposited acceptable bonds, securities or other instruments of equal value with Owner or in a custodial account or other mutually-agreed account satisfactory to Owner, with an approved bank or trust company to be held in lieu of the cash retainage for the benefit of Owner. Interest or earnings on the bonds, securities or other instruments shall accrue to the Contractor. The Contractor shall execute and provide such documentation and instructions respecting the bonds, securities and other instruments as the Owner may require to protect its interests. To be permissible, the bonds, securities and other instruments must be of a character approved by Owner; or

- b. that the Contractor be allowed, with the approval of the Owner, Owner allow Contractor to deposit a surety bond for the benefit of Owner, in a form acceptable to Owner, in lieu of all or a portion of funds retained, or to be retained. Such bond and any proceeds therefrom shall be made subject to all claims and liens in the manner and priority as set forth for retainage under ORS 279C.550 to ORS 279C.625.

When the Owner has accepted the Contractor's election of option (a) or (b), Owner may recover from Contractor any additional costs incurred through such election by reducing Contractor's final payment. Where the Owner has agreed to Contractor's request for option (b), Contractor shall accept like bonds from Subcontractors and suppliers on the Project from which Contractor has required retainages.

E.5.1.3 The retainage held by Owner shall be included in and paid to the Contractor as part of the final payment of the Contract Price. The Owner shall pay to Contractor interest at the rate of two thirds of one percent per month on the final payment due Contractor, interest to commence forty-five (45) Days after the date which Owner receives Contractor's final approved application for payment and Work under the Contract has been completed and accepted and to run until the date when final payment is tendered to Contractor. The Contractor shall notify Owner in writing when the Contractor considers the Work complete and deliver to Owner its final application for payment and Owner shall, within fifteen (15) Days after receiving the written notice and the application for payment, either accept the Work or notify the Contractor of Work yet to be performed on the Contract. If Owner does not within the time allowed notify the Contractor of Work yet to be performed to fulfill contractual obligations, the interest provided by this subsection shall commence to run forty-five (45) Days after the end of the fifteen (15) Day period.

E.5.1.4 Owner will reduce the amount of the retainage if the Contractor notifies the Owner that the Contractor has deposited in an escrow account with a bank or trust company, in a manner authorized by the Owner, bonds and securities of equal value of a kind approved by the Owner and such bonds and securities have in fact been deposited.

E.5.1.5 Contractor agrees that if Contractor elects to reserve a retainage from any progress payment due to any Subcontractor or supplier, such retainage shall not exceed five percent of the payment, and such retainage withheld from Subcontractors and suppliers shall be subject to the same terms and conditions stated in Subsection E.5 as apply to Owner's retainage from any progress payment due to Contractor.

E.5.1.6 The Contractor shall comply with all applicable legal requirements for withholding and releasing retainage and for prompt payments, including but not limited to those in ORS Chapters 279C and 701, and 49 CFR 26.29.

E.6 FINAL PAYMENT

E.6.1 Upon completion of all the Work under the Contract, the Contractor shall notify the Owner, in writing, that Contractor has completed Contractor's obligations under the Contract and shall prepare its application requesting final payment. The amount of final payment will be the difference between the total amount due the Contractor pursuant to the Contract Documents and the sum of all payments previously made. Upon receipt of such notice and application for payment, the Owner will inspect the Work, and, if acceptable, submit to Contractor a recommendation as to acceptance of the completed Work and the final estimate of the amount due the Contractor. If the Work is not acceptable, Owner will notify Contractor within fifteen (15) Days of Contractor's request for final payment. Upon approval of this final application for payment by the Owner and compliance by the Contractor with

provisions in Section K, and Contractor's satisfaction of other provisions of the Contract Documents as may be applicable, the Owner shall pay to the Contractor all monies due under the provisions of these Contract Documents.

E.6.2 Neither final payment nor any remaining retained percentage shall become due until the Contractor submits to the Owner (1) a certificate evidencing that insurance required by the Contract Documents to remain in force after final payment is currently in effect and will not be canceled or allowed to expire until at least thirty (30) Days' prior written notice has been given to the Owner, (2) a written statement that the Contractor knows of no substantial reason that the insurance will not be renewable to cover the period required by the Contract Documents, (3) consent of surety, if any, to final payment and (4), if required by the Owner, other data establishing payment or satisfaction of obligations, such as receipts, releases and waivers of liens, claims, security interests or encumbrances arising out of the Contract, to the extent and in such form as may be designated by the Owner. If a Subcontractor refuses to furnish a release or waiver required by the Owner, the Contractor may furnish a bond satisfactory to the Owner to indemnify the Owner against such lien. If such lien remains unsatisfied after payments are made, the Contractor shall refund to the Owner all money that the Owner may be compelled to pay in discharging such lien.

E.6.3 Acceptance of final payment by the Contractor, a Subcontractor or material supplier shall constitute a waiver of claims by that payee except those previously made in writing and identified by that payee as unsettled at the time of final application for payment.

E.6.4 Contractor agrees to submit its final payment application within ninety (90) Days after Substantial Completion, unless written extension is granted by Owner. Contractor shall not delay final payment application for any reason, including without limitation nonpayment of Subcontractors, suppliers, manufacturers or others not a party to the Contract, or lack of resolution of a dispute with Owner or any other person of matters arising out of or relating to the Contract. If Contractor fails to submit its final payment application within ninety (90) Days after Substantial Completion, and Contractor has not obtained written extension by Owner, all requests or Claims for additional costs or an extension of Contract Time shall be barred.

SECTION F PROJECT SITE CONDITIONS

F.1 USE OF PREMISES

Contractor shall confine equipment, storage of materials and operation of Work to the limits indicated by Contract Documents, Applicable Laws, permits or directions of the Owner. Contractor shall follow the Owner's instructions regarding use of premises, if any.

F.2 PROTECTION OF WORKERS, PROPERTY AND THE PUBLIC

F.2.1 Contractor shall maintain continuous and adequate protection of all of the Work from damage and shall protect the Owner, workers and property from injury or loss arising in connection with the Contract. Contractor shall remedy acceptably to the Owner any damage, injury, or loss, except such as may be directly due to errors in the Contract Documents or caused by authorized representatives or personnel of the Owner. Contractor shall adequately protect adjacent property as provided by law and the Contract Documents.

F.2.2 Contractor shall take all necessary precautions for the safety of all personnel on the Project Site or otherwise engaged in the undertaking of the Work and shall comply with the Contract Documents, best practices and all applicable provisions of federal, state and municipal safety laws and building codes to prevent

accidents or injury to persons on, about or adjacent to the premises where the Work is being performed. Contractor shall erect and properly maintain at all times, as required by the conditions and progress of the Work, all necessary safeguards for protection of workers and the public against any hazards created by construction. Contractor shall designate a responsible employee or associate on the Project Site, whose duty shall be the prevention of accidents. The name and position of the person designated shall be reported to the Owner. The Owner has no responsibility for Project Site safety. Project Site safety shall be the responsibility of the Contractor.

F.2.3 Contractor shall not enter upon private property without first obtaining permission from the property owner or its duly authorized representative. Contractor shall be responsible for the preservation of all public and private property along and adjacent to the Work contemplated under the Contract and shall use every precaution necessary to prevent damage thereto. In the event the Contractor damages any property, the Contractor shall at once notify the property owner and make, or arrange to make, full restitution. Contractor shall, immediately and in writing, report to the Owner, all pertinent facts relating to such property damage and the ultimate disposition of the claim for damage.

F.2.4 Contractor shall be responsible for protection of adjacent work areas including impacts brought about by activities, equipment, labor, utilities, vehicles and materials on the Project Site.

F.2.5 Contractor shall at all times direct its activities in such a manner as to minimize adverse effects on the environment. Handling of all materials shall be conducted so no release will occur that may pollute or become hazardous.

F.2.6 In an emergency affecting the safety of life or limb or of the Work or of adjoining property, the Contractor, without special instruction or authorization from the Owner, shall act reasonably to prevent threatened loss or injury, and shall so act, without appeal, if instructed by the Owner. Any compensation claimed by the Contractor on account of emergency work shall be determined in accordance with section D.

F.2.7 Contractor shall comply with all Owner safety rules and regulations, if applicable. Prior to commencement of any Work, Contractor and Subcontractors shall be required to complete an Owner Contractor Safety Orientation and submit all Owner required safety plans.

F.2.8 Contractor shall demonstrate that an employee drug testing program is in place.

F.3 CUTTING AND PATCHING

F.3.1 If applicable, Contractor shall be responsible for coordinating all cutting, fitting, or patching of the Work to make its several parts come together properly and fit to receive or be received by work of other contractors or Subcontractors shown upon, or reasonably implied by, the Contract Documents.

F.3.2 If applicable, Contractor shall be responsible for restoring all cut, fitted, or patched surfaces to an original condition; provided, however, that if a different condition is specified in the Contract Documents, then Contractor shall be responsible for restoring such surfaces to the condition specified in the Contract Documents.

F.4 CLEANING UP

From time to time as may be prudent or ordered by the Owner and, in any event, immediately after completion of the Work, the Contractor shall, at its own expense, clean up and remove all refuse and unused materials of any kind resulting from the Work. If Contractor fails to do so within twenty-four (24) hours after notification by the Owner the work may be

done by others and the cost charged to the Contractor and deducted from payment due the Contractor.

F.5 ENVIRONMENTAL CONTAMINATION

F.5.1. Contractor shall be held responsible for and shall indemnify, defend (with counsel of Owner's choice), and hold harmless Owner from and against any costs, expenses, damages, claims, and causes of action, or any of them, resulting from all spills, releases, discharges, leaks and disposal of environmental pollution, including storage, transportation, and handling during the performance of the Work or Contractor's obligations under the Contract which occur as a result of, or are contributed by, the negligence or actions of Contractor or its personnel, agents, or Subcontractors or any failure to perform in accordance with the Contract Documents (except to the extent otherwise void under ORS 30.140). Nothing in this section F.5.1 shall limit Contractor's responsibility for obtaining insurance coverages required under Section G.3 of the Contract, and Contractor shall take no action that would void or impair such coverages.

F.5.1.1 Contractor agrees to promptly dispose of such spills, releases, discharges or leaks to the satisfaction of Owner and regulatory agencies having jurisdiction in a manner that complies with Applicable Laws. Cleanup shall be at no cost to the Owner and shall be performed by properly qualified and, if applicable, licensed personnel.

F.5.1.2 Unless otherwise approved in the Solicitation Document, Contractor shall obtain the Owner's written consent prior to bringing onto the Project Site any (i) environmental pollutants or (ii) hazardous substances or materials, as the same or reasonably similar terms are used in any Applicable Laws. In any event, Contractor shall provide prior written notice to Owner when hazardous materials are brought on to the Project Site. The Contractor, at all times, shall:

- (a) properly handle, use and dispose of all environmental pollutants and hazardous substances or materials on the Project Site, in accordance with all Applicable Laws;
- (b) be responsible for any and all spills, releases, discharges, or leaks of (or from) environmental pollutants or hazardous substances or materials which Contractor has brought onto the Project Site; and
- (c) promptly clean up and remediate, without cost to the Owner, such spills, releases, discharges, or leaks to the Owner's satisfaction and in compliance with all Applicable Laws.

F.5.2 Contractor shall report all reportable quantity releases, as such releases are defined in Applicable Laws. Upon discovery, regardless of quantity, Contractor must verbally report all releases to the Owner in a prompt manner. A written follow-up report shall be submitted to Owner within 48 hours of the telephonic report. Such written report shall contain, as a minimum:

- (a) Description of items released (identity, quantity, manifest numbers, and any and all other documentation required by law).
- (b) Whether amount of items released is EPA/DEQ reportable, and, if so, when reported.
- (c) Exact time and location of release, including a description of the area involved.
- (d) Containment procedures initiated.

- (e) Summary of communications about the release between Contractor and State, local or federal officials other than Owner. Any communication to the press will be done by Owner and Contractor will defer to Owner.
- (f) Description of cleanup procedures employed or to be employed at the Project Site, including disposal location of spill residue.
- (g) Personal injuries, if any, resulting from, or aggravated by, the release.

F.6 ENVIRONMENTAL CLEAN-UP

F.6.1 Unless disposition of environmental pollution is specifically a part of the Contract, or was caused by the Contractor (reference F.5 Environmental Contamination), Contractor shall immediately notify Owner of any hazardous substance(s) which Contractor discovers or encounters during performance of the Work required by the Contract. "Hazardous substance(s)" means any hazardous, toxic and radioactive materials and those substances defined as "hazardous substances," "hazardous materials," "hazardous wastes," "toxic substances," or other similar designations in any federal, state, or local law, regulation, or ordinance, including without limitation asbestos, polychlorinated biphenyl ("PCB"), or petroleum, and any substances, materials or wastes regulated by 40 CFR, Part 261 and defined as hazardous in 40 CFR S 261.3. In addition to notifying Owner of any hazardous substance(s) discovered or encountered, Contractor shall immediately cease working in any particular area of the Project where a hazardous substance(s) has been discovered or encountered if continued work in such area would present a risk or danger to the health or wellbeing of Contractor's or any Subcontractor's work force, property or the environment.

F.6.2 Upon being notified by Contractor of the presence of hazardous substance(s) on the Project Site, not brought on to the Project Site by Contractor, Owner shall arrange for the proper disposition of such hazardous substance(s).

F.7 DEMOLITION

F.7.1 For demolition tasks, if any, the Contractor shall salvage or recycle construction and demolition debris, if feasible and cost-effective.

SECTION G INDEMNITY, BONDING, AND INSURANCE

G.1 RESPONSIBILITY FOR DAMAGES / INDEMNITY

G.1.1 Contractor shall be responsible for all damage to property, injury to persons, and loss, expense, inconvenience, and delay that may be caused by, or result from, the carrying out of the Work to be done under the Contract, or from any act, omission or neglect of the Contractor, its Subcontractors, employees, guests, visitors, invitees and agents.

G.1.2 To the fullest extent permitted by law, Contractor shall indemnify, defend (with counsel approved by Owner) and hold harmless the Owner and its elected officials, officers, directors, agents, and employees (collectively "Indemnitees") from and against all liabilities, damages, losses, claims, expenses, demands and actions of any nature whatsoever which arise out of, result from or are related to: (a) any damage, injury, loss, expense, inconvenience or delay described in this Section G.1; (b) any accident or occurrence which happens or is alleged to have happened in or about the Project Site or any place where the Work is being performed, or in the vicinity of either, at any time prior to the time the Work is fully completed in all respects; (c) any failure of the Contractor to

observe or perform any duty or obligation under the Contract Documents which is to be observed or performed by the Contractor, or any breach of any agreement, representation or warranty of the Contractor contained in the Contract Documents or in any subcontract; (d) the negligent acts or omissions of the Contractor, a Subcontractor or anyone directly or indirectly employed by them or any one of them or anyone for whose acts they may be liable, regardless of whether or not such claim, damage, loss or expense is caused in part by a party indemnified hereunder (except to the extent otherwise void under ORS 30.140); and (e) any lien filed upon the Project or bond claim in connection with the Work. Such obligation shall not be construed to negate, abridge, or reduce other rights or obligations of indemnity which would otherwise exist as to a party or person described in this Section G.1.2.

G.1.3 In claims against any person or entity indemnified under Section G.1.2 by an employee of the Contractor, a Subcontractor, anyone directly or indirectly employed by them or anyone for whose acts they may be liable, the indemnification obligation under Section G.1.2 shall not be limited on amount or type of damages, compensation or benefits payable by or for the Contractor or a Subcontractor under workers' compensation acts, disability benefit acts or other employee benefit acts.

G.2 PERFORMANCE AND PAYMENT SECURITY; PUBLIC WORKS BOND

G.2.1 When the Contract Price is \$50,000 or more, the Contractor shall furnish and maintain in effect at all times during the Contract Period a performance bond in a sum equal to the Contract Price and a separate payment bond also in a sum equal to the Contract Price. Contractor shall furnish such bonds even if the Contract Price is less than the above thresholds if otherwise required by the Contract Documents. If the Contract Price is increased, Contractor shall increase its payment and performance bonds to reflect the amended Contract Price.

G.2.2 Bond forms furnished by the Owner and notarized by Contractor's surety company authorized to do business in Oregon are the only acceptable forms of performance and payment security, unless otherwise specified in the Contract Documents.

G.2.3 Before execution of the Contract, the Contractor shall file with the Construction Contractors Board, and maintain in full force and effect, the separate public works bond required by Oregon Revised Statutes, Chapter 279C.830 and 279C.836, unless otherwise exempt under those provisions. The Contractor shall also include in every subcontract a provision requiring the Subcontractor to have a public works bond filed with the Construction Contractors Board before starting Work, unless otherwise exempt, and shall verify that the Subcontractor has filed a public works bond before permitting any Subcontractor to start Work.

G.3 INSURANCE

G.3.1 Primary Coverage: Insurance carried by Contractor under the Contract shall be the primary coverage. The coverages indicated are minimums unless otherwise specified in the Contract Documents.

G.3.2 Workers' Compensation: All employers, including Contractor, that employ subject workers who work under the Contract in the State of Oregon shall comply with ORS 656.017 and provide the required Workers' Compensation coverage, unless such employers are exempt under ORS 656.126. This shall include Employer's Liability Insurance with coverage limits of not less than the minimum amount required by statute for each accident. Contractors who perform the Work without the assistance or labor of any employee need not obtain such coverage if the Contractor certifies so in writing. Contractor shall ensure that each of its

Subcontractors complies with these requirements. The Contractor shall require proof of such Workers' Compensation coverage by receiving and keeping on file a certificate of insurance from each Subcontractor or anyone else directly employed by either the Contractor or its Subcontractors.

G.3.3 Builder's Risk Insurance:

G.3.3.1 **Builder's Risk:** During the term of the Contract, for new construction the Contractor shall obtain and keep in effect Builder's Risk insurance on an all risk forms, including earthquake and flood, for an amount equal to the full amount of the Contract, plus any changes in values due to modifications, Change Orders and loss of materials added. Such Builder's Risk shall include, in addition to earthquake and flood, theft, vandalism, mischief, collapse, transit, debris removal, and architect's fees "soft costs" associated with delay of Project due to insured peril. Any deductible shall not exceed \$50,000 for each loss, except the earthquake and flood deductible which shall not exceed 2 percent of each loss or \$50,000, whichever is greater. The deductible shall be paid by Contractor. The policy will include as loss payees Owner, the Contractor and its Subcontractors as their interests may appear.

G.3.3.2 **Builder's Risk Installation Floater:** For Work other than new construction, Contractor shall obtain and keep in effect during the term of the Contract, a Builder's Risk Installation Floater for coverage of the Contractor's labor, materials and equipment to be used for completion of the Work performed under the Contract. The minimum amount of coverage to be carried shall be equal to the full amount of the Contract. The policy will include as loss payees Owner, the Contractor and its Subcontractors as their interests may appear. Owner may waive this requirement at its sole and absolute discretion.

G.3.3.3 Such insurance shall be maintained until Owner has occupied the facility.

G.3.3.4 A loss insured under the Builder's Risk insurance shall be adjusted by the Owner and made payable to the Owner as loss payee. The Contractor shall pay Subcontractors their just shares of insurance proceeds received by the Contractor, and by appropriate agreements, written where legally required for validity, shall require Subcontractors to make payments to their Sub-subcontractors in similar manner. The Owner shall have power to adjust and settle a loss with insurers.

G.3.4 General Liability Insurance:

G.3.4.1 **Commercial General Liability:** Upon execution of a Contract, Contractor shall obtain, and keep in effect at Contractor's expense for the term of the Contract, Commercial General Liability Insurance ("CGL") covering bodily injury and property damage in the amount of not less than \$1,000,000 per claim and \$2,000,000 per occurrence in a form satisfactory to Owner. This insurance shall include personal injury liability, products and completed operations, and contractual liability coverage for the indemnities provided under the Contract (to the extent contractual liability coverage for the indemnity is available in the marketplace), and shall be issued on an occurrence basis written on ISO Form GC 00 01 (12 04 or later) or an equivalent form approved in advance by Owner. The CGL shall provide separation of insured language. The policy or policies obtained by Contractor for purposes of fulfilling the requirements of this section shall be primary insurance with respect to the Owner. Any insurance or self-insurance maintained by the County shall be excess and shall not contribute to it.

G.3.4.2 **Automobile Liability:** Contractor shall obtain, at Contractor's expense, and keep in effect during the term of the Contract, Automobile Liability Insurance covering owned, and/or hired

vehicles, as applicable. The coverage may be written in combination with the Commercial General Liability Insurance. Contractor shall provide proof of insurance of not less than \$1,000,000 per claim and \$2,000,000 per occurrence. Contractor and its Subcontractors shall be responsible for ensuring that all non-owned vehicles maintain adequate Automobile Liability insurance while on Project Site.

G.3.4.3 Owner may adjust the insurance amounts required in Section G.3.4.1 and G.3.4.2 based upon institution specific risk assessments through the issuance of Supplemental General Conditions and a Contract.

G.3.4.4 To the extent that the Contract Documents require the Contractor to provide professional design services, design-build, or certifications related to systems, materials, or equipment, the Contractor shall (1) purchase and maintain professional liability/errors-and-omissions insurance with limits of not less than \$1,000,000 for each claim and \$2,000,000 general annual aggregate and (2) cause those Subcontractors (of any tier) who are providing professional design services including any design-build services to procure and maintain professional liability/errors-and-omissions insurance with limits of not less than \$1,000,000 for each claim and \$2,000,000 general annual aggregate. This policy shall be for the protection of the Owner, its elected officials, officers, agents and employees against liability for damages because of personal injury, bodily injury, death, or damage to property, including loss of use thereof, and damages because of negligent acts, errors and omissions in any way related to the Contract. The Owner, at its option, may require a complete copy of the above policy.

G.3.4.5 "Tail" Coverage: If any of the required liability insurance is arranged on a "claims made" basis, "tail" coverage will be required at the completion of the Contract for a duration of 36 months or the maximum time period available in the marketplace if less than 36 months. Contractor shall furnish certification of "tail" coverage as described or continuous "claims made" liability coverage for 36 months following Final Completion. Continuous "claims made" coverage will be acceptable in lieu of "tail" coverage, provided its retroactive date is on or before the effective date of the Contract. Owner's receipt of the policy endorsement evidencing such coverage shall be a condition precedent to Owner's obligation to make final payment and to Owner's final acceptance of Work or services and related warranty (if any).

G.3.4.6 Umbrella Liability (if required by Owner through issuance of Supplemental General Conditions): Contractor shall obtain, at Contractor's expense, and keep in effect during the term of the Contract, Umbrella liability Insurance over and above the general liability, automobile liability and workers' compensation coverage if required by Owner in specified limits at time of requirement.

G.3.4.7 Pollution Liability may be required by Owner through issuance of Supplemental General Conditions.

G.3.5 Additional Insured: The general liability insurance coverage, automobile liability, umbrella, and pollution liability if required, shall include the Owner as additional insureds but only with respect to the Contractor's activities to be performed under the Contract. The additional-insured endorsement for CGL insurance must be written on ISO Form CG 20 10 (10 01) and CG 20 37 (10 01), or their equivalent, but shall not use either of the following forms: CG 20 10 (10 93) or CG 20 10 (03 94). Proof of insurance must include a copy of the endorsement showing "Clackamas County, its elected officials, agents, officers, and employees" as scheduled insureds.

If Contractor cannot obtain an insurer to name the Owner as additional insureds, Contractor shall obtain at Contractor's

expense, and keep in effect during the term of the Contract, Owners and Contractors Protective Liability Insurance, naming the Owner as additional insureds with not less than a \$2,000,000 limit per occurrence. This policy must be kept in effect for 36 months following Final Completion. As evidence of coverage, Contractor shall furnish the actual policy to Owner prior to execution of the Contract.

G.3.6 Notice of Cancellation or Change: If the Contractor receives a non-renewal or cancellation notice from an insurance carrier affording coverage required herein, or receives notice that coverage no longer complies with the insurance requirements herein, Contractor agrees to notify Owner by fax within five (5) business days with a copy of the non-renewal or cancellation notice, or written specifics as to which coverage is no longer in compliance. When notified by Owner, the Contractor agrees to stop Work pursuant to the Contract at Contractor's expense, unless all required insurance remain in effect. Any failure to comply with the reporting provisions of this insurance, except for the potential exhaustion of aggregate limits, shall not affect the coverages provided to the Owner and its institutions, divisions, officers, and employees.

Owner shall have the right, but not the obligation, of prohibiting Contractor from entering the Project Site until a new certificate(s) of insurance is provided to Owner evidencing the replacement coverage. The Contractor agrees that Owner reserves the right to withhold payment to Contractor until evidence of reinstated or replacement coverage is provided to Owner.

G.3.7 Certificate(s) of Insurance/Insurance Carrier Qualification: As evidence of the insurance coverage required by the Contract, the Contractor shall furnish certificate(s) of insurance to the Owner prior to execution of the Contract. The certificate(s) will specify all of the parties who are additional insureds or loss payees for the Contract. A renewal certificate shall be sent to Owner at least 10 days prior to coverage expiration. Insurance coverage required under the Contract shall be obtained from insurance companies or entities acceptable to the Owner and that are eligible to provide such insurance under Oregon law. Eligible insurers include admitted insurers that have been issued a certificate of authority from the Oregon Department of Consumer and Business Services authorizing them to conduct an insurance business and issue policies of insurance in the state of Oregon, and certain non-admitted surplus lines insurers that satisfy the requirements of applicable Oregon law and which are subject to approval by the Owner. The Contractor shall be financially responsible for all deductibles, self-insured retentions and/or self-insurance included hereunder. Any deductible, self-insured retention and/or self-insurance in excess of \$50,000 shall be subject to approval by the Owner in writing and shall be a condition precedent to the effectiveness of any Contract.

SECTION H SCHEDULE OF WORK

H.1 CONTRACT PERIOD

H.1.1 Time is of the essence. The Contractor shall at all times carry on the Work diligently, without delay and punctually fulfill all requirements herein.

H.1.2 Notice to Proceed. Unless otherwise directed in the Contract Documents, Contractor shall commence Work on the Project Site within fifteen (15) Days of the Notice to Proceed. Notwithstanding the Notice to Proceed, Contractor shall not be authorized to proceed with the Work until all initial Contract requirements, including the Contract, performance bond and payment bond, and certificates of insurance, have been fully executed and submitted in a form acceptable to Owner.

H.1.3 Unless otherwise not required in the Construction Documents, Contractor shall participate in a pre-construction conference with the Owner's representative and designated design team. The purpose of this pre-construction conference is to review the Contractor's proposed Schedule of Values and to review any other Project logistics to be coordinated between the parties.

H.1.4 Unless specifically extended by a Change Order, all Work shall be complete by the date contained in the Contract Documents. The Owner shall have the right to accelerate the completion date of the Work, which may require the use of overtime. Such accelerated Work schedule shall be an acceleration in performance of Work under Section D.1.2(f) and shall be subject to the provisions of Section D.1.

H.1.5 The Owner shall not waive any rights under the Contract by permitting the Contractor to continue or complete in whole or in part the Work after the date described in Section H.1.2 above.

H.2 SCHEDULE

H.2.1 Contractor shall provide, by or before the pre-construction conference, the initial as-planned schedule for review and acceptance by the Owner. The submitted schedule must illustrate Work by Project components, labor trades, and long lead items broken down by building and/or floor where applicable. If Owner shall so elect, Contractor shall provide the schedule in CPM format showing the graphical network of planned activities, including i) a reasonably detailed list of all activities required to complete the Work; ii) the time and duration that each activity will take to completion; and iii) the dependencies between the activities. Schedules lacking adequate detail, or unreasonably detailed, will be rejected. The schedule shall include the following: Notice to Proceed or the date the Work commences, if no Notice to Proceed is issued by Owner, Substantial Completion, and Final Completion. Schedules shall be updated monthly, unless otherwise required by the Contract Documents, and submitted with the monthly application for payment. Acceptance of the Schedule by the Owner does not constitute agreement by the Owner as to the Contractor's sequencing, means, methods, or durations. Any positive difference between the Contractor's scheduled completion and the Contract completion date is float owned by the Owner. Owner reserves the right to negotiate the float if it is deemed to be in Owner's best interest to do so. In no case shall the Contractor make a claim for delays if the Work is completed within the Contract Time but after Contractor's scheduled completion.

H.2.2 All Work shall be completed during normal weekdays (Monday through Friday) between the hours of 7:00 a.m. and 5:00 p.m. unless otherwise specified in the Contract Documents. Unless otherwise specified in the Contract Documents, no Work shall be performed during the following holidays:

- New Year's Day
- Martin Luther King Day
- Memorial Day
- Independence Day
- Labor Day
- Veterans Day
- Thanksgiving Day
- Christmas Day
- President's Day

When a holiday falls on a Sunday, the following Monday shall be recognized as a legal holiday. When a holiday falls on Saturday, the preceding Friday shall be recognized as a legal holiday.

H.3 PARTIAL OCCUPANCY OR USE

The Owner may occupy or use any completed or partially completed portion of the Work at any stage, provided such occupancy or use is consented to by public authorities having jurisdiction over the Work. Such partial occupancy or use may commence whether or not the portion is substantially complete, provided the Owner and Contractor have reasonably accepted in writing the responsibilities assigned to each of them. Approval by the Contractor to partial occupancy or use shall not be unreasonably withheld. Immediately prior to such partial occupancy or use, the Owner and Contractor shall jointly inspect the area to be occupied or portion of the Work to be used in order to determine and record the condition of the Work. Partial occupancy or use of a portion or portions of the Work shall not constitute acceptance of Work not complying with the requirements of the Contract Documents.

SECTION I

CORRECTION OF WORK

I.1 CORRECTION OF WORK BEFORE FINAL PAYMENT

The Contractor warrants to the Owner that materials and equipment furnished under the Contract will be of good quality and new unless otherwise required or permitted by the Contract Documents, that the Work will be free from defects, and that the Work will conform to the requirements of the Contract Documents. Work failing to conform to these requirements shall be deemed defective. Contractor shall promptly remove from the premises and replace all defective materials and equipment as determined by the Owner, whether incorporated in the Work or not. Removal and replacement shall be without loss or expense to the Owner, and Contractor shall bear the cost of repairing all Work destroyed or damaged by such removal or replacement. Contractor shall be allowed a period of no longer than thirty (30) Days after Substantial Completion for completion of defective (Punch List) work. At the end of the thirty-day period, or earlier if requested by the Contractor, Owner shall arrange for inspection of the Work by the Architect/Engineer. Should the work not be complete, and all corrections made, the costs for all subsequent re-inspections shall be borne by the Contractor. If Contractor fails to complete the Punch List work within the thirty (30) Day period, Owner may perform such work and Contractor shall reimburse Owner all costs of the same within ten (10) Days after demand without affecting Contractor's obligations.

I.2 WARRANTY WORK

I.2.1 Neither the final certificate of payment nor any provision of the Contract Documents shall relieve the Contractor from responsibility for Defective Work and, unless a longer period is specified, Contractor shall correct all defects that appear in the Work within a period of one year from the date of issuance of the written notice of Substantial Completion by the Owner except for latent defects which will be remedied by the Contractor at any time they become apparent. The Owner shall give Contractor notice of defects with reasonable promptness. Contractor shall perform such warranty work within a reasonable time after Owner's demand and at Contractors sole expense. If Contractor fails to complete the warranty work within such period as Owner determines reasonable, or at any time in the event of warranty work consisting of emergency repairs, Owner may perform such work and Contractor shall reimburse Owner all costs of the same within ten (10) Days after demand, without affecting Contractor's obligations. The Contractor shall perform the warranty Work by correcting defects within twenty-four (24) hours of notification by Owner, unless otherwise specified in the Contract Documents. Should the Contractor fail to respond within the specified response time, the Owner may, at its option, complete the necessary repairs using another contractor or its agents. If Owner completes the repairs using Owner's agent, Contractor shall pay Owner at the rate of one and one-half (1½) times the standard hourly rate of Owner's agent, plus related overhead and any direct non-salary costs. If Owner completes the repairs using another contractor, Contractor shall pay

Owner the amount of Owner's direct costs billed by the other contractor for the work, plus the direct salary costs and related overhead and direct non-salary expenses of Owner's agents who are required to monitor that contractor's work. Work performed by Owner using Owner's own agents or those of another contractor shall not affect the Contractor's contractual duties under these provisions, including warranty provisions.

- I.2.2 Nothing in this Section I.2 provision shall negate guarantees or warranties for periods longer than one year including without limitation, such guarantees or warranties required by other sections of the Contract Documents for specific installations, materials, processes, equipment or fixtures.
- I.2.3 In addition to Contractor's warranty, manufacturer's warranties shall pass to the Owner and shall not take effect until such portion of the Work covered by the applicable warranty has been accepted in writing by the Owner.
- I.2.4 The one-year period for correction of Work shall be extended with respect to portions of Work performed after Substantial Completion by the period of time between Substantial Completion and the actual performance of the Work, and shall be extended by corrective Work performed by the Contractor pursuant to this Section, as to the Work corrected. The Contractor shall remove from the Project Site portions of the Work which are not in accordance with the requirements of the Contract Documents and are neither corrected by the Contractor nor accepted by the Owner.
- I.2.5 Nothing contained in this Section I.2 shall be construed to establish a period of limitation with respect to other obligations which the Contractor might have under the Contract Documents. Establishment of the period for correction of Work as described in this Section I.2 relates only to the specific obligation of the Contractor to correct the Work, and has no relationship to the time within which the obligation to comply with the Contract Documents may be sought to be enforced, nor to the time within which proceedings may be commenced to establish the Contractor's liability with respect to the Contractor's obligations other than specifically to correct the Work.
- I.2.6 If the Owner prefers to accept Work which is not in accordance with the requirements of the Contract Documents, the Owner may do so instead of requiring its removal and correction, in which case the Contract Price will be reduced as appropriate and equitable as determined by Owner. Such adjustment shall be effected whether or not final payment has been made.

SECTION J SUSPENSION AND/OR TERMINATION OF THE WORK

J.1 OWNER'S RIGHT TO SUSPEND THE WORK

- J.1.1 The Owner has the authority to suspend portions or all of the Work due to the following causes:
 - (a) Failure of the Contractor to correct unsafe conditions;
 - (b) Failure of the Contractor to carry out any provision of the Contract;
 - (c) Failure of the Contractor to carry out orders;
 - (d) Conditions, in the opinion of the Owner, which are unsuitable for performing the Work;
 - (e) Time required to investigate differing Project Site conditions; or
 - (f) Any reason considered to be in the public interest.

- J.1.2 The Owner shall notify Contractor and the Contractor's Surety in writing of the effective date and time of the suspension, and Owner shall notify Contractor and Contractor's surety in writing to resume Work.

J.2 CONTRACTOR'S RESPONSIBILITIES

- J.2.1 During the period of the suspension, Contractor is responsible to continue maintenance at the Project just as if the Work were in progress. This includes, but is not limited to, protection of completed Work, maintenance of access, protection of stored materials, temporary facilities, and clean-up.
- J.2.2 When the Work is recommenced after the suspension, the Contractor shall replace or renew any Work damaged during the suspension, remove any materials or facilities used as part of temporary maintenance, and complete the Work in every respect as though its prosecution had been continuous and without suspension.

J.3 COMPENSATION FOR SUSPENSION

Depending on the reason for suspension of the Work, the Contractor or the Owner may be due compensation by the other party. If the suspension was required due to acts or omissions of Contractor, the Owner may assess the Contractor actual costs of the suspension in terms of administration, remedial work by the Owner's agents or another contractor to correct the problem associated with the suspension, rent of temporary facilities, and other actual costs related to the suspension, and any liquidated damages arising from the delay. If the suspension was caused by acts or omissions of the Owner, the Contractor may be due compensation which shall be defined using Section D, Changes in Work. If the suspension was required through no fault of the Contractor or the Owner, neither party shall owe the other for the impact.

J.4 OWNER'S RIGHT TO TERMINATE CONTRACT

- J.4.1 The Owner may, without prejudice to any other right or remedy, and after giving Contractor seven (7) Days' written notice and an opportunity to cure, terminate the Contract in whole or in part under the following conditions:
 - (a) If Contractor should, voluntarily or involuntarily, seek protection under the United States Bankruptcy Code and Contractor as debtor-in-possession or the Trustee for the estate fails to assume the Contract within a reasonable time;
 - (b) If Contractor should make a general assignment for the benefit of Contractor's creditors;
 - (c) If a receiver should be appointed on account of Contractor's insolvency;
 - (d) If Contractor should repeatedly refuse or fail to supply an adequate number of skilled workers or proper materials to carry on the Work as required by the Contract Documents, or otherwise fail to perform the Work in a timely manner;
 - (e) If Contractor should repeatedly fail to make prompt payment to Subcontractors or for material or labor, or should disregard laws, ordinances or the instructions of the Owner;
 - (f) If Contractor is otherwise in breach of any part of the Contract; or
 - (g) If Contractor is in violation of Applicable Laws, either in the conduct of its business or in its performance of the Work.
- J.4.2 At any time that any of the above occurs, Owner may exercise all rights and remedies available to Owner at law or in equity, and, in

addition, Owner may take possession of the premises and of all materials and appliances and finish the Work by whatever method it may deem expedient. In such case, the Contractor shall not be entitled to receive further payment until the Work is completed. If the Owner's cost of finishing the Work exceeds the unpaid balance of the Contract Price, Contractor shall pay the difference to the Owner.

J.5 TERMINATION FOR CONVENIENCE, NON-APPROPRIATION OF FUNDS, OR FORCE MAJEURE

J.5.1 Owner may terminate the Contract in whole or in part whenever Owner determines: (a) that termination of the Contract is in the best interest of Owner or the public; (b) that the Owner failed to receive funding, appropriations, allocations or other expenditure authority as contemplated by Owner's budget and Owner determines, in its sole determination, and its assessment and ranking of the policy objectives explicit or implicit in Owner's budget, Owner may determine it is necessary to and may terminate the Contract.; or (c) in the event of Force Majeure.

J.5.2 The Owner shall provide the Contractor with seven (7) Days prior written notice of a termination for Owner's or for public convenience. After such notice, the Contractor shall provide the Owner with immediate and peaceful possession of the premises and materials located on and off the premises for which the Contractor received progress payment under Section E. Compensation for Work terminated by the Owner under this provision will be according to Section E. In no circumstance shall Contractor be entitled to lost profits for Work not performed due to termination. If the Contract is terminated for public convenience, neither the Contractor nor its Surety shall be relieved of liability for damages or losses suffered by the Owner as a result of defective, unacceptable or unauthorized Work completed or performed.

J.6 ACTION UPON TERMINATION

J.6.1 Upon receiving a notice of termination, and except as directed otherwise by the Owner, Contractor shall immediately cease placing further subcontracts or orders for materials, services, or facilities. In addition, Contractor shall terminate all subcontracts or orders to the extent they relate to the Work terminated and, with the prior written approval of the Owner, settle all outstanding liabilities and termination settlement proposals arising from the termination of subcontracts and orders.

J.6.2 As directed by the Owner, Contractor shall, upon termination, transfer title and deliver to the Owner all Record Documents, information, and other property that, if the Contract had been completed, would have been required to be furnished to the Owner.

J.6.3 Upon Owner's notice of termination pursuant to either Section J.4 or J.5, if Owner shall so elect, Contractor shall assign to the Owner such subcontracts and orders as Owner shall specify. In the event Owner elects to take assignment of any such subcontract or order, Contractor shall take such action and shall execute such documents as Owner shall reasonably require for the effectiveness of such assignment and Contractor shall ensure that no contractual arrangement between it and its subcontractors or suppliers of any tier or sub-tier shall prevent such assignment.

SECTION K CONTRACT CLOSE OUT

K.1 RECORD DOCUMENTS

As a condition of final payment (refer also to section E.6), Contractor shall comply with the following: Contractor shall provide Record Documents for the entire Project to Owner. Record Documents shall depict the Project as constructed and shall reflect each and every change, modification, and deletion made during the construction. Record

Documents are part of the Work and shall be provided prior to the Owner's issuance of final payment. Record Documents include all modifications to the Contract Documents unless otherwise directed.

K.2 OPERATION AND MAINTENANCE MANUALS

As part of the Work, Contractor shall submit two completed operation and maintenance manuals ("O & M Manuals") for review by the Owner prior to submission of any pay request for more than 75% of the Work. Owner's receipt of the O & M Manuals shall be a condition precedent to any payment thereafter due. The O & M Manuals shall contain a complete set of all submittals, all product data as required by the specifications, training information, telephone list and contact information for all consultants, manufacturers, installer and suppliers, manufacturer's printed data, record and shop drawings, schematic diagrams of systems, appropriate equipment indices, warranties and bonds. The Owner shall review and return one O & M Manual for any modifications or adjustments required. Prior to submission of its final pay request, Contractor shall deliver two (2) complete and approved sets of O & M Manuals in paper form and one (1) complete and approved set in electronic form to the Owner and Owner's receipt of the O & M Manuals shall be a condition precedent to Owner's obligation to make final payment.

K.3 COMPLETION NOTICES

K.3.1 Contractor shall provide Owner written notice of both Substantial and Final Completion. The certificate of Substantial Completion shall state the date of Substantial Completion, the responsibilities of the Owner and Contractor for security, maintenance, heat, utilities, damage to the Work and insurance, and the time within which the Contractor shall finish all items on the Punch List accompanying the Certificate. Both completion notices must be signed and notarized by the Contractor and signed by the Architect/Engineer (if applicable) and Owner to be valid. The Owner shall provide the final signature on the notices. The notices shall take effect on the date they are signed by the Owner.

K.3.2 Substantial Completion of a facility with operating systems (e.g., mechanical, electrical, HVAC) shall be that degree of completion that has provided a minimum of thirty (30) continuous Days of successful, trouble-free operation, which period shall begin after all performance and acceptance testing has been successfully demonstrated to the Owner. All equipment contained in the Work, plus all other components necessary to enable the Owner to operate the facility in the manner that was intended, shall be complete on the Substantial Completion date. The Contractor may request that a Punch List be prepared by the Owner with submission of the request for the Substantial Completion notice.

K.4 TRAINING

As part of the Work, and prior to submission of the final application for payment, the Contractor shall schedule with the Owner training sessions for all equipment and systems as required by the Contract Documents. Contractor shall schedule training sessions at least two weeks in advance of the date of training to allow Owner to provide its personnel with adequate notice. If assignments arise because of termination under Section J.4, then such assignments shall not relieve Contractor of liability hereunder. The O & M Manual shall be used as a basis for training. In addition to any off-Project Site training required by the Contract Documents, training shall include a formal session conducted at the Project Site after the equipment and/or system is completely installed and operational in its normal operating environment.

K.5 EXTRA MATERIALS

As part of the Work, Contractor shall provide spare parts, extra maintenance materials, and other materials or products in the quantities specified in the Contract Documents prior to final payment. Delivery point for extra materials shall be designated by the Owner.

K.6 ENVIRONMENTAL CLEAN-UP

As part of the Final Completion notice, or as a separate written notice submitted with or before the notice of Final Completion, the Contractor shall notify the Owner that all environmental and pollution clean-up, remediation and closure have been completed in accordance with all Applicable Laws and pursuant to the authority of all agencies having jurisdiction, and Contractor shall provide Owner with any and all documentation related to the same, including but not limited to directives, orders, letters, certificates and permits related to or arising from such environmental pollution. The notice shall reaffirm the indemnification given under Section F.5.1 above. Contractor's completion of its obligations under this Section K.6 and Owner's receipt of documents evidencing such completion shall be a condition precedent to Owner's obligation to make final payment.

K.7 CERTIFICATE OF OCCUPANCY

Owner's receipt of an unconditioned certificate of occupancy from the appropriate state and/or local building officials shall be a condition precedent to Owner's obligation to make final payment, except to the extent failure to obtain an unconditional certificate of occupancy is due to the fault or neglect of Owner.

K.8 OTHER CONTRACTOR RESPONSIBILITIES

The Contractor shall be responsible for returning to the Owner all property of Owner issued to Contractor during construction such as keys, security passes, Project Site admittance badges, and all other pertinent items. Upon notice from Owner, Contractor shall be responsible for notifying the appropriate utility companies to transfer utility charges from the Contractor to the Owner. The utility transfer date shall not be before Substantial Completion and may not be until Final Completion, if the Owner does not take beneficial use of the facility and the Contractor's agents continue with the Work.

The Owner's property is drug free and weapons free areas and the use of tobacco products is only allowed in designated areas. Contractor shall be required to ensure that its employees, Subcontractors and agents shall comply with these requirements.

SECTION L GENERAL PROVISIONS

L.1 NO THIRD PARTY BENEFICIARIES

Owner and Contractor are the only parties to the Contract and are the only parties entitled to enforce its terms. Nothing in the Contract gives, is intended to give, or shall be construed to give or provide any benefit or right, whether directly, indirectly, or otherwise, to third persons unless such third persons are individually identified by name herein and expressly described as intended beneficiaries of the terms of the Contract.

L.2 SEVERABILITY

If any provision of the Contract is declared by a court to be unenforceable, illegal, or in conflict with any law, the validity of the remaining terms and provisions shall not be affected and the rights and obligations of the parties shall be construed and enforced as if the Contract did not contain the particular provision held to be invalid.

L.3 ACCESS TO RECORDS

L.3.1 Contractor shall keep, at all times on the Project Site, one record copy of the complete Contract Documents, including the Plans, Specifications, addenda, and Change Orders (if any) in good order and marked currently to record field changes and selections made during construction, and one record copy of Shop Drawings, Product Data, Samples and similar submittals, and shall at all times give the Owner access thereto.

L.3.2 Contractor shall retain and the Owner and its duly authorized representatives shall have access, for a period not less than ten (10) years, to all Record Documents, financial and accounting records, and other books, documents, papers and records of Contractor which are pertinent to the Contract, including records pertaining to Overhead and indirect costs, for the purpose of making audit, examination, excerpts and transcripts. If for any reason, any part of the Work or the Contract shall be subject to litigation, Contractor shall retain all such records until all litigation is resolved and Contractor shall continue to provide Owner and/or its agents with full access to such records until such time as all litigation is complete and all periods for appeal have expired and full and final satisfaction of any judgment, order or decree is recorded and Owner receives a record copy of documentation from Contractor.

L.4 WAIVER

Failure of the Owner to enforce any provision of the Contract shall not constitute a waiver or relinquishment by the Owner of the right to such performance in the future nor of the right to enforce any other provision of the Contract.

L.5 SUCCESSORS IN INTEREST

The provisions of the Contract shall be binding upon and shall accrue to the benefit of the parties to the Contract and their respective permitted successors and assigns.

L.6 GOVERNING LAW

The Contract shall be governed by and construed in accordance with the laws of the State of Oregon without giving effect to the conflict of law provisions thereof.

L.7 APPLICABLE LAW

Contractor hereto agrees to comply in all ways with applicable local, state and federal ordinances, statutes, laws and regulations.

L.8 NON-EXCLUSIVE RIGHTS AND REMEDIES

Except as otherwise expressly provided herein, the rights and remedies expressly afforded under the provisions of the Contract shall not be deemed exclusive, and shall be in addition to and cumulative with any and all rights and remedies otherwise available at law or in equity. The exercise by either Party of any one or more of such remedies shall not preclude the exercise by it, at the same or different times, of any other remedies for the same default or breach, or for any other default or breach, by the other Party.

L.9 INTERPRETATION

The titles of the sections of the Contract are inserted for convenience of reference only and shall be disregarded in construing or interpreting any of its provisions.

L.10 DEBT LIMITATION

The Contract is expressly subject to the debt limitation of Oregon counties set forth in Article XI, Section 10, of the Oregon Constitution, and is contingent upon funds being appropriated therefore. Any provisions herein which would conflict with law are deemed inoperative to that extent.

L.11 LITIGATION

Any Claim between Owner and Contractor that arises from or relates to the Contract and that is not resolved through the Claims Review Process in Section D.3 shall be brought and conducted solely and exclusively within the Circuit Court of Clackamas County for the State of Oregon; provided, however, if a Claim must be brought in a federal forum, then it

shall be brought and conducted solely and exclusively within the United States District Court for the District of Oregon. In no event shall this section be construed as a waiver by the County of any form of defense or immunity, whether sovereign immunity, governmental immunity, immunity based on the Eleventh Amendment to the Constitution of the United States or otherwise, from any claim or from the jurisdiction of any court. CONTRACTOR, BY EXECUTION OF THE CONTRACT, HEREBY CONSENTS TO THE IN PERSONAM JURISDICTION OF THE COURTS REFERENCED IN THIS SECTION.

L. 12 SURVIVAL

All warranty, indemnification, and record retention provisions of the Contract, and all of Contractor's other obligations under the Contract that are not fully performed by the time of Final Completion or termination, and all other rights and obligations which by their context are intended to survive, shall survive Final Completion or any termination of the Contract.

L.13 ACCESS TO RECORDS

- L.13.1. Contractor shall keep, at all times on the Work site, one record copy of the complete Contract Documents, including the Plans, Specifications, Construction Change Directives and addenda, in good order and marked currently to record field changes and selections made during construction, and one copy of Shop Drawings, Project Data, Samples and similar submittals, and shall at all times give the Owner access thereto.
- L.13.2 Contractor shall retain and the Owner and its duly authorized representatives shall have access, for a period not less than ten (10) years, to all Record Documents, financial and accounting records, and other books, documents, papers and records of Contractor which are pertinent to the Contract, including records pertaining to Overhead and indirect costs, for the purpose of making audit, examination, excerpts and transcripts. If for any reason, any part of the Work or this Contract shall be subject to litigation, Contractor shall retain all such records until all litigation is resolved and Contractor shall continue to provide Owner and/or its agents with full access to such records until such time as all litigation is complete and all periods for appeal have expired and full and final satisfaction of any judgment, order or decree is recorded and Owner receives a record copy of documentation from Contractor.

L.14 WAIVER

Failure of the Owner to enforce any provision of this Contract shall not constitute a waiver or relinquishment by the Owner of the right to such performance in the future nor of the right to enforce any other provision of this Contract.

L. 15 NO ATTORNEY FEES.

In the event any arbitration, action or proceeding, including any bankruptcy proceeding, is instituted to enforce any term of this Contract, each party shall be responsible for its own attorneys' fees and expenses.



CLACKAMAS COUNTY
PUBLIC IMPROVEMENT CONTRACT

PERFORMANCE BOND

Bond No.: 9454680

Solicitation: #2024-105

Project Name: Lake Road Health Center Flooring Project

Fidelity and Deposit

<u>Company of Maryland</u> (Surety #1)	Bond Amount No. 1:	<u>\$225,572.00</u>
<u>N/A</u> (Surety #2)*	Bond Amount No. 2:*	<u>\$N/A</u>
* If using multiple sureties		Total Penal Sum of Bond: <u>\$225,572.00</u>

We, Fabulous Floors, LLC, 13400 Midway Road, Farmers ** as Principal, and the above identified Surety(ies), authorized to transact surety business in Oregon, as Surety, hereby jointly and severally bind ourselves, our respective heirs, executors, administrators, successors and assigns firmly by these presents to pay unto Clackamas County, the sum of (Total Penal Sum of Bond) Two Hundred Twenty Five Thousand Five Hundred Seventy Two *** (Provided, that we the Sureties bind ourselves in such sum "jointly and severally" as well as "severally" only for the purpose of allowing a joint action or actions against any or all of us, and for all other purposes each Surety binds itself, jointly and severally with the Principal, for the payment of such sum only as is set forth opposite the name of such Surety); and

WHEREAS, the Principal has entered into a contract with Clackamas County, along with the plans, specifications, terms and conditions of which are contained in the above-referenced Solicitation; and

WHEREAS, the terms and conditions of the contract, together with applicable plans, standard specifications, special provisions, schedule of performance, and schedule of contract prices, are made a part of this Performance Bond by reference, whether or not attached to the contract (all hereafter called "Contract"); and

WHEREAS, the Principal has agreed to perform the Contract in accordance with the terms, conditions, requirements, plans and specifications, and all authorized modifications of the Contract which increase the amount of the work, the amount of the Contract, or constitute an authorized extension of the time for performance, notice of any such modifications hereby being waived by the Surety:

NOW, THEREFORE, THE CONDITION OF THIS BOND IS SUCH that if the Principal herein shall faithfully and truly observe and comply with the terms, conditions and provisions of the Contract, in all respects, and shall well and truly and fully do and perform all matters and things undertaken by Contractor to be performed under the Contract, upon the terms set forth therein, and within the time prescribed therein, or as extended as provided in the Contract, with or without notice to the Sureties, and shall defend, indemnify, and save harmless Clackamas County and its elected officials, officers, employees and agents, against any direct or indirect damages or claim of every kind and description that shall be suffered or claimed to be suffered in connection with or

arising out of the performance of the Contract by the Principal or its subcontractors, and shall in all respects perform said contract according to law, then this obligation is to be void; otherwise, it shall remain in full force and effect for so long as any term of the Contract remains in effect.

Nonpayment of the bond premium will not invalidate this bond nor shall Clackamas County, be obligated for the payment of any premiums.

This bond is given and received under authority of Oregon Revised Statutes Chapter 279C and the Clackamas County Local Contractor Review Board Rules, the provisions of which hereby are incorporated into this bond and made a part hereof.

IN WITNESS WHEREOF, WE HAVE CAUSED THIS INSTRUMENT TO BE EXECUTED AND SEALED BY OUR DULY AUTHORIZED LEGAL REPRESENTATIVES.

Dated this 7th day of March, 2025.

PRINCIPAL: Fabulous Floors, LLC

By: Michael Willis

President Signature

Official Capacity

Attest: By:

Corporation Secretary

SURETY: Fidelity and Deposit Company of Maryland
[Add signatures for each if using multiple bonds]

BY ATTORNEY-IN-FACT:

[Power-of-Attorney must accompany each bond]

Jennifer L. Clampert, Attorney-in-Fact

Name

J Clampert Signature

1299 Zurich Way, 10th Floor

Address

Schaumburg, IL 60196-1056

City

State

Zip

(847) 605-6000

(866) 947-1075

Phone

Fax





**CLACKAMAS COUNTY
PUBLIC IMPROVEMENT CONTRACT**

PAYMENT BOND

Bond No.: 9454680

Solicitation: #2024-105

Project Name: Lake Road Health Center Flooring Project

Fidelity and Deposit

Company of Maryland (Surety #1)

Bond Amount No. 1: \$ 225,572.00

N/A (Surety #2)*

Bond Amount No. 2: \$ N/A

*** If using multiple sureties**

Total Penal Sum of Bond: \$ 225,572.00

We, Fabulous Floors, LLC, 13400 Midway Road, Farmers **, as Principal, and the above identified Surety(ies), authorized to transact surety business in Oregon, as Surety, hereby jointly and severally bind ourselves, our respective heirs, executors, administrators, successors and assigns firmly by these presents to pay unto Clackamas County, the sum of (Total Penal Sum of Bond) Two Hundred Twenty Five Thousand Five Hundred Seventy Two *** (Provided, that we the Sureties bind ourselves in such sum "jointly and severally" as well as "severally" only for the purpose of allowing a joint action or actions against any or all of us, and for all other purposes each Surety binds itself, jointly and severally with the Principal, for the payment of such sum only as is set forth opposite the name of such Surety); and

WHEREAS, the Principal has entered into a contract with Clackamas County, along with the plans, specifications, terms and conditions of which are contained in above-referenced Solicitation; and

WHEREAS, the terms and conditions of the contract, together with applicable plans, standard specifications, special provisions, schedule of performance, and schedule of contract prices, are made a part of this Payment Bond by reference, whether or not attached to the contract (all hereafter called "Contract"); and

WHEREAS, the Principal has agreed to perform the Contract in accordance with the terms, conditions, requirements, plans and specifications, and schedule of contract prices which are set forth in the Contract and any attachments, and all authorized modifications of the Contract which increase the amount of the work, or the cost of the Contract, or constitute authorized extensions of time for performance of the Contract, notice of any such modifications hereby being waived by the Surety:

NOW, THEREFORE, THE CONDITION OF THIS BOND IS SUCH that if the Principal shall faithfully and truly observe and comply with the terms, conditions and provisions of the Contract, in all respects, and shall well and truly and fully do and perform all matters and things by it undertaken to be performed under said Contract and any duly authorized modifications that are made, upon the terms set forth therein, and within the time prescribed therein, or as extended therein as provided in the Contract, with or without notice to the Sureties, and shall defend, indemnify, and save harmless Clackamas County and its elected officials, officers, employees and agents, against any claim for direct or indirect damages of every kind and description that shall be suffered or claimed to be suffered in connection with or arising out of the performance of the Contract by the Contractor or its subcontractors, and shall promptly pay all persons supplying labor, materials or both to the Principal or its subcontractors for prosecution of the work provided in the Contract; and shall promptly pay all contributions due the State Industrial Accident Fund and the State Unemployment Compensation Fund from the Principal or its subcontractors in connection with the performance of the Contract; and shall pay over to the Oregon Department of Revenue all sums required to be deducted and retained from the wages of employees of the Principal and its subcontractors pursuant to ORS 316.167, and

shall permit no lien nor claim to be filed or prosecuted against Clackamas County on account of any labor or materials furnished; and shall do all things required of the Principal by the laws of this State, then this obligation shall be void; otherwise, it shall remain in full force and effect for so long as any term of the Contract remains in effect.

Nonpayment of the bond premium will not invalidate this bond nor shall Clackamas County be obligated for the payment of any premiums.

This bond is given and received under authority of Oregon Revised Statutes Chapter 279C and the Clackamas County Local Contractor Review Board Rules, the provisions of which hereby are incorporated into this bond and made a part hereof.

IN WITNESS WHEREOF, WE HAVE CAUSED THIS INSTRUMENT TO BE EXECUTED AND SEALED BY OUR DULY AUTHORIZED LEGAL REPRESENTATIVES:

Dated this 7th day of March, 2025.

PRINCIPAL: Fabulous Floors, LLC

By: Michael Willis

Signature

President

Official Capacity

Attest: By:

Corporation Secretary

SURETY: Fidelity and Deposit Company of Maryland
[Add signatures for each if using multiple bonds]

BY ATTORNEY-IN-FACT:

[Power-of-Attorney must accompany each bond]

Jennifer L. Clampert, Attorney-in-Fact

Name

By: J Clampert

Signature

1299 Zurich Way, 10th Floor

Address

Schaumburg, IL 60196-1056

City

State


Zip

(847) 605-6000

(866) 947-1075

Phone

Fax

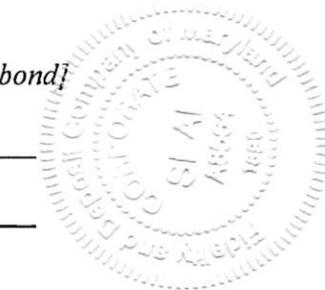

**ZURICH AMERICAN INSURANCE COMPANY
COLONIAL AMERICAN CASUALTY AND SURETY COMPANY
FIDELITY AND DEPOSIT COMPANY OF MARYLAND
POWER OF ATTORNEY**

KNOW ALL MEN BY THESE PRESENTS: That the ZURICH AMERICAN INSURANCE COMPANY, a corporation of the State of New York, the COLONIAL AMERICAN CASUALTY AND SURETY COMPANY, a corporation of the State of Illinois, and the FIDELITY AND DEPOSIT COMPANY OF MARYLAND a corporation of the State of Illinois (herein collectively called the "Companies"), by Robert D. Murray, Vice President, in pursuance of authority granted by Article V, Section 8, of the By-Laws of said Companies, which are set forth on the reverse side hereof and are hereby certified to be in full force and effect on the date hereof, do hereby nominate, constitute, and appoint **Ashlea MCCAUGHEY, Jennifer L. CLAMPERT, Nicole L. MCCOLLAM, Amy COONTS, Brandi J. TETLEY, Danielle WARING, Michael LISCHER JR., David DONDLINGER, Lindsey MINUTILLO** all of Denver, Colorado, its true and lawful agent and Attorney-in-Fact, to make, execute, seal and deliver, for, and on its behalf as surety, and as its act and deed: any and all bonds and undertakings, and the execution of such bonds or undertakings in pursuance of these presents, shall be as binding upon said Companies, as fully and amply, to all intents and purposes, as if they had been duly executed and acknowledged by the regularly elected officers of the ZURICH AMERICAN INSURANCE COMPANY at its office in New York, New York., the regularly elected officers of the COLONIAL AMERICAN CASUALTY AND SURETY COMPANY at its office in Owings Mills, Maryland., and the regularly elected officers of the FIDELITY AND DEPOSIT COMPANY OF MARYLAND at its office in Owings Mills, Maryland., in their own proper persons.

The said Vice President does hereby certify that the extract set forth on the reverse side hereof is a true copy of Article V, Section 8, of the By-Laws of said Companies, and is now in force.


IN WITNESS WHEREOF, the said Vice-President has hereunto subscribed his/her names and affixed the Corporate Seals of the said ZURICH AMERICAN INSURANCE COMPANY, COLONIAL AMERICAN CASUALTY AND SURETY COMPANY, and FIDELITY AND DEPOSIT COMPANY OF MARYLAND, this 5th day of April, A.D. 2024.



ATTEST:
**ZURICH AMERICAN INSURANCE COMPANY
COLONIAL AMERICAN CASUALTY AND SURETY COMPANY
FIDELITY AND DEPOSIT COMPANY OF MARYLAND**



By: Robert D. Murray
Vice President

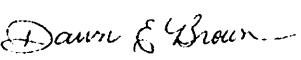


By: Dawn E. Brown
Secretary

**State of Maryland
County of Baltimore**

On this 5th day of April, A.D. 2024, before the subscriber, a Notary Public of the State of Maryland, duly commissioned and qualified, **Robert D. Murray, Vice President and Dawn E. Brown, Secretary** of the Companies, to me personally known to be the individuals and officers described in and who executed the preceding instrument, and acknowledged the execution of same, and being by me duly sworn, deposeth and saith, that he/she is the said officer of the Company aforesaid, and that the seals affixed to the preceding instrument are the Corporate Seals of said Companies, and that the said Corporate Seals and the signature as such officer were duly affixed and subscribed to the said instrument by the authority and direction of the said Corporations.

IN TESTIMONY WHEREOF, I have hereunto set my hand and affixed my Official Seal the day and year first above written.

Genevieve M. Maison

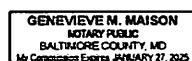

EXTRACT FROM BY-LAWS OF THE COMPANIES

"Article V, Section 8, Attorneys-in-Fact. The Chief Executive Officer, the President, or any Executive Vice President or Vice President may, by written instrument under the attested corporate seal, appoint attorneys-in-fact with authority to execute bonds, policies, recognizances, stipulations, undertakings, or other like instruments on behalf of the Company, and may authorize any officer or any such attorney-in-fact to affix the corporate seal thereto; and may with or without cause modify or revoke any such appointment or authority at any time."

CERTIFICATE

I, the undersigned, Vice President of the ZURICH AMERICAN INSURANCE COMPANY, the COLONIAL AMERICAN CASUALTY AND SURETY COMPANY, and the FIDELITY AND DEPOSIT COMPANY OF MARYLAND, do hereby certify that the foregoing Power of Attorney is still in full force and effect on the date of this certificate; and I do further certify that Article V, Section 8, of the By-Laws of the Companies is still in force.

This Power of Attorney and Certificate may be signed by facsimile under and by authority of the following resolution of the Board of Directors of the ZURICH AMERICAN INSURANCE COMPANY at a meeting duly called and held on the 15th day of December 1998.

RESOLVED: "That the signature of the President or a Vice President and the attesting signature of a Secretary or an Assistant Secretary and the Seal of the Company may be affixed by facsimile on any Power of Attorney...Any such Power or any certificate thereof bearing such facsimile signature and seal shall be valid and binding on the Company."

This Power of Attorney and Certificate may be signed by facsimile under and by authority of the following resolution of the Board of Directors of the COLONIAL AMERICAN CASUALTY AND SURETY COMPANY at a meeting duly called and held on the 5th day of May, 1994, and the following resolution of the Board of Directors of the FIDELITY AND DEPOSIT COMPANY OF MARYLAND at a meeting duly called and held on the 10th day of May, 1990.

RESOLVED: "That the facsimile or mechanically reproduced seal of the company and facsimile or mechanically reproduced signature of any Vice-President, Secretary, or Assistant Secretary of the Company, whether made heretofore or hereafter, wherever appearing upon a certified copy of any power of attorney issued by the Company, shall be valid and binding upon the Company with the same force and effect as though manually affixed.

IN TESTIMONY WHEREOF, I have hereunto subscribed my name and affixed the corporate seals of the said Companies, this _____ day of _____, _____.



Thomas O. McClellan

Thomas O. McClellan

Vice President

TO REPORT A CLAIM WITH REGARD TO A SURETY BOND, PLEASE SUBMIT A COMPLETE DESCRIPTION OF THE CLAIM INCLUDING THE PRINCIPAL ON THE BOND, THE BOND NUMBER, AND YOUR CONTACT INFORMATION TO:

Authenticity of this bond can be confirmed at bondvalidator.zurichna.com or 410-559-8790

Zurich Surety Claims
1299 Zurich Way
Schaumburg, IL 60196-1056
reportsfclaims@zurichna.com
800-626-4577



CLACKAMAS COUNTY
PUBLIC IMPROVEMENT CONTRACT
PROJECT INFORMATION, PLANS, SPECIFICATIONS AND DRAWINGS

PROJECT: BID# 2024-105 Lake Road Health Center Flooring Project

Background

Clackamas County Facilities Management, acting as a general contractor, is soliciting bids from qualified Contractors to complete various components of a 41,739 square foot remodel of a County owned building. The Lake Road Health Center is a three story building located at 6605 SE Lake Rd, Milwaukie, Oregon 97222. The building was built in 1992 and sits on 2.37 acres. Clackamas County proposed improvements include office and bathroom build outs within the existing building envelope indicated in the Contract Documents. Subcontracted work includes, but is not limited to, the following: Designated carpet, vinyl, and base removal and installation. A single contract shall be awarded to the lowest and most responsive bidder for this work.

Project Scope:

Work includes, but is not limited to, the following – 1. Removal of existing carpet, vinyl flooring and cove base; 2. Installation of new carpet tiles, linoleum, and cove base. Work requirements are described in the attached drawings and the following specifications.

Engineers Estimate: \$250,000.00

Key Dates:

All Basic Bid Work may begin as soon as the Notice to Proceed (“NTP”) is issued

Substantial Completion: March 28, 2025

Final Completion: April 14, 2025

The Scope further includes the following Plans, Specifications and Drawings:

- Resilient Flooring- (4 pages)
- Fluid-Applied Flooring- (2 pages)
- Carpet Tile- (2 pages)
- Lake Road Health Center Plan Set- (38 pages)

PART 1 GENERAL**RESILIENT FLOORING****1.01****SECTION INCLUDES**

- A. Resilient sheet flooring.
- B. Rubber Base (RB).
- C. Installation accessories.

1.02 REFERENCE STANDARDS

- A. ASTM E 648 - Standard Test Method for Critical Radiant Flux of Floor-Covering Systems Using a Radiant Heat Energy Source; 2008.
- B. ASTM F1066 - Standard Specification for Vinyl Composition Floor Tile; 2004 (Reapproved 2010)e1.
- C. ASTM F 1861 - Standard Specification for Resilient Wall Base; 2002.
- D. NFPA 253 - Standard Method of Test for Critical Radiant Flux of Floor Covering Systems Using a Radiant Heat Energy Source; National Fire Protection Association; 2011.

1.03 SUBMITTALS

- A. Product Data: Provide data on specified products, describing physical and performance characteristics; including sizes, patterns and colors available; and installation instructions.
- B. Shop Drawings: Indicate seaming plan.
- C. Verification Samples: Submit two samples, 12 by 12 inch in size illustrating color and pattern for each resilient flooring product specified.
- D. Maintenance Data: Include maintenance procedures, recommended maintenance materials, and suggested schedule for cleaning, stripping, and re-waxing.

1.04 DELIVERY, STORAGE, AND HANDLING

- A. Protect roll materials from damage by storing on end.

1.05 FIELD CONDITIONS

- A. Maintain temperature in storage area between 55 degrees F and 90 degrees F.
- B. Store materials for not less than 48 hours prior to installation in area of installation at a temperature of 70 degrees F to achieve temperature stability. Thereafter, maintain conditions above 55 degrees F.

PART 2 PRODUCTS**2.01 SHEET FLOORING****2.02 TILE FLOORING**

- A. Vinyl Composition Tile: Homogeneous, with color extending throughout thickness, and:
 - 1. Minimum Requirements: Comply with ASTM F1066, of Class corresponding to type specified.
 - 2. Critical Radiant Flux (CRF): Minimum 0.45 watt per square centimeter, when tested in accordance with ASTM E 648 or NFPA 253.
 - 3. Size: 12 x 12 inch.
 - 4. Thickness: 0.125 inch.
 - 5. Pattern: Solid color.
 - 6. Manufacturers:
 - a. Design Basis: Armstrong World Industries, Inc; Product Excelon Imperial Texture: www.armstrong.com.
 - 1) VCT-1 51805 Camel Beige
 - 2) VCT-2 51906 Teal

RESILIENT FLOORING

2.03 STAIR COVERING

- A. Stair Treads and Risers: Rubber; full width and depth of stair tread in one piece; tapered thickness; nosing not less than 1-5/8 inch deep.
 - 1. Design Basis: Johnsonite; Product Cubis (CRT).
 - a. Tensile Strength: ASTM D 412 > 1200 PSI
 - b. Hardness: ASTM D 2240 – Not less than 85 Shore A.
 - c. Abrasion Resistance: ASTM D 3389 <1.0 gm weight loss.
 - d. Slip Resistance: ASTM D 2047 – Meets or Exceeds a static coefficient of friction of 0.8
 - e. Color Heat Stability: ASTM F 1514 < 8.0 ΔE
 - f. Static Load Limit: ASTM F 970 – Passes at 250 PSI.
 - g. Fire Resistance:
 - 1) ASTM E 648/NFPA 253 (Critical Radiant Flux), Class 1.
 - 2) ASTM E 662/NFPA 258 (Smoke Density), less than 450.
- B. Stair Stringers: Full height in one piece and in maximum available lengths, matching treads in material and color:
 - 1. Thickness: 0.080 inch.
 - 2. Pattern: Solid color.

2.04 RESILIENT BASE

- A. Resilient Base: ASTM F1861, Type TS rubber, vulcanized thermoset; top set Style B, Cove, and as follows:
 - 1. Critical Radiant Flux (CRF): Minimum 0.45 watt per square centimeter, when tested in accordance with ASTM E 648 or NFPA 253.
 - 2. Height: 4 inch.
 - 3. Thickness: 0.125 inch thick.
 - 4. Finish: Satin.
 - 5. Length: Roll.
 - 6. Accessories: Premolded external corners and end stops.

2.05 ACCESSORIES

- A. Subfloor Filler: Modified Portland cement type recommended by adhesive material manufacturer.
- B. Primers, Adhesives, and Seaming Materials: Waterproof; types recommended by flooring manufacturer.
- C. Sealer and Wax: Types recommended by flooring manufacturer.

2.06 BASE SCHEDULE:

- A. RB-1: Manufacturer: Flexco
 - 1. Wallflowers - Style B, Cove
 - 2. Height: 4" in all rooms, 6" at janitor rooms
 - 3. Finish: Satin
 - 4. Length: Roll
 - 5. Color: #03 Charcoal

PART 3 EXECUTION

3.01 EXAMINATION

- A. Verify that surfaces are flat to tolerances acceptable to flooring manufacturer, free of cracks that might telegraph through flooring, clean, dry, and free of curing compounds, surface hardeners, and other chemicals that might interfere with bonding of flooring to substrate.
- B. Verify that sub-floor surfaces are smooth and flat within the tolerances specified for that type of work and are ready to receive resilient flooring.

RESILIENT FLOORING

- C. Verify that wall surfaces are smooth and flat within the tolerances specified for that type of work, are dust-free, and are ready to receive resilient base.
- D. Verify that sub-floor surfaces are dust-free and free of substances that could impair bonding of adhesive materials to sub-floor surfaces.
- E. Verify that concrete sub-floor surfaces are ready for resilient flooring installation by testing for moisture emission rate and alkalinity; obtain instructions if test results are not within the following limits:
 1. Moisture emission rate: Not greater than 3 lb per 1000 sq ft per 24 hours when tested using calcium chloride moisture test kit for 72 hours.
 2. Alkalinity: pH range of 5-9.
- F. Verify that required floor-mounted utilities are in correct location.

3.02 PREPARATION

- A. Prepare floor substrates as recommended by flooring and adhesive manufacturers.
- B. Remove sub-floor ridges and bumps. Fill minor low spots, cracks, joints, holes, and other defects with sub-floor filler to achieve smooth, flat, hard surface.
- C. Prohibit traffic until filler is cured.
- D. Clean substrate.
- E. Apply primer as required to prevent "bleed-through" or interference with adhesion by substances that cannot be removed.

3.03 INSTALLATION

- A. Starting installation constitutes acceptance of sub-floor conditions.
- B. Install in accordance with manufacturer's instructions.
- C. Spread only enough adhesive to permit installation of materials before initial set.
- D. Fit joints tightly.
- E. Set flooring in place, press with heavy roller to attain full adhesion.
- F. Where type of floor finish, pattern, or color are different on opposite sides of door, terminate flooring under centerline of door.
- G. Install edge strips at unprotected or exposed edges, where flooring terminates, and where indicated.
- H. Scribe flooring to walls, columns, cabinets, floor outlets, and other appurtenances to produce tight joints.

3.04 SHEET FLOORING

- A. Lay flooring with joints and seams parallel to longer room dimensions, to produce minimum number of seams. Lay out seams to avoid widths less than 1/3 of roll width; match patterns carefully at seams.
- B. Double cut sheet at seams.
- C. Lay flooring with tightly butted seams, without any seam sealer unless otherwise indicated.
- D. Double cut sheet; provide heat welded seams.

3.05 TILE FLOORING

- A. Mix tile from container to ensure shade variations are consistent when tile is placed, unless manufacturer's instructions say otherwise.

3.06 RESILIENT BASE

- A. Fit joints tightly and make vertical. Maintain minimum dimension of 18 inches between joints.
- B. Miter internal corners. At external corners, use premolded units. At exposed ends, use premolded units.

RESILIENT FLOORING

- C. Install base on solid backing. Bond tightly to wall and floor surfaces.
- D. Scribe and fit to door frames and other interruptions.

3.07 STAIR COVERINGS

- A. Install stair coverings in one piece for full width and depth of tread.
- B. Install stringers configured tightly to stair profile.
- C. Adhere over entire surface. Fit accurately and securely.

3.08 CLEANING

- A. Remove excess adhesive from floor, base, and wall surfaces without damage.
- B. Clean in accordance with manufacturer's instructions.
- C. Clean, seal, and wax resilient flooring products in accordance with manufacturer's instructions.

3.09 PROTECTION

- A. Prohibit traffic on resilient flooring for 48 hours after installation.

3.10 BASE SCHEDULE:

- A. RB-1: Manufacturer: Flexco
 - 1. Wallflowers - Style B, Cove
 - 2. Height: 4" in all rooms, 6" at janitor rooms
 - 3. Finish: Satin
 - 4. Length: Roll
 - 5. Color: #03 Charcoal

END OF SECTION

FLUID-APPLIED FLOORING

PART 1 GENERAL

1.01

SECTION INCLUDES

- A. Fluid-applied flooring and base.
- B. Integral colored patterns.

1.02 REFERENCE STANDARDS

- A. ASTM D570 - Standard Test Method for Water Absorption of Plastics; 1998 (Reapproved 2010).
- B. ASTM D638 - Standard Test Method for Tensile Properties of Plastics; 2010.
- C. ASTM D 695 - Standard Test Method for Compressive Properties of Rigid Plastics; 2008.
- D. ASTM D 905 - Standard Test Method for Strength Properties of Adhesive Bonds in Shear by Compression Loading; 2003.
- E. ASTM D4060 - Standard Test Method for Abrasion Resistance of Organic Coatings by the Taber Abraser; 2010.
- F. ASTM E84 - Standard Test Method for Surface Burning Characteristics of Building Materials; 2013a.
- G. ASTM E96/E96M - Standard Test Methods for Water Vapor Transmission of Materials; 2013.
- H. ASTM E 648 - Standard Test Method for Critical Radiant Flux of Floor-Covering Systems Using a Radiant Heat Energy Source; 2008.

1.03 SUBMITTALS

- A. Product Data: Provide data on specified products, describing physical and performance characteristics; sizes, patterns and colors available; and _____.
- B. Samples: Submit two samples, ____x____ inch in size illustrating color and pattern for each floor material for each color specified.
- C. Manufacturer's Installation Instructions: Indicate special procedures.
- D. Maintenance Data: Include maintenance procedures, recommended maintenance materials, procedures for stain removal, repairing surface, and suggested schedule for cleaning.

1.04 QUALITY ASSURANCE

- A. Manufacturer Qualifications: Company specializing in manufacturing products specified in this section with minimum three years documented experience.
- B. Applicator Qualifications: Company specializing in performing work of this section with minimum 5 years experience.
- C. Supervisor Qualifications: Trained by product manufacturer, under direct full time supervision of manufacturer's own foreman.

1.05 DELIVERY, STORAGE, AND HANDLING

- A. Store resin materials in a dry, secure area.
- B. Store materials for three days prior to installation in area of installation to achieve temperature stability.

1.06 FIELD CONDITIONS

- A. Maintain minimum temperature in storage area of 55 degrees F.
- B. Store materials in area of installation for minimum period of 24 hours prior to installation.
- C. Maintain ambient temperature required by manufacturer 72 hours prior to, during, and 24 hours after installation of materials.

FLUID-APPLIED FLOORING

PART 2 PRODUCT

S 2.01 MATERIALS

- A. Fluid-Applied Flooring : Epoxy base coat(s), polyurethane top coat, with light non-slip aggregate surfacing.
 - 1. Texture: Slip resistant.
 - 2. Sheen: High gloss.
 - 3. Color: To be selected by Architect.
 - 4. Base: 6 inch integral base, unless noted otherwise.
 - 5. Products:
 - a. Design Basis: Stonhard HRI or approved equal.
 - b. Substitutions: See Section 01 60 00 - Product Requirements.

2.02 ACCESSORIES

- A. Cant Strips: Molded of flooring resin material.
- B. Base: Embedded stainless steel cove closure strip.
- C. Subfloor Filler: White premix latex; type recommended by flooring material manufacturer.
- D. Primers and Adhesives: Waterproof; types recommended by flooring manufacturer.

PART 3 EXECUTION

3.01 EXAMINATION

- A. Verify that sub-floor surfaces are smooth and flat within the tolerances specified for that type of work and are ready to receive flooring.

3.02 PREPARATION

- A. Remove sub-floor ridges and bumps. Fill low spots, cracks, joints, holes, and other defects with sub-floor filler.
- B. If required by manufacturer as part of preparation requirements, apply, trowel, and float filler to achieve smooth, flat, hard surface. Grind irregularities above the surface level. Prohibit traffic until filler is cured.
- C. Vacuum clean substrate.
- D. Apply primer to surfaces required by flooring manufacturer.

3.03 INSTALLATION - FLOORING

- A. Apply in accordance with manufacturer's instructions.
- B. Apply each coat to minimum thickness indicated.
- C. Finish to smooth level surface.

3.04 PROTECTION

- A. Prohibit traffic on floor finish for 48 hours after installation.
- B. Barricade area to protect flooring until cured.

END OF SECTION

CARPET TILE

PART 1 GENERAL

1.01 SECTION INCLUDES

- A. Carpet tile, fully adhered.
- B. Accessories

1.02 REFERENCE STANDARDS

- A. CRI (CIS) - Carpet Installation Standard; Carpet and Rug Institute; 2009.
- B. CRI (GLA) - Green Label Testing Program - Approved Adhesive Products; Carpet and Rug Institute; current listings at www.carpet-rug.org.

1.03 SUBMITTALS

- A. Shop Drawings: Indicate layout of joints.
- B. Product Data: Provide data on specified products, describing physical and performance characteristics; sizes, patterns, colors available, and method of installation.
- C. Samples: Submit two carpet tiles illustrating color and pattern design for each carpet color selected.
- D. Manufacturer's Installation Instructions: Indicate special procedures.
- E. Maintenance Data: Include maintenance procedures, recommended maintenance materials, and suggested schedule for cleaning.

1.04 QUALITY ASSURANCE

1.05 FIELD CONDITIONS

- A. Store materials in area of installation for minimum period of 24 hours prior to installation.

PART 2 PRODUCTS

2.01 MATERIALS

- A. For carpet tile types, see schedule at end of section.

2.02 ACCESSORIES

- A. Sub-Floor Filler: Modified Portland cement type recommended by flooring material manufacturer.
- B. Edge Strips: Embossed aluminum, clear anodized color.
- C. Recessed Frame: 1/8 inch thick zinc exposed top strip, zinc coated steel concealed bottom strip, 1/2 inch deep, with anchoring features.
 - 1.
- D. Adhesives: Acceptable to carpet tile manufacturer, compatible with materials being adhered; maximum VOC of 50 g/L; CRI Green Label certified; in lieu of labeled product, independent test report showing compliance is acceptable.

PART 3 EXECUTION

3.01 EXAMINATION

- A. Verify that sub-floor surfaces are smooth and flat within tolerances specified for that type of work and are ready to receive carpet tile.
- B. Verify that wall surfaces are smooth and flat within the tolerances specified for that type of work, are dust-free, and are ready to receive carpet tile.
- C. Verify that sub-floor surfaces are dust-free and free of substances that could impair bonding of adhesive materials to sub-floor surfaces.
- D. Verify that concrete sub-floor surfaces are ready for carpet tile installation by testing for moisture emission rate and alkalinity; obtain instructions if test results are not within the following limits:
 - 1. Moisture emission rate: Not greater than 3 lb per 1000 sq ft per 24 hours when tested using calcium chloride moisture test kit for 72 hours.

CARPET TILE

2. Alkalinity: pH range of 5-9.
- E. Verify that required floor-mounted utilities are in correct location.

3.02 PREPARATION

- A. Remove sub-floor ridges and bumps. Fill minor or local low spots, cracks, joints, holes, and other defects with sub-floor filler.
- B. Apply, trowel, and float filler to achieve smooth, flat, hard surface. Prohibit traffic until filler is cured.
- C. Vacuum clean substrate.

3.03 INSTALLATION

- A. Starting installation constitutes acceptance of sub-floor conditions.
- B. Install carpet tile in accordance with manufacturer's instructions and CRI Carpet Installation Standard.
- C. Blend carpet from different cartons to ensure minimal variation in color match.
- D. Cut carpet tile clean. Fit carpet tight to intersection with vertical surfaces without gaps.
- E. Lay carpet tile in square pattern, with pile direction parallel to next unit, set parallel to building lines.
- F. Fully adhere carpet tile to substrate.
- G. Trim carpet tile neatly at walls and around interruptions.
- H. Complete installation of edge strips, concealing exposed edges.

3.04 CLEANING

- A. Remove excess adhesive without damage, from floor, base, and wall surfaces.
- B. Clean and vacuum carpet surfaces.

3.05 CARPET TILE SCHEDULE



- A. Tile Type CPT-2: Manufacturer: Mohawk
 1. Custom Carpet Tile: Trax with matched colors from Penciled plum, Graphic edge for less sculpted look.
 2. Color: #G3702
 3. Tile Size: 24 X 24
 4. Backing System: UltraSet Modular System

END OF SECTION

LAKE ROAD HEALTH CENTER

6605 SE Lake Rd, Milwaukie, OR 97222

PHASE: BUILDING PERMIT
CLIENT: CLACKAMAS COUNTY

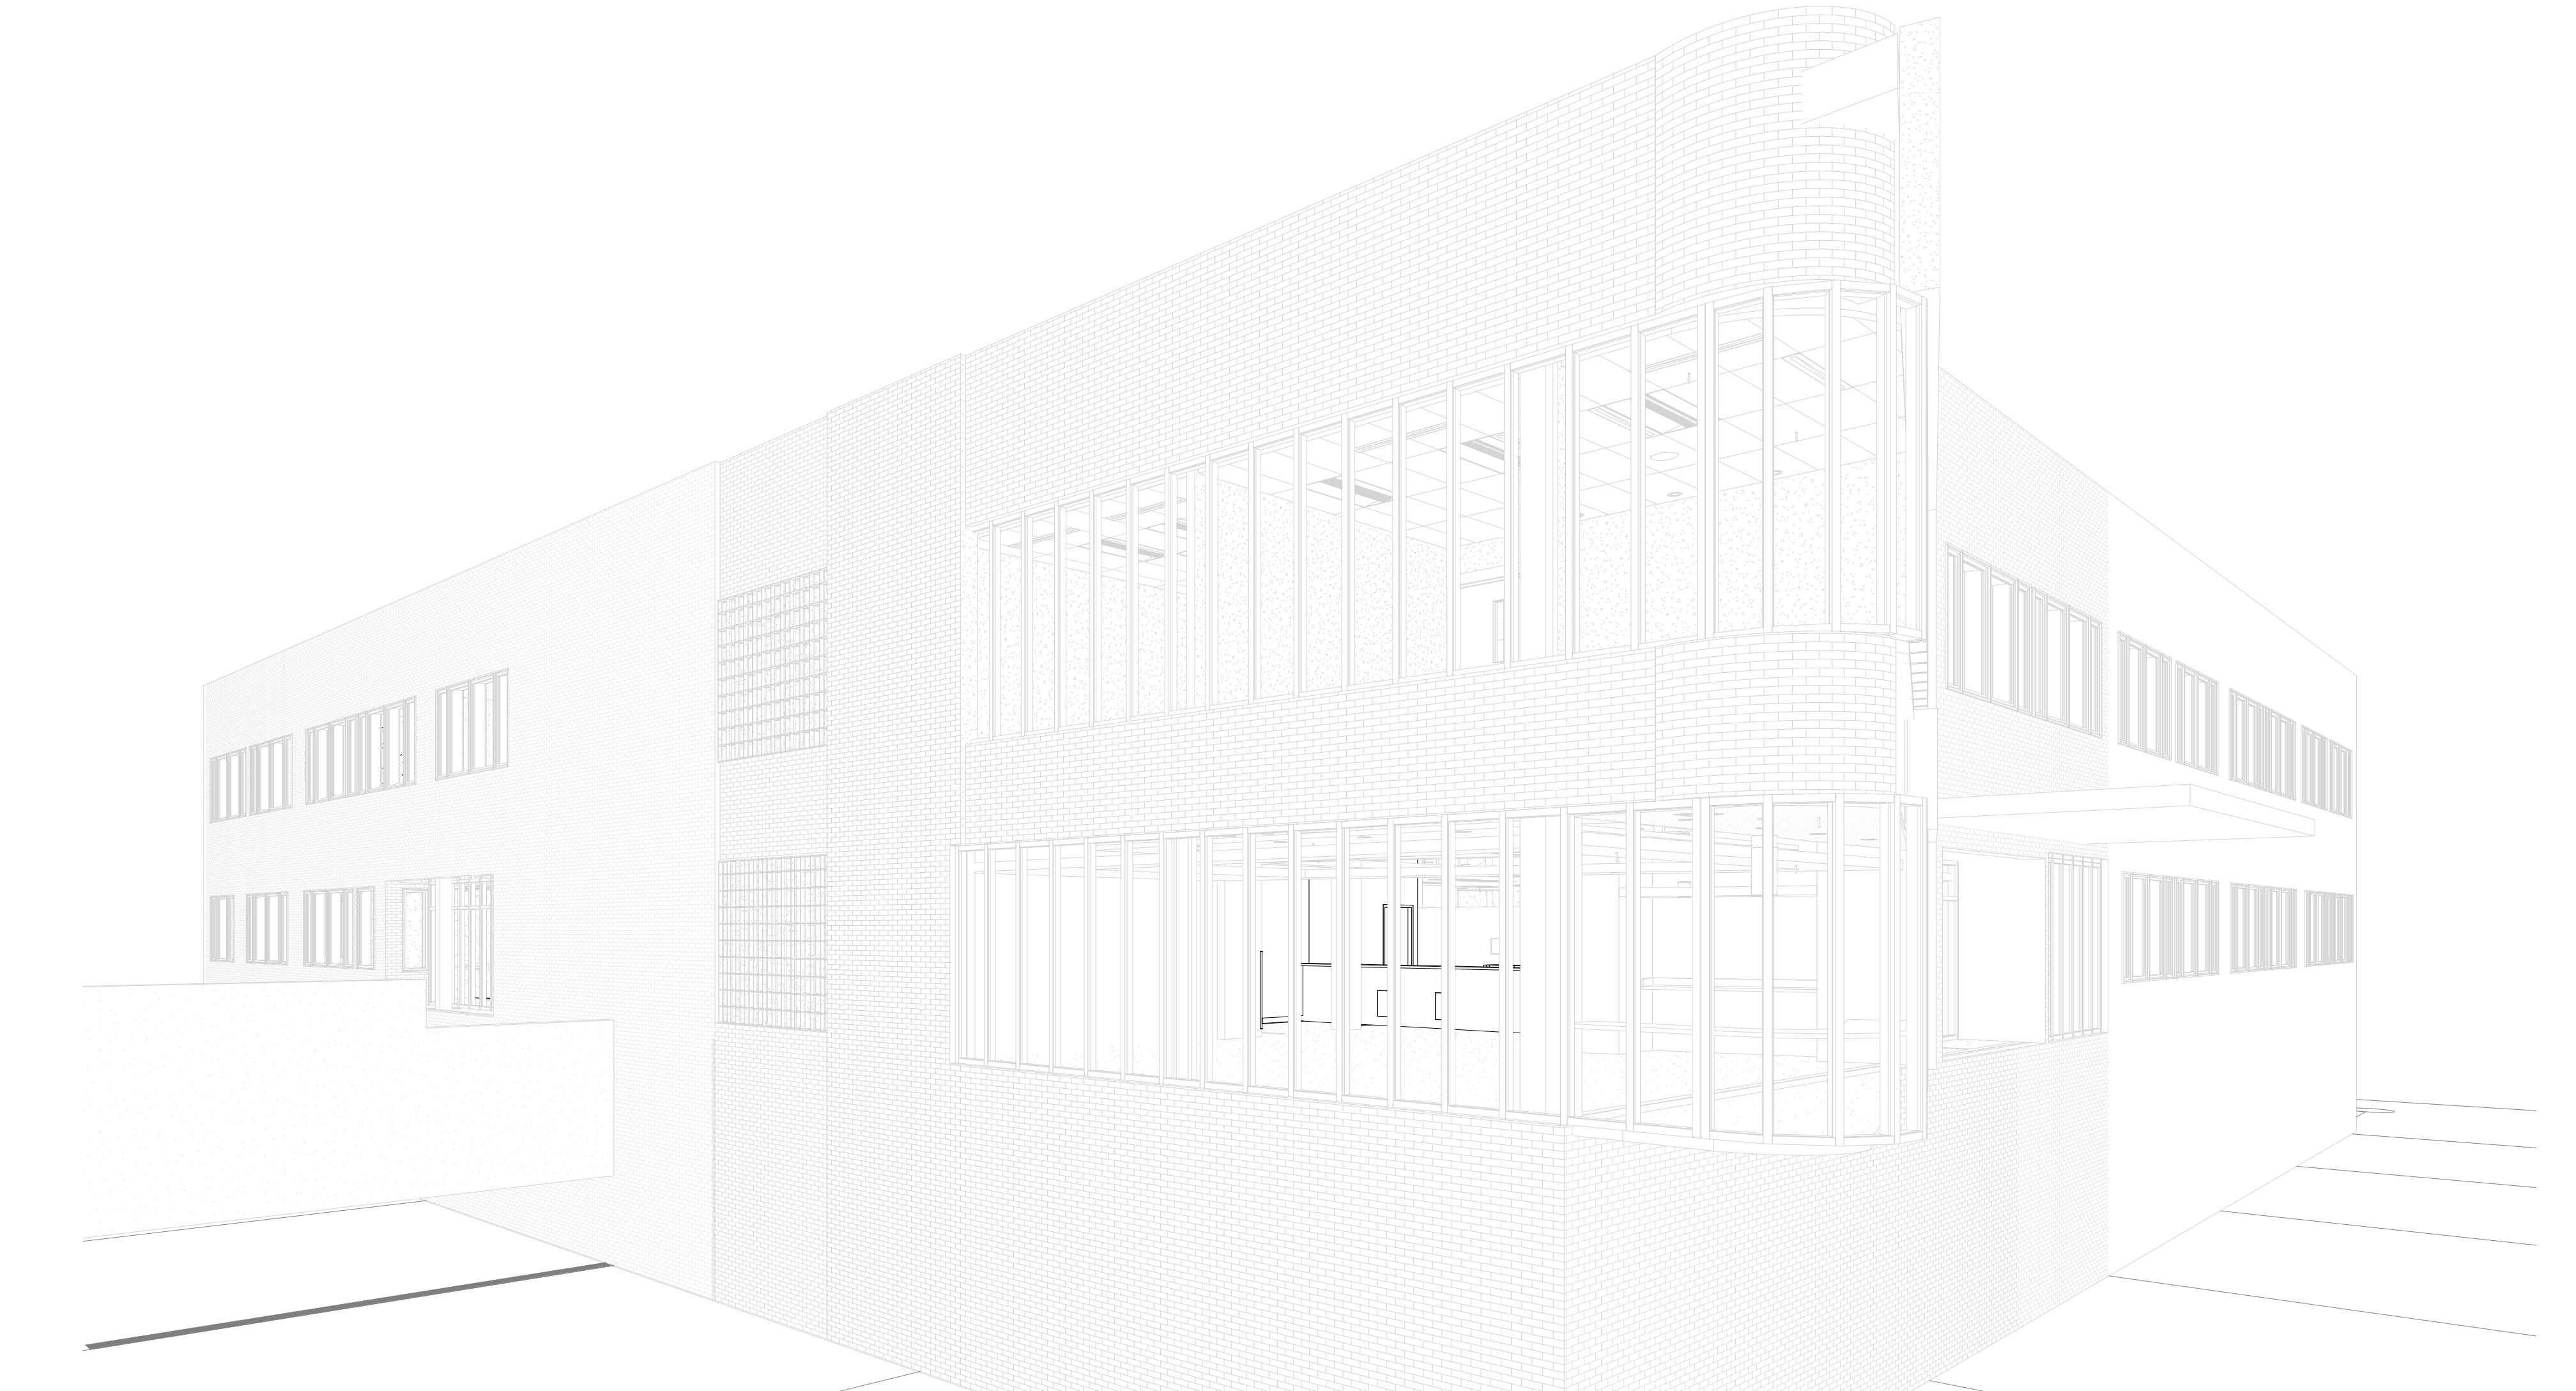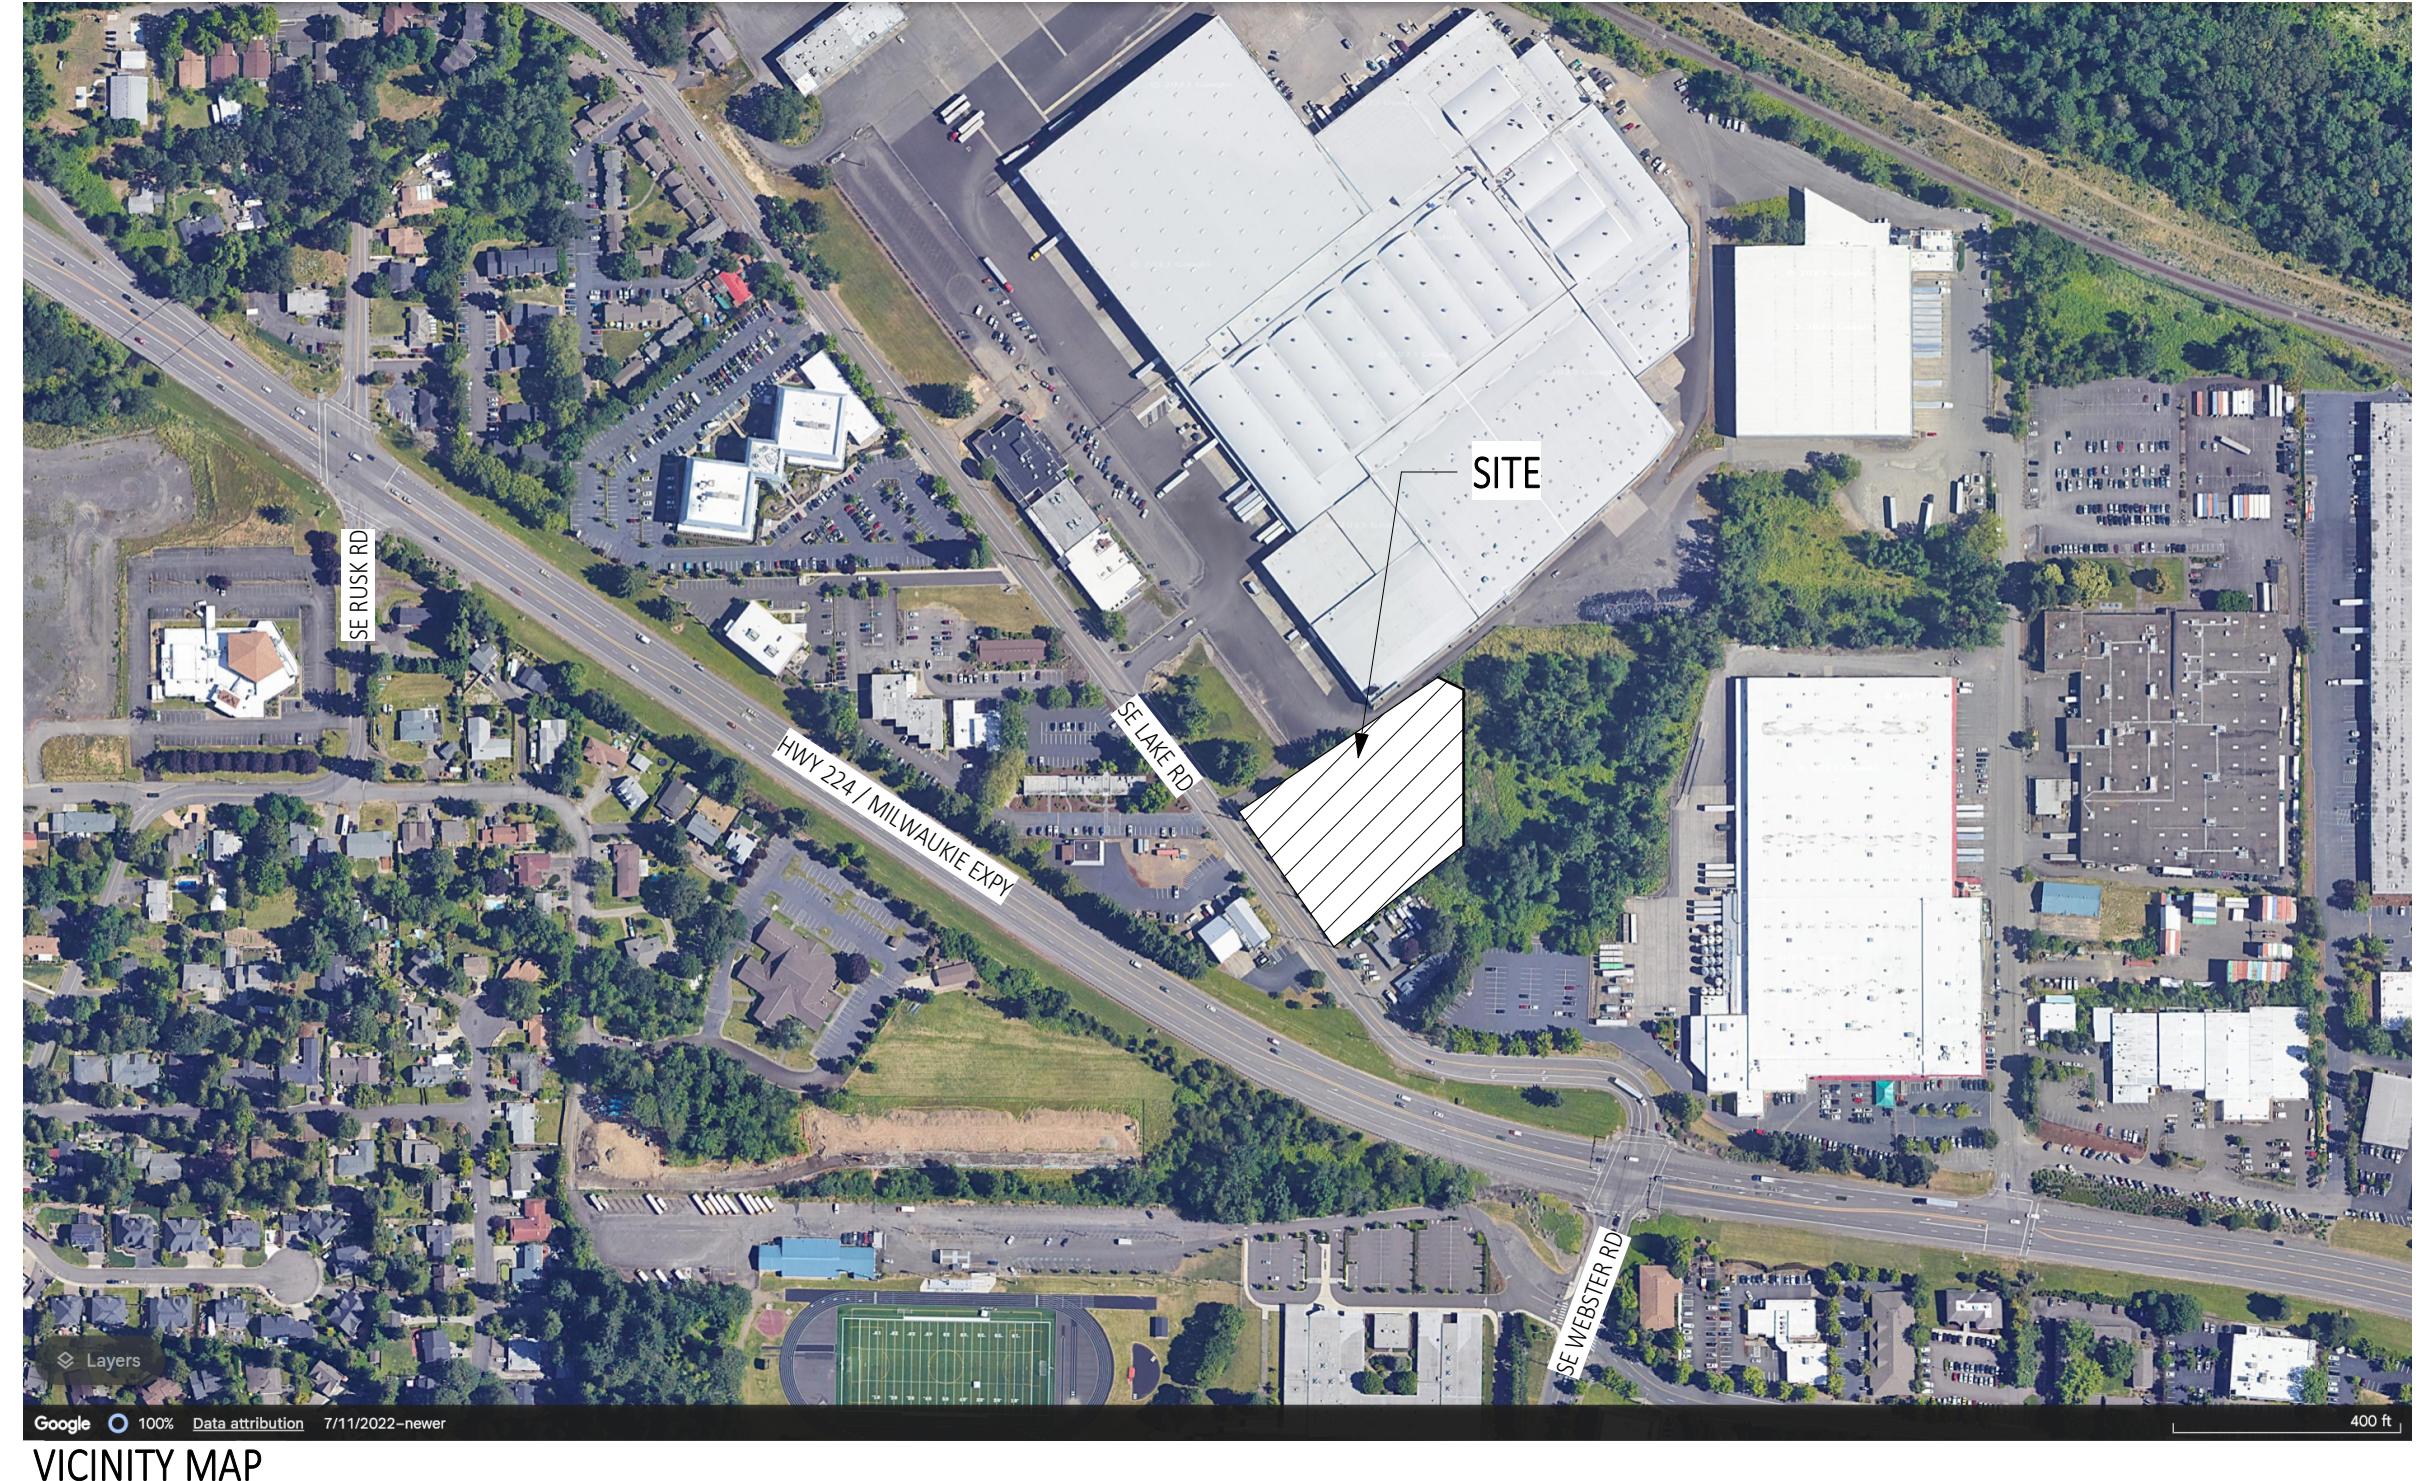


PROJECT CONTACT INFORMATION		PROJECT INFORMATION	DRAWING INDEX																																																																												
<p>OWNER: CLACKAMAS COUNTY BEHAVIORAL HEALTH 150 BEAVERCREEK ROAD OREGON CITY, OR 97045 PHONE: 503-351-4012 CONTACT: JASON VARGA</p> <p>STRUCTURAL: FROELICH ENGINEERS 17705SW UPPER BOONES FERRY RD. SUITE 115 PORTLAND, OR 97224 PHONE: 503-624-7005 CONTACT: YASHAR SARAFOUR</p>	<p>ARCHITECT: PINNACLE ARCHITECTURE, INC 1001 SW DISK DRIVE, SUITE 105 BEND, OREGON 97702 PHONE: (541) 388-9897 CONTACT: KALINA KUNERT</p> <p>PHARMACY DESIGN: GENOA HEALTHCARE CHICAGO IL PHONE: (785) 221-5023 CONTACT: CODY HALTHAUS EMAIL: CHOLTHAUS@GENOAEALTHCARE.COM</p>	<p>DESCRIPTION / SCOPE OF WORK: INTERIOR REMODEL OF EXISTING 3-STORY OFFICE BUILDING. NON-LOAD BEARING WALLS ONLY. ALL MEP WORK TO BE DONE UNDER SEPARATE PERMIT AS LISTED BELOW. NO EXTERIOR WORK OTHER THAN REQUIRED ADA UPGRADES AND MAINTENANCE.</p> <p>OCCUPANCY TYPE: BUSINESS</p> <p>CONSTRUCTION TYPE: II-B</p> <p>LEGAL DESCRIPTION: TAX LOT 22058 00401</p> <p>ZONING: OC</p> <p>LOT SIZE: 2.37 ACRES</p> <p>PARKING: ACCESSIBLE: EXISTING PROVIDED: 5 STANDARD: EXISTING PROVIDED: 135 TOTAL: EXISTING PROVIDED: 140</p> <p>SETBACKS: FRONT: 15'-0" MIN - 20'-0" MAX. SIDE: 10'-0" SIDE: 10'-0" REAR: 10'-0"</p> <p>SEPARATE PERMITS: FIRE ALARM FIRE SPRINKLER MECHANICAL ELECTRICAL PLUMBING LOW VOLTAGE</p> <table border="1"> <tr> <td colspan="2">BUILDING INFORMATION</td> </tr> <tr> <td>Name</td> <td>Area</td> </tr> <tr> <td>BUSINESS</td> <td>41,739 SF</td> </tr> <tr> <td>GRAND TOTAL</td> <td>41,739 SF</td> </tr> </table>	BUILDING INFORMATION		Name	Area	BUSINESS	41,739 SF	GRAND TOTAL	41,739 SF	<p>01 - GENERAL</p> <table border="1"> <tr> <td>G0.10</td> <td>COVER</td> </tr> <tr> <td>G0.11</td> <td>NOTES & CONVENTIONS</td> </tr> <tr> <td>G1.10</td> <td>CODE PLAN</td> </tr> <tr> <td>G5.10</td> <td>GENERAL ACCESSIBILITY DETAILS</td> </tr> <tr> <td>G6.10</td> <td>EXISTING PHOTOS - REFERENCE ONLY</td> </tr> </table> <p>03 - SITE</p> <table border="1"> <tr> <td>AS1.10</td> <td>ARCHITECTURAL SITE PLAN</td> </tr> </table> <p>05 - STRUCTURAL</p> <table border="1"> <tr> <td>S0.00</td> <td>COVER SHEET</td> </tr> <tr> <td>S0.01</td> <td>GSN AND SPECIAL INSPECTION TABLES</td> </tr> <tr> <td>S1.10</td> <td>2ND FLOOR FRAMING PLAN</td> </tr> <tr> <td>S1.11</td> <td>3RD FLOOR FRAMING PLAN</td> </tr> <tr> <td>S1.12</td> <td>ROOF FRAMING PLAN</td> </tr> <tr> <td>S6.00</td> <td>NON-STRUCTURAL WALL DETAILS</td> </tr> <tr> <td>S6.01</td> <td>NON-STRUCTURAL WALL DETAILS</td> </tr> <tr> <td>S6.10</td> <td>SUSPENDED CEILING DETAILS</td> </tr> <tr> <td>S6.11</td> <td>SUSPENDED CEILING DETAILS</td> </tr> </table> <p>06 - ARCHITECTURAL DEMO</p> <table border="1"> <tr> <td>AD1.11</td> <td>1ST FLOOR PLAN - DEMO</td> </tr> <tr> <td>AD1.12</td> <td>2ND FLOOR PLAN - DEMO</td> </tr> <tr> <td>AD1.13</td> <td>3RD FLOOR PLAN - DEMO</td> </tr> </table> <p>07 - ARCHITECTURAL</p> <table border="1"> <tr> <td>A1.10</td> <td>1ST FLOOR PLAN</td> </tr> <tr> <td>A1.11</td> <td>2ND FLOOR PLAN</td> </tr> <tr> <td>A1.12</td> <td>3RD FLOOR PLAN</td> </tr> <tr> <td>A1.20</td> <td>1ST FLOOR EXISTING REFLECTED CEILING PLAN</td> </tr> <tr> <td>A1.21</td> <td>2ND FLOOR EXISTING REFLECTED CEILING PLAN</td> </tr> <tr> <td>A1.22</td> <td>3RD FLOOR EXISTING REFLECTED CEILING PLAN</td> </tr> <tr> <td>A1.40</td> <td>1ST FLOOR FINISH FLOOR PLAN</td> </tr> <tr> <td>A1.41</td> <td>2ND FLOOR FINISH FLOOR PLAN</td> </tr> <tr> <td>A1.42</td> <td>3RD FLOOR FINISH FLOOR PLAN</td> </tr> <tr> <td>A1.43</td> <td>INTERIOR FINISH SCHEDULES</td> </tr> <tr> <td>A2.20</td> <td>ENLARGED PLANS & INTERIOR ELEVATIONS</td> </tr> <tr> <td>A2.21</td> <td>ENLARGED PLANS & INTERIOR ELEVATIONS</td> </tr> <tr> <td>A5.20</td> <td>INTERIOR DETAILS - REFLECTED CEILING & DOOR DETAILS</td> </tr> <tr> <td>A5.23</td> <td>INTERIOR DETAILS - CASEWORK</td> </tr> <tr> <td>A6.10</td> <td>ASSEMBLIES</td> </tr> <tr> <td>A6.20</td> <td>DOORS & WINDOWS</td> </tr> </table>	G0.10	COVER	G0.11	NOTES & CONVENTIONS	G1.10	CODE PLAN	G5.10	GENERAL ACCESSIBILITY DETAILS	G6.10	EXISTING PHOTOS - REFERENCE ONLY	AS1.10	ARCHITECTURAL SITE PLAN	S0.00	COVER SHEET	S0.01	GSN AND SPECIAL INSPECTION TABLES	S1.10	2ND FLOOR FRAMING PLAN	S1.11	3RD FLOOR FRAMING PLAN	S1.12	ROOF FRAMING PLAN	S6.00	NON-STRUCTURAL WALL DETAILS	S6.01	NON-STRUCTURAL WALL DETAILS	S6.10	SUSPENDED CEILING DETAILS	S6.11	SUSPENDED CEILING DETAILS	AD1.11	1ST FLOOR PLAN - DEMO	AD1.12	2ND FLOOR PLAN - DEMO	AD1.13	3RD FLOOR PLAN - DEMO	A1.10	1ST FLOOR PLAN	A1.11	2ND FLOOR PLAN	A1.12	3RD FLOOR PLAN	A1.20	1ST FLOOR EXISTING REFLECTED CEILING PLAN	A1.21	2ND FLOOR EXISTING REFLECTED CEILING PLAN	A1.22	3RD FLOOR EXISTING REFLECTED CEILING PLAN	A1.40	1ST FLOOR FINISH FLOOR PLAN	A1.41	2ND FLOOR FINISH FLOOR PLAN	A1.42	3RD FLOOR FINISH FLOOR PLAN	A1.43	INTERIOR FINISH SCHEDULES	A2.20	ENLARGED PLANS & INTERIOR ELEVATIONS	A2.21	ENLARGED PLANS & INTERIOR ELEVATIONS	A5.20	INTERIOR DETAILS - REFLECTED CEILING & DOOR DETAILS	A5.23	INTERIOR DETAILS - CASEWORK	A6.10	ASSEMBLIES	A6.20	DOORS & WINDOWS
BUILDING INFORMATION																																																																															
Name	Area																																																																														
BUSINESS	41,739 SF																																																																														
GRAND TOTAL	41,739 SF																																																																														
G0.10	COVER																																																																														
G0.11	NOTES & CONVENTIONS																																																																														
G1.10	CODE PLAN																																																																														
G5.10	GENERAL ACCESSIBILITY DETAILS																																																																														
G6.10	EXISTING PHOTOS - REFERENCE ONLY																																																																														
AS1.10	ARCHITECTURAL SITE PLAN																																																																														
S0.00	COVER SHEET																																																																														
S0.01	GSN AND SPECIAL INSPECTION TABLES																																																																														
S1.10	2ND FLOOR FRAMING PLAN																																																																														
S1.11	3RD FLOOR FRAMING PLAN																																																																														
S1.12	ROOF FRAMING PLAN																																																																														
S6.00	NON-STRUCTURAL WALL DETAILS																																																																														
S6.01	NON-STRUCTURAL WALL DETAILS																																																																														
S6.10	SUSPENDED CEILING DETAILS																																																																														
S6.11	SUSPENDED CEILING DETAILS																																																																														
AD1.11	1ST FLOOR PLAN - DEMO																																																																														
AD1.12	2ND FLOOR PLAN - DEMO																																																																														
AD1.13	3RD FLOOR PLAN - DEMO																																																																														
A1.10	1ST FLOOR PLAN																																																																														
A1.11	2ND FLOOR PLAN																																																																														
A1.12	3RD FLOOR PLAN																																																																														
A1.20	1ST FLOOR EXISTING REFLECTED CEILING PLAN																																																																														
A1.21	2ND FLOOR EXISTING REFLECTED CEILING PLAN																																																																														
A1.22	3RD FLOOR EXISTING REFLECTED CEILING PLAN																																																																														
A1.40	1ST FLOOR FINISH FLOOR PLAN																																																																														
A1.41	2ND FLOOR FINISH FLOOR PLAN																																																																														
A1.42	3RD FLOOR FINISH FLOOR PLAN																																																																														
A1.43	INTERIOR FINISH SCHEDULES																																																																														
A2.20	ENLARGED PLANS & INTERIOR ELEVATIONS																																																																														
A2.21	ENLARGED PLANS & INTERIOR ELEVATIONS																																																																														
A5.20	INTERIOR DETAILS - REFLECTED CEILING & DOOR DETAILS																																																																														
A5.23	INTERIOR DETAILS - CASEWORK																																																																														
A6.10	ASSEMBLIES																																																																														
A6.20	DOORS & WINDOWS																																																																														
			<p>APPROVED FOR</p> <p>BUILDING PERMIT 02.02.24 KK</p> <p>DESCRIPTION DATE DATE</p> <p>COVER</p> <p>PROJECT NO: 2221.HCR</p> <p>DRAWN BY: BJL</p> <p>CHECKED BY: PETER BAER</p> <p>© PINNACLE ARCHITECTURE, INC. 2024 ORIGINAL SHEET SIZE: 30" x 42"</p> <p>G0.10</p>																																																																												


GENERAL NOTES

1. THIS DESIGN IS AN ORIGINAL UNPUBLISHED WORK AND MAY NOT BE DUPLICATED, PUBLISHED AND/OR USED WITHOUT THE WRITTEN CONSENT OF THE ARCHITECT.
2. THESE SHEETS - LISTED BY DRAWING INDEX, ALL ACCOMPANYING SPECIFICATIONS FOR MATERIALS, WORKMANSHIP QUALITY, AND NOTES HAVE BEEN PREPARED SOLELY FOR THE CONSTRUCTION AND FINISH OF PROJECT IMPROVEMENTS.
3. ALL WORK IS TO BE PERFORMED IN ACCORDANCE WITH PERTINENT JURISDICTIONAL CODES, RESTRICTIONS, COVENANTS, AND/OR ORDINANCES. ANY CONFLICT BETWEEN DESIGN AND REQUIREMENT SHALL BE REPORTED TO THE ARCHITECT BEFORE PROCEEDING. ALL WORK SHALL BE INSPECTED BY GOVERNING AGENCIES IN ACCORDANCE WITH THEIR REQUIREMENTS. JURISDICTIONAL APPROVAL SHALL BE SECURED BEFORE PROCEEDING WITH WORK.
4. ANY AND ALL PROPOSED CHANGES, MODIFICATIONS AND/OR SUBSTITUTIONS SHALL BE REPORTED TO THE ARCHITECT BEFORE PROCEEDING. ANY DEVIATION FROM THE CONTRACT DOCUMENTS, WITHOUT THE EXPRESS WRITTEN AUTHORIZATION OF THE ARCHITECT, BECOMES THE RESPONSIBILITY OF THE CONTRACTOR.
5. IN THE EVENT OF CONFLICT BETWEEN THE DESIGN DOCUMENTS AND/OR JURISDICTIONAL REQUIREMENTS, THE MORE RESTRICTIVE FROM THE STANDPOINT OF SAFETY AND PHYSICAL SECURITY SHALL APPLY.
6. ANY INSTALLATION OR WORK NECESSARY TO THE FUNCTIONING, SAFETY AND/OR PHYSICAL SECURITY OF DESIGN THAT IS TO BE ENCAPSULATED OR OTHERWISE PERMANENTLY OBSCURED FROM INSPECTION SHALL BE REPORTED TO THE ARCHITECT. A MINIMUM OF TWO (2) WORKING DAYS BEFORE ENCLOSURE.
7. ANY INSTALLATION, FINISH, OR COMPONENT INTENDED TO PROVIDE ENCLOSURE, WEATHERABILITY OR APPEARANCE QUALITY SHALL BE PRODUCED AS A REPRESENTATIVE SAMPLE PRIOR TO PROCEEDING WITH COMPLETION. WORK PERFORMED WITHOUT WRITTEN APPROVAL OF SUCH SAMPLE BY THE ARCHITECT SHALL BE DONE AT THE RISK OF THE CONTRACTOR. A MINIMUM OF TWO (2) WORKING DAYS NOTICE SHALL BE GIVEN.
8. BUILDING DESIGN IS GENERALLY PREDICATED UPON PROVISIONS OF THE CURRENT EDITION OF THE IBC AND/OR AMENDMENTS AS MAY HAVE BEEN LOCALLY ADOPTED. ALL REQUIREMENTS OF THE JURISDICTIONAL FIRE SAFETY/PREVENTION DISTRICT SHALL BE ACCOMMODATED BY THIS DESIGN AND ANY CONSEQUENT CONSTRUCTION.
9. ANY DAMAGE, DISRUPTION OR COMPROMISE OF AMBIENT RIGHTS-OF-WAY, UTILITIES, OR ENVIRONMENTAL QUALITY SHALL BE IMMEDIATELY RECTIFIED BY THE CONTRACTOR TO THE SATISFACTION OF THE ARCHITECT AT NO ADDITIONAL COST TO THE OWNER.
10. ALL PENETRATIONS OF RATED ASSEMBLIES SHALL BE PROTECTED BY MATERIALS AND CONSTRUCTION THAT CONFORMS TO UNDERWRITERS LABORATORIES LISTINGS FOR "THROUGH-PENETRATION FIRE STOP SYSTEMS". THE CONTRACTOR SHALL SUBMIT SHOP DRAWING DETAILS, PROVIDED BY THE SUPPLIER OF THE FIRE STOP MATERIAL, THAT INDICATE COMPLETE CONFORMANCE WITH THE UL LISTING. DRAWINGS SHALL REMAIN AVAILABLE AT THE WORK SITE TO ARCHITECT, OWNER, AND INSPECTORS. DRAWINGS SHALL BE SPECIFIC FOR EACH PENETRATION, WITH APPROPRIATE UL # AND ALL VARIATIONS CLEARLY DEFINED.
11. THIS DESIGN PURPORTS TO PERMIT FULL ACCOMMODATION ACCESS, AND/OR ADAPTABILITY FOR HANDICAPPED PERSONS AS PROVIDED FOR BY PROVISIONS OF FEDERAL LAW AND LOCAL STIPULATION. ANY DEVIATION OR COMPROMISE SHALL BE REPORTED TO THE ARCHITECT BEFORE PROCEEDING WITH WORK.
12. DIMENSIONS (ON ARCHITECTURAL DRAWINGS) ARE TAKEN TO:
 - A. COORDINATE GRID LINES
 - B. FACE OF CONCRETE OR CONCRETE MASONRY UNITS (CMU) - F.O.C.
 - C. FACE OF VERTICAL STUD OR COLUMN - F.O.S. UNLESS NOTATED WITH C INDICATING THAT DIMENSION IS TO CENTERLINE.
 - D. TOP SURFACE OF FLOOR (WITHOUT FINISH), WALL, TRIM, CAP, RAILING, ETC. ABOVE NEAREST REFERENCE LEVEL - A.F.F.
 - E. CENTER OF HORIZONTAL OPENING OF DOOR & WINDOW LOCATIONS, UNLESS NOTED OTHERWISE.
13. DO NOT SCALE DRAWINGS.

HATCH PATTERNS

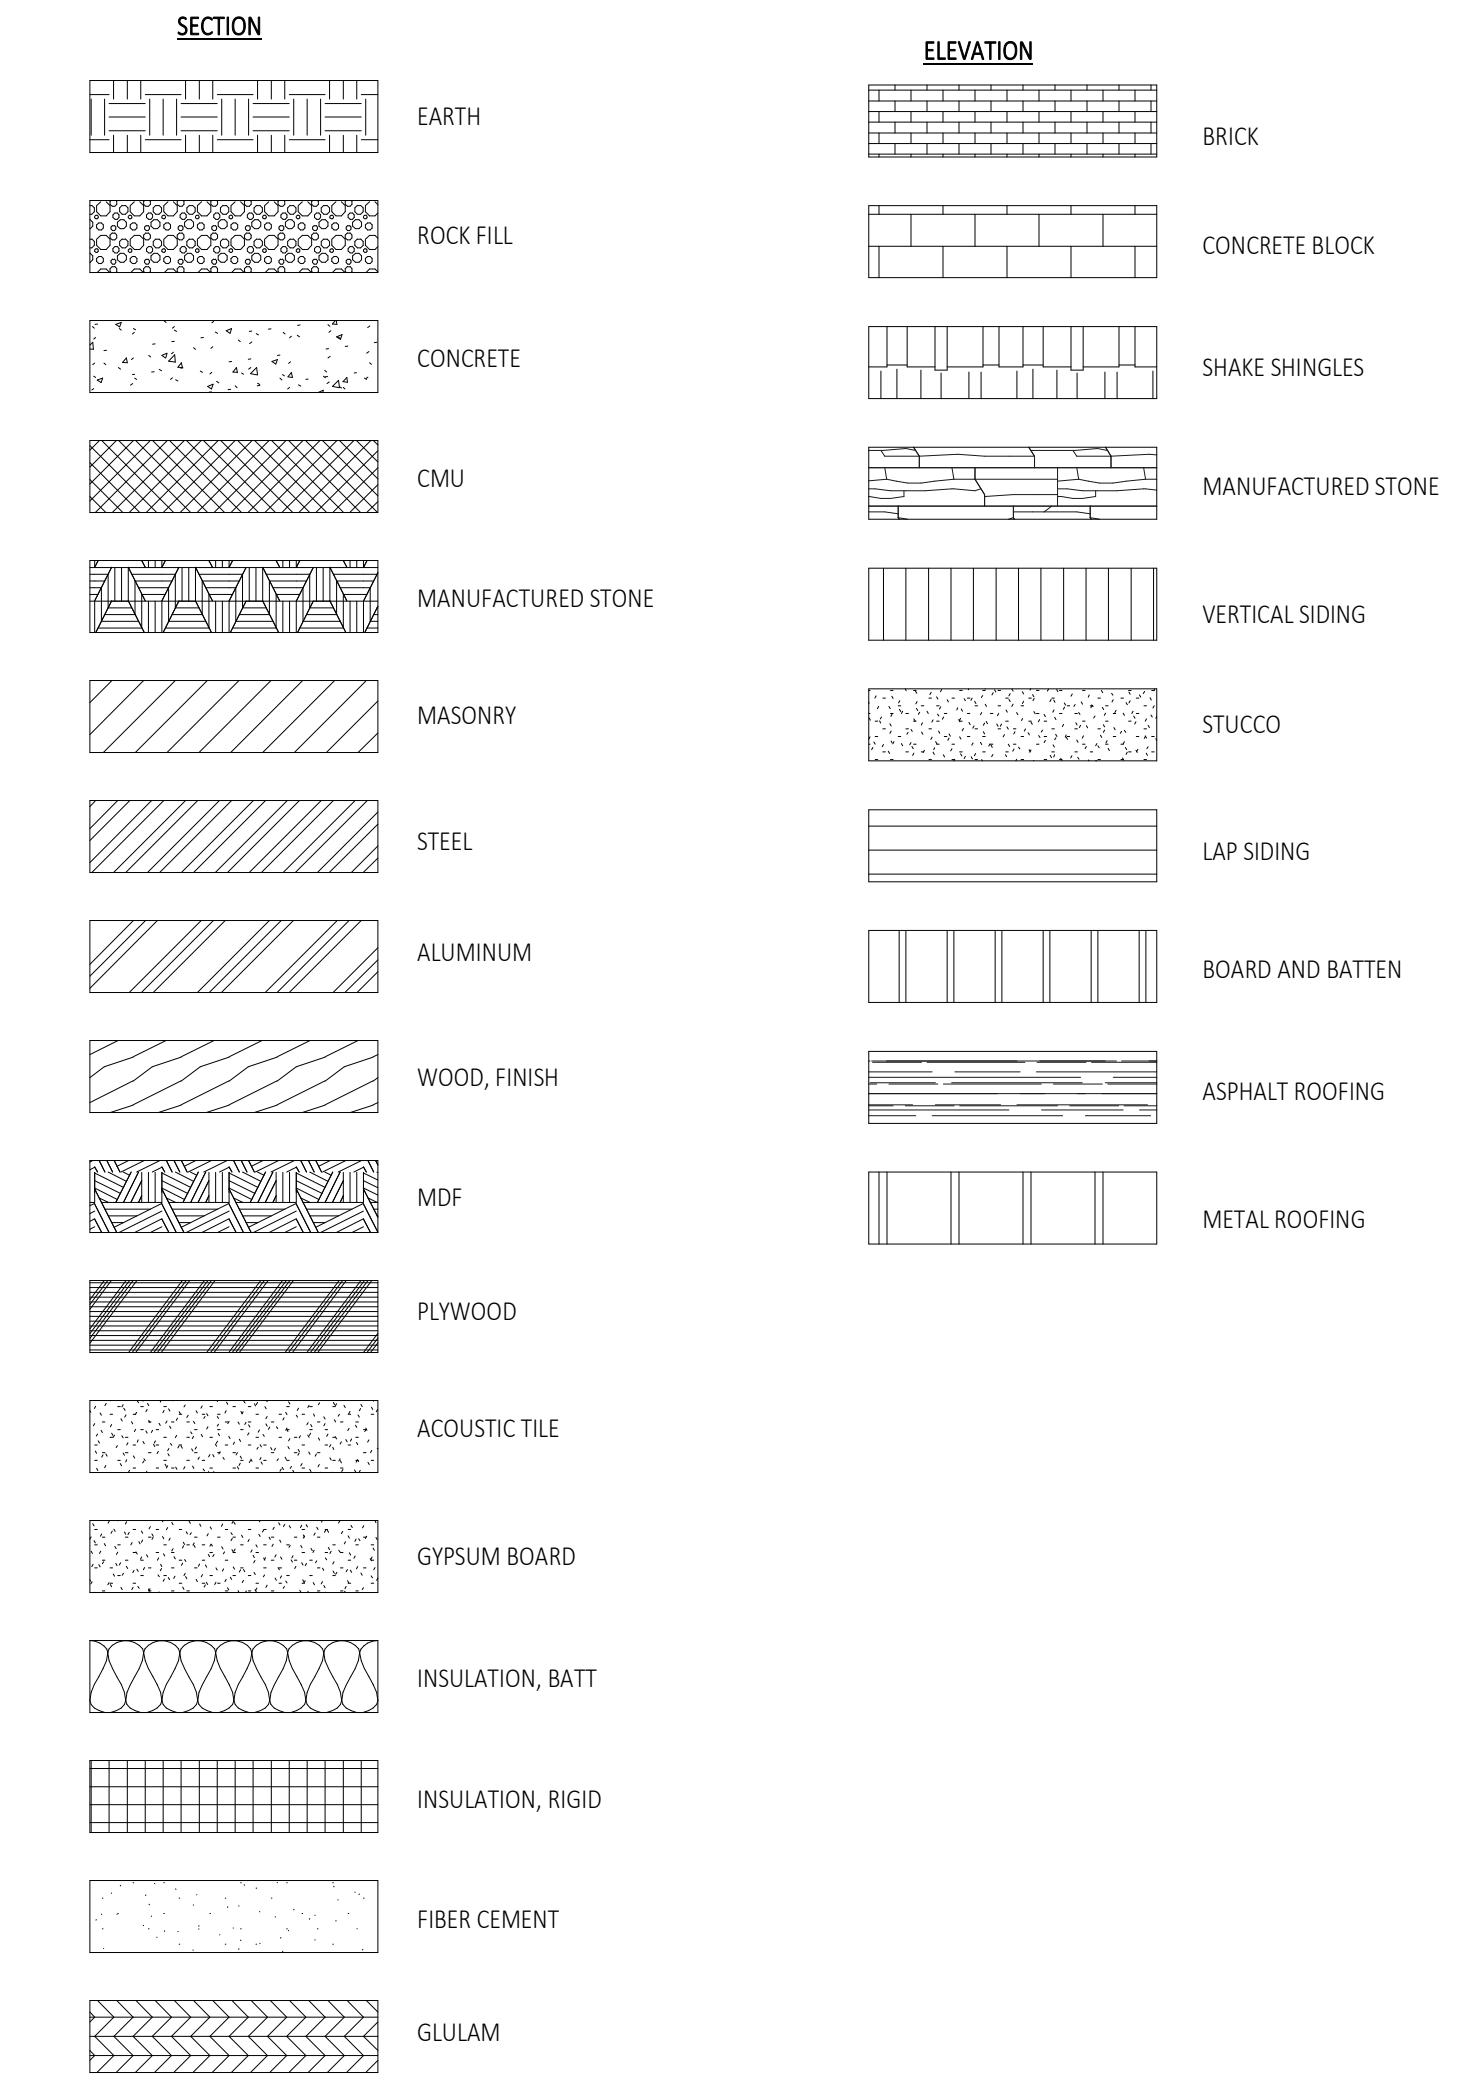

DRAWING SYMBOLS

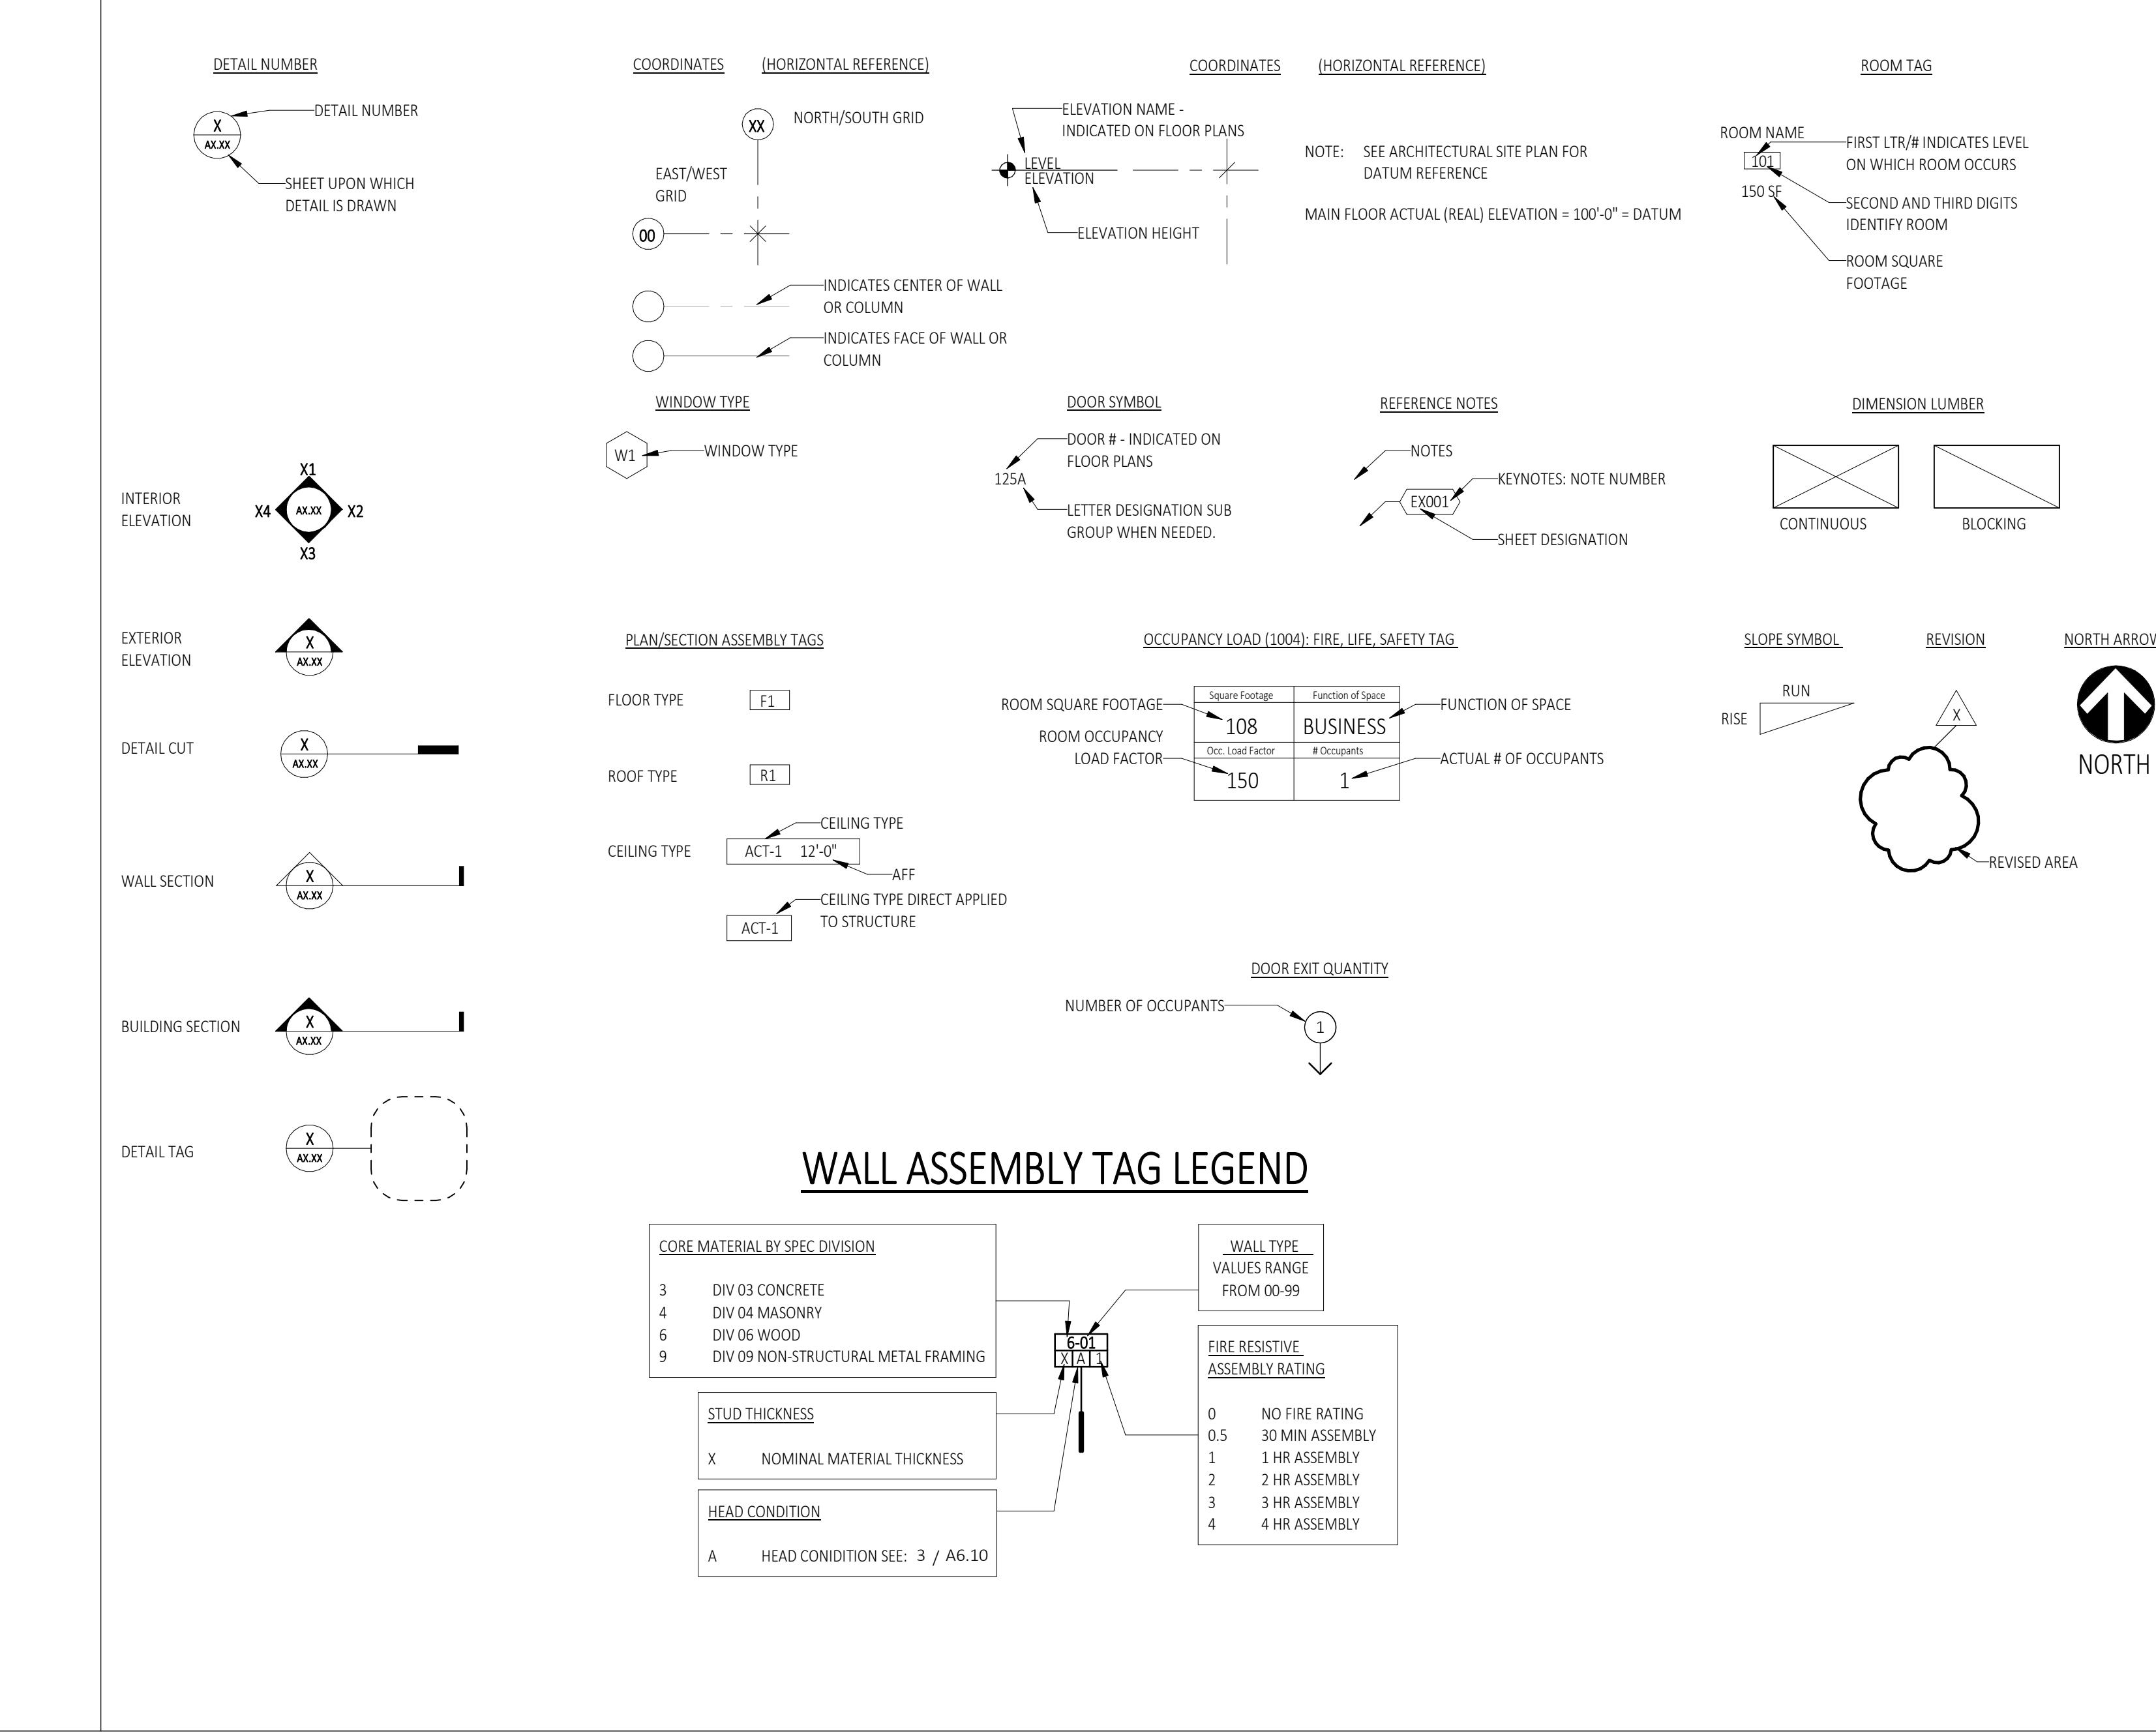

ABBREVIATIONS

&	AND	CAB	CABINET	DIM	DIMENSION	FHC	FIRE HOSE CABINET	HR	HOUR	OC	ON CENTER	RO	ROUGH OPENING	THRU	THROUGH	
@	ANGLE	CB	CATCH BASIN OR CHALKBOARD	DISP	DISPENSER	FIN	FINISH	HVAC	HEATING, VENTILATION,	OD	OUTSIDE DIAMETER	RT	RUBBER / RESILIENT TILE	TO	TOP OF	
AT	AT	CCB	CEMENT BACKER BOARD	DIV	DIVISION OR DIVIDE	FIN FLR	FINISH FLOOR	REF	AIR CONDITIONING	OFCI	OWNER FURNISHED	RVS	REVERSED	TOC	TOP OF CONCRETE	
C	CENTERLINE	CEM	CEMENT	DW	DOWN	FL	FLUSH	FLR	INDOOR	CONTRACTOR INSTALLED	RWL	RADIANT WATER LEADER	TOL	TOP OF LEADER		
D	DIA	CEM	CEM	DR	DOWN	FLUOR	FLUORESCENT	INSUL	INSULATION	OFF	OFFICE	SAM	SOLID-ADHERED MEMBRANE	TOS	TOP OF STEEL	
+	+	CFCI	CONTRACTOR FURNISHED/	DS	DOVINGSPOUT	FMT	FORMED METAL TRIM	INT	INTERIOR	OFOI	OWNER FURNISHED	SC	SOLID CORE	TOW	TOP OF WALL	
-	-	DEG	DEGREE	DWG	DRAWING	FOC	FACE OF CONCRETE OR CURB	IS	JOINT SEALANT	SCHED	SCHEDULE	TRD	TOILET PAPER DISPENSER			
#	POUND OR NUMBER	CG	CORNER GUARD	DWR	DRAWER	FOF	FACE OF FINISH	IT	JOINT	OPNG	OPENING	SD	STORM DRAIN OR SOAP DISPENSER	TPTN		
(E)	EXISTING	CI	CAST IRON	EA	EACH	FOS	FACE OF STUD	LAB	LABORATORY	OPP	OPPOSITE	SECT	SECTION	TR	TOILET PARTITION	
AB	ANCHOR BOLT	CIP	CAST-IN-PLACE	EF	EACH FACE	FP	FIREPROOF	LNU	LNUCLEUM	OTC SAPP	OREGON TRANSPORTATION COMMISSION	SHR	SHOWER	TYP	TRASH RECEPTACLE	
A/C	AIR CONDITIONING	CJ	CONSTRUCTION OR CONTROL JOINT	EJ	EXPANSION JOINT	FT	FOOT ON FEET	LAM	LAMINATE	SHT	SHEET	UNFIN	UNFINISHED			
ACT	ACOUSTICAL	CLG	CEILING	EL	ELEVATION	FTG	FOOTING	LAV	LAVATORY	STANDARDS FOR ACCESSIBLE PARKING	STANDARDS	UNF	UNFINISHED			
ACT	ACOUSTICAL CEILING TILE	CLG	CEILING	ECC	ELEMENTAL	FUS	FLOORING UTILITY SHELF	LKR	LEAK	PLACES	PLACES	UNL	UNLESS NOTED OTHERWISE			
ACW	ACOUSTICAL CURTAIN WALL	CIR	CLEAR	ELEV	ELEVATOR	G	GROUNDS	LS	LIGHT	P-2	PARTICLE COLOR	SCL	SCREW	UP		
AD	AREA DRAP	CMU	CONCRETE MASONRY UNIT	EP	ELECTRICAL PANEL	GA	GAUGE	LT	LIGHT	PBD	PARTICLE BOARD	SUD	SOLID SURFACE	US	UTILITY SHELF	
AD	ADJUSTABLE OR ADJACENT	CNTR	COUNTER	EPK	EPoxy Paint	GALV	GAVALYZED	LVT	LUXURY VINYL TILE / PLANK	PC	PARTICLE BOARD	SND	SANITARY NARIN DISPOSAL	VCT	VINYL COMPOSITION TILE	
AFF	ABOVE FINISHED FLOOR	CO	CLEANOUT	EPK-F	EPoxy Flooring	GB	GRAB BAR	MATL	MATERIAL	PEBE	PERFORATED	SNDU	SANITARY NARIN DISPOSAL UNIT	VERT	VERTICAL	
AGGR	AGGREGATE	COL	COLUMN	EQ	EQUAL	GL	GLASS	MAX	MAXIMUM	PLAM	PLASTIC LAMINATE	SQ	SQUARE	VIF	VESTIBULE	
AHI	AUTHORITY HAVING JURISDICTION	CONC	CONCRETE	EQUIP	EQUIPMENT	GL BLK	GLASS BLOCK	MB	MARKER BOARD	PLAS	PLASTER	SS	SUNSCREEN	VINYL	VERIFY IN FIELD	
AHU	AIR HANDLING UNIT	CONN	CONNECTION	EST	ESTIMATE	GLZ CMU	GLAZED CMU	MECH	MECHANICAL	PLYWD	PLYWOOD	SST	STAINLESS STEEL	W/	WITH	
ALUM	ALUMINUM	CONSTR	CONSTRUCTION	EWA	ELECTRIC WATER COOLER	GR	GRANITE	MEM	MEMBRANE	PNL	POLYMER	ST	STAIN	WD	WOOD	
APPROX	APPROXIMATE	CONT	CONTINUOUS	EWH	ELECTRIC WATER HEATER	GWB	GYPSUM WALL BOARD	MFR	MFGUREUR	PR	PARTICLE	ST7A	STATION	WRB	WEATHER RESISTIVE BARRIER	
ARCH	ARCHITECTURAL	CORR	CORRIDOR	EXH	EXHAUST	GWB-IR	GYPSUM WALL BOARD -	MH	MAMHOLE	PS	PROJECTION SCREEN	STD	STANDARD			
ASF	ALUMINUM STOREFRONT	CPT	CARPET	(E)	EXISTING	IMPACT RESISTANT	MIC	MINIMUM	PTAC	PACKAGED TERMINAL	STD	STANDARD	STL	STEEL		
ASPH	ASPHALT	CSK	COUNTERSUNK	EXP	EXPOSED OR EXPANSION	GWB-WR	GYPSUM WALL BOARD -	MO	MASONRY OPENING	STRUCT	STRUCTURAL	STOR	STORAGE			
AWP	ACOUSTICAL WALL PANEL	CT	CERAMIC TILE	EXT	EXTERIOR	WATER RESISTANT	MO	MASONRY OPENING	AIR CONDITIONER	STRUCTURAL	STUD	STUD				
BCS	BABY CHANGING STATION	CTR	CENTER	FA	FIRE ALARM	HB	HOSE BIBB	MP	METAL PANEL	PTD	PAPER TOWEL DISPENSER	SUSP	SUSPEND			
BD	BOARD	DBL	DOUBLE	FB	FLAT BAR	HC	HOLLOW CORE	MS	METAL SIDING	PTHP	PACKAGED TERMINAL	SV	SHEET VINYL			
BLDG	BUILDING	DEPT	DEPARTMENT	FC	FIBER CEMENT	HD	HAND DRYER	MTD	MOUNTED	PTN	PARTITION	SYMM	SYMMETRICAL			
BLKG	BLOCKING	DET	DETAIL	FD	FLOOR DRAIN	HDWD	HARDWOOD	MTL	METAL	PTN	PARTITION	T	TREAD			
BM	BEAM	DIA	DIAMETER	DTN	DETENTION	HGT	HEIGHT	MU	MULTI-UNIT	Q	QUADRANT	T&G	TOP & GROOVE			
BOT	BOTTOM			FEC	FIRE EXTINGUISHER	HM	HOLLOW METAL	MULL	MULLION	QT	QUARRY TILE	TB	TACKBOARD			
				FEC	FIRE EXTINGUISHER CABINET	HORIZ	HORIZONTAL	(N)	NEW	R	RADIUS OR RISER	TBD	TO BE DETERMINED			
				FGS	FRAMELESS GLASS SYSTEM	NIC	NOT IN CONTRACT	RA	RETURN AIR	TCD	TOILET COVER DISPENSER					
						NO	NUMBER	RB	RESILIENT BASE	TEL	TELEPHONE					
						NOM	NOMINAL	RB HK	ROBE HOOK	THK	THICKNESS					
						NTS	NOT TO SCALE	RCP	REFLECTED CEILING PLAN							
						OA	OVERALL	RC	ROOF DRAIN							
								REF	REFRIGERATOR							
								REINF	REINFORCED							
								RCOD	RCOUPLED							
								RESIL	RESILIENT							
								RM	ROOM							

pinnacle
architecture, inc.

"ENHANCING LIVES AND COMMUNITIES"
1001 SW DISK DRIVE, SUITE 105
BEND OR 97702
541.388.9897
WWW.PINNACLEARCHITECTURE.COM

REGISTERED ARCHITECT
PETER E. BAER
BEND, OREGON
3078
LAKE ROAD HEALTH CENTER


CLIENT:
CLACKAMAS COUNTY
PROJECT ADDRESS:
6605 SE Lake Rd, Milwaukie, OR
97222

APPROVED FOR DATE BY
BUILDING PERMIT 02.02.24 KK
DESCRIPTION DATE
PROJECT NO: 2221 HCR
DRAWN BY: MALLORY FAIR
CHECKED BY: PETER BAER
© PINNACLE ARCHITECTURE, INC. 2024 ORIGINAL SHEET SIZE: 30" x 42"


NOTES & CONVENTIONS
G0.11
2/24/2024 4:48:17 PM

OCCUPANCY GROUP

BUSINESS

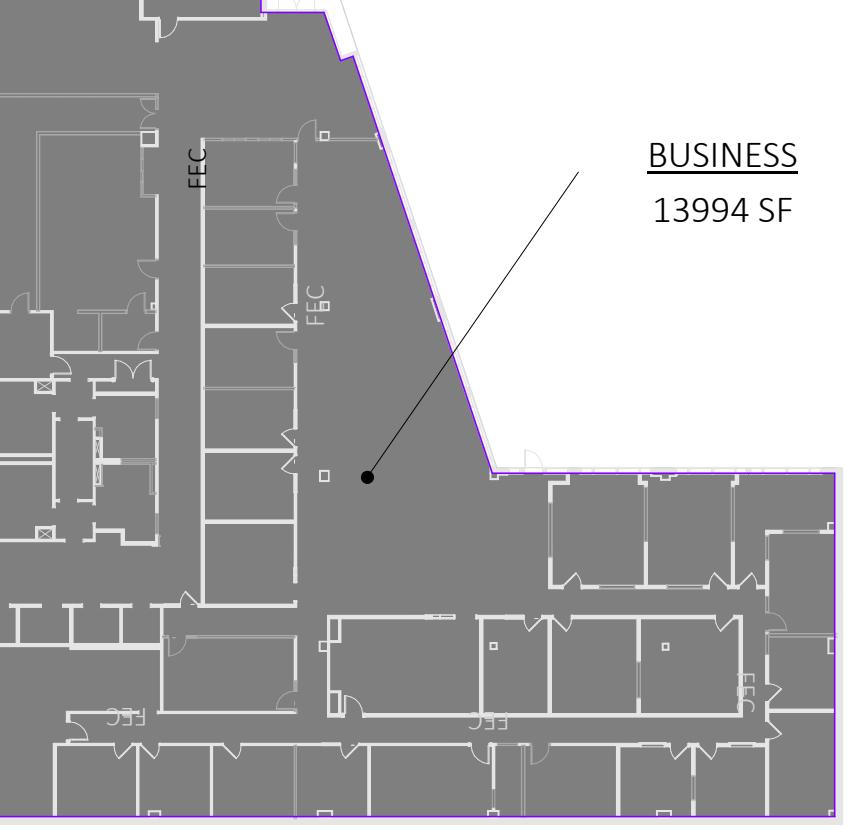

1 LEVEL_01 - OCCUPANCY GROUP
1/32" = 1'-0"

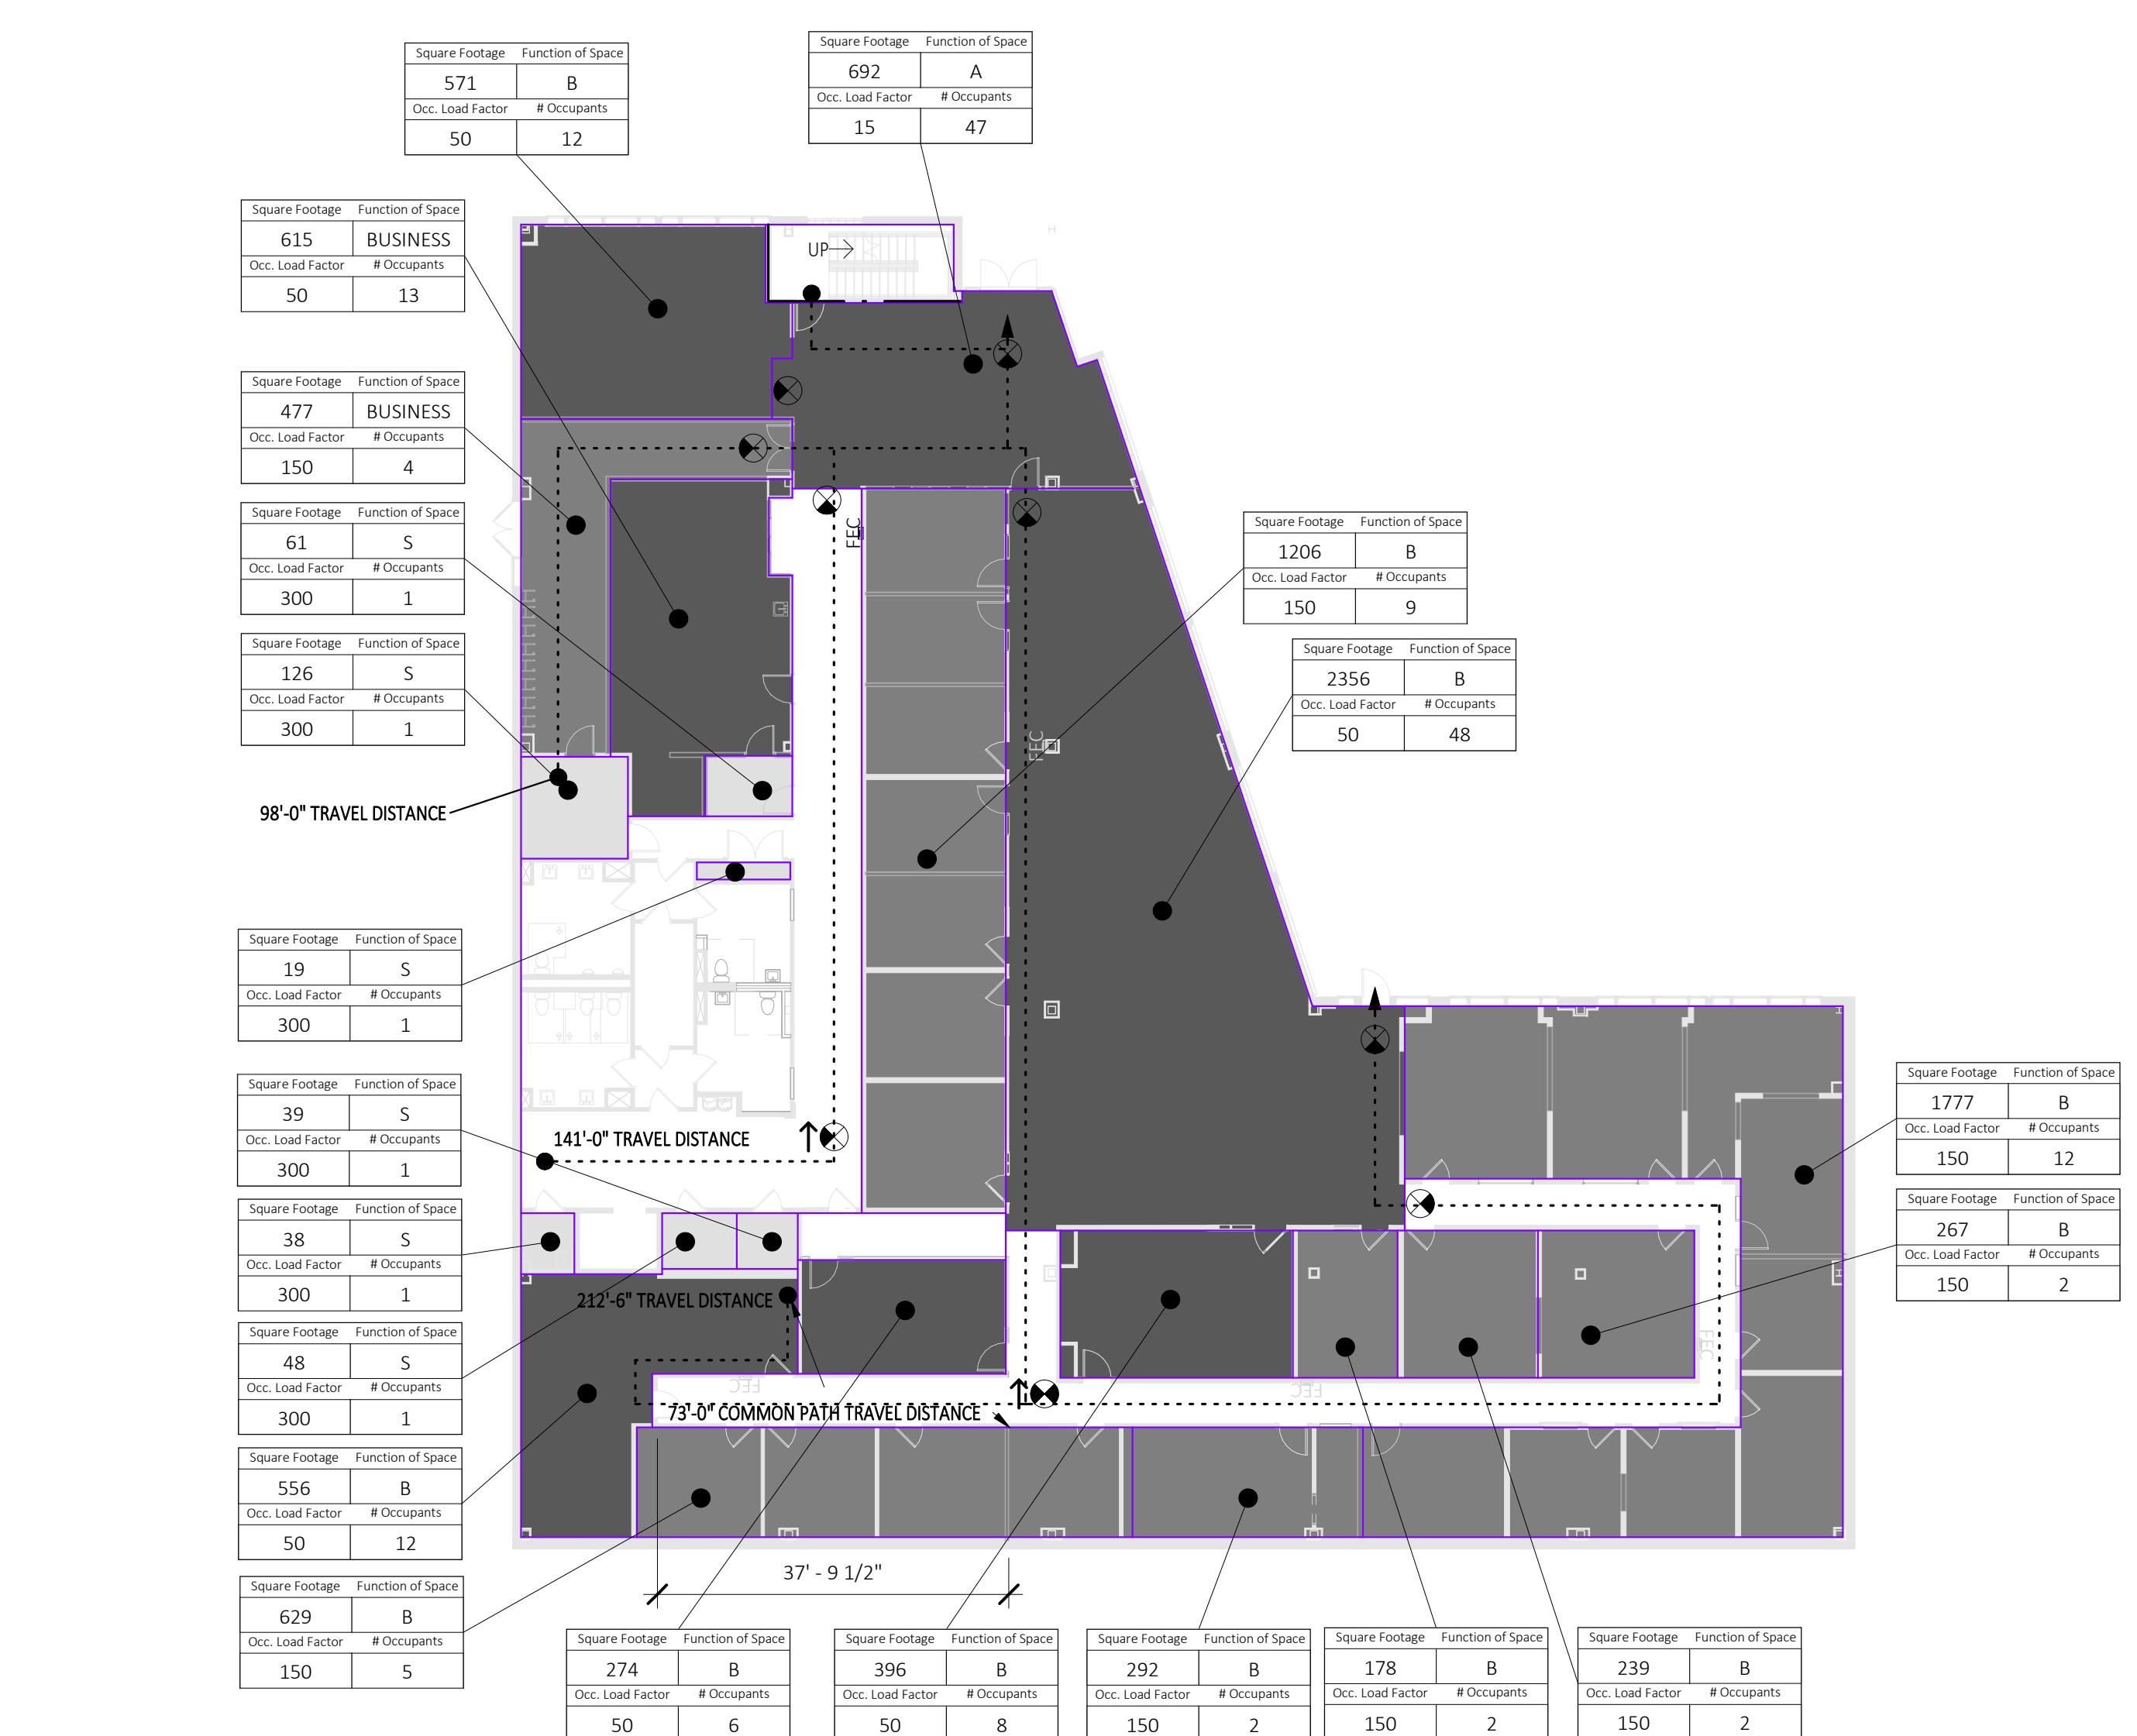

FIRE RESISTANCE CHART - BUILDING ELEMENTS

CONSTRUCTION ELEMENT - TYPE II	RATING (HOURS)
PRIMARY STRUCTURE (INCLUDING COLUMNS, GIRDERS AND JOISTS)	0
EXTERIOR BEARING WALLS	0
NON-BEARING EXTERIOR WALLS	0
NON-BEARING EXTERIOR WALLS AND PARTITIONS (see TABLE 705.5)	0
NON-BEARING INTERIOR WALLS AND PARTITIONS	0
FLOOR CONSTRUCTION (INCLUDING BEAMS & JOISTS)	0
ROOF CONSTRUCTION (INCLUDING BEAMS & JOISTS)	0

OSSC, TABLE 705.5 FIRE-RESISTANCE RATING REQUIREMENTS FOR EXTERIOR WALLS BASED ON FIRE SEPARATION DISTANCE (FSD)	
FSD (FEET) - TYPE B	RATING (HOURS)
X < 5'	1
5' < X < 10'	1
10' < X < 30'	0
X > 30'	0

INTERIOR WALL AND CEILING FINISH REQUIREMENTS BY OCCUPANCY IN SPRINKLERED BUILDINGS (TABLE 803.13)

GROUP	INTERIOR STAIRWAYS	CORRIDORS	ROOMS
B	B	C	C

ACCESSIBLE BARRIER REMOVAL PLAN

SITE ELEMENTS:

- ACCESSIBLE SITE PATH MAINTENANCE, DEMO AND REPLACE TO MEET CODE REQUIRED SLOPES
- ACCESSIBLE PARKING STALL, DEMO AND REPLACE TO MEET CODE REQUIRED SLOPES
- ACCESSIBLE PARKING STALL, REPAINTING AND WALKWAY REPAINTING

BUILDING INTERIOR:

- ACCESSIBLE RESTROOM UPGRADES, ADDITIONAL (3) ADA RESTROOMS TO CURRENT REQUIRED CODE STANDARDS
- DOOR HARDWARE UPGRADES, TO BE LEVER TYPES HANDLES FOR ADA COMPLIANCE

BUILDING OCCUPANCY DATA (NON-SEPARATED USE, PER 508.3)
 OCCUPANCY CLASSIFICATION (PER 302): **B**
 CONSTRUCTION TYPE (PER 602): **TYPE II B**

GROUP B / TYPE II = 69,000 SF
NOT USED
41,793 SF GROSS TOTAL

ACTUAL BUILDING BREAKDOWN:

BUILDING INFORMATION	
Name	Area
BUSINESS	41,739 SF
GRAND TOTAL	41,739 SF

ALLOWABLE BUILDING HEIGHT (TABLE 504.3 / 504.4)
 ACTUAL BUILDING HEIGHT
 4 STORIES (7' HEIGHT)
 3 STORIES (40' - 11" HEIGHT)

FIRE RESISTIVE BUILDING ELEMENTS (RATING)
 STRUCTURAL FRAME
 EXTERIOR BEARING WALLS
 INTERIOR BEARING WALLS
 EXTERIOR NON-BEARING WALLS
 INTERIOR NON-BEARING WALLS
 FLOOR CONSTRUCTION
 ROOF CONSTRUCTION
 CORRIDORS (Table 1020.1)
 NOT RATED (NR)

FIRE PROTECTION SYSTEMS
 FIRE SUPPRESSION AND DETECTING SYSTEMS
 AUTOMATIC FIRE SPRINKLER SYSTEM (NFPA 13)
 FIRE & SMOKE DETECTION (NFPA 72)
 FIRE EXTINGUISHER
 REFERENCE: PLANS FOR (E) EXTINGUISHER LOCATIONS

MEANS OF EGRESS - EGRESS WIDTH REQUIREMENT
 MAIN LEVEL EGRESS REQUIREMENT
 DOOR: 0.2" PER 100' (PER 100.3.2)
 3'-0" DOOR (3' 0" MIN CLR WITHIN 6'-0" DOOR (64" MIN CLR WIDTH))
 DOOR WIDTH REQUIRED: 542 X 0.2 = 10.8"
 REFERENCE: PLAN DIAGRAMS FOR EXIT REQUIREMENTS

MAXIMUM COMMON PATH OF TRAVEL (TABLE 1006.2.1)
 OCC. W/ SPRINKLER SYS.
 B 100'

MAXIMUM TRAVEL DISTANCE (TABLE 1017.2)
 OCC. W/ SPRINKLER SYS.
 B 300'

OCCUPANT LOAD	
OSSC TABLE 1004.5	637

PLUMBING SYSTEMS
 FIXTURE REQUIREMENTS (TABLE 2902.1)


MALE / FEMALE PLUMBING COUNTS
 OCCUPANT LOAD / 2 = M AND F COUNTS

REQUIRED -
 WATERCLOSET (W/C) = 1 PER 25 OCC FOR THE FIRST 50 AND 1 PER 50 FOR THE REMAINING OCCUPANTS
 LAVATORY (L) = 1 PER 40 OCC FOR THE FIRST 80 AND 1 PER 80 FOR THE REMAINING OCCUPANTS

CLASS/OCCUPANTS W/C M F
 GROUP B/ 318 OCCUPANTS 8 8 0

PROVIDED
 CLASS/OCCUPANTS W/C M F U
 GROUP B/ 318 OCCUPANTS 6 9 3 0

APPROVED FOR DATE BY
 BUILDING PERMIT 02.02.24 KK

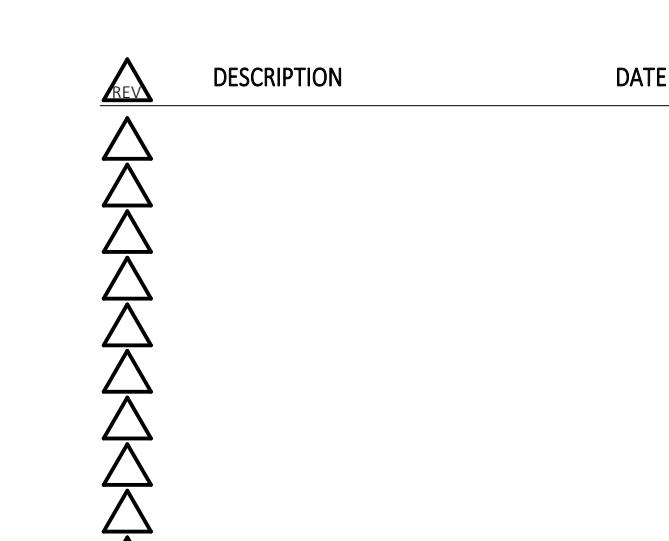

PROJECT NO: 2221 HCR
 DRAWN BY: BL
 CHECKED BY: PETER BAER
 © PINNACLE ARCHITECTURE, INC. 2024 ORIGINAL SHEET SIZE: 30" x 42"

CODE PLAN


1 LEVEL_01 - OCCUPANCY GROUP
1/32" = 1'-0"



6

LEVEL_03
1/16" = 1'-0"

3 LEVEL_02
1/32" = 1'-0"

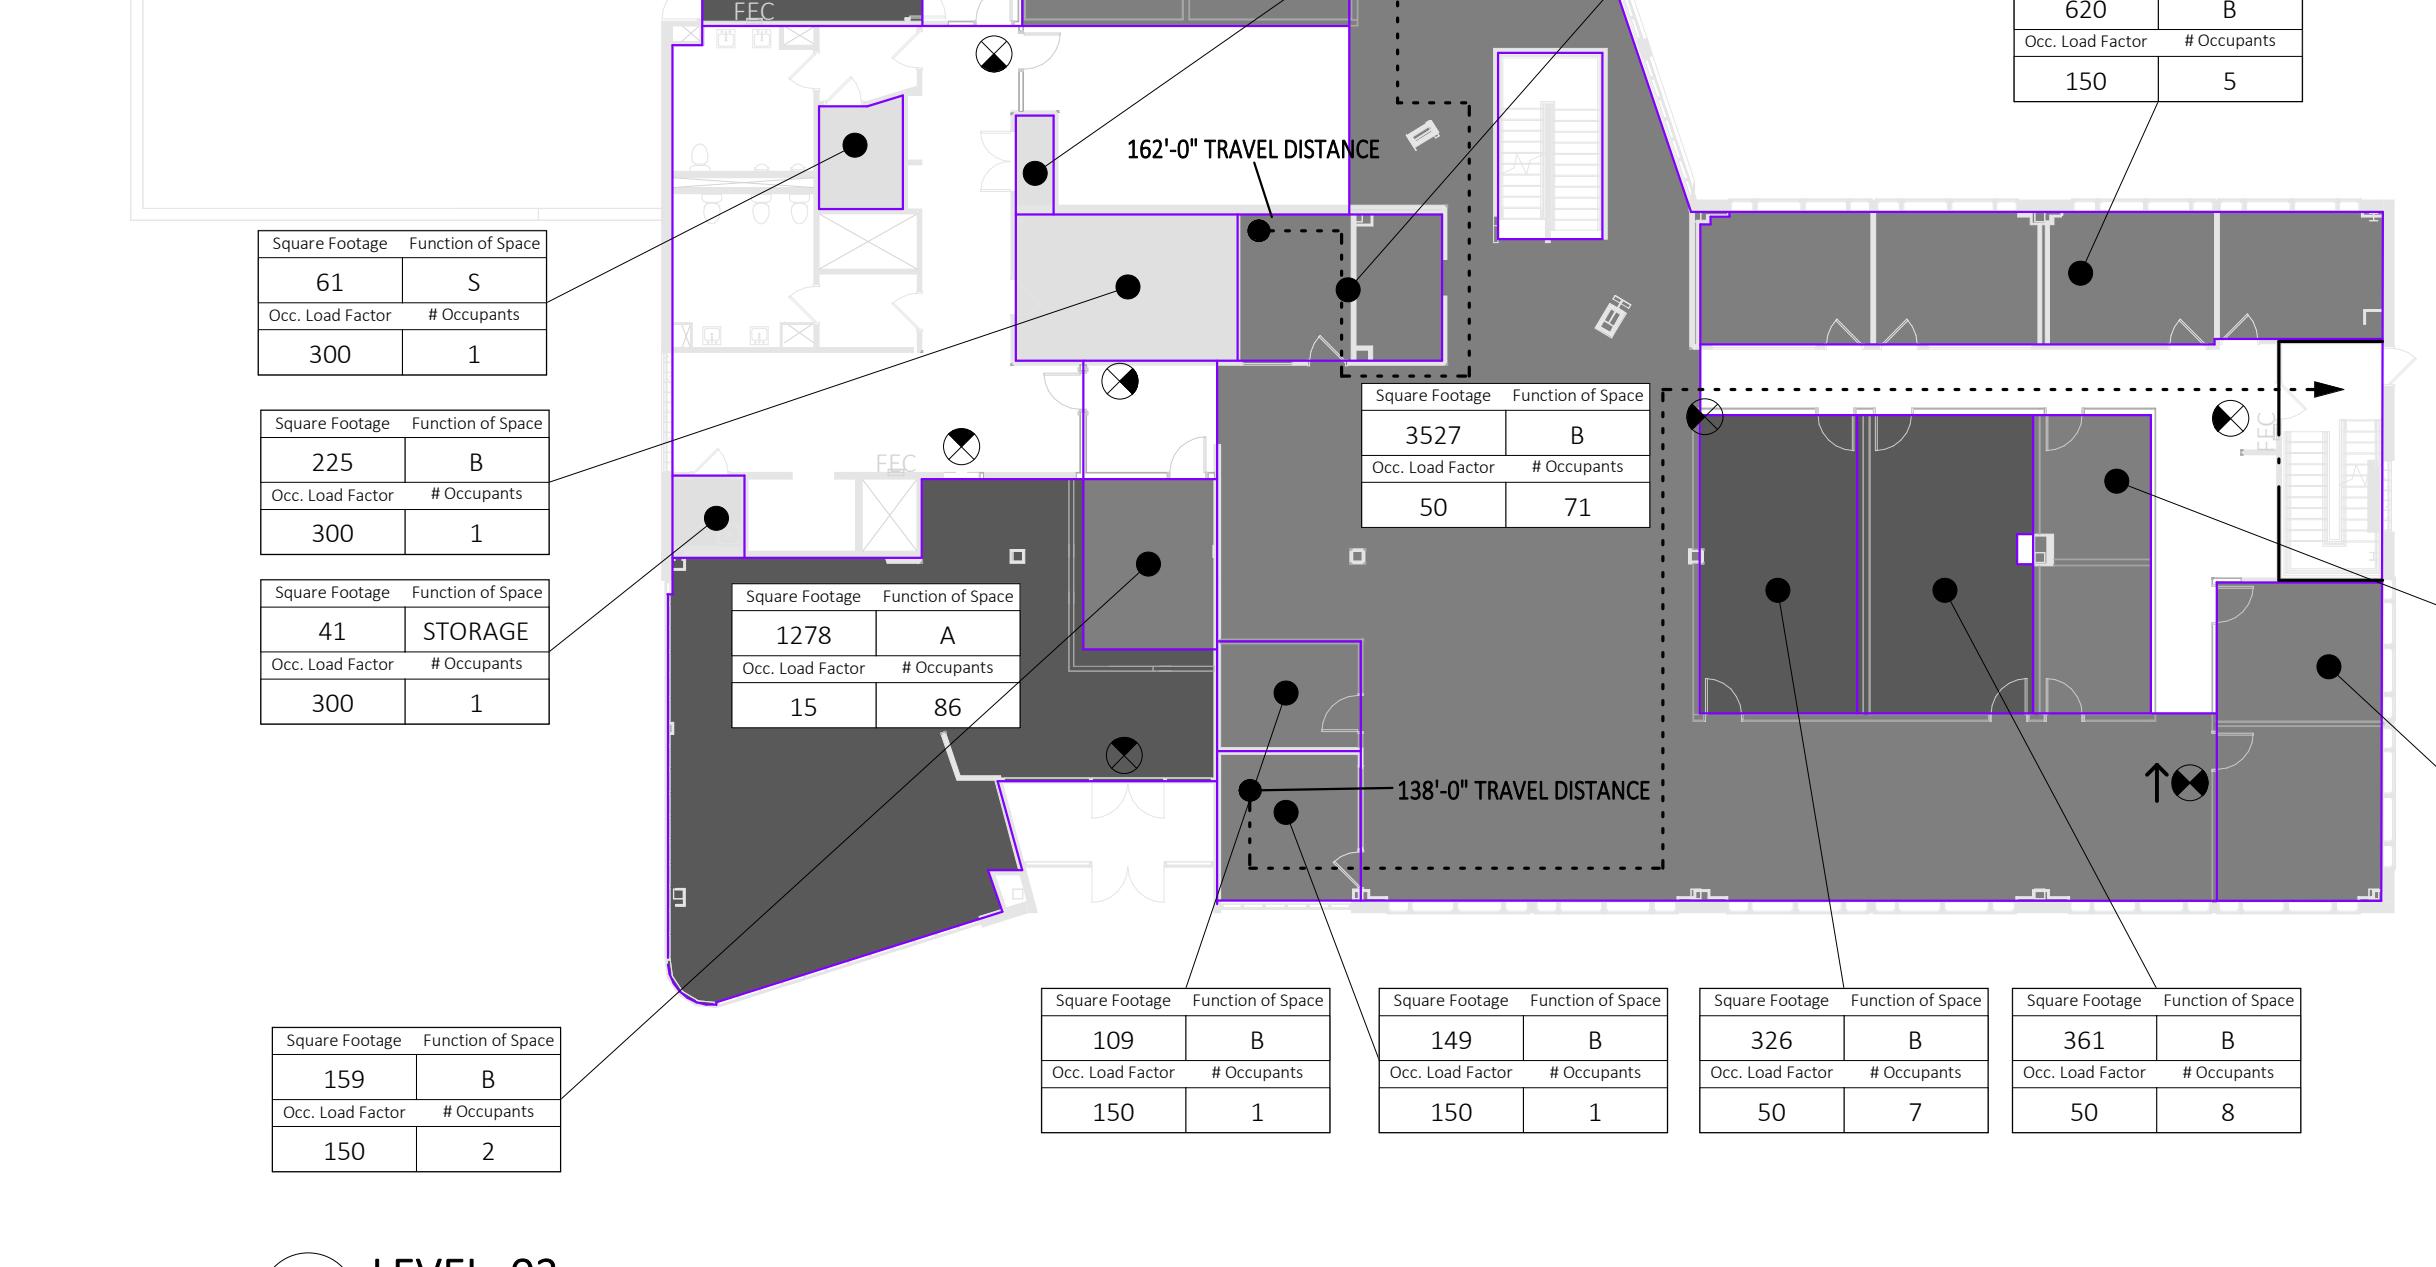


4 LEVEL_03
1/32" = 1'-0"

5 LEVEL_02
1/16" = 1'-0"


6

LEVEL_03
1/16" = 1'-0"

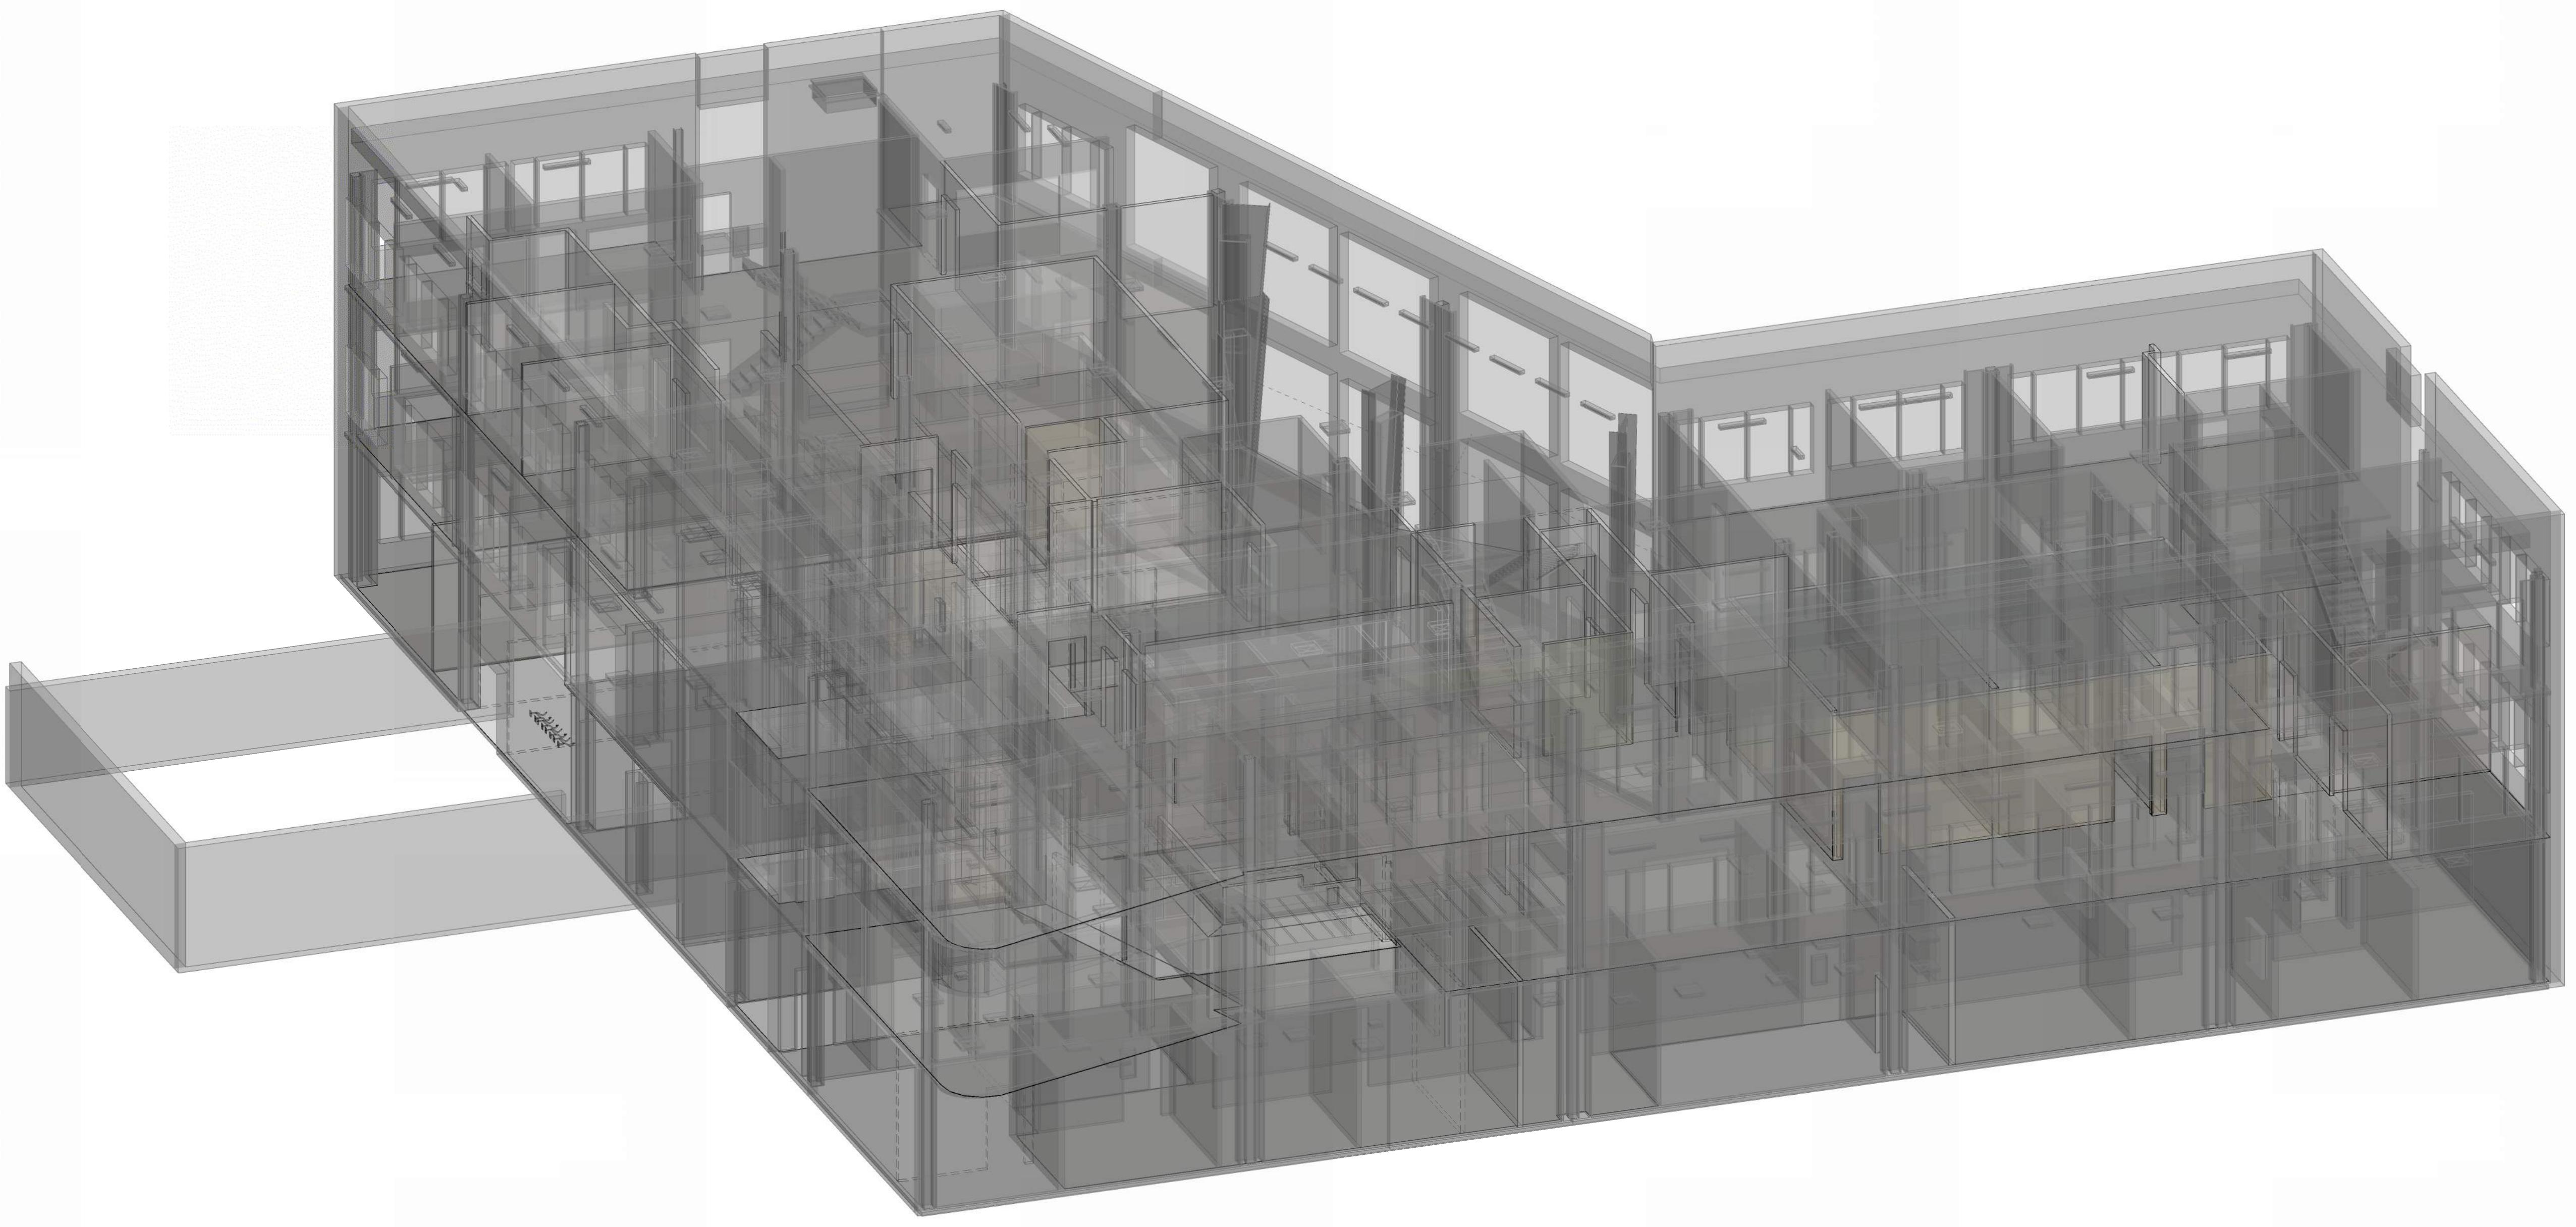


Sheet Number	Sheet Name
S0.00	COVER SHEET
S0.01	GSN AND LEGAL INSPECTION TABLES
S1.10	2ND FLOOR FRAMING PLAN
S1.11	3RD FLOOR FRAMING PLAN
S1.12	ROOF FRAMING PLAN
S6.00	NON-STRUCTURAL WALL DETAILS
S6.01	NON-STRUCTURAL WALL DETAILS
S6.10	SUSPENDED CEILING DETAILS
S6.11	SUSPENDED CEILING DETAILS

INCH	DBA	DEFORMED BAR ANCHOR	HAS	HEADED ANCHOR STUD	OD	OUTSIDE DIAMETER	THK	THICK
NUMBER, POUND	DBL	DOUBLE	HC	HOLLOW CORE	OH	OVERHEAD	THRD	THREADED
AND	DEFL	DEFLECTION	HCP	HOLLOW CORE PLANK	OPNG	OPENING	TOB	TOP OF BEAM
FEET	DEMO	DEMOLITION	HDD	HEADED ANCHOR STUD	OPP	OPPOSITE, OPPOSITE HAND	TOC	TOP OF COLUMN, TOP OF CURB
AT	DEPT	DEPARTMENT	HDR	HEADER	OSWJ	OPEN WEB STEEL JOIST	TOF	TOP OF FOOTING
(E)	EXISTING	DETAIL	HEX	HEXAGONAL			TOJ	TOP OF JOIST
(N)	NEW	DF	DOUG FIR (DOUGLAS FIR)	HM	HOLLOW METAL	PIL	PROPERTY LINE	TOJ
ANCHOR BOLT	DIAG	DIAGONAL	HOR	HORIZONTAL	PAF	POWDER ACTUATED FASTENERS	TOL	TOLERANCE
ACI AMERICAN CONCRETE INSTITUTE	DIAPH	DIAPHRAGM	HSS	HOLLOW STRUCTURAL SHAPE	PC	PRECAST	TOP	TOP OF PIER, TOP OF PLATE
ADD ADDENDUM, ADDITION	DIM	DIMENSION	HT	HEIGHT	PCF	POUNDS PER CUBIC FOOT	TOPV	TOP OF PAVEMENT
ADJ ADJUST, ADJUSTABLE	DKG	DECKING	HVAC	HEATING, VENTILATION, AIR CONDITIONING	PER	PERFORATE, PERFORATED, PERFORMANCE	TOS	TOP OF SLAB, TOP OF STEEL
AESS ARCHITECTURALLY EXPOSED STRUCTURAL STEEL	DL	DEAD LOAD	IBC	INTERNATIONAL BUILDING CODE	PE	PROFESSIONAL ENGINEER	TOW	TOP OF WALL
AFF ABOVE FINISH FLOOR	DWG	DRAWING	ICF	INSULATED CONCRETE FORMS	PERP	PERPENDICULAR	TRANS	TRANSVERSE
ALT ALTERNATE	DWGS	DRAWINGS	ID	INSIDE DIAMETER	PL	PLATE	TRANSL	TRANSLUCENT
ALUM ALUMINUM	DWL	DOWEL	IN	INCH, INCHES	PLF	POUNDS PER LINEAL FOOT	TYP	TYPICAL
APPROX APPROXIMATELY			INFO	INFORMATION	PLWD	PLYWOOD	UNO	UNLESS NOTED OTHERWISE
ARCH ARCHITECTURE	EIFS	EXTERIOR INSULATED FINISH SYSTEM	INSP	INSPECTION	PNL	PANEL	UTIL	UTILITY
ASTM AMERICAN SOCIETY FOR TESTING AND MATERIALS	ELEV	ELEVATOR	INSUL	INSULATION	PREFAB	PREFABRICATED		
AVG AVERAGE	ENGR	ENGINEER	INT	INTERIOR	PREFIN	PREFINISHED	VERT	VERTICAL
AWS AMERICAN WELDING SOCIETY	EOR	ENGINEER OF RECORD	PREFIN	PREFINISHED	PSF	POUNDS PER SQUARE FOOT	VFY	VERIFY
BALC BALCONY	EQ	EQUAL	JST	JOIST	PSI	POUNDS PER SQUARE INCH	VIF	VERIFY IN FIELD
BD BOARD	EOPT	EQUIPMENT	JT	JOINT, JOINTS	PSL	PARALLEL STRAND LUMBER		
BEV BEVEL	ES	EACH SIDE	PT	PRESERVATIVE TREATED, POST-TENSIONED	W/	WITH		
BKR BACKER	EW	EACH WAY	K	KILOGPUND (1000 POUNDS)	W/O	WITHOUT		
BLDG BUILDING	EXIST	EXISTING	KIP	KILOGPUND (1000 POUNDS)	WT	WOOD		
BLK BLOCK	EXP	EXPANSION	OTY	QUANTITY	WF	WIDE FLANGE (STRUCTURAL STEEL)		
BLKG BLOCKING	EXPO	EXPOSED	L	ANGLE, LEFT, LENGTH	WP	WORK POINT OR WORKING POINT		
BM BEAM	EXT	EXTERIOR	LAM	LAMINATE, LAMINATED	RCP	REFLECTED CEILING PLAN		
BOC BOTTOM OF CURB	F TO F	FACE TO FACE	LAT	LATERAL	RD	ROOF DRAIN	WR	WATER RESISTANT, WATER RESISTIVE
BOT/BTM BOTTOM	FAB	FABRICATIONS / FABRICATED	LB	POUND	REF	REFERENCE	WT	WEIGHT
BOW BOTTOM OF WALL	FB	FLAT BAR	LF	LINEAR FEET, LINEAR FOOTAGE	REFIN	REINFORCED, REINFORCING	WWF	WOVEN WIRE FABRIC
BP BASE PLATE	FDTN	FOUNDATION	LN	LINEAR	REQ	REQUIREMENTS		
BRDG BRIDGE, BRIDGING	FE	FEROLEICH ENGINEERS	LN FT	LINEAR FEET, LINEAR FOOTAGE	REQD	REQUIRED		
BRG BEARING	FF	FINISH FLOOR	LL	LIVE LOAD	REV	REVISION		
BRK BRICK	FFE	FINISH FLOOR ELEVATION	LLH	LONG LEG HORIZONTAL	RO	ROUGH OPENING		
BSMT BASEMENT	FIN	FINISH	LLV	LONG LEG VERTICAL				
BU BUILT-UP	FLR	FLOOR	LNTL	LINTEL	SCHED	SCHEDULE		
CEM CEMENT, CEMENTITIOUS	FOC	FACE OF CONCRETE	LONG	LONGITUDINAL	SE	STRUCTURAL ENGINEER		
CGS CENTER OF GRAVITY OF STRAND	FOF	FACE OF FINISH	LSL	LAMINATED STRAND LUMBER	SECT	SECTION		
CIP CAST IN PLACE	FOM	FACE OF MASONRY	LT WT	LIGHTWEIGHT	SF	SQUARE FEET		
CJ CONTROL JOINT	FOS	FACE OF STUD	LVL	LAMINATED VENEER LUMBER	SGL	SINGLE		
CL CENTER LINE	FR	FIRE RATED, FIRE RESISTIVE	MANUF	MANUFACTURER, MANUFACTURED	SHT	SHEET		
CLG CEILING	FRM	FRAMED, FRAMING	MAX	MAXIMUM	SHTG	SEATING		
CLR CLEAR	FRR	FIRE RESISTANCE RATED	MB	MACHINE BOLT	SIM	SIMILAR		
CMU CONCRETE MASONRY UNIT	FRT	FIRE RETARDANT TREATED	MECH	MECHANICAL	SIMP	SIMPSON STRONG TIE		
COL COLUMN	FT	FOOT, FEET	MEZZ	MEZZANINE	SL	SNOW LOAD		
COMP COMPOSITE, COMPENSATION	FTG	FOOTING	MFR	MANUFACTURER, MANUFACTURED	SQ	SLAB ON GRADE		
CONC CONCRETE	FURRG	FURRING	MIN	MINIMUM	SS	STAINLESS STEEL		
COND CONDITION	FUT	FUTURE	MISC	MISCELLANEOUS	STD	STANDARD		
CONN CONNECTION	GA	GAUGE	MTL	METAL	STIFF	STIFFENER		
CONSTR CONSTRUCTION	GALV	GALVANIZED	MUL	MULLION	STL	STEEL		
CONT CONTINUOUS	GC	GENERAL CONTRACTOR	N	NORTH	STRUCT	STRUCTURAL		
CORR CORRIDOR	GEN	GENERAL	NIC	NOT IN CONTRACT	SUSP	SUSPENDED		
CTR CENTER	GL	GLU-LAMINATED	NO	NUMBER	SYM	SYMMETRICAL		
CTRL CONTROL	GLB	GLU-LAMINATED BEAM	NOM	NOMINAL				
CTSK COUNTERSINK	GND	GROUND	NTS	NOT TO SCALE	T AND B	TOP AND BOTTOM		
CU CUBIC	GR	GRADE	OC	ON CENTER	T AND G	TONGUE AND GROOVE		
CUST CUSTOM	GT	GIRDER TRUSS			TAN	TANGENT		
	GYP BD	GYPSUM						
		GYPSUM BOARD						

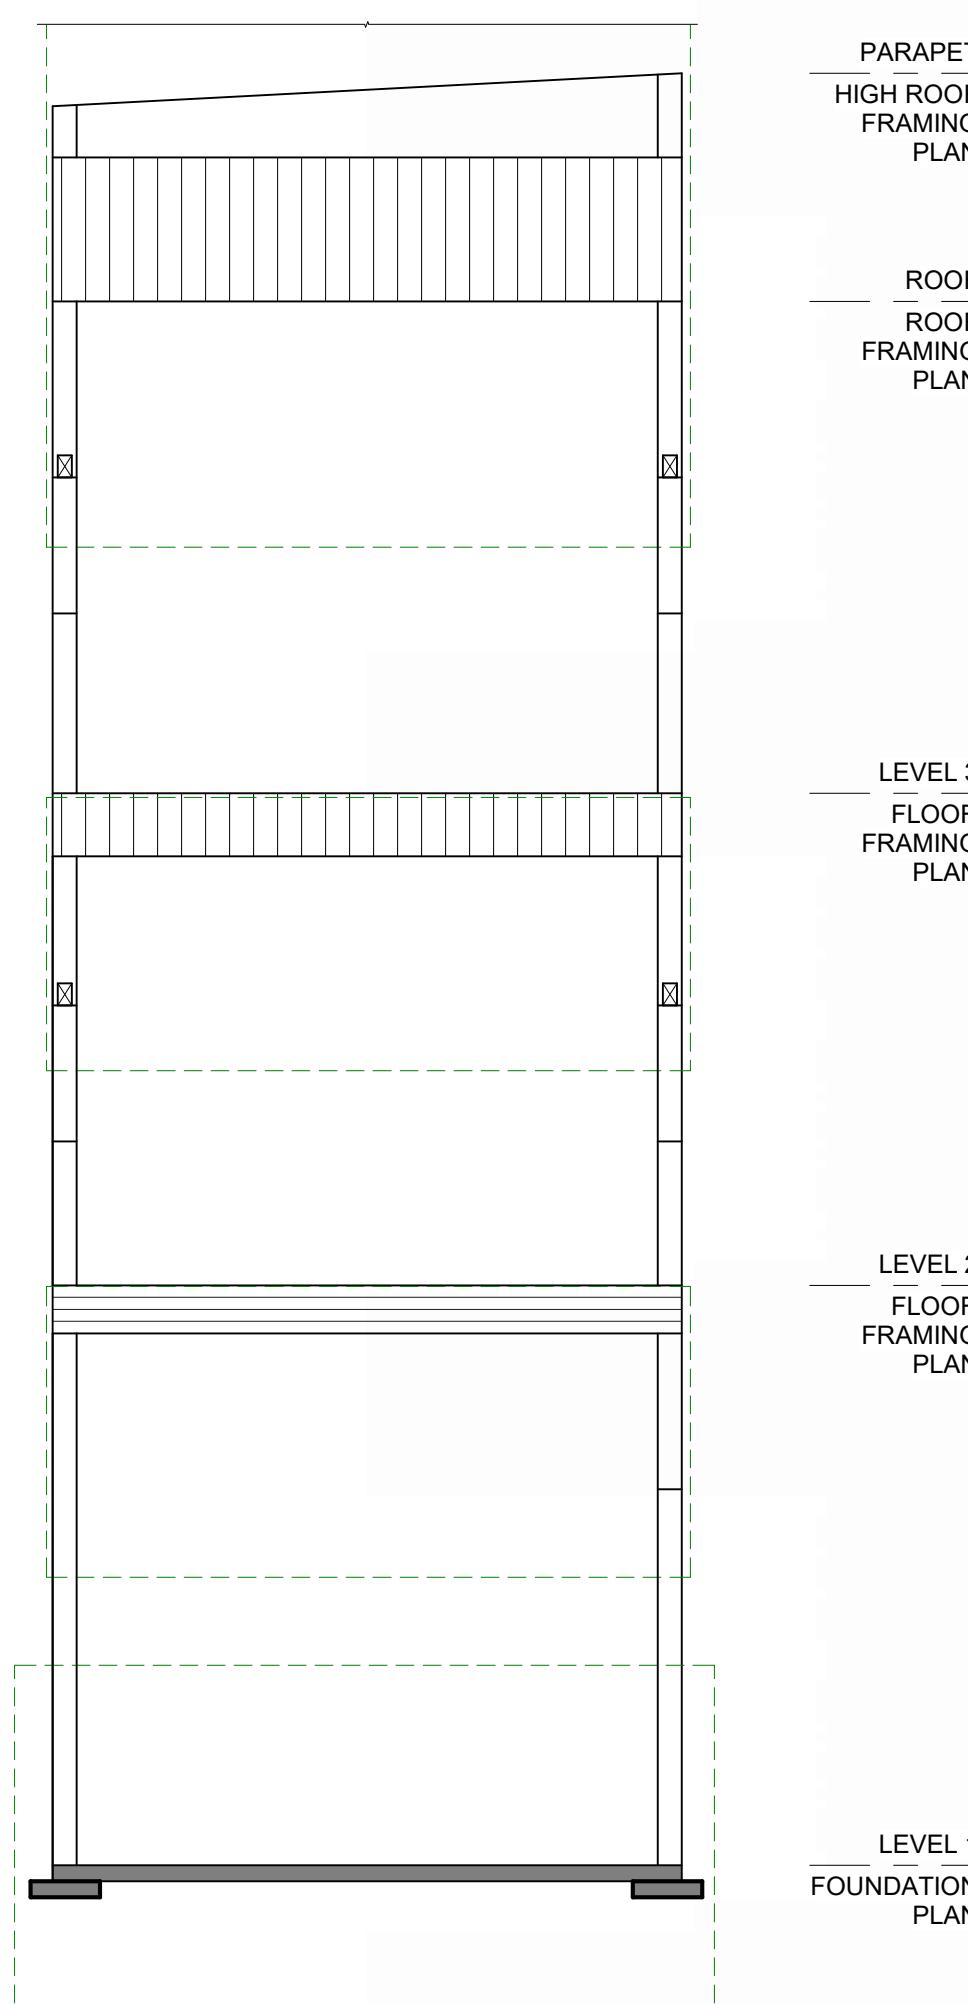

FOUNDATION AND FRAMING PLAN CUTS - ELEVATION DIAGRAM

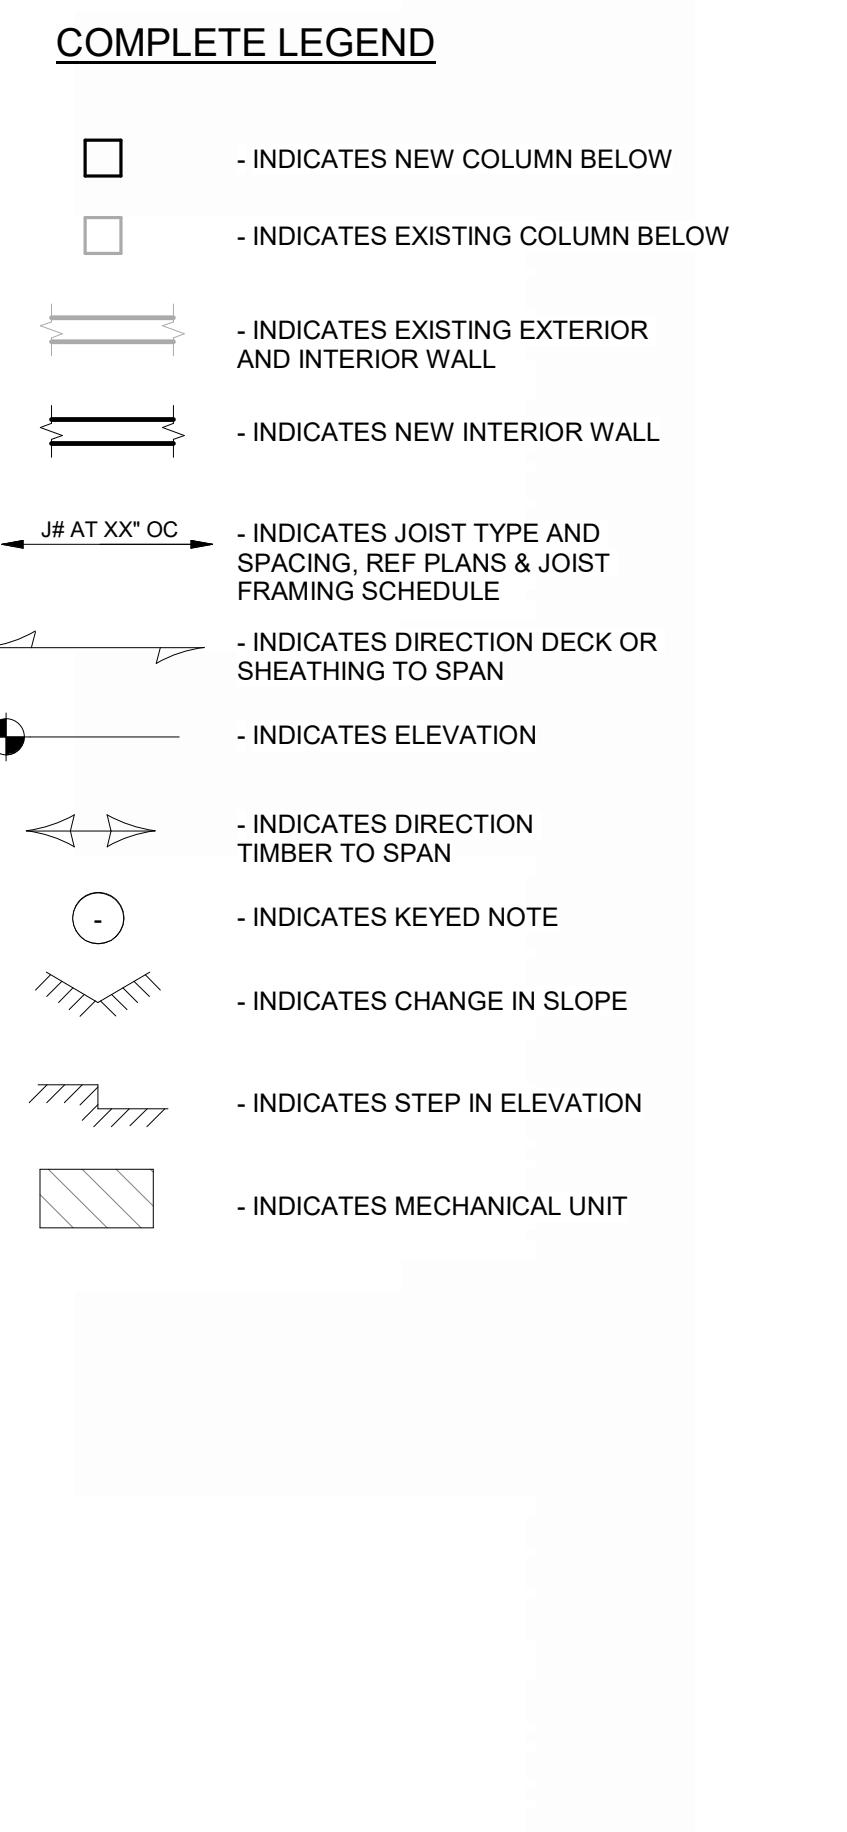

APPROVED FOR	DATE	BY
PERMIT DOCUMENTS	2.5.2024	Approver
PROJECT NO:	2221.HCR	
DRAWN BY:	Author	
CHECKED BY:	Checker	
© PINNACLE ARCHITECTURE, INC. 2023	ORIGINAL SHEET SIZE: 30" x 42"	
COVER SHEET		

SO.00

PROJECT DESCRIPTION:

- TENANT IMPROVEMENT OF AN EXISTING 3-STORY OFFICE BUILDING
- CEILING AND NON-BEARING WALL DESIGN

GENERAL:

1. THE STRUCTURAL DRAWINGS ARE A PORTION OF THE CONTRACT DOCUMENTS AND ARE INTENDED TO BE USED IN CONJUNCTION WITH THE ARCHITECTURAL, CIVIL, MECHANICAL, AND ELECTRICAL DRAWINGS. THE CONTRACTOR IS RESPONSIBLE FOR COORDINATING THE REQUIREMENTS FROM THE ENTIRE SET OF CONTRACT DOCUMENTS AND FOR COORDINATING THE WORK OF ALL TRADES IN THEIR WORK.
2. THESE GENERAL NOTES SUPPLEMENT THE PROJECT SPECIFICATIONS. REFER TO THE PROJECT SPECIFICATIONS FOR ADDITIONAL REQUIREMENTS.
3. NOTES AND DETAILS ON THE STRUCTURAL DRAWINGS SHALL TAKE PRIORITY OVER THE GENERAL STRUCTURAL NOTES AND TYPICAL DETAILS.
4. CONTRACTOR SHALL VERIFY ALL DIMENSIONS AND ELEVATIONS PROVIDED ON STRUCTURAL DRAWINGS WITH ALL DISCIPLINES INCLUDING, BUT NOT LIMITED TO ARCHITECT, GEOTECHNICAL ENGINEER, AND CIVIL ENGINEER PRIOR TO CONSTRUCTION.
5. DETAILS ON THESE PLANS ARE INTENDED TO DEPICT THE GENERAL CONSTRUCTION METHODS FOR THIS STRUCTURE. CONNECTIONS, DETAILS AND CONDITIONS NOT SPECIFICALLY SHOWN THAT ARE SIMILAR TO THOSE THAT ARE SPECIFIED SHALL BE ASSUMED. DURING THE CONSTRUCTION PROCESS, IF ANY OF THE ABOVE DETAILS ARE ENCOUNTERED, NOTIFY THE ARCHITECT/ENGINEER FOR CLARIFICATION IN A TIMELY MANNER PRIOR TO BID OPENING.

CODE REQUIREMENTS:

1. CONFORM TO THE 2022 OREGON STRUCTURAL SPECIALTY CODE (OSSC), BASED UPON THE 2021 INTERNATIONAL BUILDING CODE (IBC).
2. ALL REFERENCE TO OTHER CODES AND STANDARDS (ACI, AISC, AWS, NDS, ASTM, ETC.) SHALL BE FOR THE EDITIONS NOTED IN CHAPTER 35 OF THE IBC/OSSC.

TEMPORARY CONDITIONS:

1. THE STRUCTURE HAS BEEN DESIGNED TO FUNCTION AS A UNIT UPON COMPLETION. THE CONTRACTOR IS RESPONSIBLE FOR FURNISHING ALL TEMPORARY BRACING AND / OR SUPPORTS AS A RESULT OF THE CONTRACTOR'S CONSTRUCTION METHODS AND / OR SEQUENCES.
2. CONTRACTOR'S CONSTRUCTION METHODS AND / OR SEQUENCES SHALL RECOGNIZE AND CONSIDER THE EFFECTS OF THERMAL MOVEMENTS OF STRUCTURAL ELEMENTS DURING THE CONSTRUCTION PERIOD.
3. RETAINING WALLS TO UPPER SLABS SHALL NOT BE BACKFILLED UNTIL THE UPPER SLAB REACHES FULL STRENGTH UNLESS ADEQUATE BRACING IS PROVIDED AT THE TOP OF THE WALL.
4. FOR EXISTING BUILDINGS, ADDED STRUCTURAL MEMBERS, HARDWARE, CONNECTORS, STRAPS, FASTENERS, ETC. SHOWN ON THE STRUCTURAL DRAWINGS MAY NECESSITATE THE UNCOVERING / EXPOSURE OF PART OF THE EXISTING STRUCTURE. CONTRACTOR SHALL NOT REMOVE ANY EXISTING ELEMENTS OR PARTIAL DEMOLITION OF ELEMENTS SUCH AS CLADDING, FINISHES, CEILING, ROOFING, INSULATION, ELECTRICAL, PLUMBING, MECHANICAL, SPRINKLERS, ARCHITECTURAL, STRUCTURAL, ETC. THE CONTRACTOR IS RESPONSIBLE FOR DETERMINING THE MEANS AND METHODS TO EXECUTE THE REMOVAL / DEMOLITION. CONTRACTOR SHALL EXECUTE AND INSTALL ELEMENTS SHOWN ON THE STRUCTURAL DRAWINGS, REMOVED / DEMOLISHED ELEMENTS AS PREVIOUSLY NOTED THAT ARE PART OF THE FINAL PRODUCTION. ELEMENTS TO BE RESTORED TO THEIR ORIGINAL STATE UPON COMPLETION AND SHALL COMPLY WITH THE REQUIREMENTS OF THE ORIGINAL ARCHITECT, OTHER DISCIPLINES AND CURRENT BUILDING CODES AND STANDARDS.
5. FOR EXISTING BUILDINGS, SHORING OF PORTIONS OF THE EXISTING STRUCTURE MAY BE NECESSARY PRIOR TO REMOVAL / DEMOLITION. CARE SHALL BE TAKEN TO AVOID DAMAGE AND DISTRESS TO THE EXISTING STRUCTURE BEYOND THE DEMOLITION EXTENT. CONTRACTOR IS RESPONSIBLE FOR DETERMINING THE MEANS AND METHODS TO EXECUTE ALL MEASURES NECESSARY TO PROTECT THE STRUCTURE (EXISTING AND NEW) DURING CONSTRUCTION. THE CONTRACTOR IS RESPONSIBLE FOR FURNISHING ALL TEMPORARY BRACING AND / OR SUPPORT REQUIRED AS A RESULT OF THE CONTRACTOR'S CONSTRUCTION METHODS AND / OR SEQUENCES.

EXISTING CONDITIONS:

1. ALL EXISTING CONDITIONS, DIMENSIONS, AND ELEVATIONS SHALL BE FIELD VERIFIED - ONLY FIELD VERIFIED DIMENSIONS SHALL BE USED IN CREATION OF THE SHOP DRAWINGS. THE CONTRACTOR SHALL NOTIFY THE ARCHITECT AND ENGINEER OF ANY SIGNIFICANT DISCREPANCIES FROM DIMENSIONS AND CONDITIONS SHOWN ON THE DRAWINGS.

2. X-RAY OR GPR SHALL BE USED PRIOR TO DRILLING OR CUTTING INTO CONCRETE CONSTRUCTION TO LOCATE AND AVOID REINFORCEMENT AND/OR TENDONS. APPROVED HOLES (APPROVED BY FROELICH ENGINEERS) THROUGH EXISTING CONCRETE ARE ALLOWED, PROVIDED THAT THEY DO NOT CUT THROUGH ANY REINFORCING STEEL OR PRE-STRESSED TENDONS.
3. APPROVED HOLES (APPROVED BY FROELICH ENGINEERS) THROUGH EXISTING STEEL STRUCTURE SHALL BE CUT CAREFULLY AND CLEANLY. DO NOT TORCH OR FLAME CUT.
4. DUE TO LIMITED OBSERVATION AND ACCESS TO THE EXISTING STRUCTURE PRIOR TO THE PREPARATION OF THE STRUCTURAL DRAWINGS, FROELICH ENGINEERS ASSUMES THAT THE EXISTING STRUCTURE IS IN GOOD CONDITION WITH NO SIGNIFICANT DEFORMATION, DAMAGE, ETC. AND WAS CONSTRUCTED IN ACCORDANCE WITH THE ORIGINAL CONSTRUCTION DOCUMENTS (IF AVAILABLE). GENERAL CONTRACTOR SHALL VERIFY THE ABOVE ASSUMPTIONS AND NOTIFY THE ENGINEER OF RECORD OF CONCERN, DAMAGE, OR DISCREPANCIES.
5. FOR NEW EQUIPMENT OR CONSTRUCTION ADDED ATOP OR BEneath EXISTING CONSTRUCTION, THE GENERAL CONTRACTOR SHALL VERIFY THAT PROPER ROOF SLOPE AND DRAINAGE IS STILL IN PLACE.

DESIGN CRITERIA:

1. DESIGN WAS BASED ON THE STRENGTH AND DEFLECTION CRITERIA OF THE IBC/OSSC. IN ADDITION TO THE DEAD LOADS, THE FOLLOWING LOADS AND ALLOWANCES WERE USED FOR DESIGN, WITH LIVE LOADS (LL) REDUCED IN ACCORDANCE WITH THE IBC:

DESIGN CRITERIA	
GEOTECHNICAL CRITERIA	
2500 PSF (MIN) PER GEOTECHNICAL REPORT DATED DECEMBER 3, 2021	
BUILDING RISK CATEGORY	
RISK CATEGORY	II
LIVE LOAD CRITERIA	
FLOOR DESIGN IS NOT IN FROELICH ENGINEERS SCOPE OF WORK	
ROOF CRITERIA	
ROOF DESIGN IS NOT IN FROELICH ENGINEERS SCOPE OF WORK	
SEISMIC CRITERIA	
ANALYSIS PROCEDURE	EQUIVALENT LATERAL FORCE, REF ASCE 7-16 SECTION 13
SITE CLASS	D
IMPORTANCE FACTOR	$I_p = 1.00$
SEISMIC DESIGN CATEGORY	D
MCE SPECTRAL ACCELERATIONS	$S_s = 0.94$
DESIGN SPECTRAL ACCELERATIONS	$S_{ds} = 0.76$
REVERSE MODIFICATION FACTOR	$R_p = 2.5$
COMPONENT AMPLIFICATION FACTOR	$a_p = 1.0$
WEIGHT OF CEILING (MAX.)	W = 4 PSF

CEILING PLAN GENERAL NOTES:

1. THIS DRAWING IS FOR INTERIOR APPLICATION ONLY.
2. THE CEILING WEIGHTS SHALL NOT EXCEED 4 PSF.
3. REFER TO SHEET S4.01 FOR TYPICAL CONNECTION DETAILS.
4. A HEAVY DUTY T-BAR GRID SYSTEM SHALL BE USED.
5. FOR CEILING AREAS EXCEEDING 1,000 SQ. FT., HORIZONTAL RESTRAINT OF CEILING TO THE STRUCTURAL SYSTEM SHALL BE PROVIDED. THE TRIBUTARY AREAS OF THE HORIZONTAL RESTRAINTS ARE APPROXIMATELY 1,000 SQ. FT. WHERE CEILING AREAS ARE LESS THAN OR EQUAL TO 1,000 SQ. FT., BOUNDARY ELEMENTS SUCH AS WALLS SHALL BE ADEQUATELY BRACED BY OTHERS TO RESIST THE LATERAL CEILING FORCES EXERTED UPON IT.
6. CEILING WITH INTERSTICIAL SPACES LESS THAN 12 INCHES TO FRAMING ARE NOT REQUIRED TO HAVE LATERAL FORCE BRACING.
7. SPRINKLER HEADS AND OTHER PENETRATIONS SHALL HAVE 2" OVERRIDED RING THROUGH THE TILE TO ALLOW 1" OF FREE MOVEMENT IN ALL DIRECTION - REF TO TYPICAL DETAIL.
8. THE DRAWINGS ASSUME THAT THE STURDY CEILINGS CAN SUPPORT ALL VERTICAL (STRUT, DROP, ETC.) AND LATERAL LOADS (SPRAYS, ETC.) REPORTED UPON IT.
9. LATERAL BRACING REQUIREMENTS (SPRAY WIRES, KICKERS & COMPRESSION POSTS/STRUTS) SHOWN ON TYPICAL DETAILS ARE NOT REQUIRED FOR GYPSUM CEILING ON ONE LEVEL THAT ARE SURROUNDED BY BOUNDARY ELEMENTS THAT ARE LATERALLY SUPPORTED AND BRACED TO STRUCTURE ABOVE.

SUBMITTALS:

1. REVIEW OF THE SUBMITTALS IS ONLY FOR REVIEW OF GENERAL CONFORMANCE WITH THE DESIGN CONCEPT OF THE PROJECT AND GENERAL COMPLIANCE WITH THE INFORMATION GIVEN IN THE CONTRACT DOCUMENTS. NO RESPONSIBILITY IS ASSUMED BY THE STRUCTURAL ENGINEER FOR CORRECTNESS, DIMENSIONS OR DETAILS CONTAINED WITHIN THE SUBMITTALS. THE CONTRACTOR IS SOLELY RESPONSIBLE FOR CONFIRMING AND CORRELATING ALL QUANTITIES AND DIMENSIONS; SELECTING FABRICATION PROCESSES AND TECHNIQUES; COORDINATING CONSTRUCTION; COORDINATING THEIR WORK WITH THAT OF ALL OTHER TRADES; AND PERFORMING THEIR WORK IN A SAFE AND SATISFACTORY MANNER.
2. REVIEW OF THE SUBMITTALS DOES NOT RELIEVE THE CONTRACTOR FROM COMPLIANCE WITH THE REQUIREMENTS OF CONTRACT DOCUMENTS AND SPECIFICATIONS. THE REVIEW OF A SUBMITTAL SHALL NOT BE CONSIDERED A WAIVER OF THE REQUIREMENT OF STRICT COMPLIANCE WITH THE CONTRACT DOCUMENTS AND SPECIFICATIONS. ALL SUBMITTALS SHALL BE REVIEWED IN ACCORDANCE WITH THE REQUIREMENTS SPECIFIED ON THE STRUCTURAL DRAWINGS, GOVERNING BUILDING CODES, AND REFERENCED STANDARDS SHALL BE MET REGARDLESS OF THE INFORMATION INDICATED ON THE SUBMITTALS.
3. REVIEW OF SUBMITTALS WILL BE REVIEWED A MAXIMUM OF TWO ITERATIONS / ROUNDS BY FROELICH ENGINEERS. INDIVIDUAL REVIEW OF STRUCTURAL SUBMITTALS WILL BE BILLED AT AN HOURLY RATE. REVIEW OF SUBMITTALS BEYOND OUR SCOPE WILL BE BILLED AT AN HOURLY RATE IN ADDITION TO PROJECT FEE, ACCORDING TO RATES NOTED IN THE PROJECT CONTRACT.
4. SUBMITTALS AND DRAWINGS SHALL BE GENERATED BY AND ORIGINATE FROM THE CONTRACTOR. STRUCTURAL AUTOCAD/REVIT BACKGROUNDS WILL NOT BE RELEASED BY FE AND MAY NOT BE USED FOR THE GENERATION OF SUBMITTALS AND DRAWINGS. IT IS THE CONTRACTOR'S RESPONSIBILITY TO COORDINATE THESE DOCUMENTS WITH THE DESIGN TEAM.
5. SUBMITTALS SHALL BE REVIEWED FOR CONFORMANCE WITH THE CONTRACT DOCUMENTS AND STAMPED BY THE GENERAL CONTRACTOR PRIOR TO SUBMISSION TO THE DESIGN TEAM. SUBMITTALS THAT ARE NOT REVIEWED AND STAMPED BY THE GENERAL CONTRACTOR WILL BE RETURNED WITHOUT REVIEW.
6. REQUESTS FOR SUBSTITUTIONS OR MODIFICATION OF PLANS OR SPECIFICATIONS SHALL BE SUBMITTED AS SEPARATE ITEMS. SUBMITTALS SUBMITTED FOR REVIEW DO NOT CASTING A "WRITING" UNLESS SPECIFIC SUGGESTED CHANGES ARE CLEARLY MARKED (I.E. CLOUDED, SUGGESTING A CHANGE). IN ALL CASES, SUCH CHANGES BY MEANS OF THE SUBMITTAL BECOME THE RESPONSIBILITY OF THE PARTY INITIATING SUCH CHANGE. TIME AND MATERIALS INCURRED BY FE RELATED TO SUCH SUBSTITUTIONS OR MODIFICATIONS WILL BE BILLED AT AN HOURLY RATE IN ADDITION TO PROJECT FEE, ACCORDING TO RATES NOTED IN THE PROJECT CONTRACT.
6. SUBMITTALS SHALL BE SUBMITTED TO THE DESIGN TEAM PRIOR TO THE FABRICATION AND CONSTRUCTION OF ALL STRUCTURAL ITEMS INCLUDING THE FOLLOWING:

SUBMITTALS			
ITEM	SUBMITTAL (A, D)	DEFERRED SUBMITTAL (B, D)	COMMENTS
MEP ANCHORAGE AND BRACING	X	FOOTNOTE "C"	

- A. IF THE SHOP DRAWINGS DIFFER FROM OR ADD TO THE DESIGN OF THE STRUCTURAL DRAWINGS, THEY SHALL BEAR THE SEAL AND SIGNATURE OF A PROFESSIONAL ENGINEER REGISTERED IN THE STATE WHERE THE PROJECT IS LOCATED. ANY MODIFICATIONS TO THE STRUCTURAL DRAWINGS SHALL BE SUBMITTED TO THE ARCHITECT AND ARE SUBJECT TO REVIEW AND APPROVAL BY THE STRUCTURAL ENGINEER RECORD.
- B. DESIGN DRAWINGS, SHEET DRAWINGS, AND CALCULATIONS FOR THE DESIGN AND FABRICATION OF ITEMS THAT ARE DESIGNED BY OTHERS SHALL BEAR THE SEAL AND SIGNATURE OF A PROFESSIONAL ENGINEER REGISTERED IN THE STATE WHERE THE PROJECT IS LOCATED. CALCULATIONS SHALL BE INCLUDED FOR ALL CONNECTIONS TO THE STRUCTURE CONSIDERING LOCALIZED EFFECTS ON STRUCTURAL ELEMENTS INDUCED BY THE CONNECTION. DESIGN DRAWINGS SHALL BE BASED UPON THE REQUIREMENTS OF THE IBC/OSSC AND AS NOTED UNDER "DESIGN CRITERIA".
- C. THE CONTRACTOR SHALL COORDINATE THE VERTICAL AND LATERAL RESTRAINTS OF MECHANICAL, ELECTRICAL, AND PLUMBING EQUIPMENT, MACHINERY, AND ASSOCIATED PIPING WITH THE STRUCTURE. CONNECTIONS TO THE STRUCTURE SHALL CONFORM TO ASCE 7 (INCLUDING, BUT NOT LIMITED TO CHAPTER 13) AND DESIGNED BY A PROFESSIONAL ENGINEER REGISTERED IN THE STATE WHERE THE PROJECT IS LOCATED.
- D. PIPE BRIDGING DETAILS SHALL BE SUBMITTED BY THE CONTRACTOR PRIOR TO ADDITION TO THE STRUCTURE. DRAWINGS SHALL BEAR THE SEAL AND SIGNATURE OF A PROFESSIONAL ENGINEER REGISTERED IN THE STATE WHERE THE PROJECT IS LOCATED AND SHALL BE SUBMITTED TO THE ARCHITECT PRIOR TO CONSTRUCTION. ANY SUCH DETAILS ARE SUBJECT TO REVIEW AND ACCEPTANCE BY THE STRUCTURAL ENGINEER RECORD.
- E. THE DELEGATED DESIGNER SHALL IN CO-OPERATION WITH THE GENERAL CONTRACTOR, COORDINATE THE VERTICAL LATERAL RESTRAINTS AND LOADS OF EQUIPMENT OR COMPONENT WITH THE STRUCTURE. CONNECTIONS TO THE STRUCTURE SHALL CONFORM TO IBC/OSSC AND ASCE 7 AND BE DESIGNED BY A PROFESSIONAL ENGINEER REGISTERED IN THE STATE WHERE THE PROJECT IS LOCATED.
- F. TERTIARY STRUCTURE SUBMITTALS ABOVE ARE OUTSIDE THE SCOPE OF FROELICH ENGINEERS TO REVIEW.

LIGHT GAGE STEEL FRAMING:

1. METAL STUDS SHALL BE C-STUDS WITH A MINIMUM YIELD STRENGTH OF 33 KSI FOR 33 AND 43 MILS AND 50 KSI FOR 54, 69, AND 97 MILS.
2. STUDS SHALL BE OF SAME SIZE, GAUGE AND SPACING AS SHOWN ON THE STRUCTURAL DRAWINGS.
3. PROVIDE BRIDGING IN CONFORMANCE WITH THE STEEL STUD MANUFACTURERS ASSOCIATION'S (SSMA) RECOMMENDATIONS ADEQUATE FOR DEVELOPMENT OF THE FULL MOMENT CAPACITY.
4. ALL TRACKS SHALL BE OVERSIZED TO PROVIDE FULL STUD END BEARING.
5. SCREWS SHALL BE ELCO DRILL-FLEX, OR HILTI KWIK-FLEX (ICC ER-4790). SCREWS SHALL EXTEND THROUGH ALL MEMBERS WITH A MINIMUM OF 3 EXPOSED THREADS.
6. WELDING SHALL CONFORM WITH AWS D1.3 AND BE COMPLETED BY AWS WELDERS CERTIFIED FOR LIGHT GAGE STEEL.
7. LOAD CLOTH FASTENERS SHALL BE 0.157" DIAMETER HILTI X-U (ICC ESR-2269) OR DEWALT CSI SPIRAL DRIVE PIN (SSR-2024).
8. WHERE STUD CLIPS ARE ATTACHED SLAB EDGE ANGLES, SCREWS AND PAFS SHALL BE INSTALLED PRIOR TO CONCRETE SLAB PLACEMENT. AFTER SLAB IS PLACED, WELDS SHALL BE USED - CONTACT FROELICH ENGINEERS FOR WELD SIZES.
9. PROVIDE ALL ACCESSORIES, INCLUDING, BUT NOT LIMITED TO BRIDGING, TRACKS, CLIPS, WEB STRIPS, LOAD CLOTH, FASTENING DEVICES AND OTHER ACCESSORIES REQUIRED FOR A COMPLETE AND PROPER INSTALLATION.
10. SPLICES IN STUDS ARE NOT PERMITTED.
11. STUDS SHALL BE SCREWED TO THE FLANGES OF BOTH UPPER AND LOWER TRACKS.
12. JOIST SHALL BE BRACED WITH BRIDGING, REF MANUFACTURER'S SPECIFICATIONS.

GENERAL - SPECIAL INSPECTIONS					
SYSTEM OR MATERIAL	OSSC CODE REFERENCE	CODE OR STANDARD REFERENCE	FREQUENCY (NOTE 6)		REMARKS
			CONTINUOUS	PERIODIC	
DEFERRED SUBMITTALS				X	SPECIAL INSPECTION REQUIREMENTS FOR DEFERRED SUBMITTAL ITEMS, INCLUDING REQUIREMENTS FOR DESIGNATED SEISMIC SYSTEMS IN ACCORDANCE WITH OSSC SECTION 1705.13.4 IF APPLICABLE. TO BE SPECIFIED BY THE SYSTEM ENGINEER AND INCLUDED WITH DEFERRED SUBMITTAL DOCUMENTS.
PRE-ENGINEERED STRUCTURES	1705.1.1	MBMA	X	X	REFER TO DEFERRED SUBMITTALS AND FABRICATORS REQUIREMENTS

pinnacle
architecture, inc.
"ENHANCING LIVES AND COMMUNITIES"
1001 SW DISK DRIVE, SUITE 105
BEND OR 97702
541.388.9897
WWW.PINNACLEARCHITECTURE.COM



CLACKAMAS COUNTY BEHAVIORAL
HEALTH
CLIENT:
CLACKAMAS COUNTY

PROJECT ADDRESS:
6605 SE Lake Rd, Milwaukie, OR
97222

APPROVED FOR _____ DATE _____ BY _____
PERMIT DOCUMENTS 2.5.2024 Approver
DESCRIPTION _____ DATE _____

PROJECT NO: 2221.HCR
DRAWN BY: Author
CHECKED BY: Checker
© PINNACLE ARCHITECTURE, INC. 2023 ORIGINAL SHEET SIZE: 30" x 42"

GSN AND SPECIAL INSPECTION
TABLES

SO.01



FROELICH
ENGINEERS

Portland, OR | Bend, OR | Denver, CO

foeelich-engineers.com | FEE # 23-126



CLACKAMAS COUNTY BEHAVIORAL
HEALTH
CLIENT:
CLACKAMAS COUNTY

PROJECT ADDRESS:
6605 SE Lake Rd, Milwaukie, OR
97222

APPROVED FOR DATE BY
PERMIT DOCUMENTS 2.5.2024 Approver

DESCRIPTION DATE
PROJECT NO: 2221 HCR
DRAWN BY: Author
CHECKED BY: Checker

ORIGINAL SHEET SIZE: 30" x 42"

© PINNACLE ARCHITECTURE, INC. 2023


7/5/2024 1:39:21 PM


2ND FLOOR FRAMING PLAN

S1.10

KEYED NOTES

1. REFER TO SHEET S8.00 AND S8.01 FOR ALL TYPICAL CFS WALL DETAILS.
2. ALL MAIN CEILING BEAMS SHALL BE HEAVY DUTY.
3. ALL CROSS TEE MEMBERS SHALL BE CAPABLE OF CARRYING THE DESIGN LOAD WITHOUT EXCEEDING A DEFLECTION OF 1/360 OF ITS SPAN.
4. ALL SPAN WIRES ARE TO BE SECURED TO THE MAIN RUNNER AND BE WITHIN 2' OF THE COMPRESSION STRUTS.
5. ALL SPAN WIRES SHALL BE SPACED 6" MIN. FROM ALL HORIZONTAL PIPING OR DUCT WORK THAT IS NOT INDEPENDENTLY LATERALLY BRACED.
6. HANGER AND PERIMETER WIRES ARE TO BE PLUMB WITHIN 1 IN 6 UNLESS COUNTER SLOPING WIRES ARE PROVIDED.
7. HANGER WIRES SHALL NOT ATTACH TO OR BEND AROUND INTERFERING EQUIPMENT. SEE SPECIFIC DETAIL FOR TRAPEZEE AROUND OBSTRUCTION.
8. LIGHT FIXTURE LESS THAN 10 LBS SHALL HAVE (1) 12 GA. HANGER WIRE CONNECTED TO THE FIXTURE AND THE STRUCTURE ABOVE. THIS WIRE MUST BE PLUMB.
9. LIGHT FIXTURES GREATER THAN 10 LBS AND LESS THAN 60 LBS AND MECHANICAL EQUIPMENT MORE THAN 20 LBS AND LESS THAN 60 LBS SHALL HAVE (2) 12 GA. HANGER WIRE CONNECTED TO OPPOSING CORNERS OF THE FIXTURE/EQUIPMENT AND ATTACH TO STRUCTURE ABOVE. THESE WIRES MAYBE SLACK.
10. ALL EQUIPMENT MORE THAN 60 LBS SHALL BE INDEPENDENTLY SUPPORTED WITH THE SUPPORT AND BRACING BY A LICENSED ENGINEER NOT IN FROELICH ENGINEER'S SCOPE OF WORK.
11. ALL SUSPENDED CEILING BRACING LOCATIONS ARE TO HAVE A VERTICAL COMPRESSION STRUT. THESE STRUTS MAY BE AN ELECTRICAL METALLIC TUBING (EMT). REFER TO SCHEDULE ON TYPICAL DETAILS FOR MORE INFO.
12. THE STRUTS SHALL BE VERTICAL, AND SHALL NOT HANG MORE THAN 1 IN 6 OUT OF PLUMB.
13. PROVIDE SPREADER BARS WHERE BEAMS AND CROSSTEES ARE NOT DIRECTLY ATTACHED TO PERIMETER CLOSURE ANGLE.
14. SPREADER BARS ARE NOT REQUIRED WHERE A 90 DEGREE INTERSECTING CROSS TEE OR MAIN MEMBER IS WITHIN 8' OF THE PERIMETER WALL.
15. WHERE REQUIRED SPREADER BARS ARE TO BE PLACED WITHIN 8' OF PERIMETER WALL.
16. PERIMETER WIRES ARE NOT REQUIRED AT CROSS TEE MEMBERS WHEN THEIR LENGTH IS 8' OR LESS.
17. SEISMIC CLIPS SHALL BE ONE OF THE FOLLOWINGS:
 - CERTAINTEED CTSPC AND CTSPC-2'
 - USG ACM7
 - ARMSTRONG BRC2
 - CHICAGO METALLIC 1490 SEISMIC CLIP
18. CLIP CONNECTION "A": (2) #8'S TO WALL ANGLE AND (1) #8 TO GRID MEMBER. THE SEISMIC PERIMETER CLIP IS INSTALLED BY PUSHING THE BACK TABS OF THE CLIP OVER THE VERTICAL HEM OF THE WALL ANGLE OR SHADOW MOLDING. ON THE TWO ADJACENT FIXED WALLS, THE PERIMETER CLIP MUST BE ATTACHED TO THE FRAMING MEMBER BY A #8 FASTENED INTO THE BULB OR WEB OF THE RUNNER AND DRAINED NO CLEARANCE BETWEEN THE TERMINAL RUNNER AND THE WALL ANGLE OR SHADOW MOLDING.
19. CLIP CONNECTION "B": THE CLIP MUST ALLOW FOR A MINIMUM 0.75 INCH MOVEMENT OF THE TERMINAL RUNNER END TOWARDS AND AWAY FROM THE WALL. CLIPS MUST BE SCREWED TO THE WALL ANGLE OR SHADOW MOLDING WITH (2) #8'S, AND THE WALL ANGLE OR SHADOW MOLDING MUST BE POSITIVELY ATTACHED TO THE WALL STUDS OR SUPPORT ANGLE. SEISMIC PERIMETER CLIPS INSTALLED IN THIS MANNER ARE USED IN LIEU OF THE STABILIZER BARS REQUIRED.

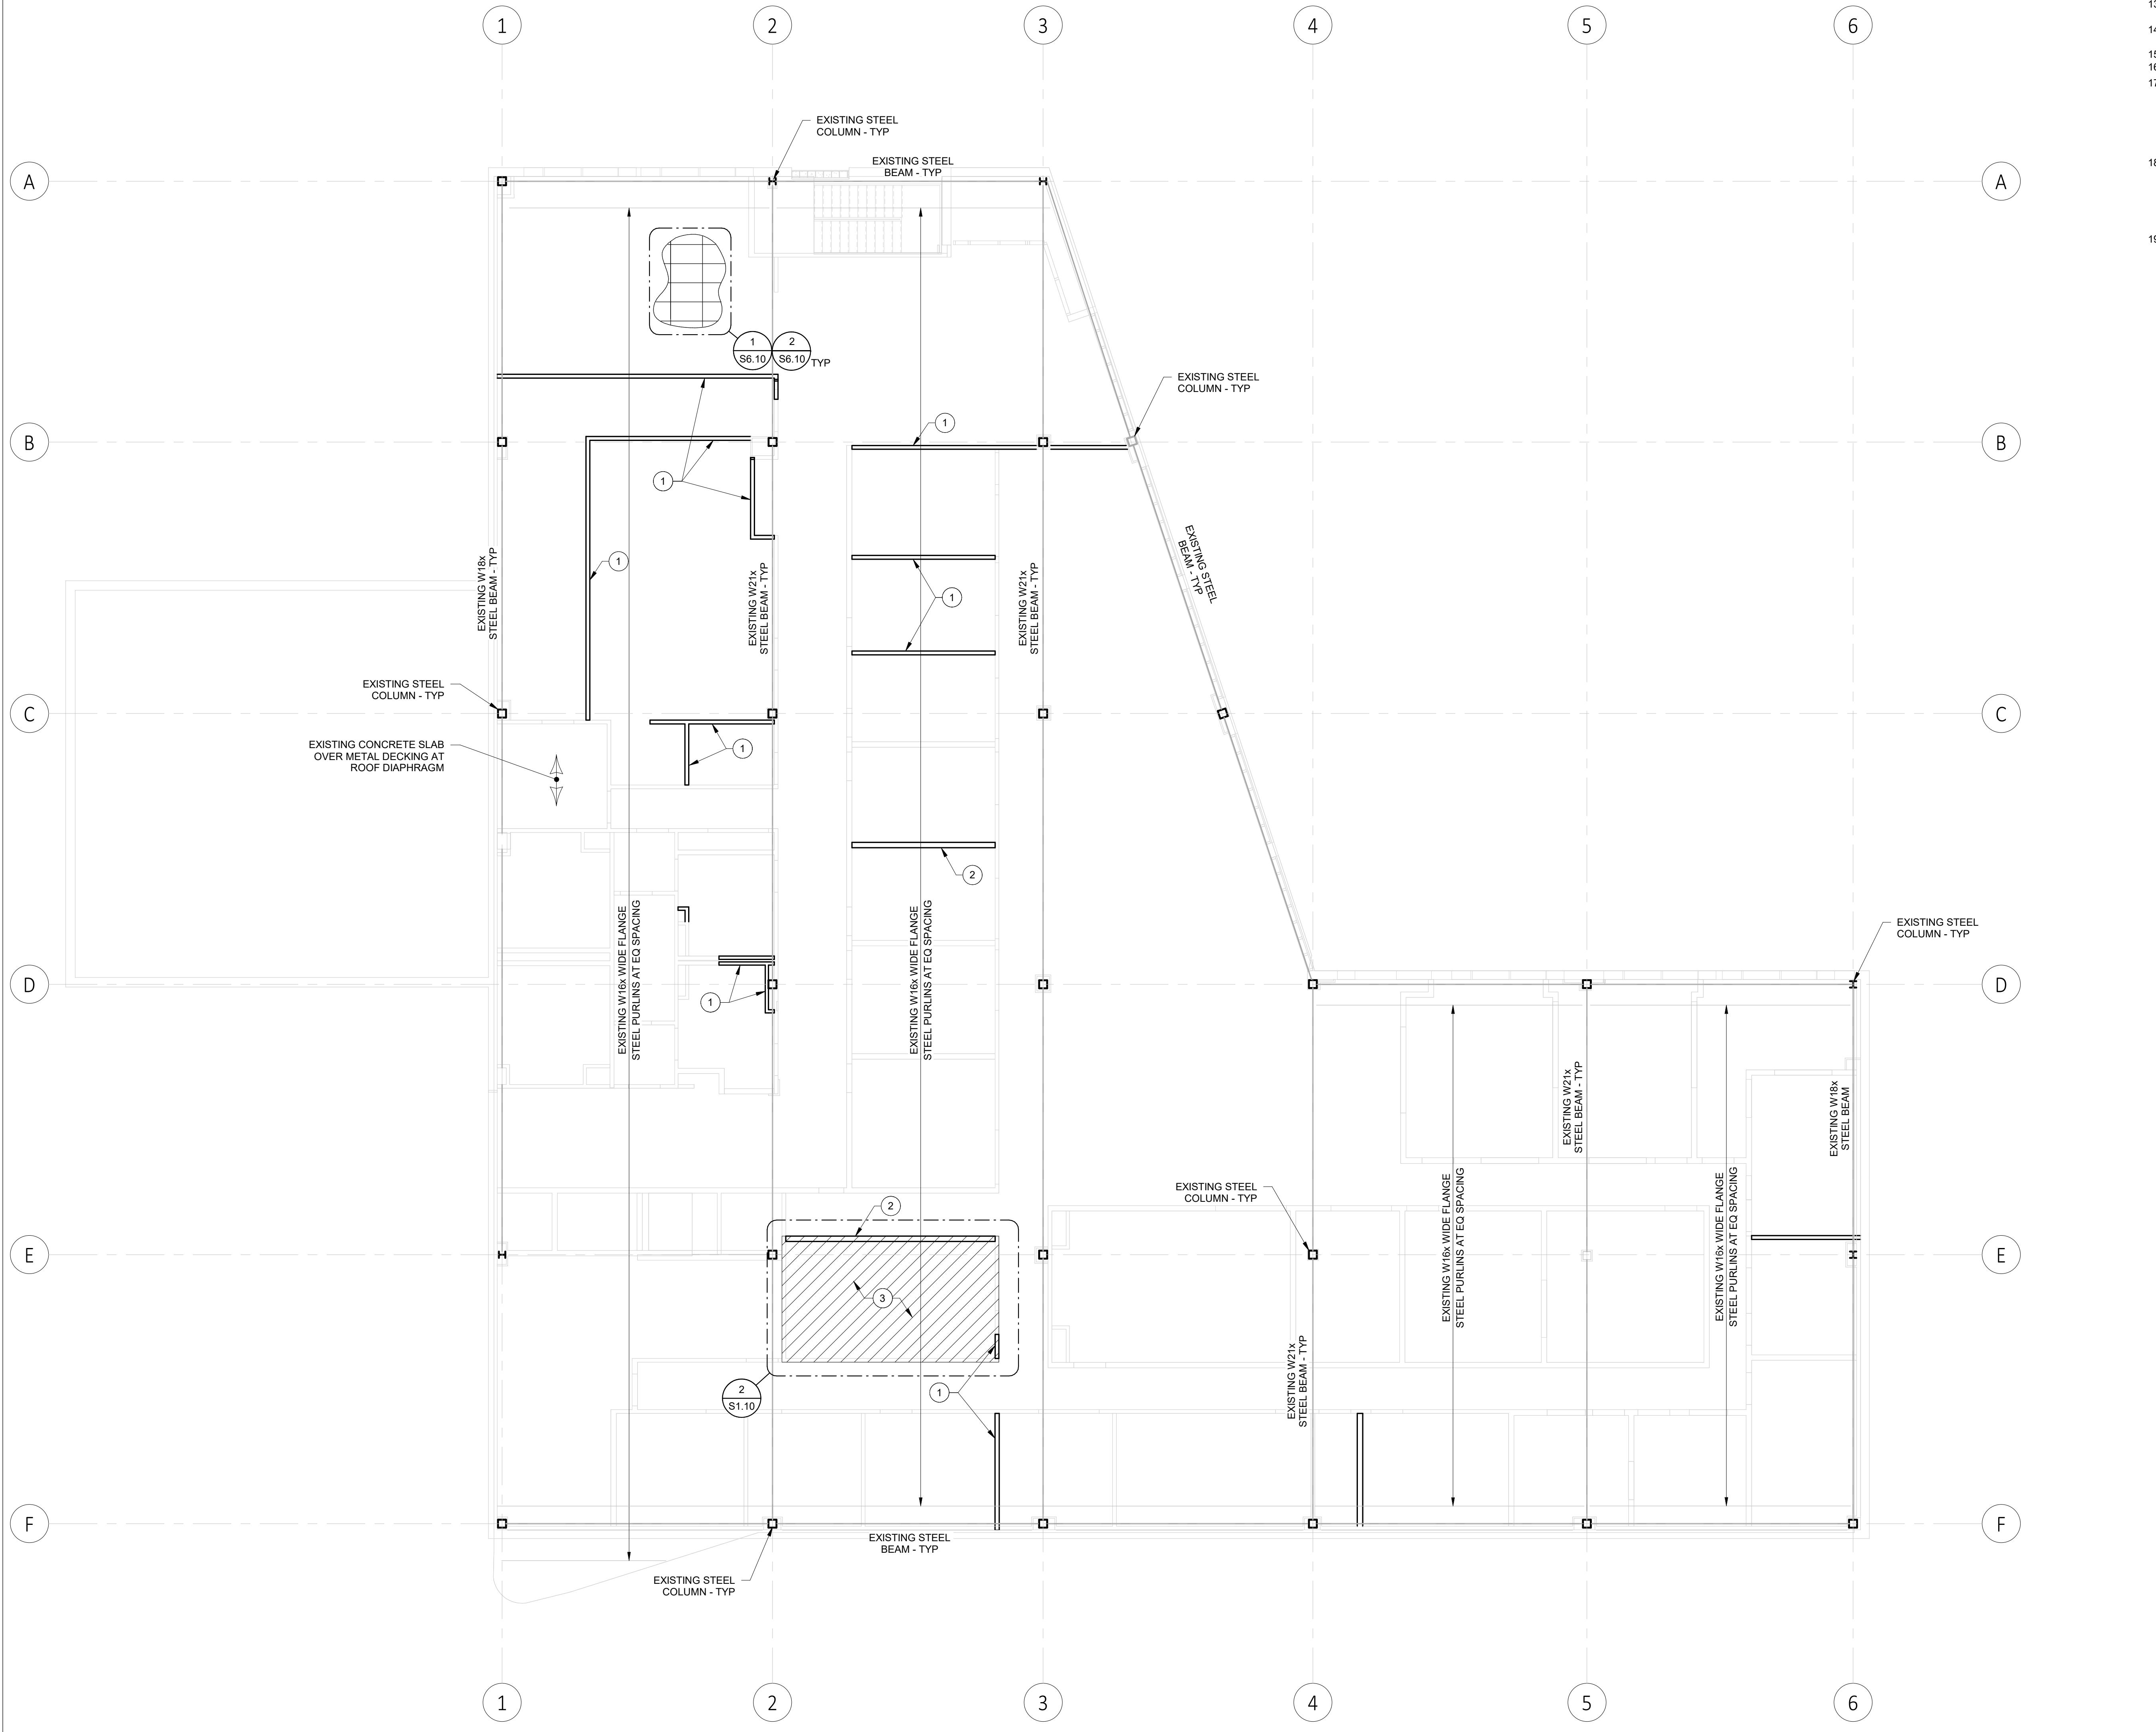


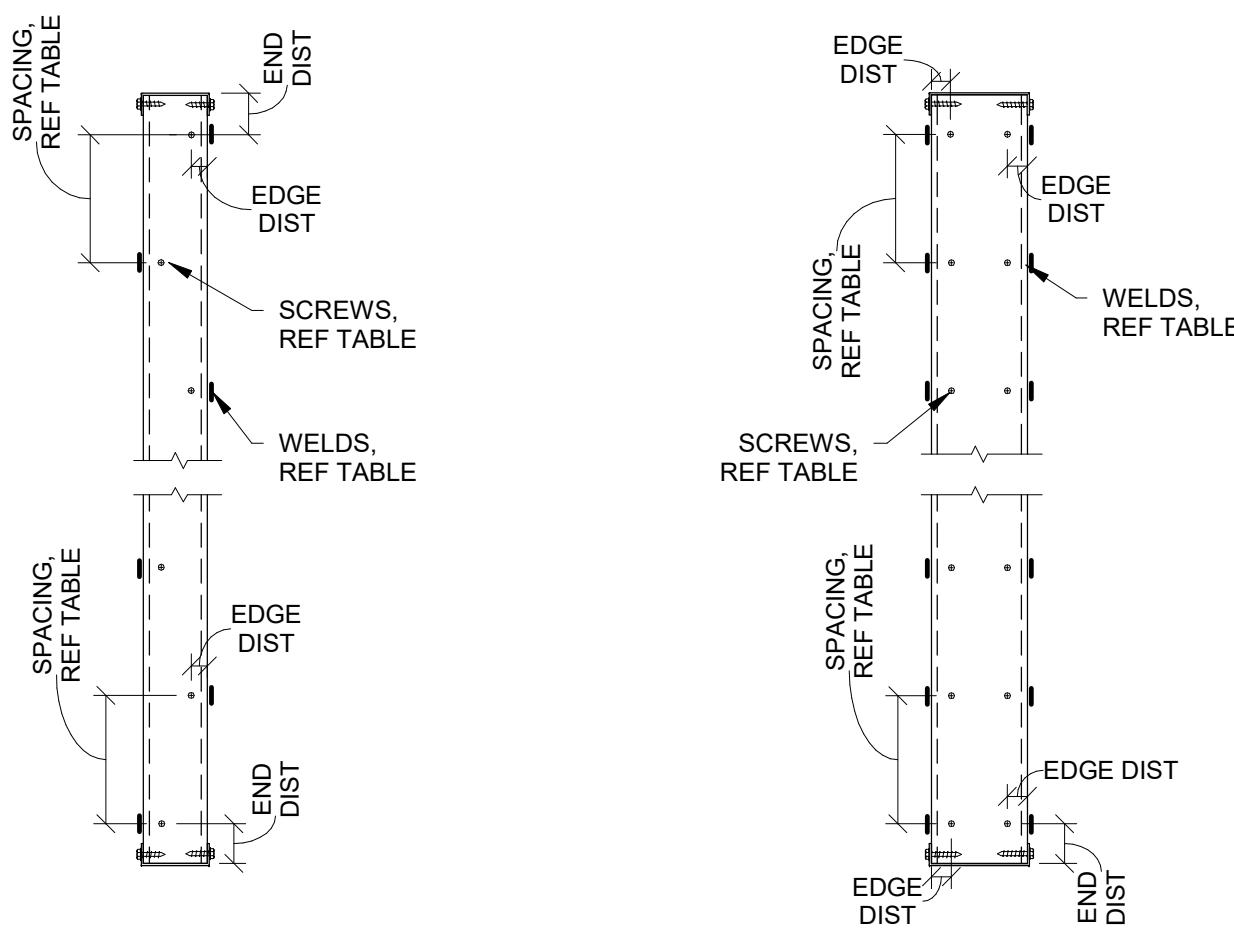


BUILT-UP MEMBER	FASTENER SIZE	FASTENER SPACING	FASTENER END DIST	FASTENER EDGE DIST	ROWS OF FASTENERS
(2) 4" STUDS	#10 SCREWS	8"	2.5"	1'-1.5"	1 - STAGGER
(4) 4" STUDS	#10 SCREWS + 1" LONG WELDS	8"	2.5"	1'-1.5"	1 - STAGGER
(2) 6" STUDS	#10 SCREWS	8"	2.5"	1'-1.5"	2
(4) 6" STUDS	#10 SCREWS + 1" LONG WELDS	8"	2.5"	1'-1.5"	2

NOTES:
1. PLYWOOD SHEATHING OR GYP BOARD FASTENERS SHALL BE STAGGERED TO EACH STUD IN BUILT-UP MEMBER.
2. SCREWS SHALL BE STAGGERED EACH SIDE OF BUILT-UP MEMBER.


8 BUILT-UP CFS POSTS
1" = 1'-0"

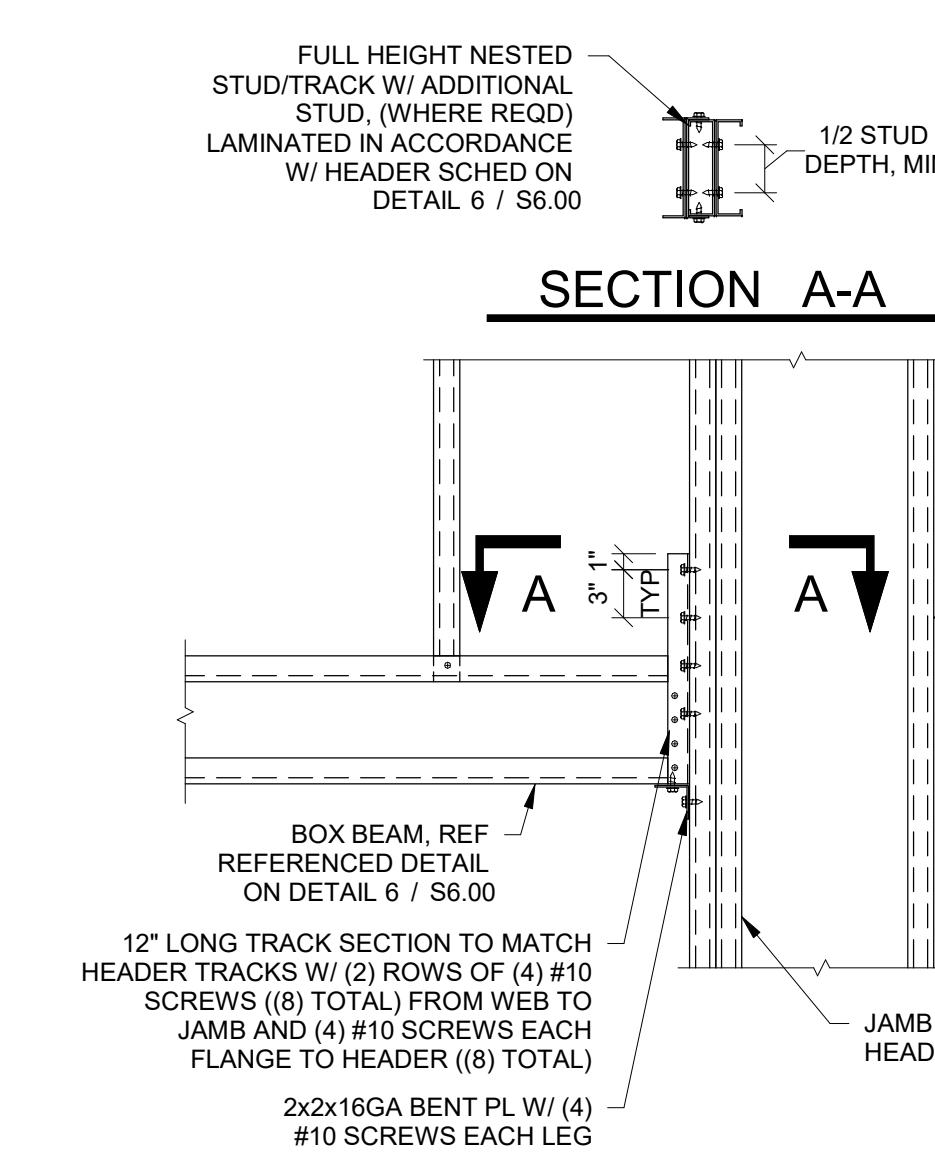

9 HEADER TO JAMB STUD
1" = 1'-0"

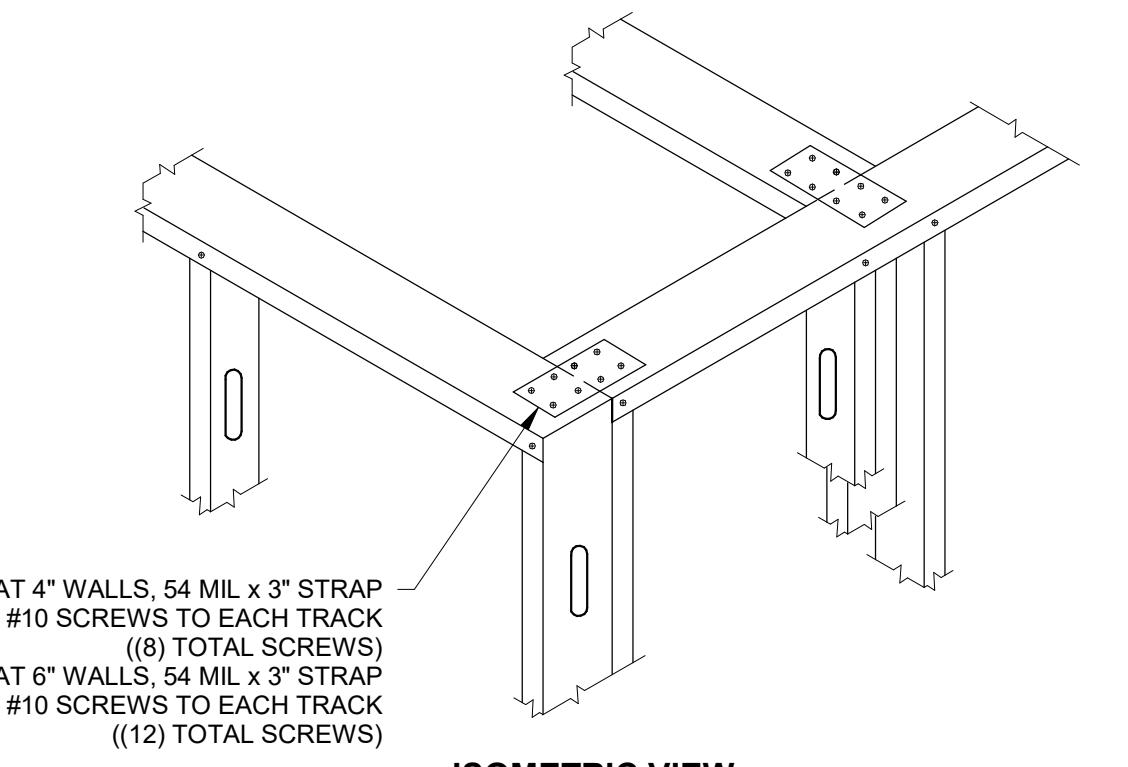


ISOMETRIC VIEW

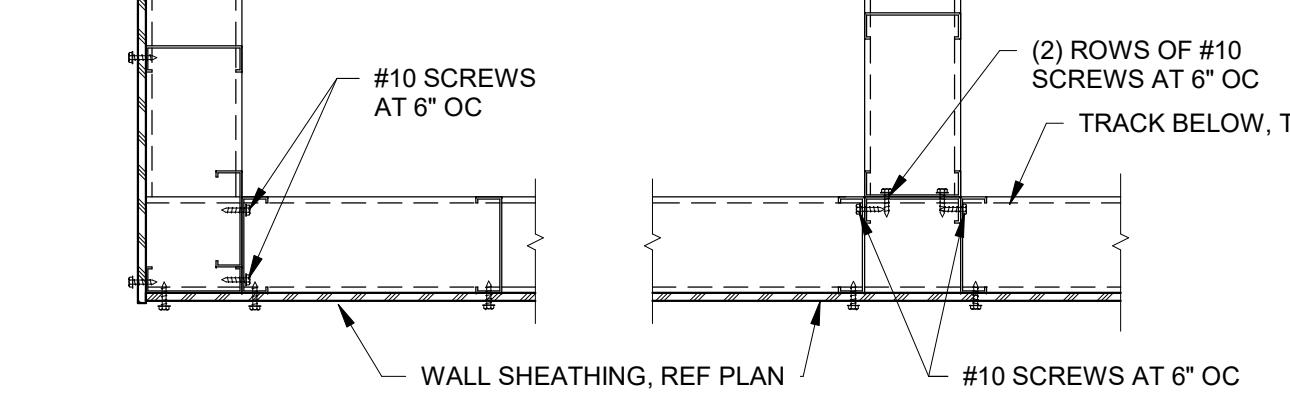


CORNER - PLAN VIEW

INTERSECTION - PLAN VIEW

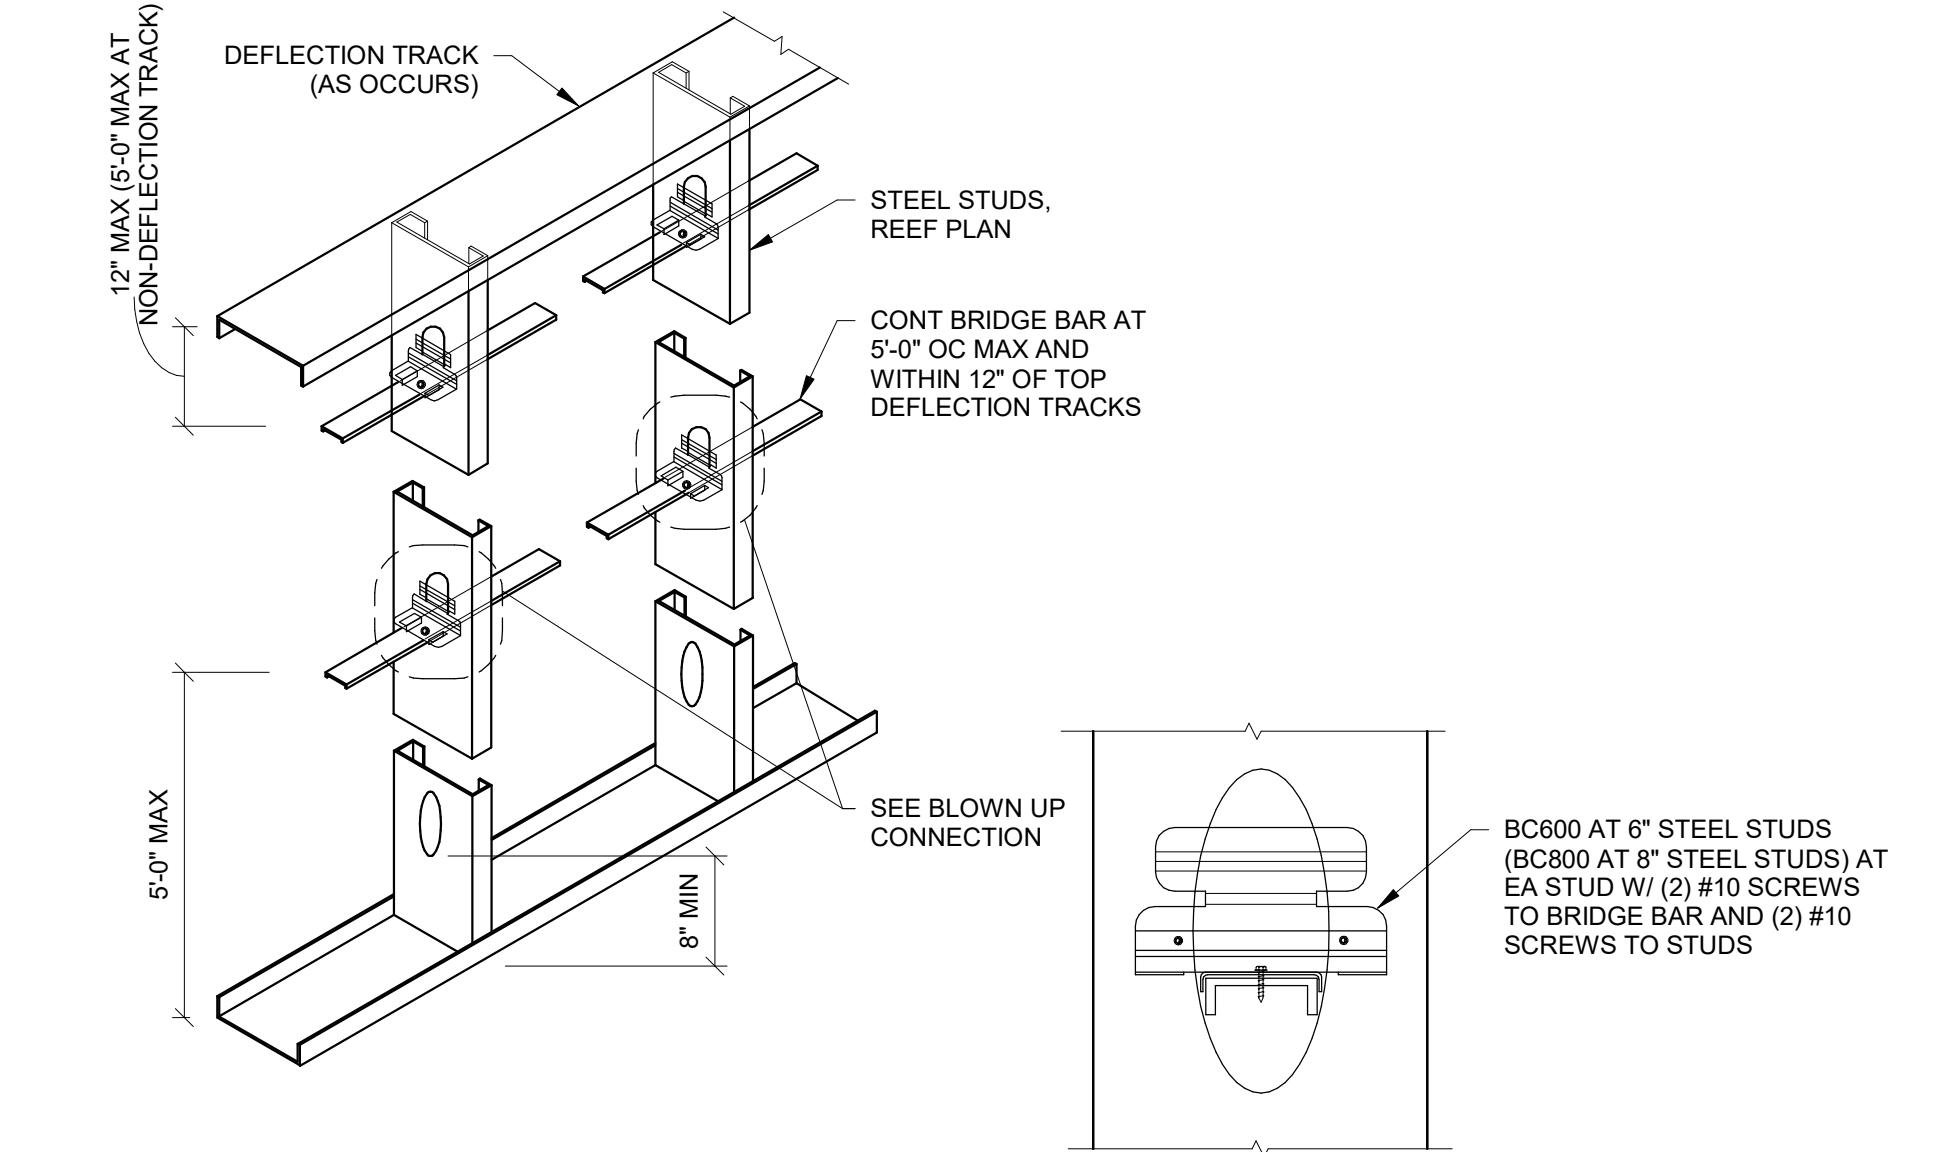

1 STEEL STUD WALL BRIDGING
1" = 1'-0"

5 WALL FRAMING AT CORNERS AND INTERSECTIONS
1" = 1'-0"

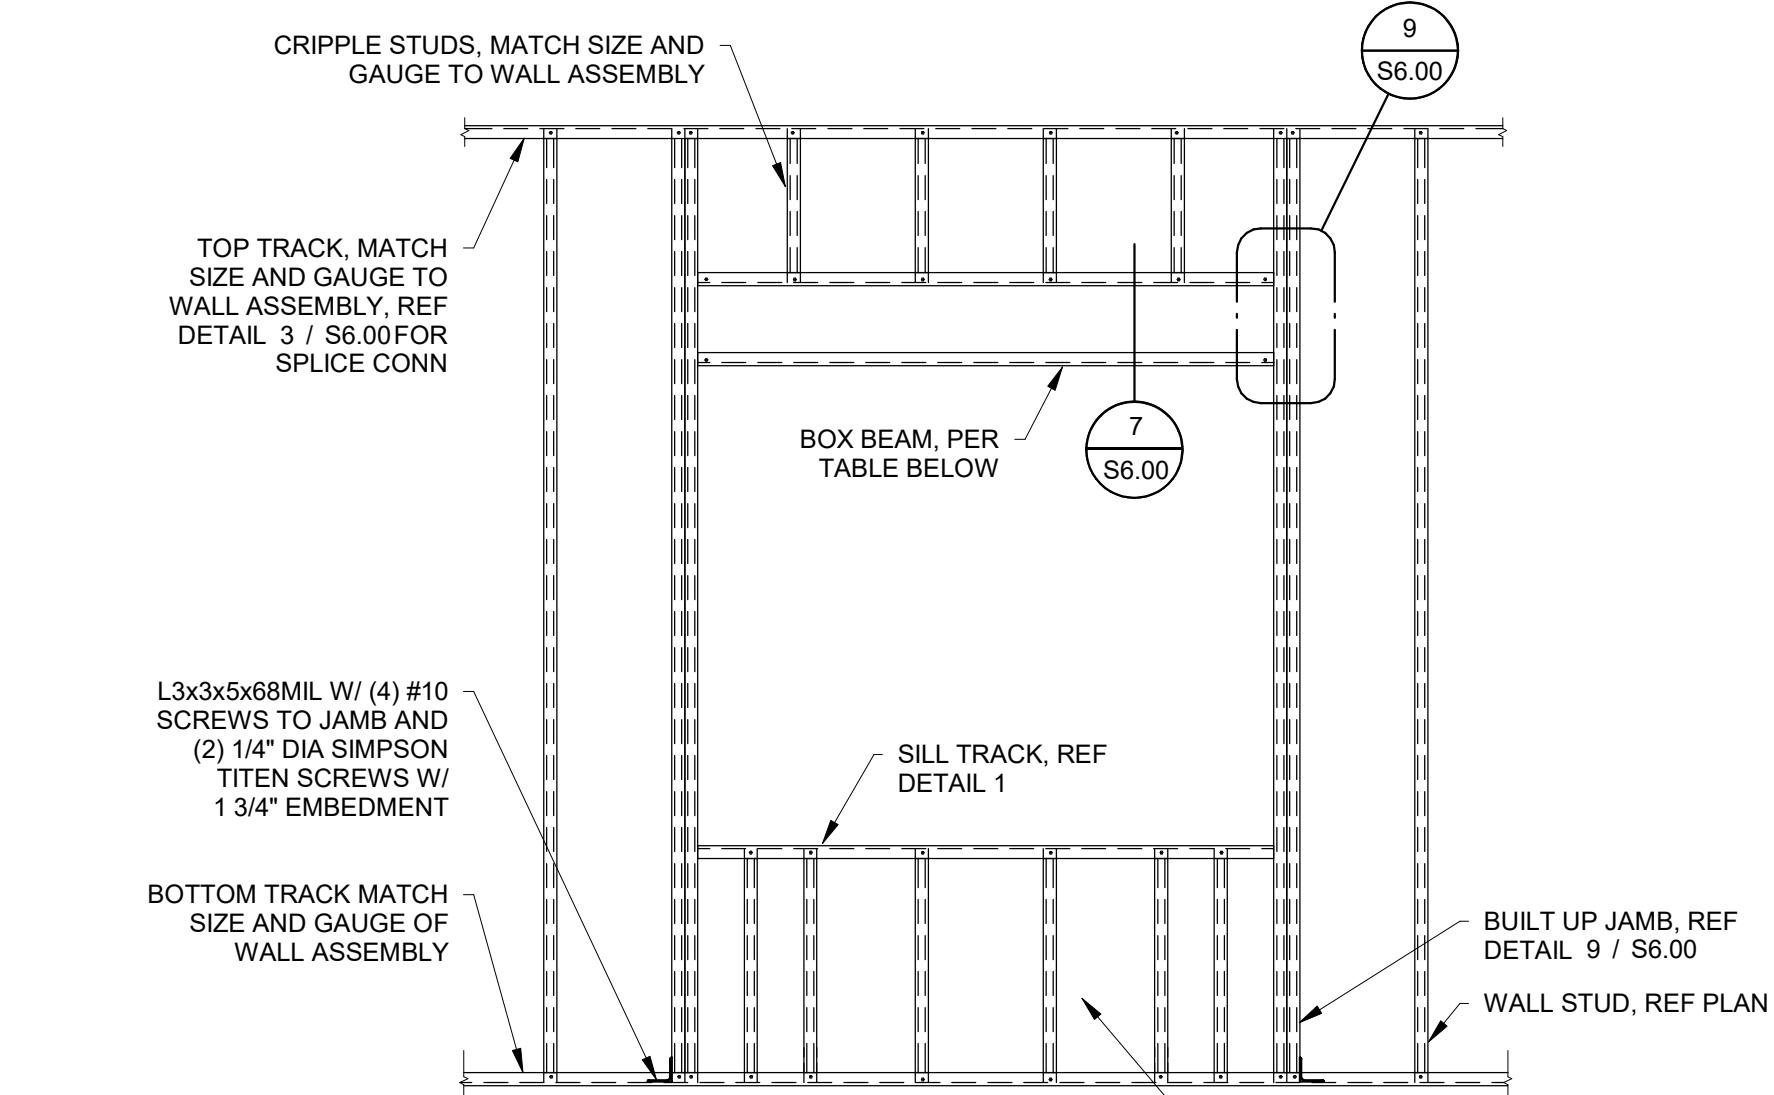


BOX BEAM HEADER SCHEDULE					
OPENING WIDTH	5 1/2" WIDE BOXED HEADER SIZE	3 5/8" WIDE BOXED HEADER SIZE	JAMB STUD	FASTENERS	SILL
0 TO 5'-0"	(2) 600S162-33 (2) 550T150-33 REF 7 / \$6.00	(2) 600S162-33 (2) 362T150-33 REF 7 / \$6.00	(2) 550S162-43 REF 9 / \$6.00 (USE (2) 362S200-54 STUDS AT 4" NOM WALLS)	(2) #10 SCREWS TO EACH JAMB STUD (8) TOTAL SCREWS AT EACH END OF HEADER)	550T125-43
5'-1" TO 10'-0"	(2) 800S162-43 (2) 550T150-43 REF 7 / \$6.00	(2) 800S162-43 (2) 362T150-43 REF 9 / \$6.00 (USE (2) 362S200-54 STUDS AT 4" NOM WALLS)	(2) 550S162-43 REF 9 / \$6.00 (3) #10 SCREWS TO EACH JAMB STUD (12) TOTAL SCREWS AT EACH END OF HEADER)	(3) #10 SCREWS TO EACH JAMB STUD (12) TOTAL SCREWS AT EACH END OF HEADER)	550T125-43
10'-1" TO 15'-0"	(2) 1000S162-43 (2) 550T150-43 REF 7 / \$6.00	(2) 1000S162-43 (2) 362T150-43 REF 9 / \$6.00 (USE (2) 362S200-54 STUDS AT 4" NOM WALLS)	(2) 550S200-54 REF 9 / \$6.00 (4) #10 SCREWS TO EACH JAMB STUD (16) TOTAL SCREWS AT EACH END OF HEADER)	(4) #10 SCREWS TO EACH JAMB STUD (16) TOTAL SCREWS AT EACH END OF HEADER)	550T150-54


NOTES:
1. REFER TO STUD WALL SCHEDULE FOR STUD SIZES, SPACING AND GAUGES.
2. REFERENCE DETAILS FOR TYPICAL CONNECTIONS.

6 STEEL FRAMING AT WALL OPENING
1/2" = 1'-0"


NOTES:
FOR HEADER SUPPORT AT
JAMBS REF DETAIL 6 / \$6.00 AND
9 / \$6.00 AND HEADER SCHEDULE

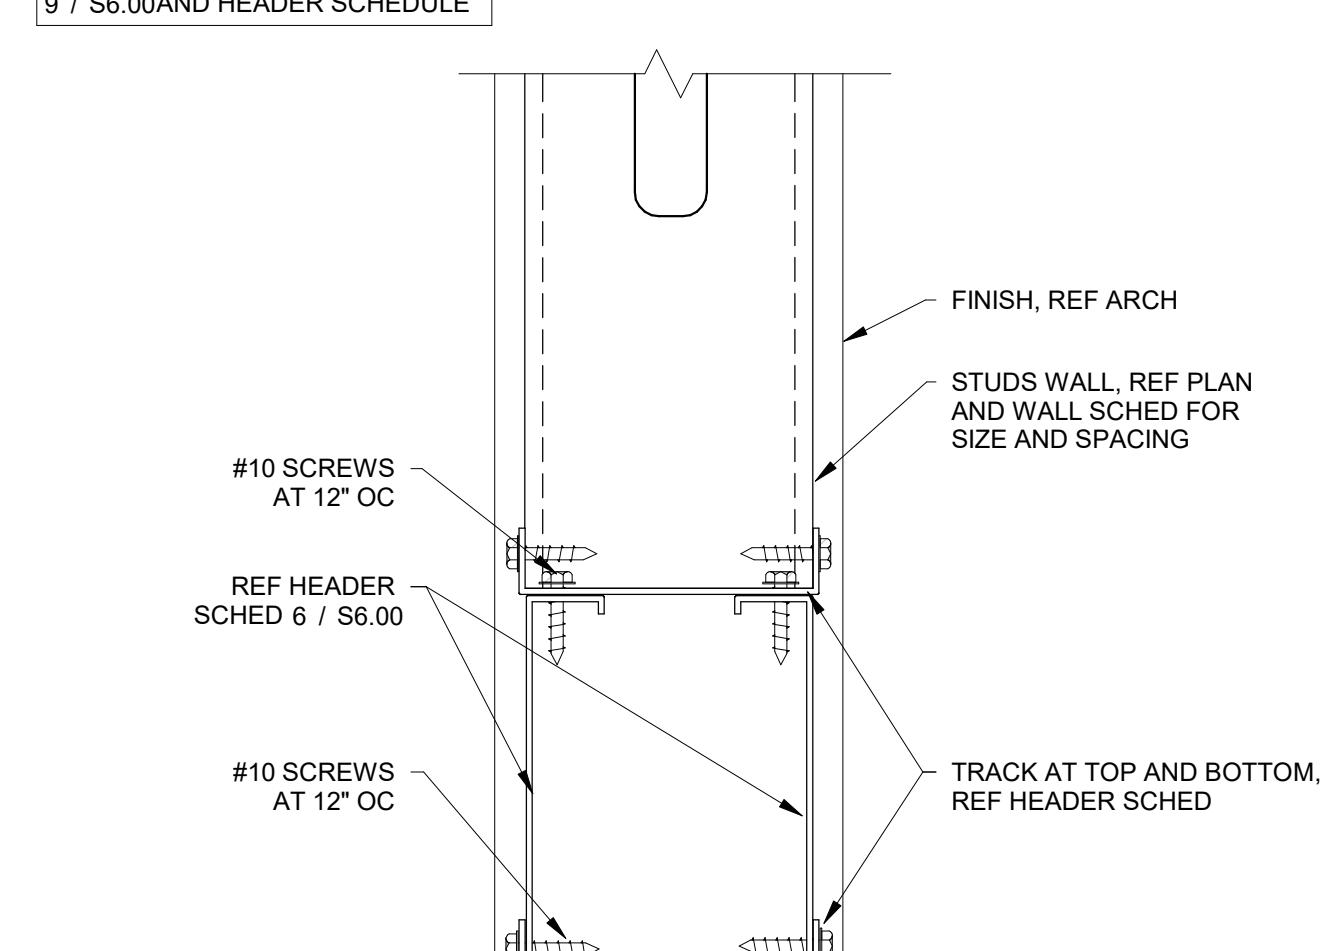


7 BOX HEADER DETAIL
3" = 1'-0"

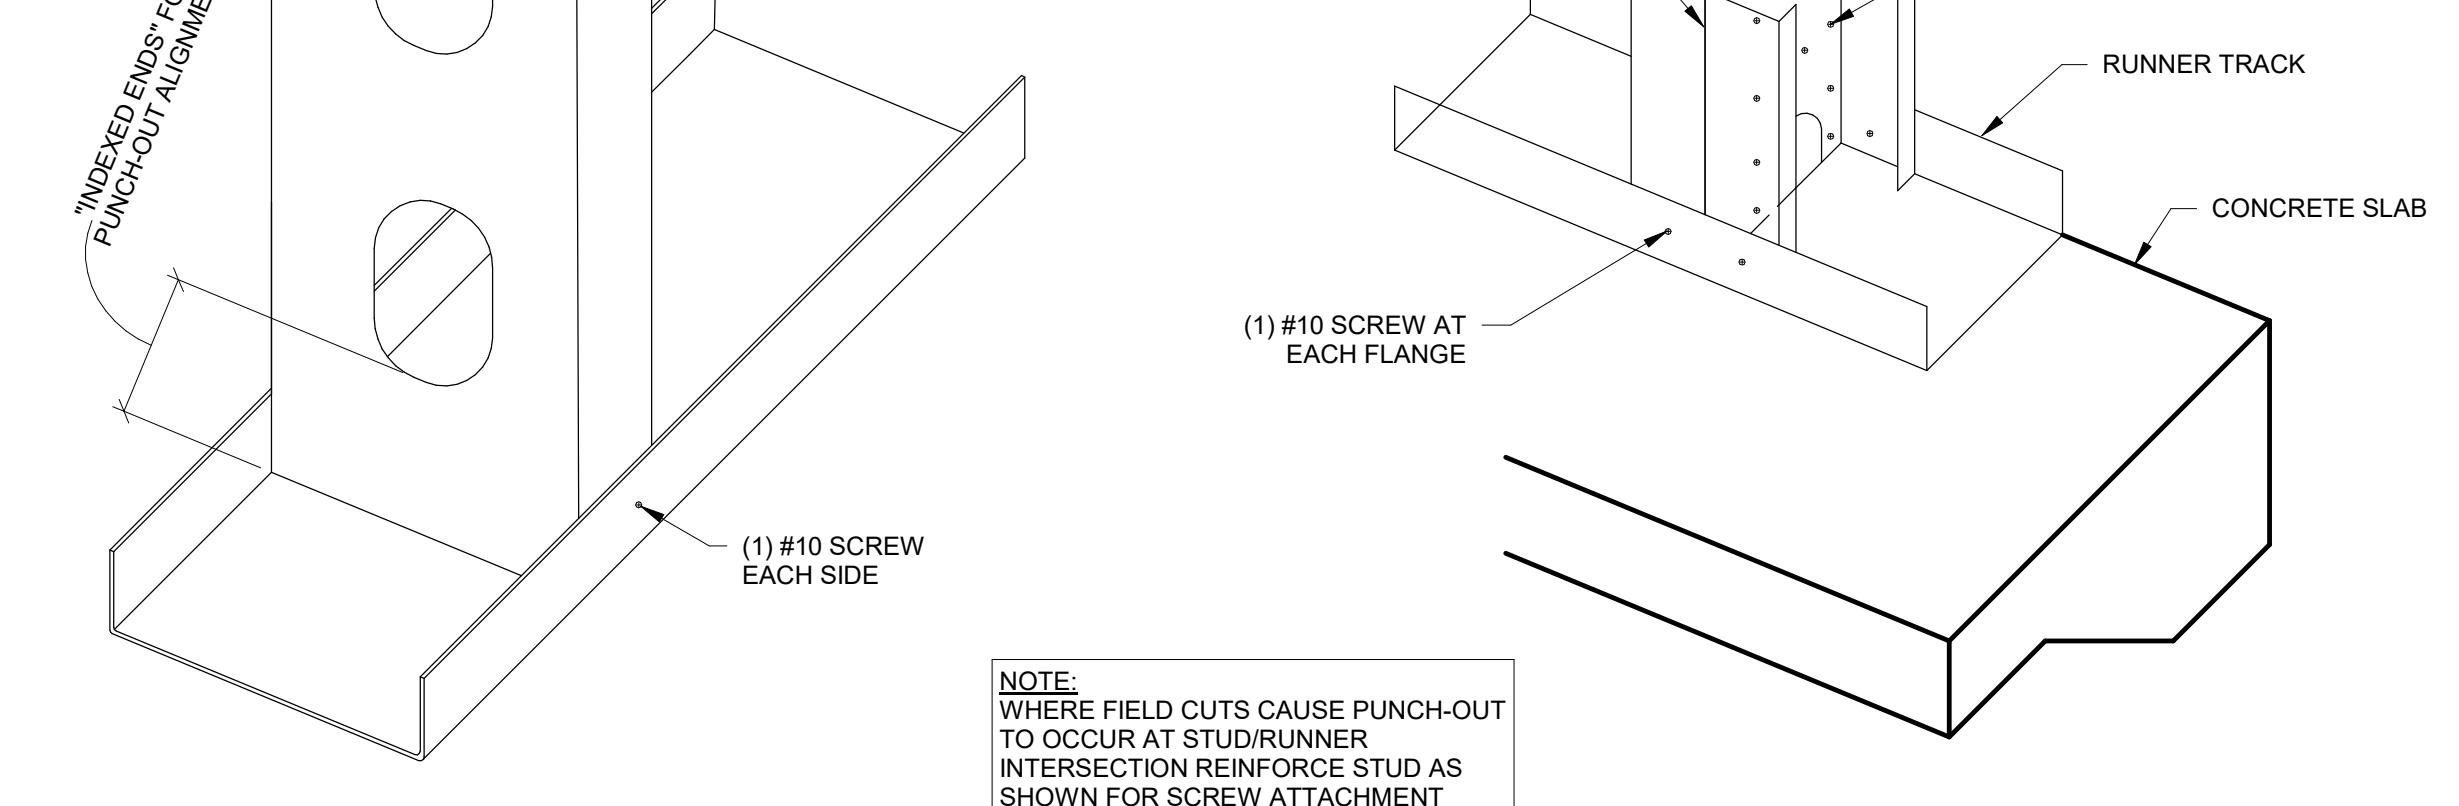

2 STUD TO TRACK ATTACHMENT
1" = 1'-0"


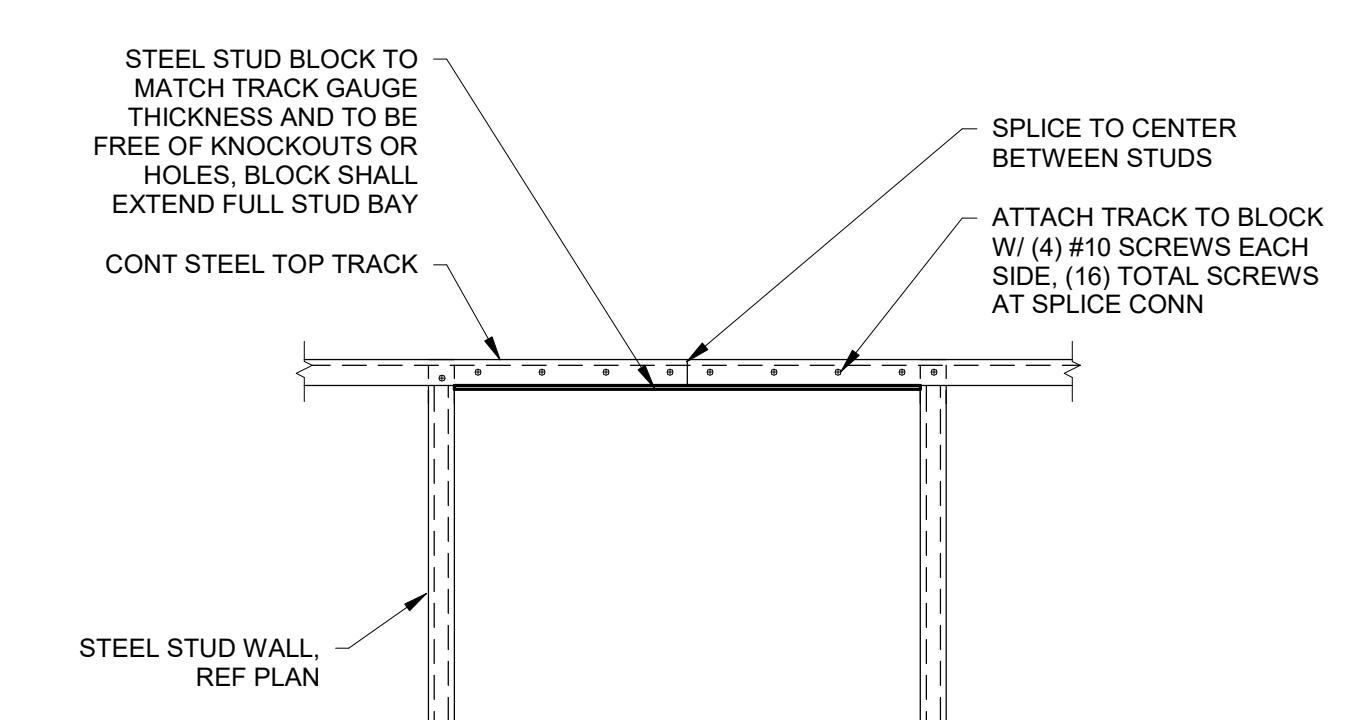


3 TOP TRACK SPLICE
1" = 1'-0"

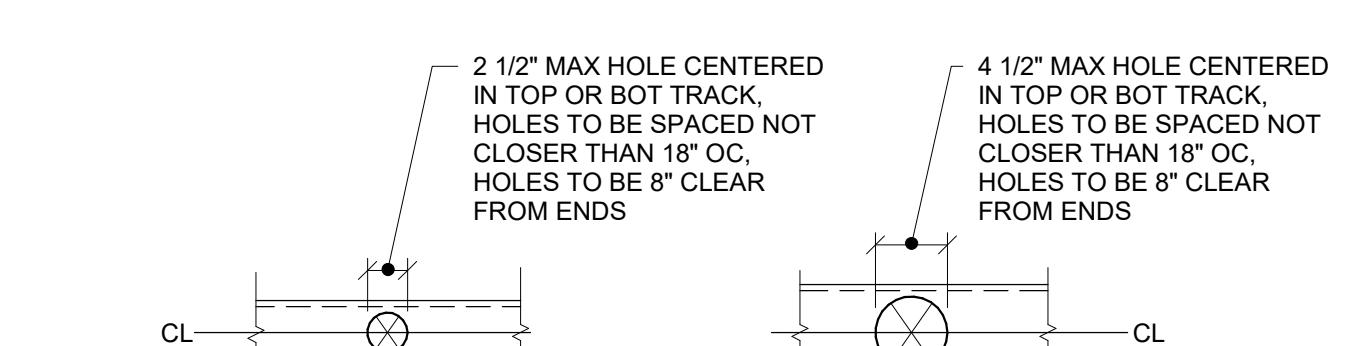


4" STEEL TOP AND
BOT WALL TRACKS 6" STEEL TOP AND
BOT WALL TRACKS


4 ALLOWABLE HOLES THRU STEEL TOP AND BOTTOM TRACK
1" = 1'-0"

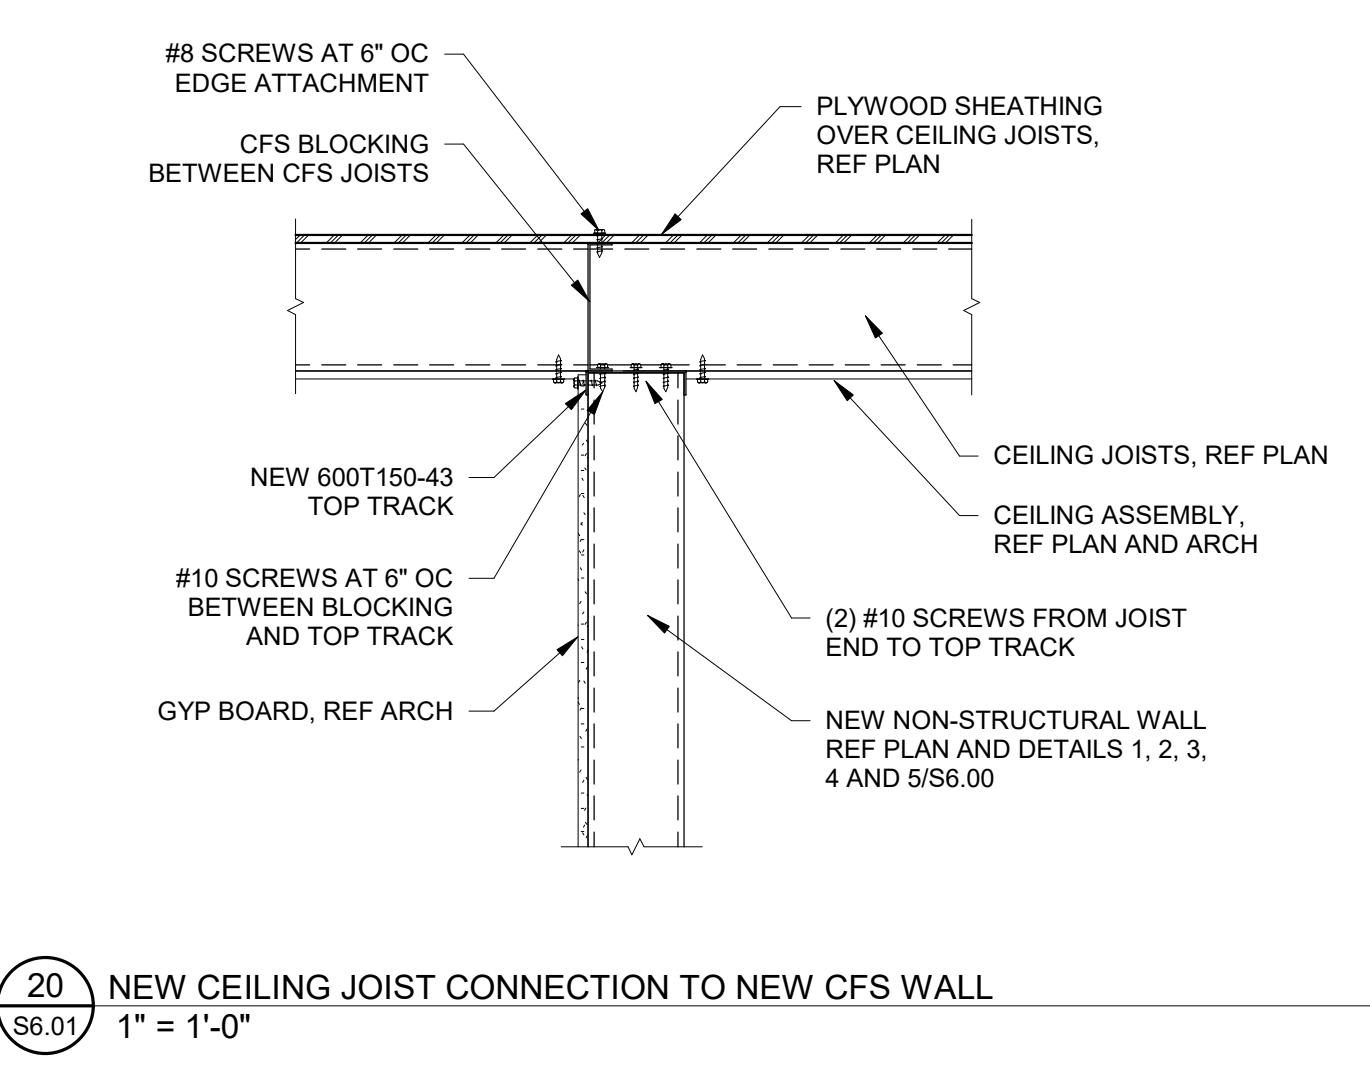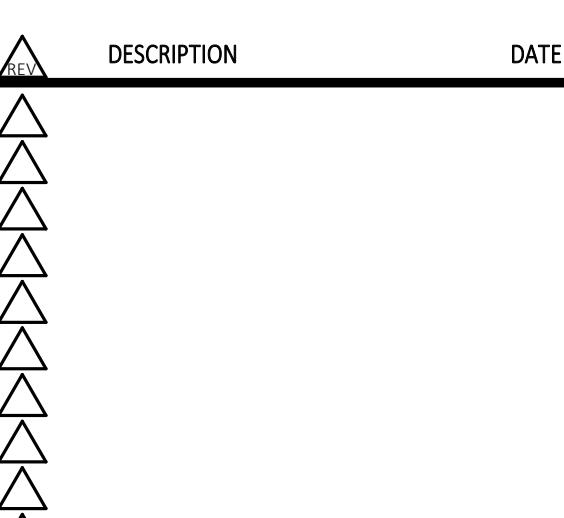


20 NEW CEILING JOIST CONNECTION TO NEW CFS WALL
S6.01 1" = 1'-0"

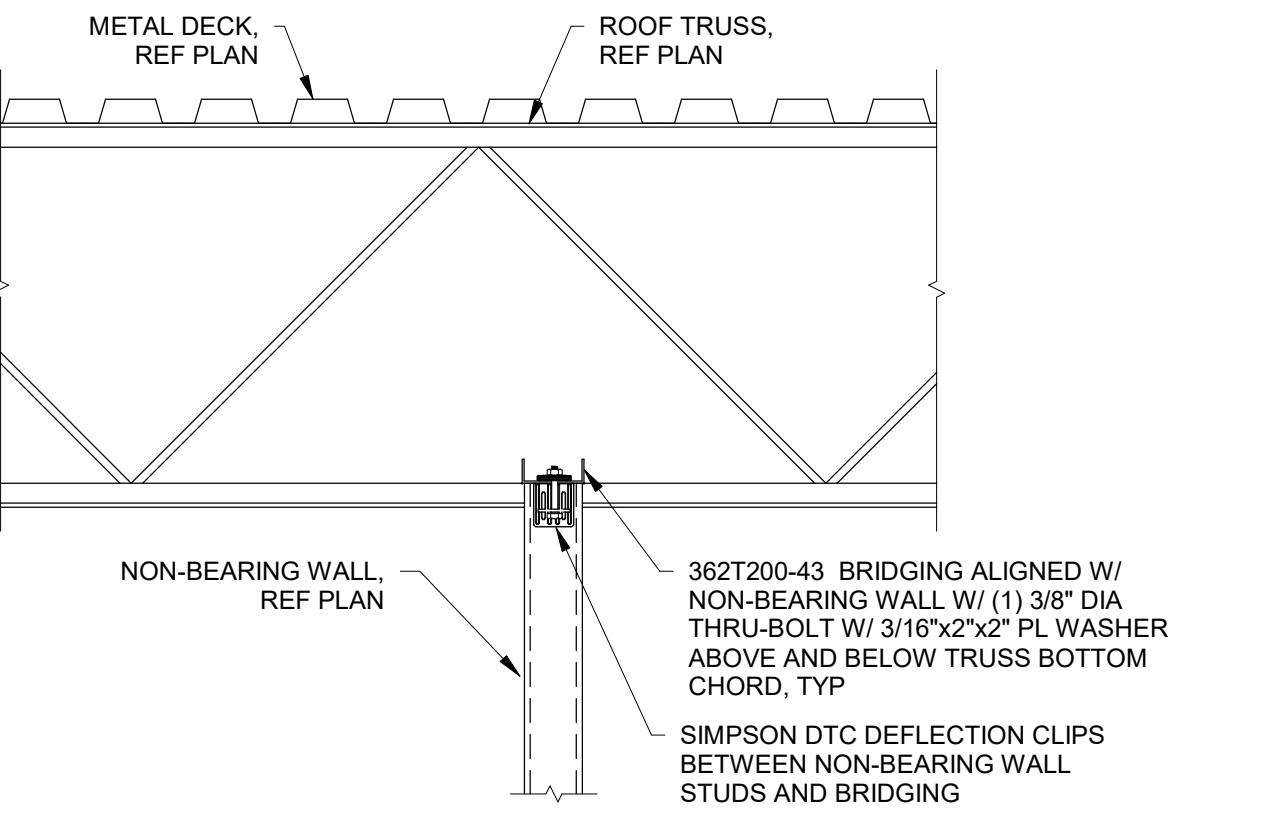


15 NON-BEARING WALL CONNECTION AT TOP
S6.01 1" = 1'-0"

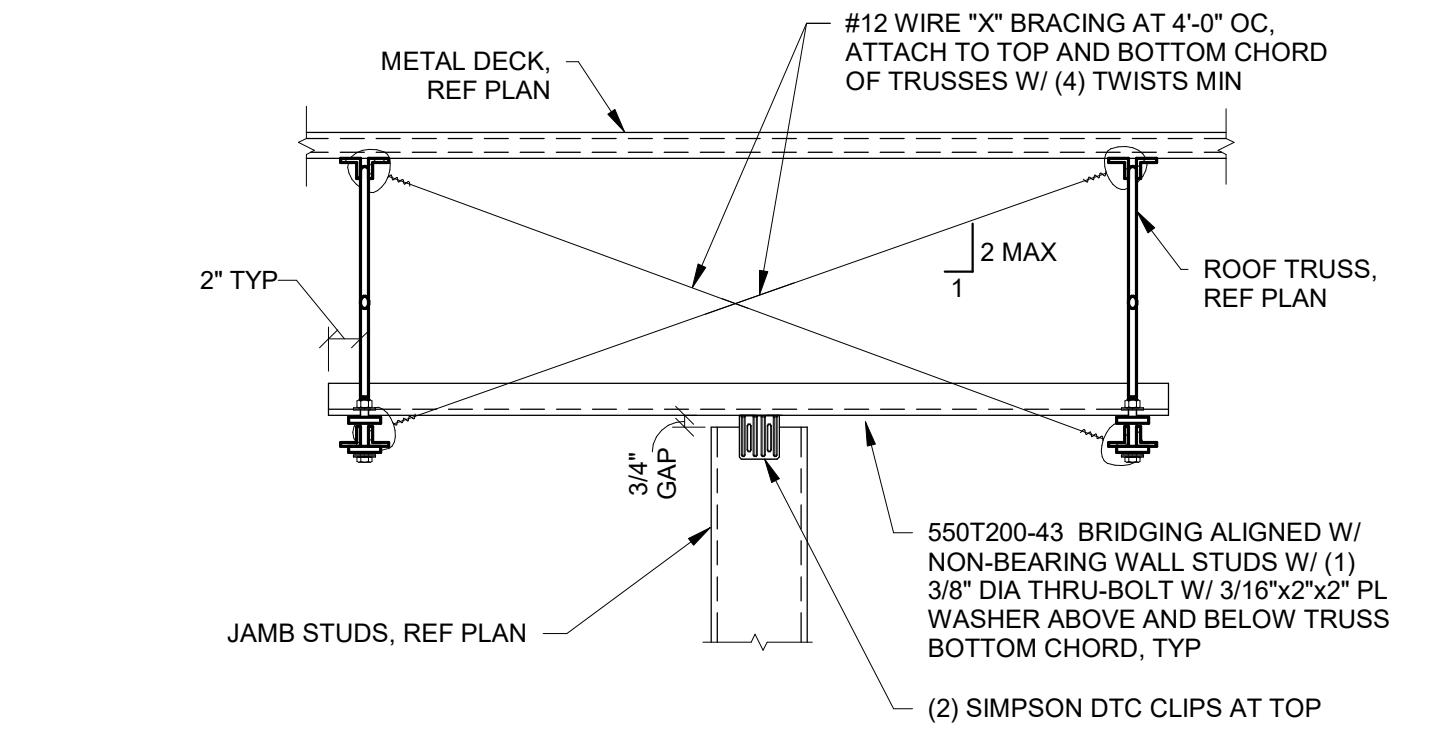


10 JAMB STUDS CONNECTION AT TOP
S6.01 1" = 1'-0"

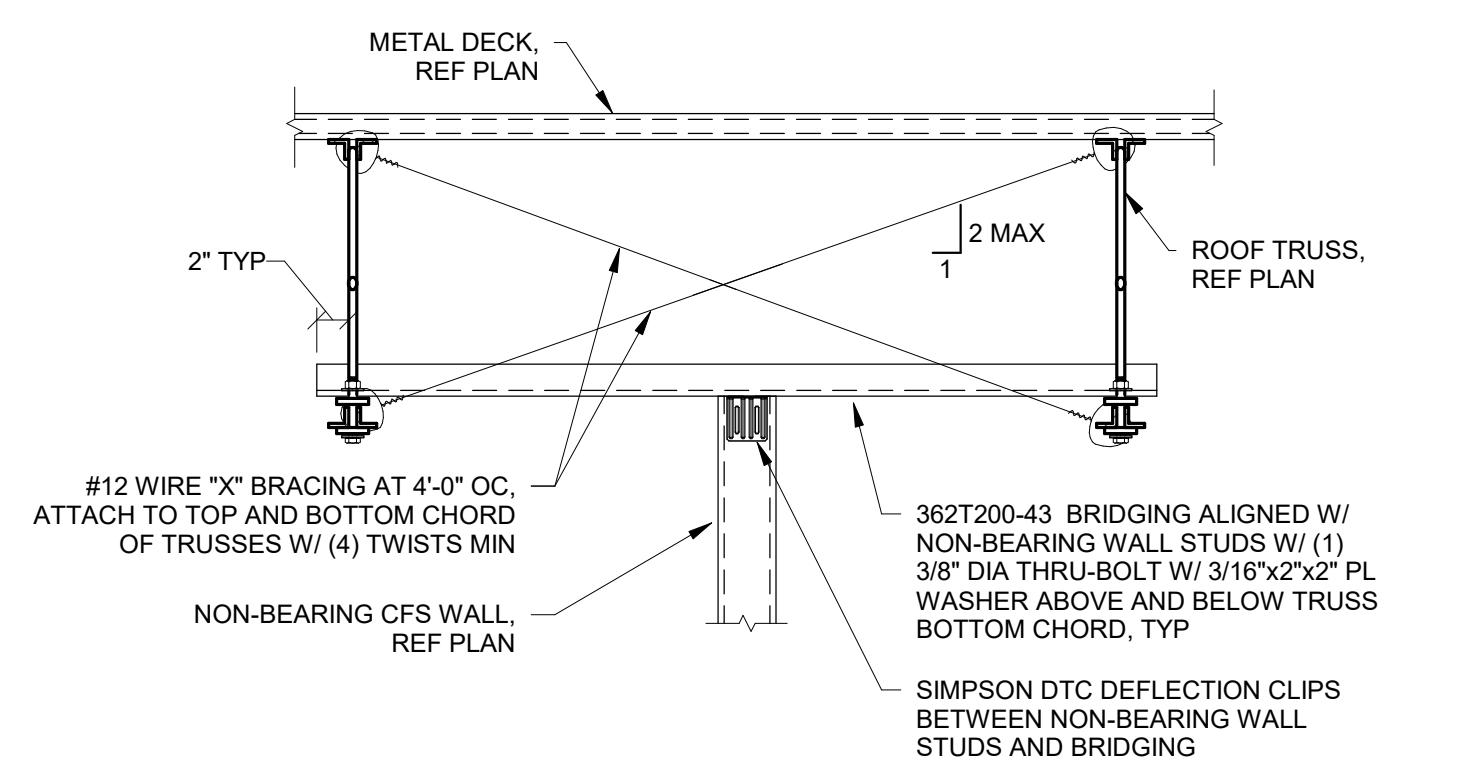


16 NON-BEARING WALL CONNECTION AT TOP
S6.01 1" = 1'-0"

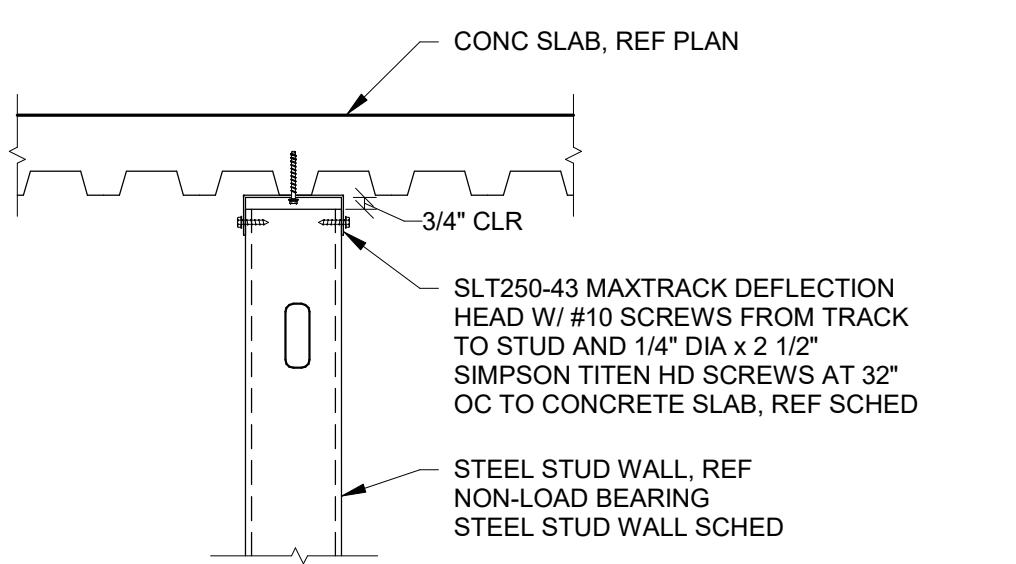


11 NON-BEARING WALL CONNECTION AT TOP TO CONCRETE SLAB
S6.01 1" = 1'-0"

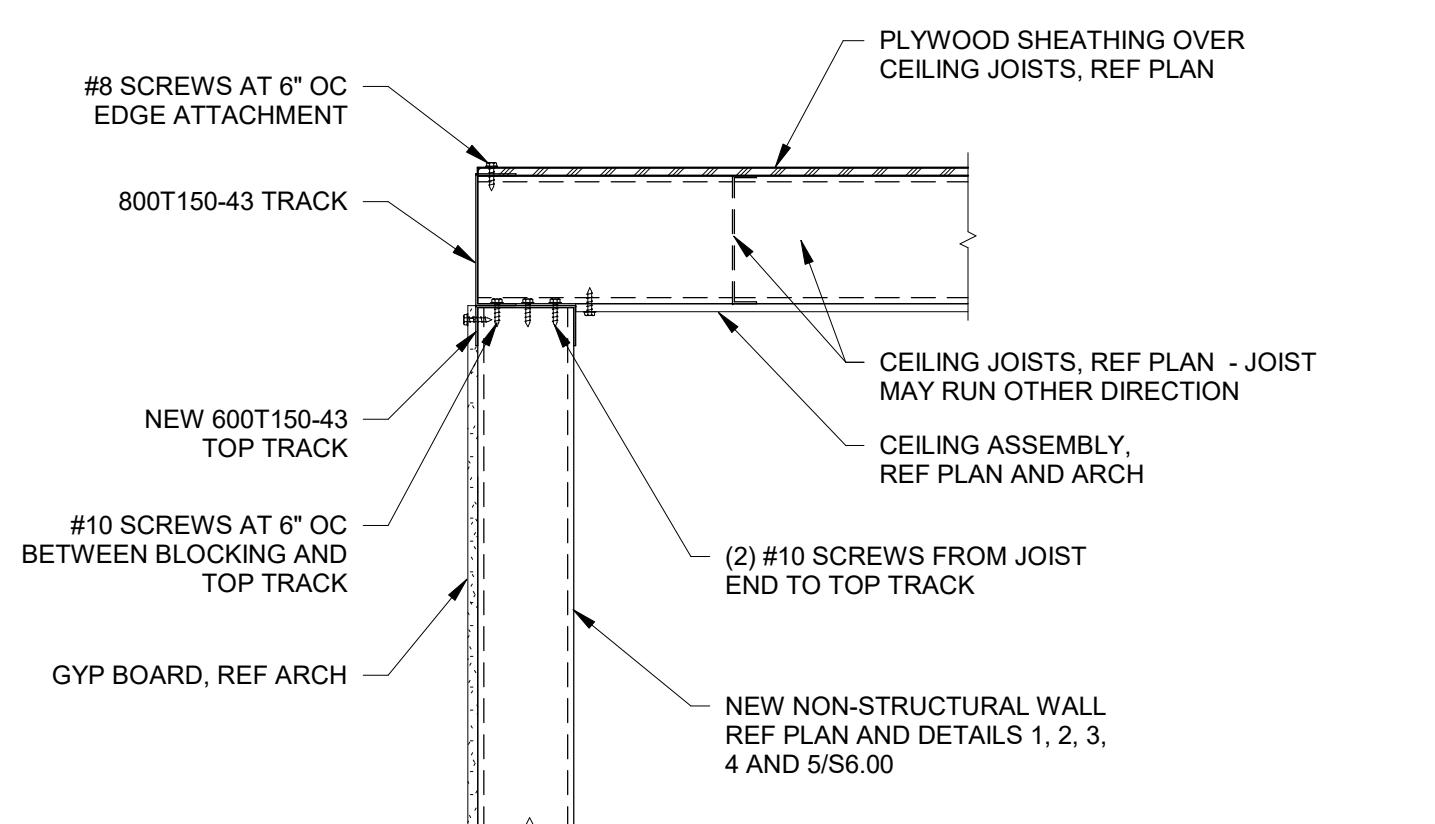


17 NEW CEILING JOIST CONNECTION TO NEW CFS WALL
S6.01 1" = 1'-0"

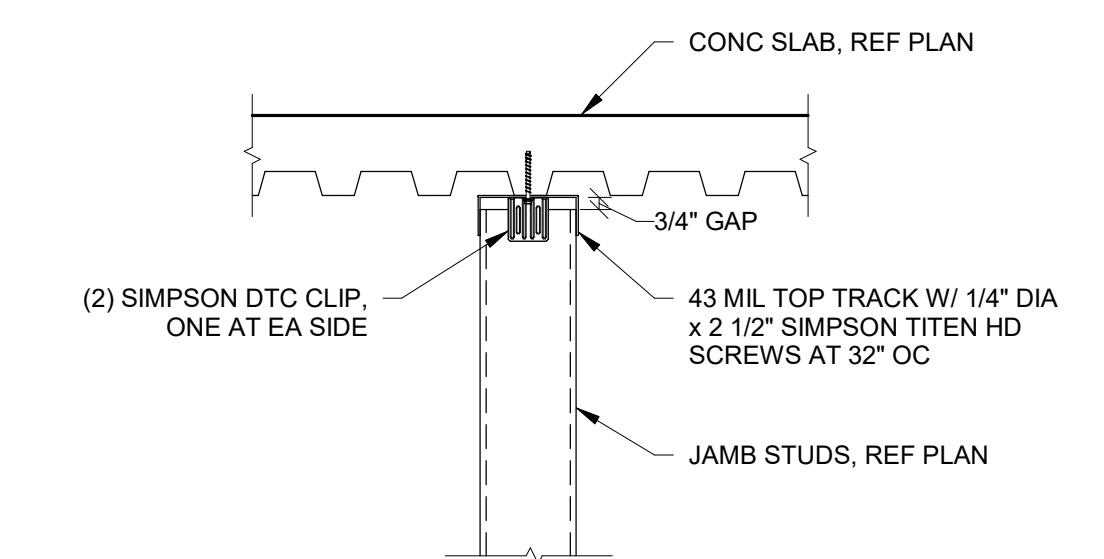


12 JAMB STUD CONNECTION AT TOP TO CONCRETE SLAB
S6.01 1" = 1'-0"

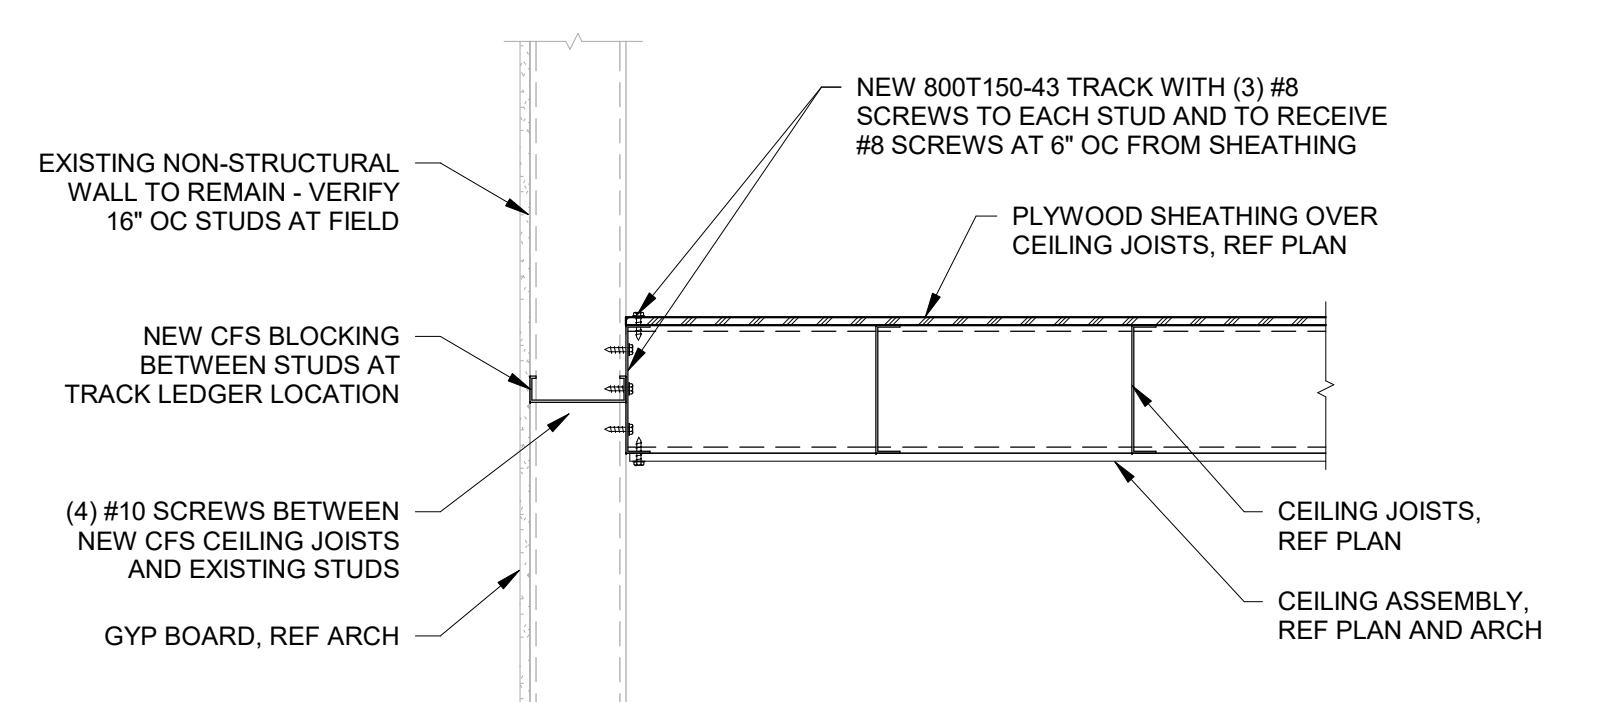


18 NEW CEILING JOIST CONNECTION TO NEW CFS WALL
S6.01 1" = 1'-0"

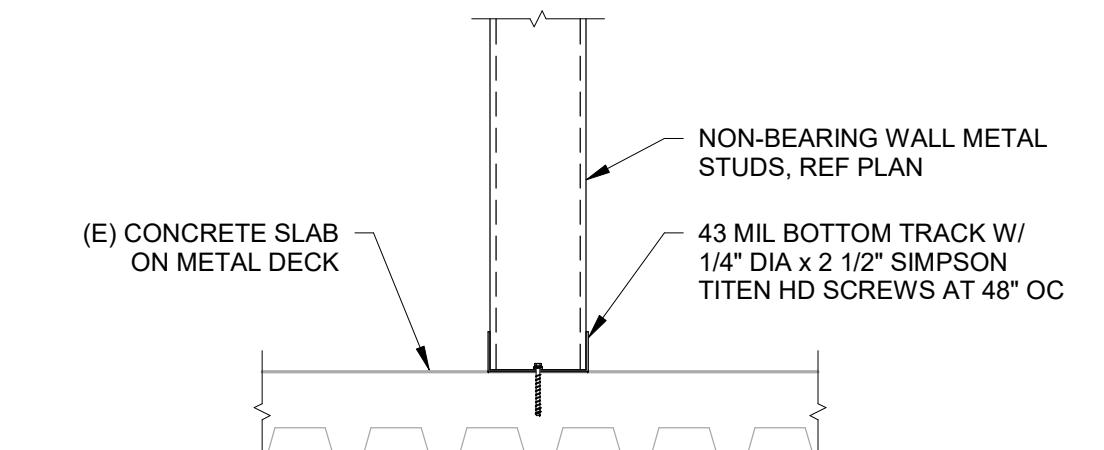





13 NON-BEARING WALL CONNECTION AT BOTTOM TO CONCRETE SLAB
S6.01 1" = 1'-0"

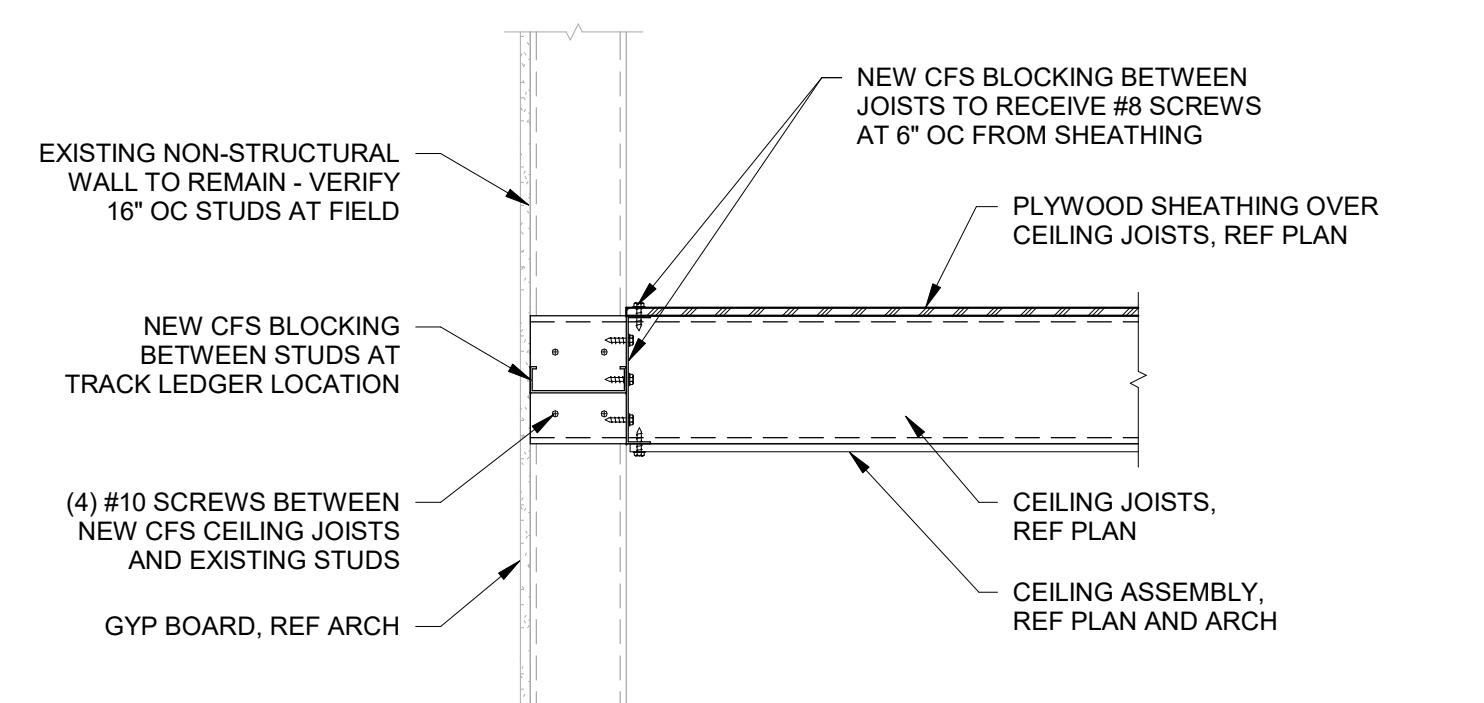

19 NEW CEILING JOIST CONNECTION TO NEW CFS WALL
S6.01 1" = 1'-0"

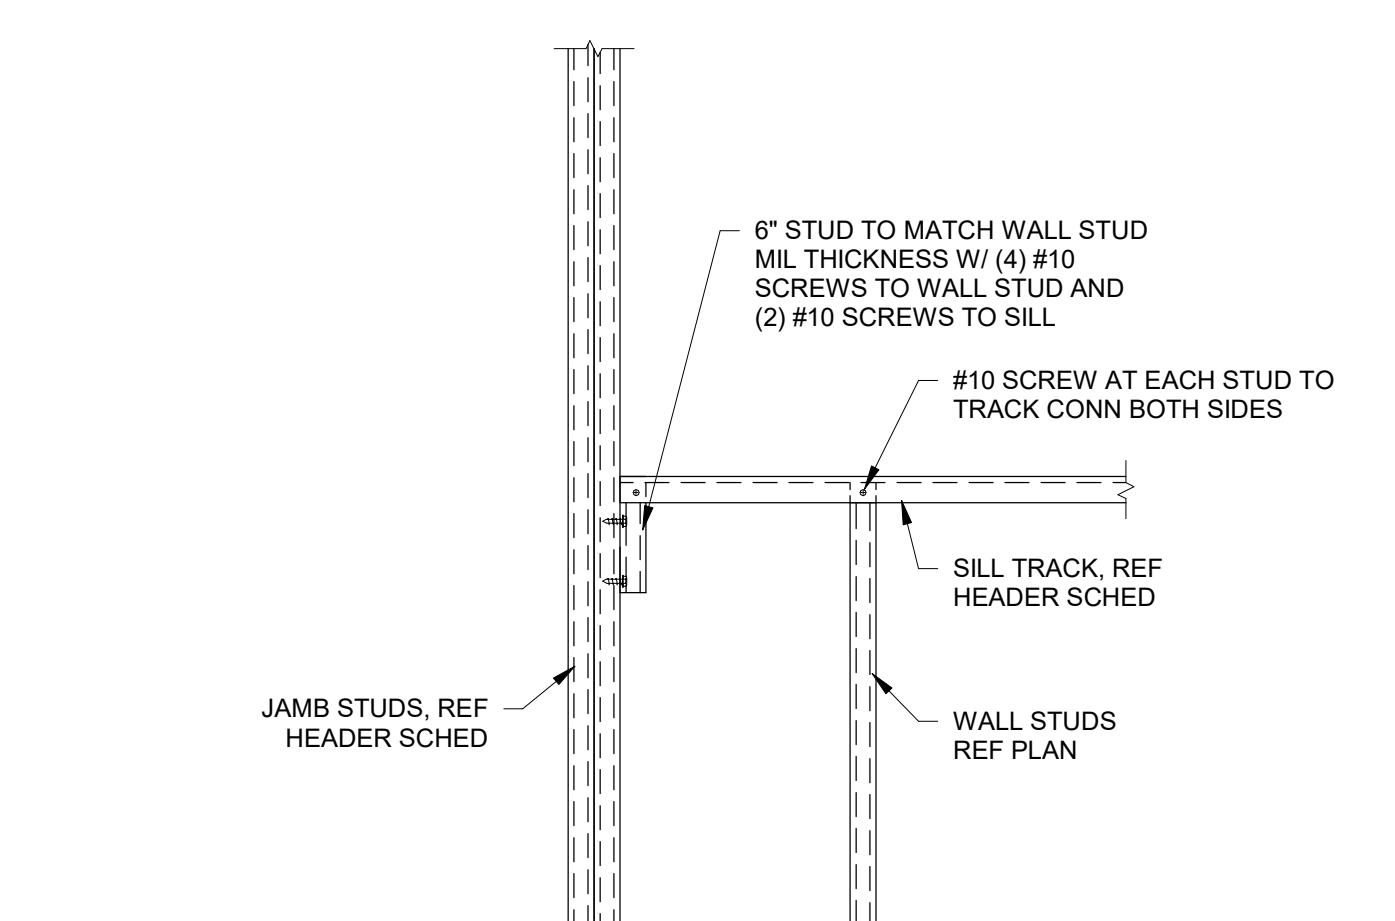

14 WINDOW SILL TO JAMB STUD
S6.01 1" = 1'-0"

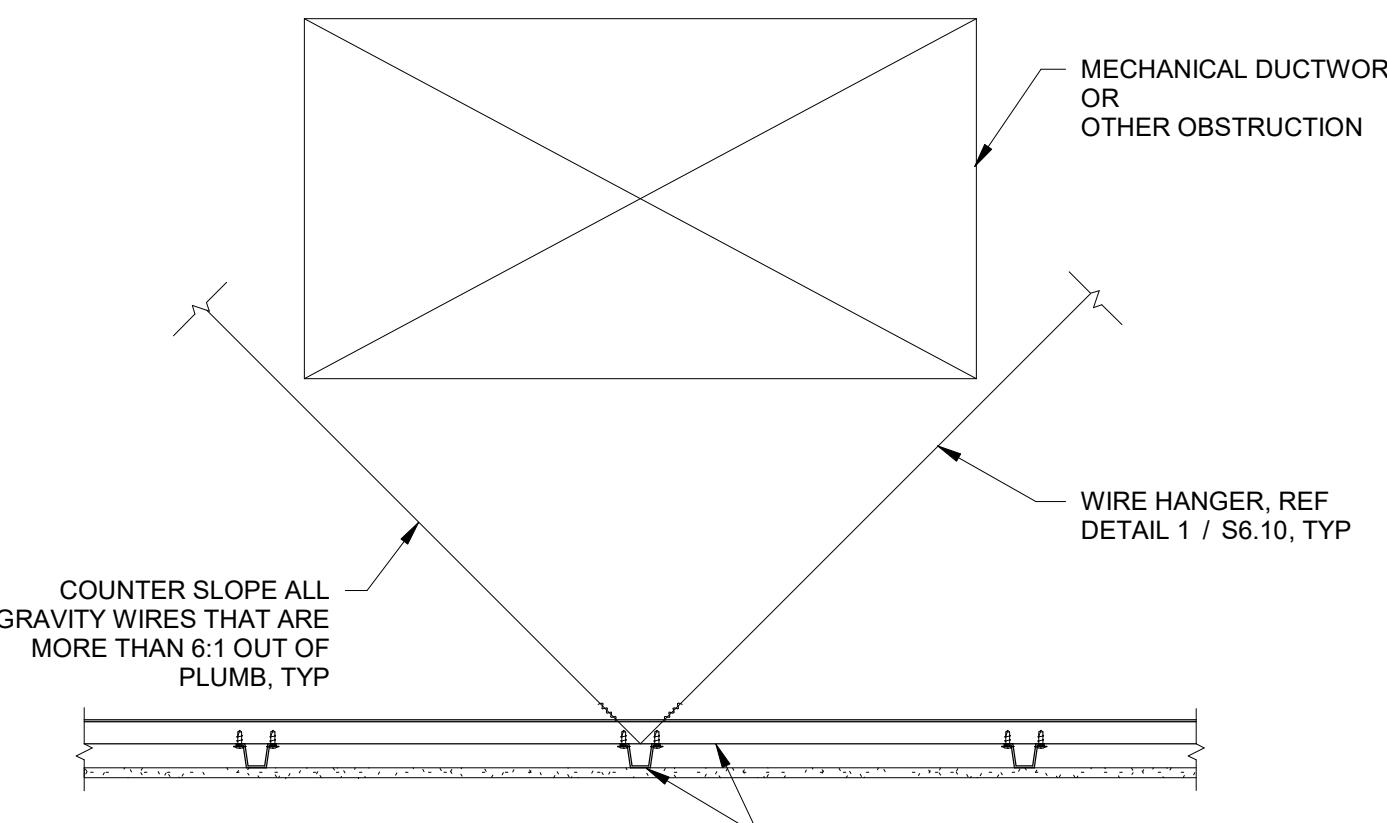
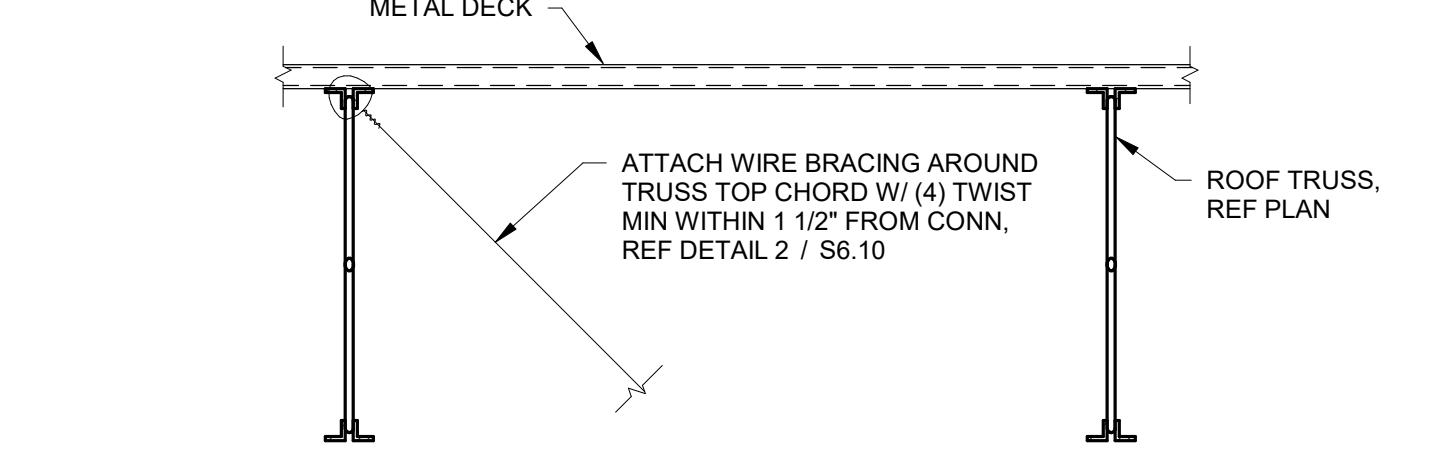
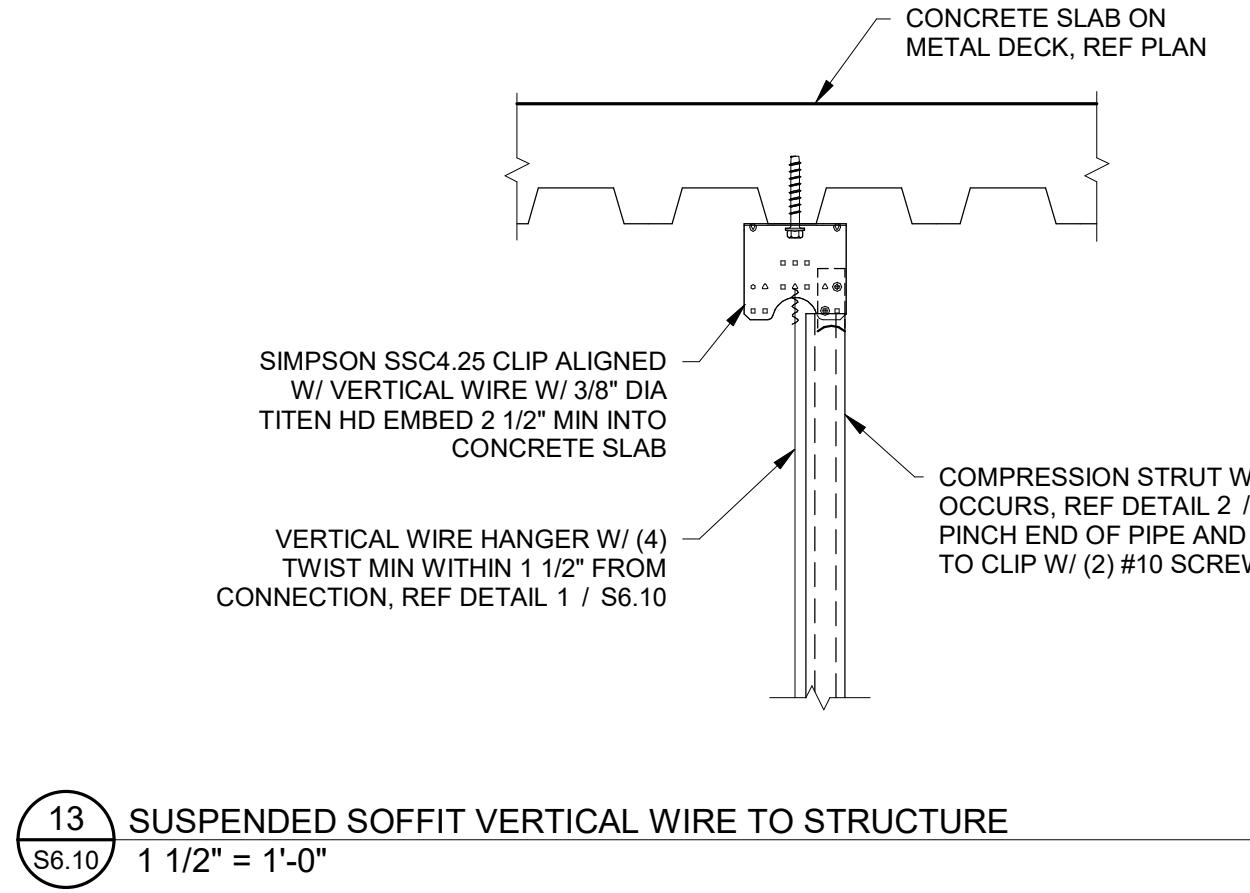
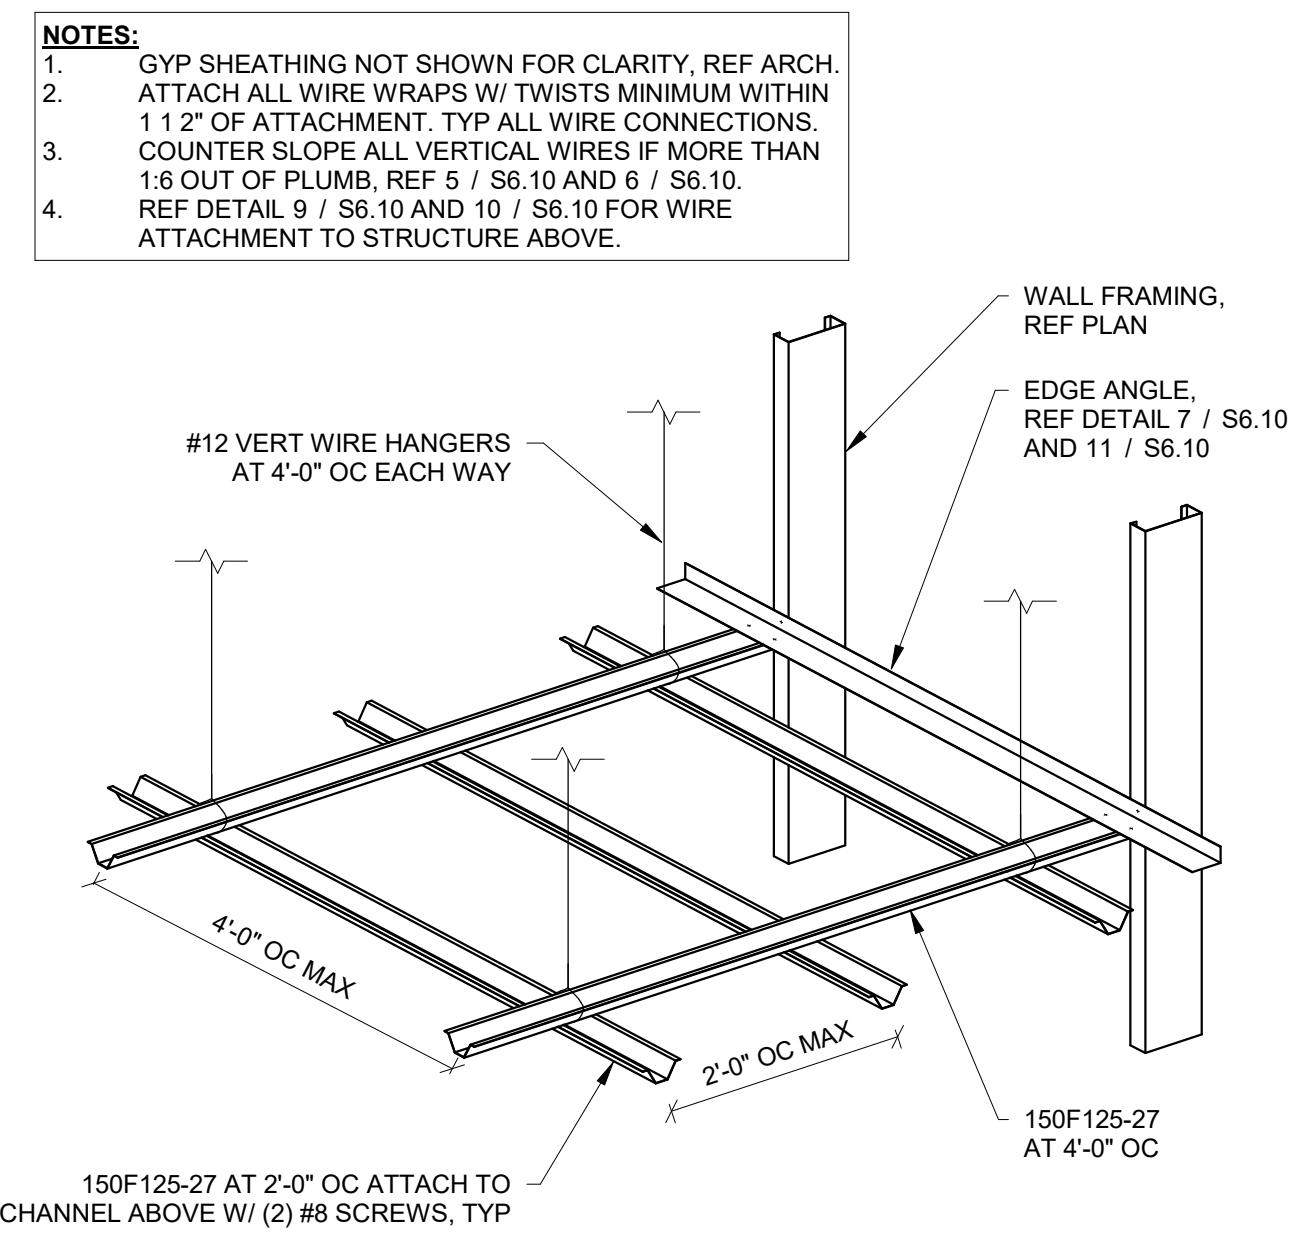


13 SUSPENDED SOFFIT VERTICAL WIRE TO STRUCTURE
S6.10 1 1/2" = 1'-0"

9 SUSPENDED SOFFIT WIRE BRACING TO STRUCTURE
S6.10 1" = 1'-0"

5 SUSPENDED SOFFIT VERTICAL WIRE HANGER OBSTRUCTION
S6.10 1" = 1'-0"

1 SUSPENDED SOFFIT FRAMING TYP
S6.10 3/4" = 1'-0"

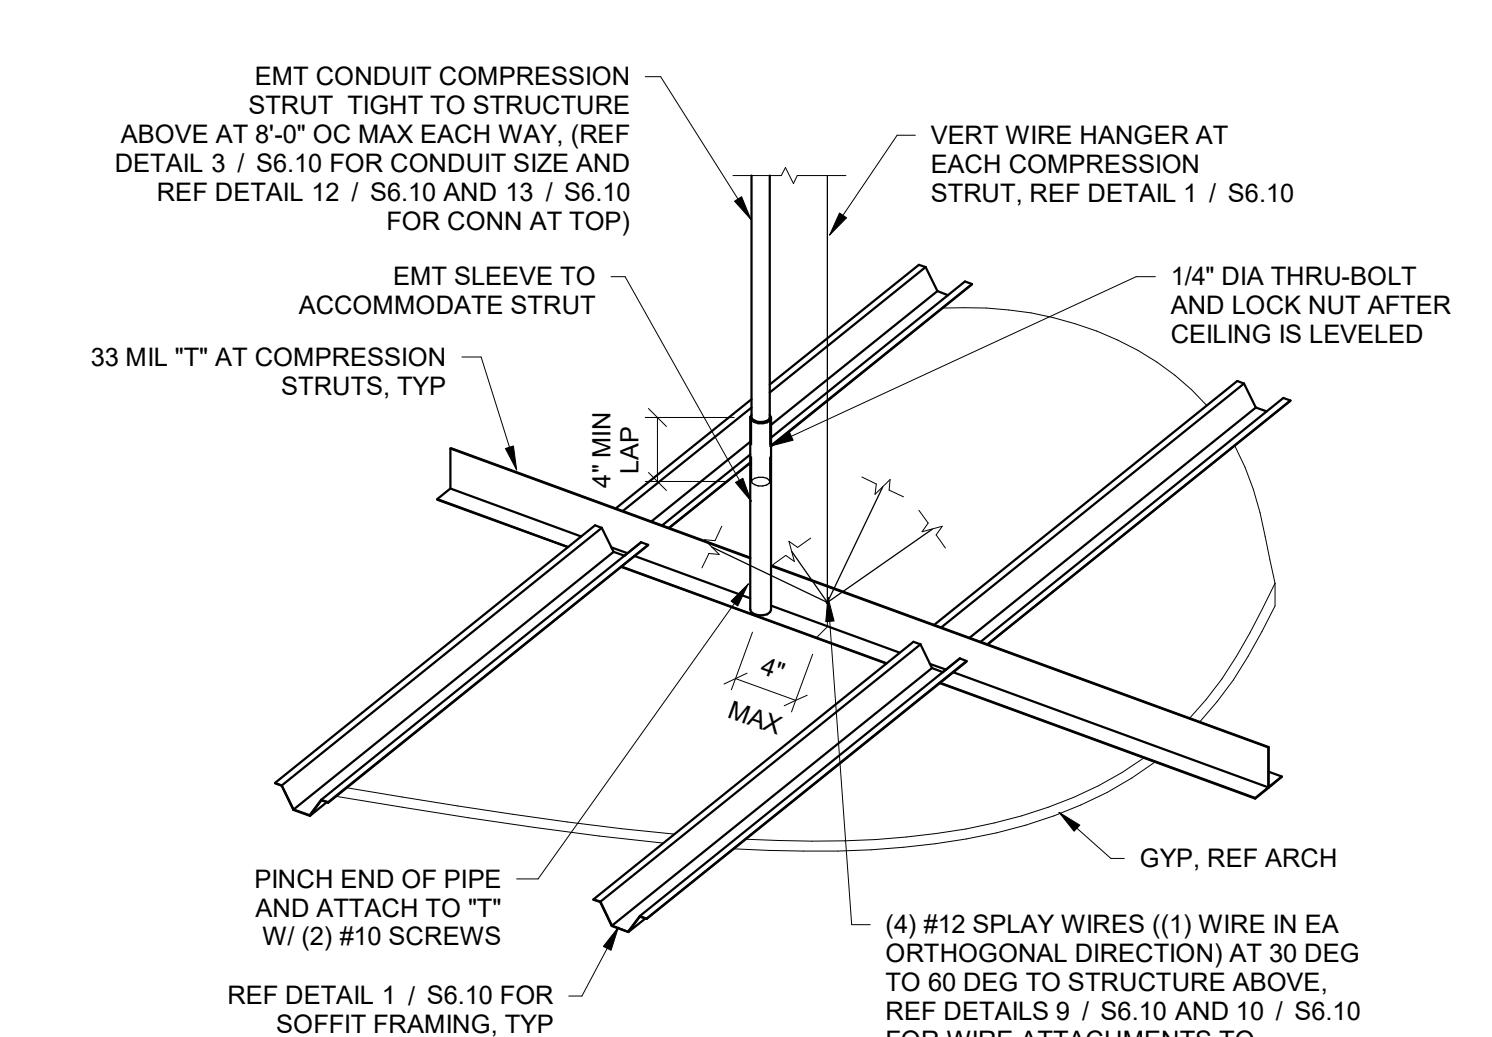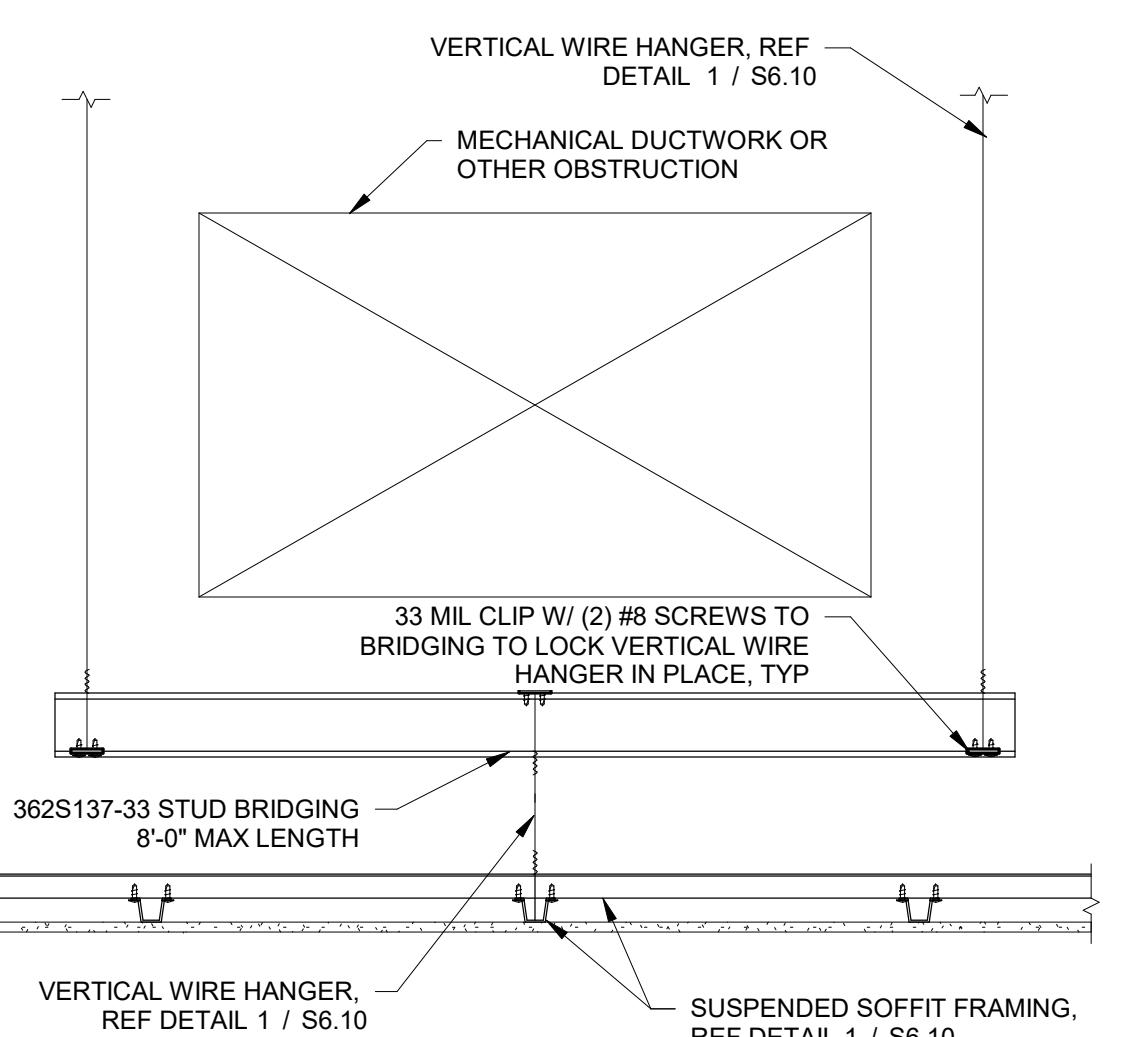
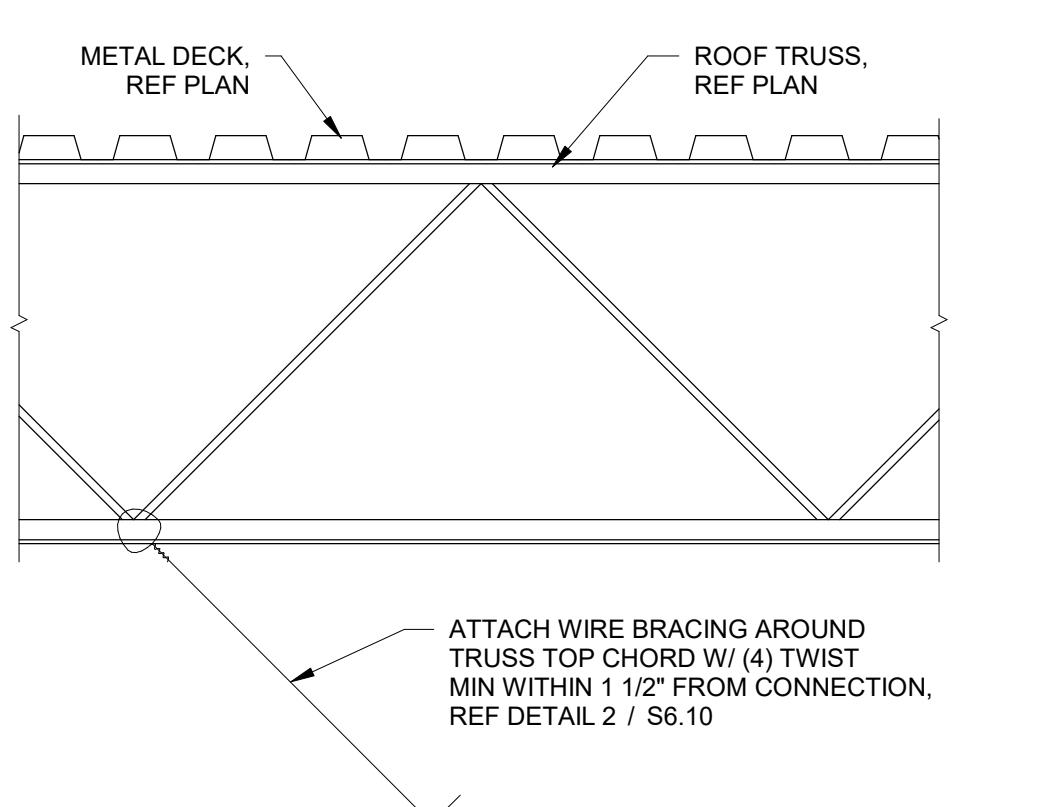
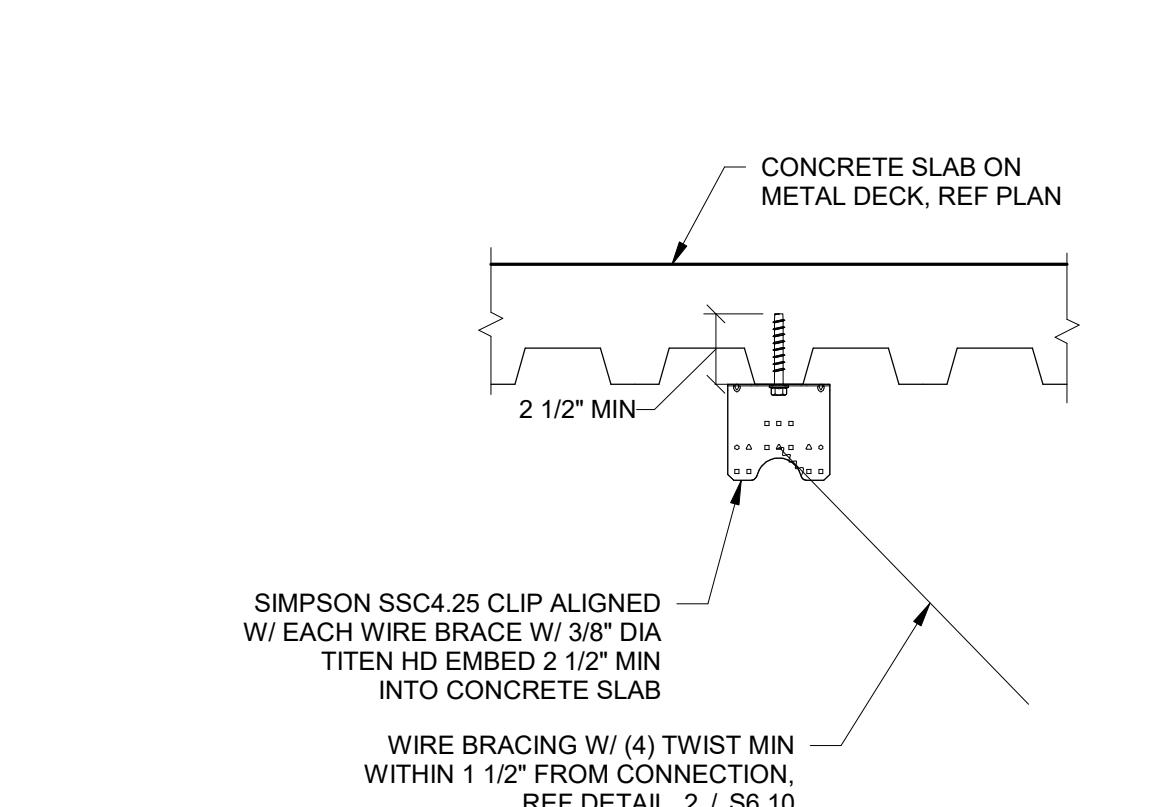


14 SUSPENDED SOFFIT WIRE BRACING TO STRUCTURE
S6.10 1 1/2" = 1'-0"

10 SUSPENDED SOFFIT WIRE BRACING TO STRUCTURE
S6.10 1" = 1'-0"

6 SUSPENDED SOFFIT VERTICAL WIRE HANGER OBSTRUCTION
S6.10 1" = 1'-0"

2 SUSPENDED SOFFIT LATERAL BRACING TYP.
S6.10 1" = 1'-0"

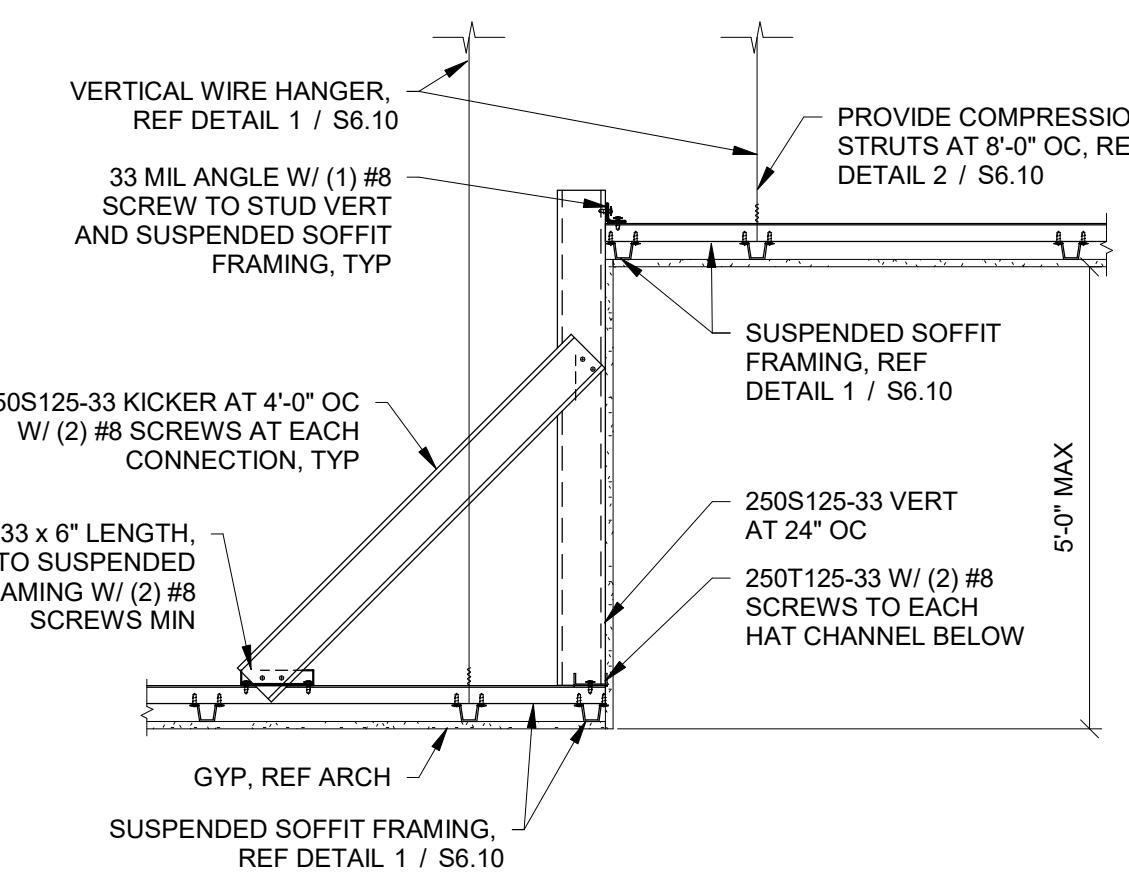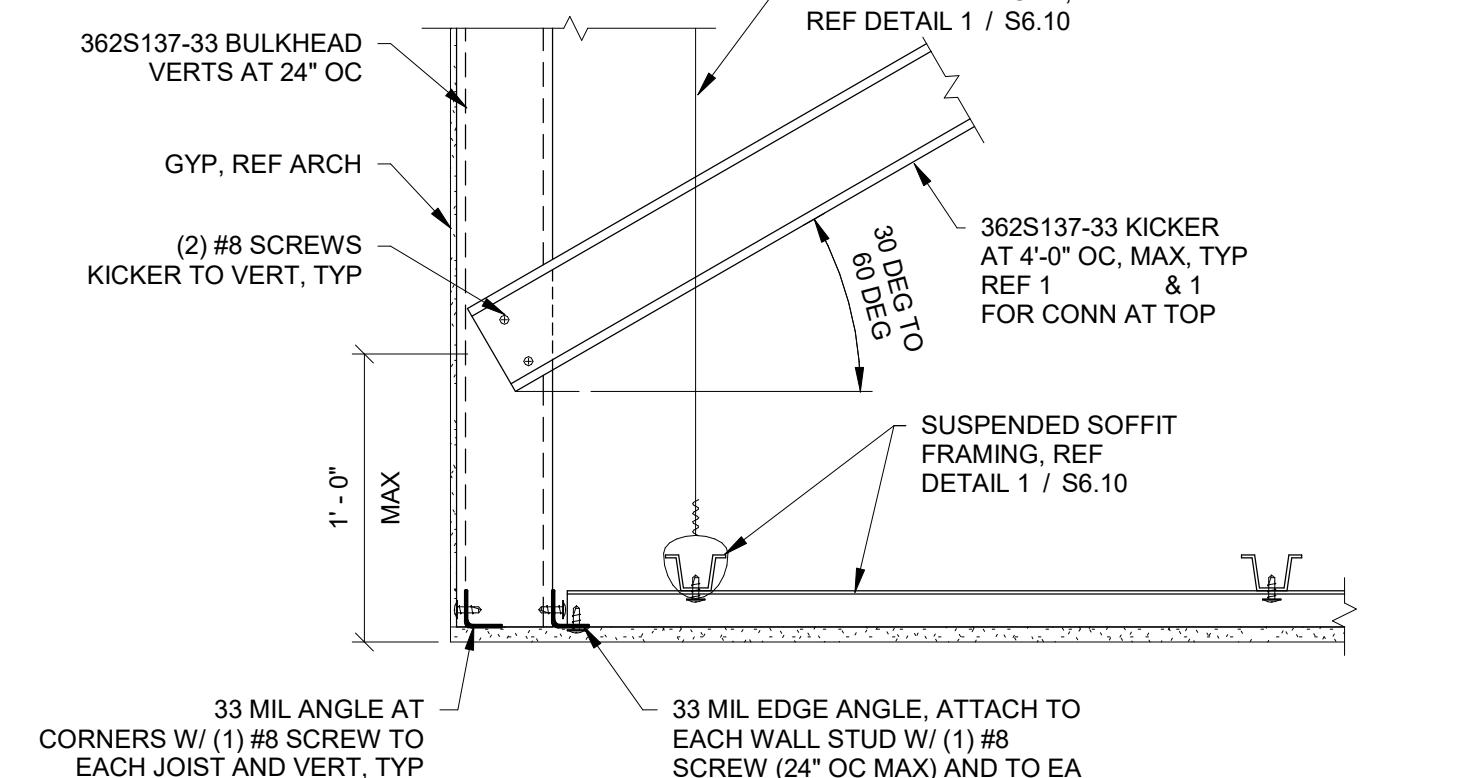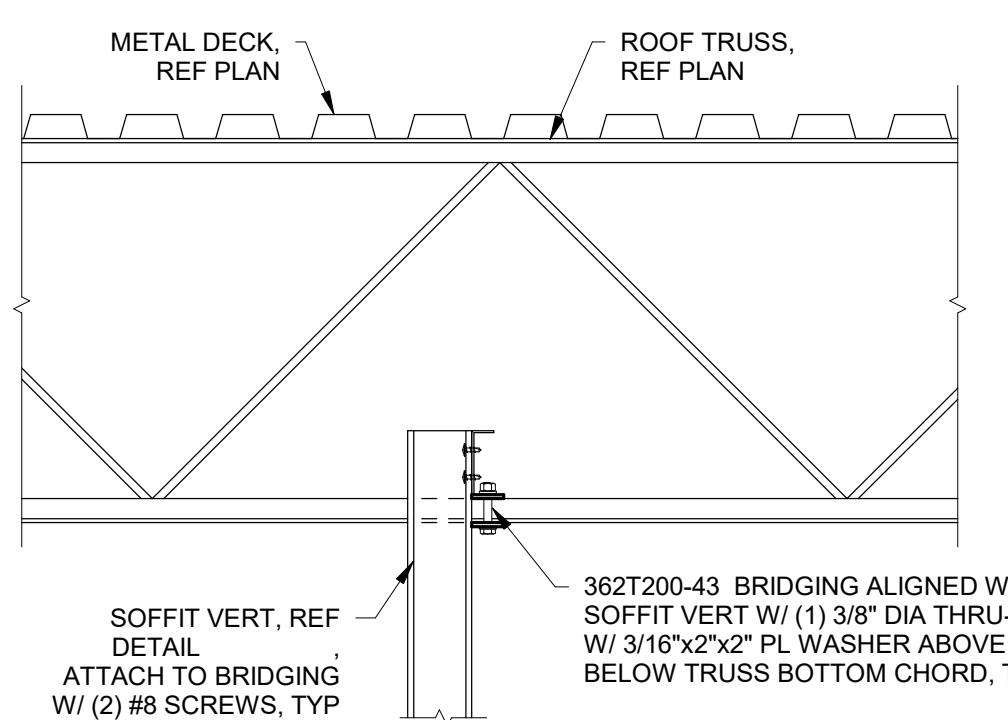

EMT CONDUIT COMPRESSION STRUT SCHEDULE	
MAX LENGTH	EMT PIPE STRUT
3'-0"	3/4" DIA EMT CONDUIT
4'-6"	1" DIA EMT CONDUIT
6'-9"	1 1/4" DIA EMT CONDUIT
7'-9"	1 1/2" DIA EMT CONDUIT
9'-9"	2" DIA EMT CONDUIT





NOTES
1. EMT CONDUIT TO BE MANUFACTURED IN ACCORDANCE WITH ANSI/NSPE-3
2. TABLE VALUES ARE BASED OFF OF A MAXIMUM SPECTRAL SHORT PERIOD SPECTRAL RESPONSE ACCELERATION PARAMETER (SDS) VALUE OF 0.850

15 SUSPENDED SOFFIT BULKHEAD VERT TO STRUCTURE
S6.10 1" = 1'-0"

11 SUSPENDED SOFFIT BULKHEAD
S6.10 1 1/2" = 1'-0"

7 SUSPENDED SOFFIT FRAMING STEP TYP.
S6.10 3/4" = 1'-0"

3 COMPRESSION PIPE STRUT SCHEDULE
S6.10 1" = 1'-0"

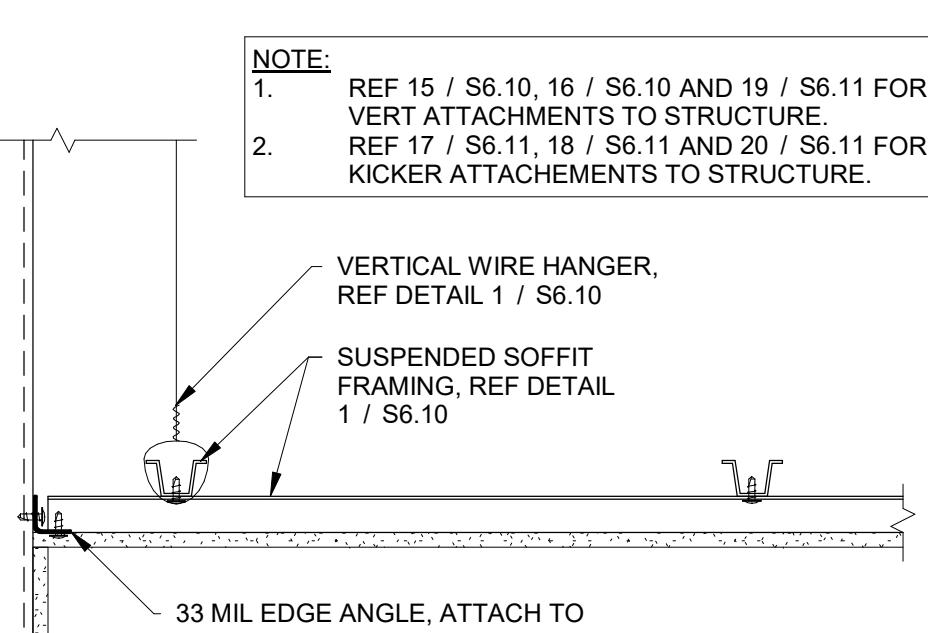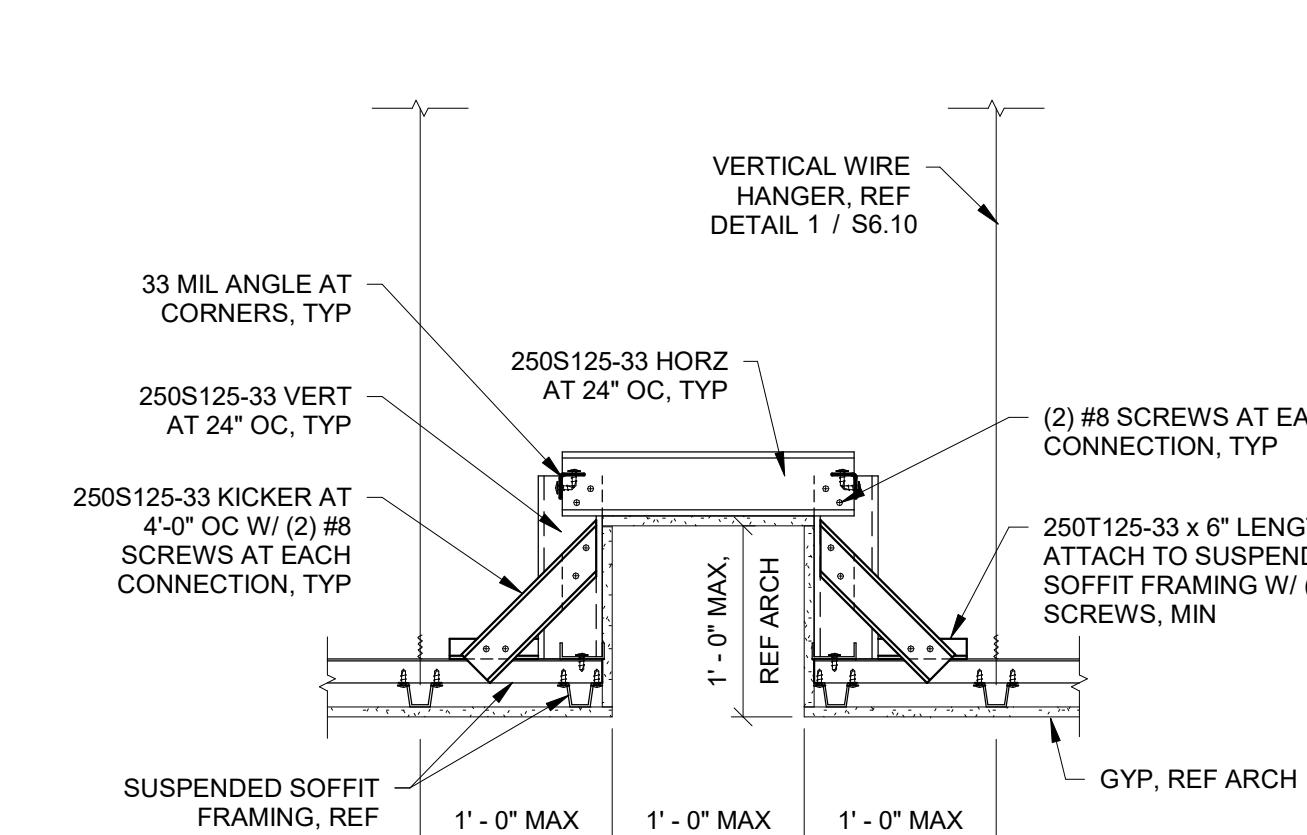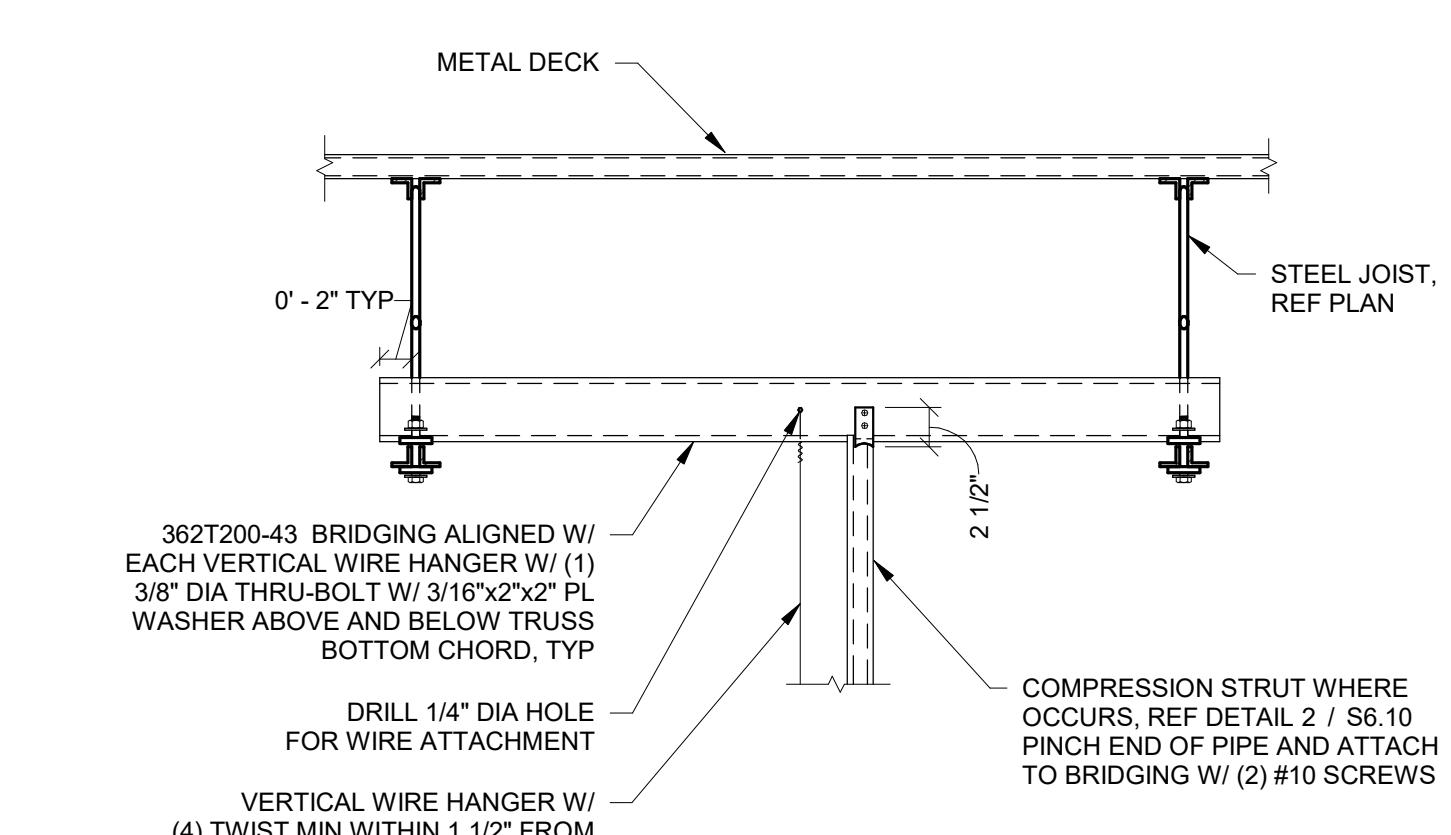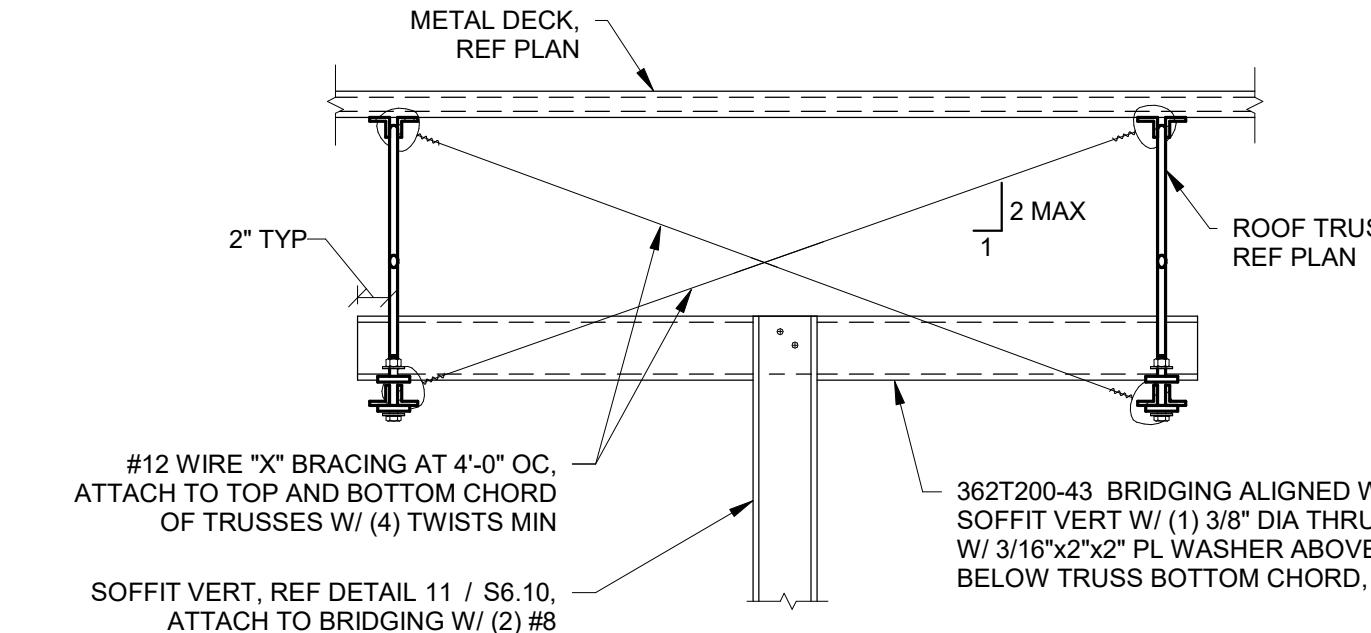


16 SUSPENDED SOFFIT BULKHEAD VERT TO STRUCTURE
S6.10 1" = 1'-0"


12 SUSPENDED SOFFIT VERTICAL WIRE TO STRUCTURE
S6.10 1" = 1'-0"

8 SUSPENDED SOFFIT FRAMING AT COVE LIGHT
S6.10 1" = 1'-0"


4 SUSPENDED SOFFIT EDGE CONDITION
S6.10 1 1/2" = 1'-0"

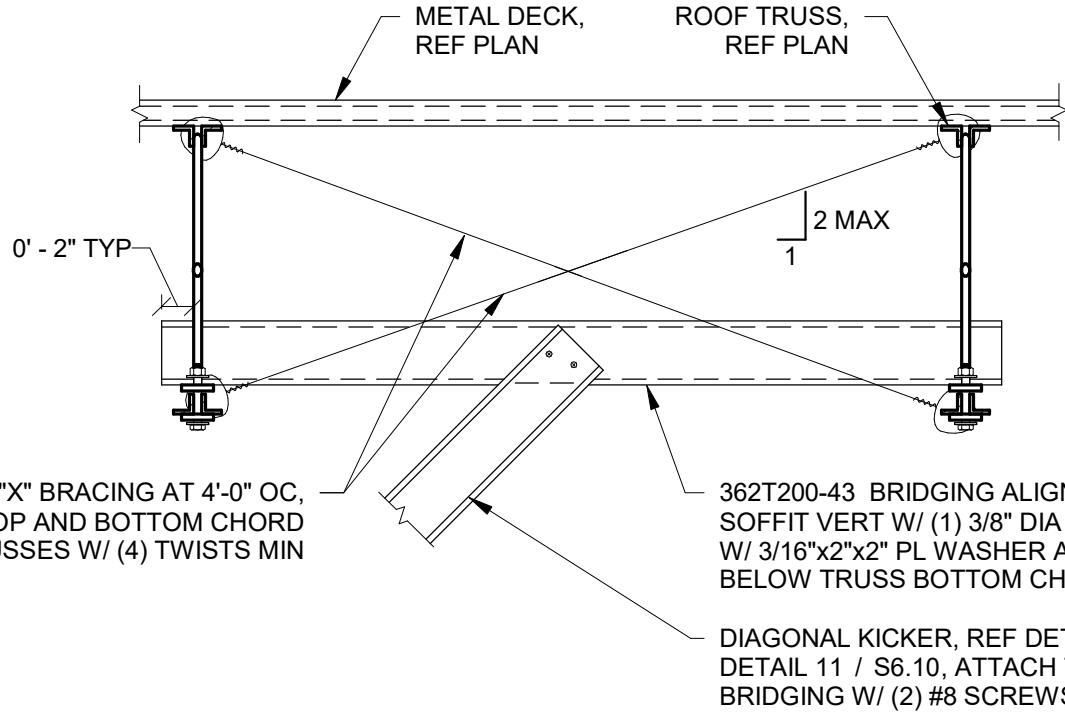


17 SOFFIT KICKER TO STRUCTURE
1" = 1'-0"

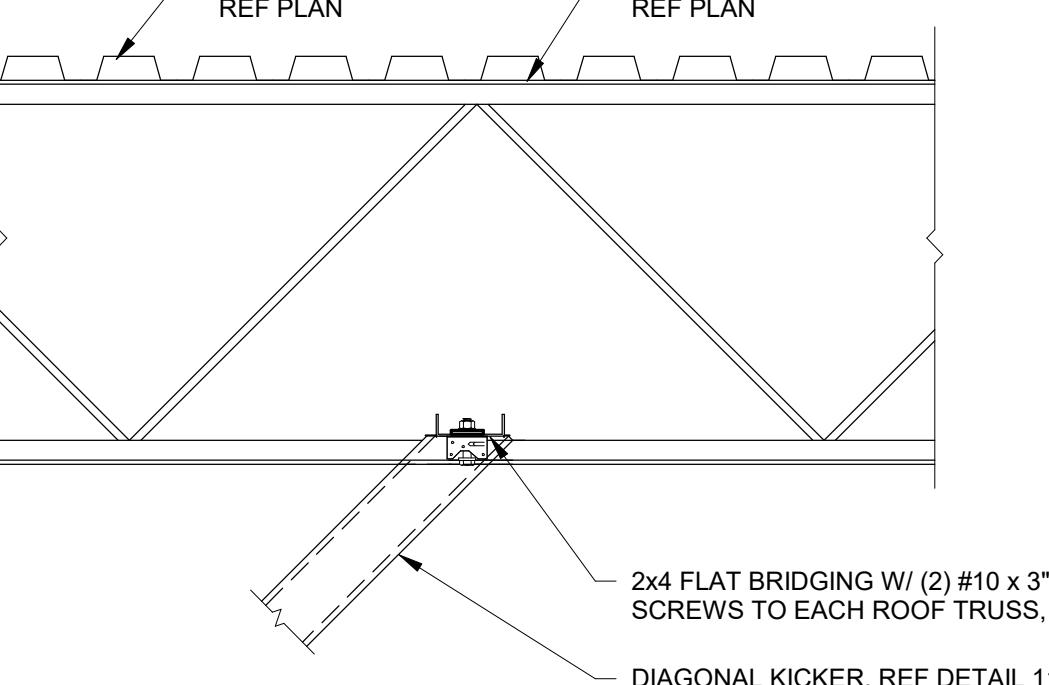

18 SOFFIT KICKER TO STRUCTURE
1" = 1'-0"

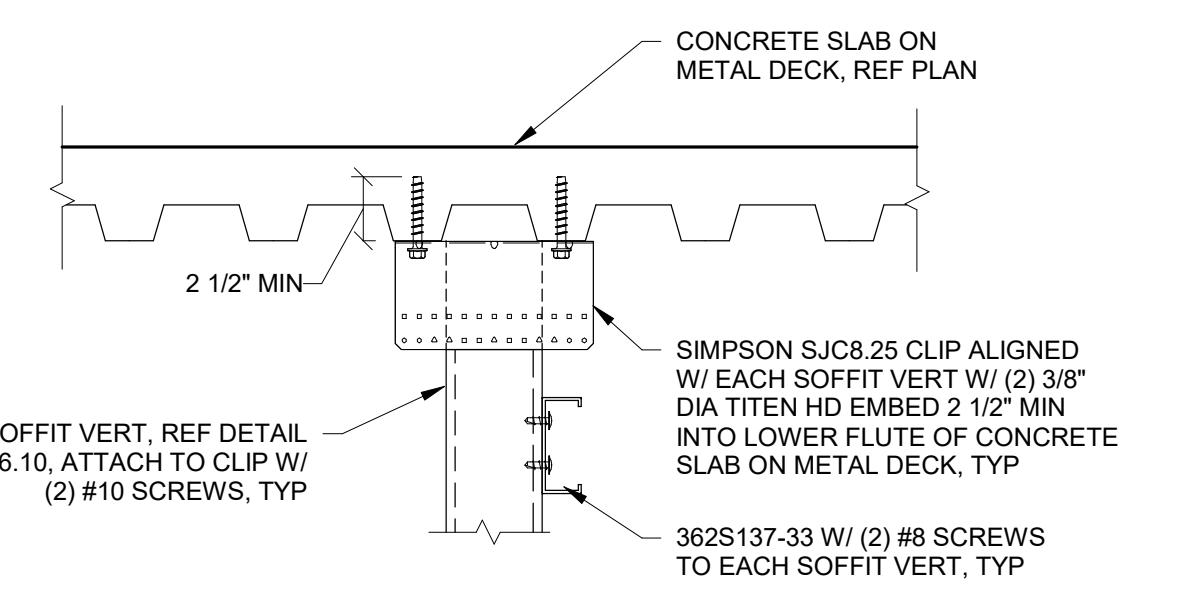


OPTION "A"

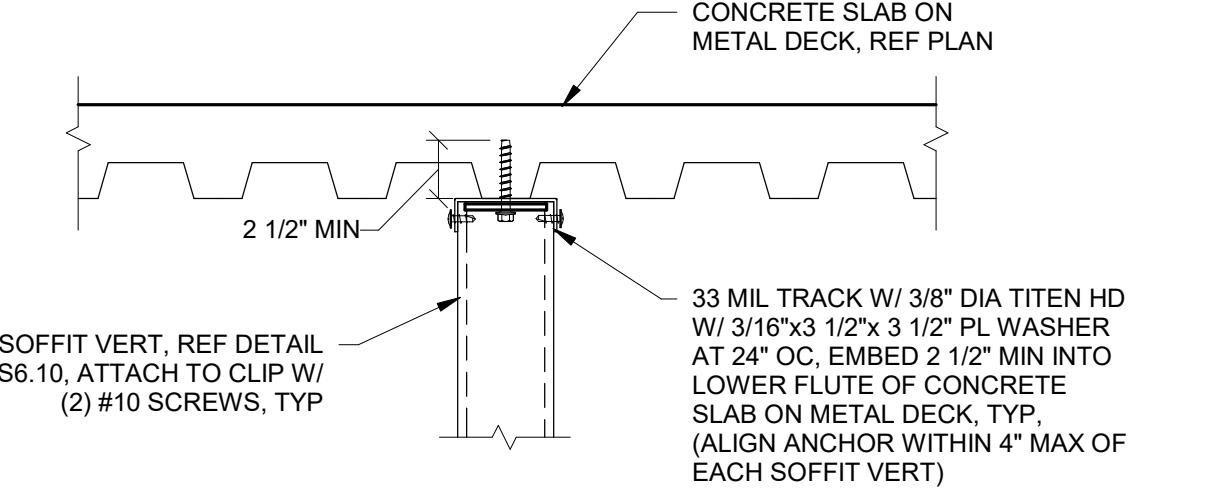

OPTION "B"

19 SUSPENDED SOFFIT BULKHEAD VERT TO STRUCTURE
1 1/2" = 1'-0"

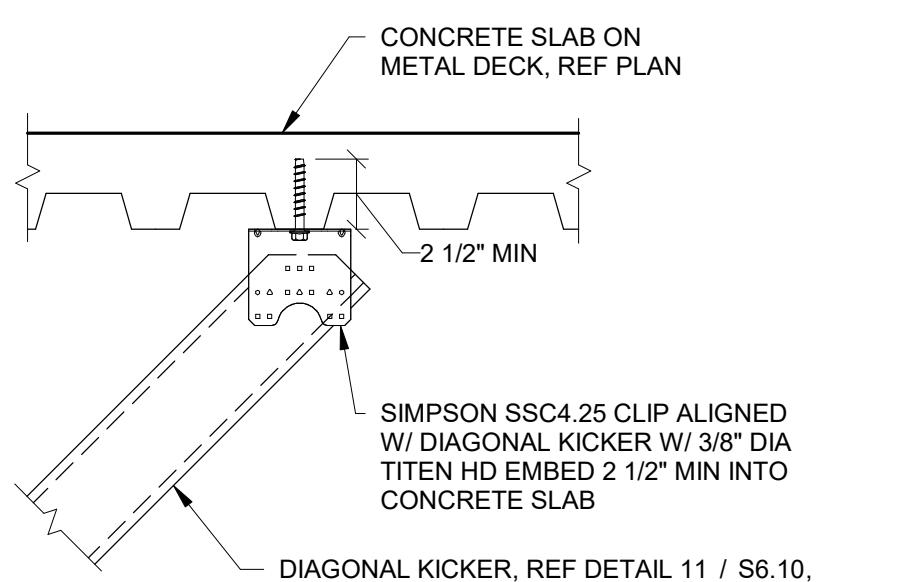

20 SOFFIT KICKER TO STRUCTURE
1 1/2" = 1'-0"

GENERAL DEMO PLAN NOTES

1. DEMO WALLS IN THEIR ENTIRETY WHERE INDICATED ON PLANS.
2. ALL FIRE DEVICES, THERMOSTATS, AND ELECTRICAL DEVICES IN DEMOLISHED WALLS TO BE RELOCATED.
3. WHERE INDICATED ON PLANS DEMO ALL FINISH FLOOR MATERIAL AND PREP SURFACE FOR INSTALLATION OF NEW FINISH MATERIAL PER MANUFACTURER'S INSTRUCTIONS.
4. WHERE ITEMS ARE REMOVED, PATCH AND REPAIR AS REQUIRED FOR NEW WORK.
5. CONTRACTOR SHALL PROVIDE MEANS TO PROTECT THE PUBLIC AND WORKERS DURING THE DEMOLITION PROCESS.
6. SALVAGE EXISTING DOORS ON SITE FOR REUSE.
7. SALVAGE EXISTING CEILING TILE AND GRID SYSTEM WHERE POSSIBLE; REPLACE CEILING TILES AS NEEDED FOR NEW LAYOUTS AND FOR DAMAGED TILES.

DEMO PLAN LEGEND

The diagram consists of four distinct symbols. 1. A horizontal grey bar with a vertical line extending from its left end, labeled 'EXISTING WALL TO REMAIN'. 2. A symbol consisting of three horizontal lines of decreasing length from left to right, labeled 'EXISTING WALL TO BE DEMOLISHED'. 3. A symbol showing a horizontal line with a vertical line branching off at an angle, labeled 'EXISTING DOOR TO REMAIN'. 4. A symbol showing a horizontal line with two vertical lines branching off at different angles, labeled 'EXISTING DOOR TO BE DEMOLISHED'.

KEYNOTES - DEMO PLANS

Key Value	Keynote Text
D001	DEMO IN ITS ENTIRETY EXISTING WALL.
D002	DEMO IN ITS ENTIRETY EXISTING DOOR, TRIM AND THRESHOLD. SALVAGE EXISTING DOOR FOR REUSE AS POSSIBLE.
D004	DEMO IN ITS ENTIRETY EXISTING COUNTERTOP AND/OR CASEWORK AND/OR EQUIPMENT.
D005	DEMO IN ITS ENTIRETY EXISTING DOOR, TRIM AND THRESHOLD, SALVAGE TO REINSTALL IN PROJECT, SEE DOOR SCHEDULE.
D007	DEMO IN ITS ENTIRETY ALL EXISTING PLUMBING EQUIPMENT. REMOVE (E) CABINETRY IF PRESENT. IF PIPING IS TO NO BE REUSED, ABANDON LINES IN-PLACE AND CAP PIPING FLUSH WITH FLOOR IN A MANNER THAT ALLOWS THE INSTALLATION OF FLOORING MATERIALS TO MANUFACTURERS SPECIFICATION WHERE NEW FLOOR IS TO BE INSTALLED.
D008	DEMO WALL AREA FOR NEW DOOR OPENING, SEE FLOOR PLAN FOR DOOR TAG. PREP AND REPAIR FOR NEW OPENING.
D009	DEMO IN ITS ENTIRETY INTERIOR GLAZING, PATCH AND REPAIR AS NECESSARY
D011	(E) ELECTRICAL PANELS TO REMAIN IN PLACE; MAINTAIN MIN CLEARANCES IN FRONT OF PANELS
D012	DEMO IN ITS ENTIRETY EXISTING FINISH FLOOR AND WALL BASE; PATCH AND PREP SUBFLOOR AND WALLS AS REQ'D FOR (N) FINISH FLOOR AND BASE.
D013	(E) CASEWORK TO REMAIN IN PLACE
D014	NO WORK ANTICIPATED IN THIS ROOM, REFER TO FINISH SCHEDULE AND PLAN FOR ANY PAINT UPDATES
D018	SALVAGE AND REINSTALL EXISTING FIRE EXTINGUISHER CABINET, SEE DETAIL 16/A5.20
D019	SAW CUT EXISTING CONCRETE TO THE EXTENT NECESSARY FOR NEW PLUMBING INSTALL, POUR AND REPLACE NEW CONCRETE FLOOR IN KIND ONCE COMPLETE.

pinnacle architecture, inc.

"ENHANCING LIVES AND COMMUNITIES"

1001 SW DISK DRIVE, SUITE 105
BEND OR 97702
541.388.9897
WWW.PINNACLEARCHITECTURE.COM

LAKE ROAD HEALTH CENTER

CLIENT: CLACKAMAS COUNTY


CLACKAMAS COUNTY

PROJECT ADDRESS:
6605 SE Lake Rd, Milwaukie, OR
97222

APPROVED FOR	DATE	BY
<hr/>		
BUILDING PERMIT	02.02.24	KK

 REV	DESCRIPTION	DATE
		
		
		
		
		
		
		
		
		
		

1ST FLOOR PLAN - DFMO

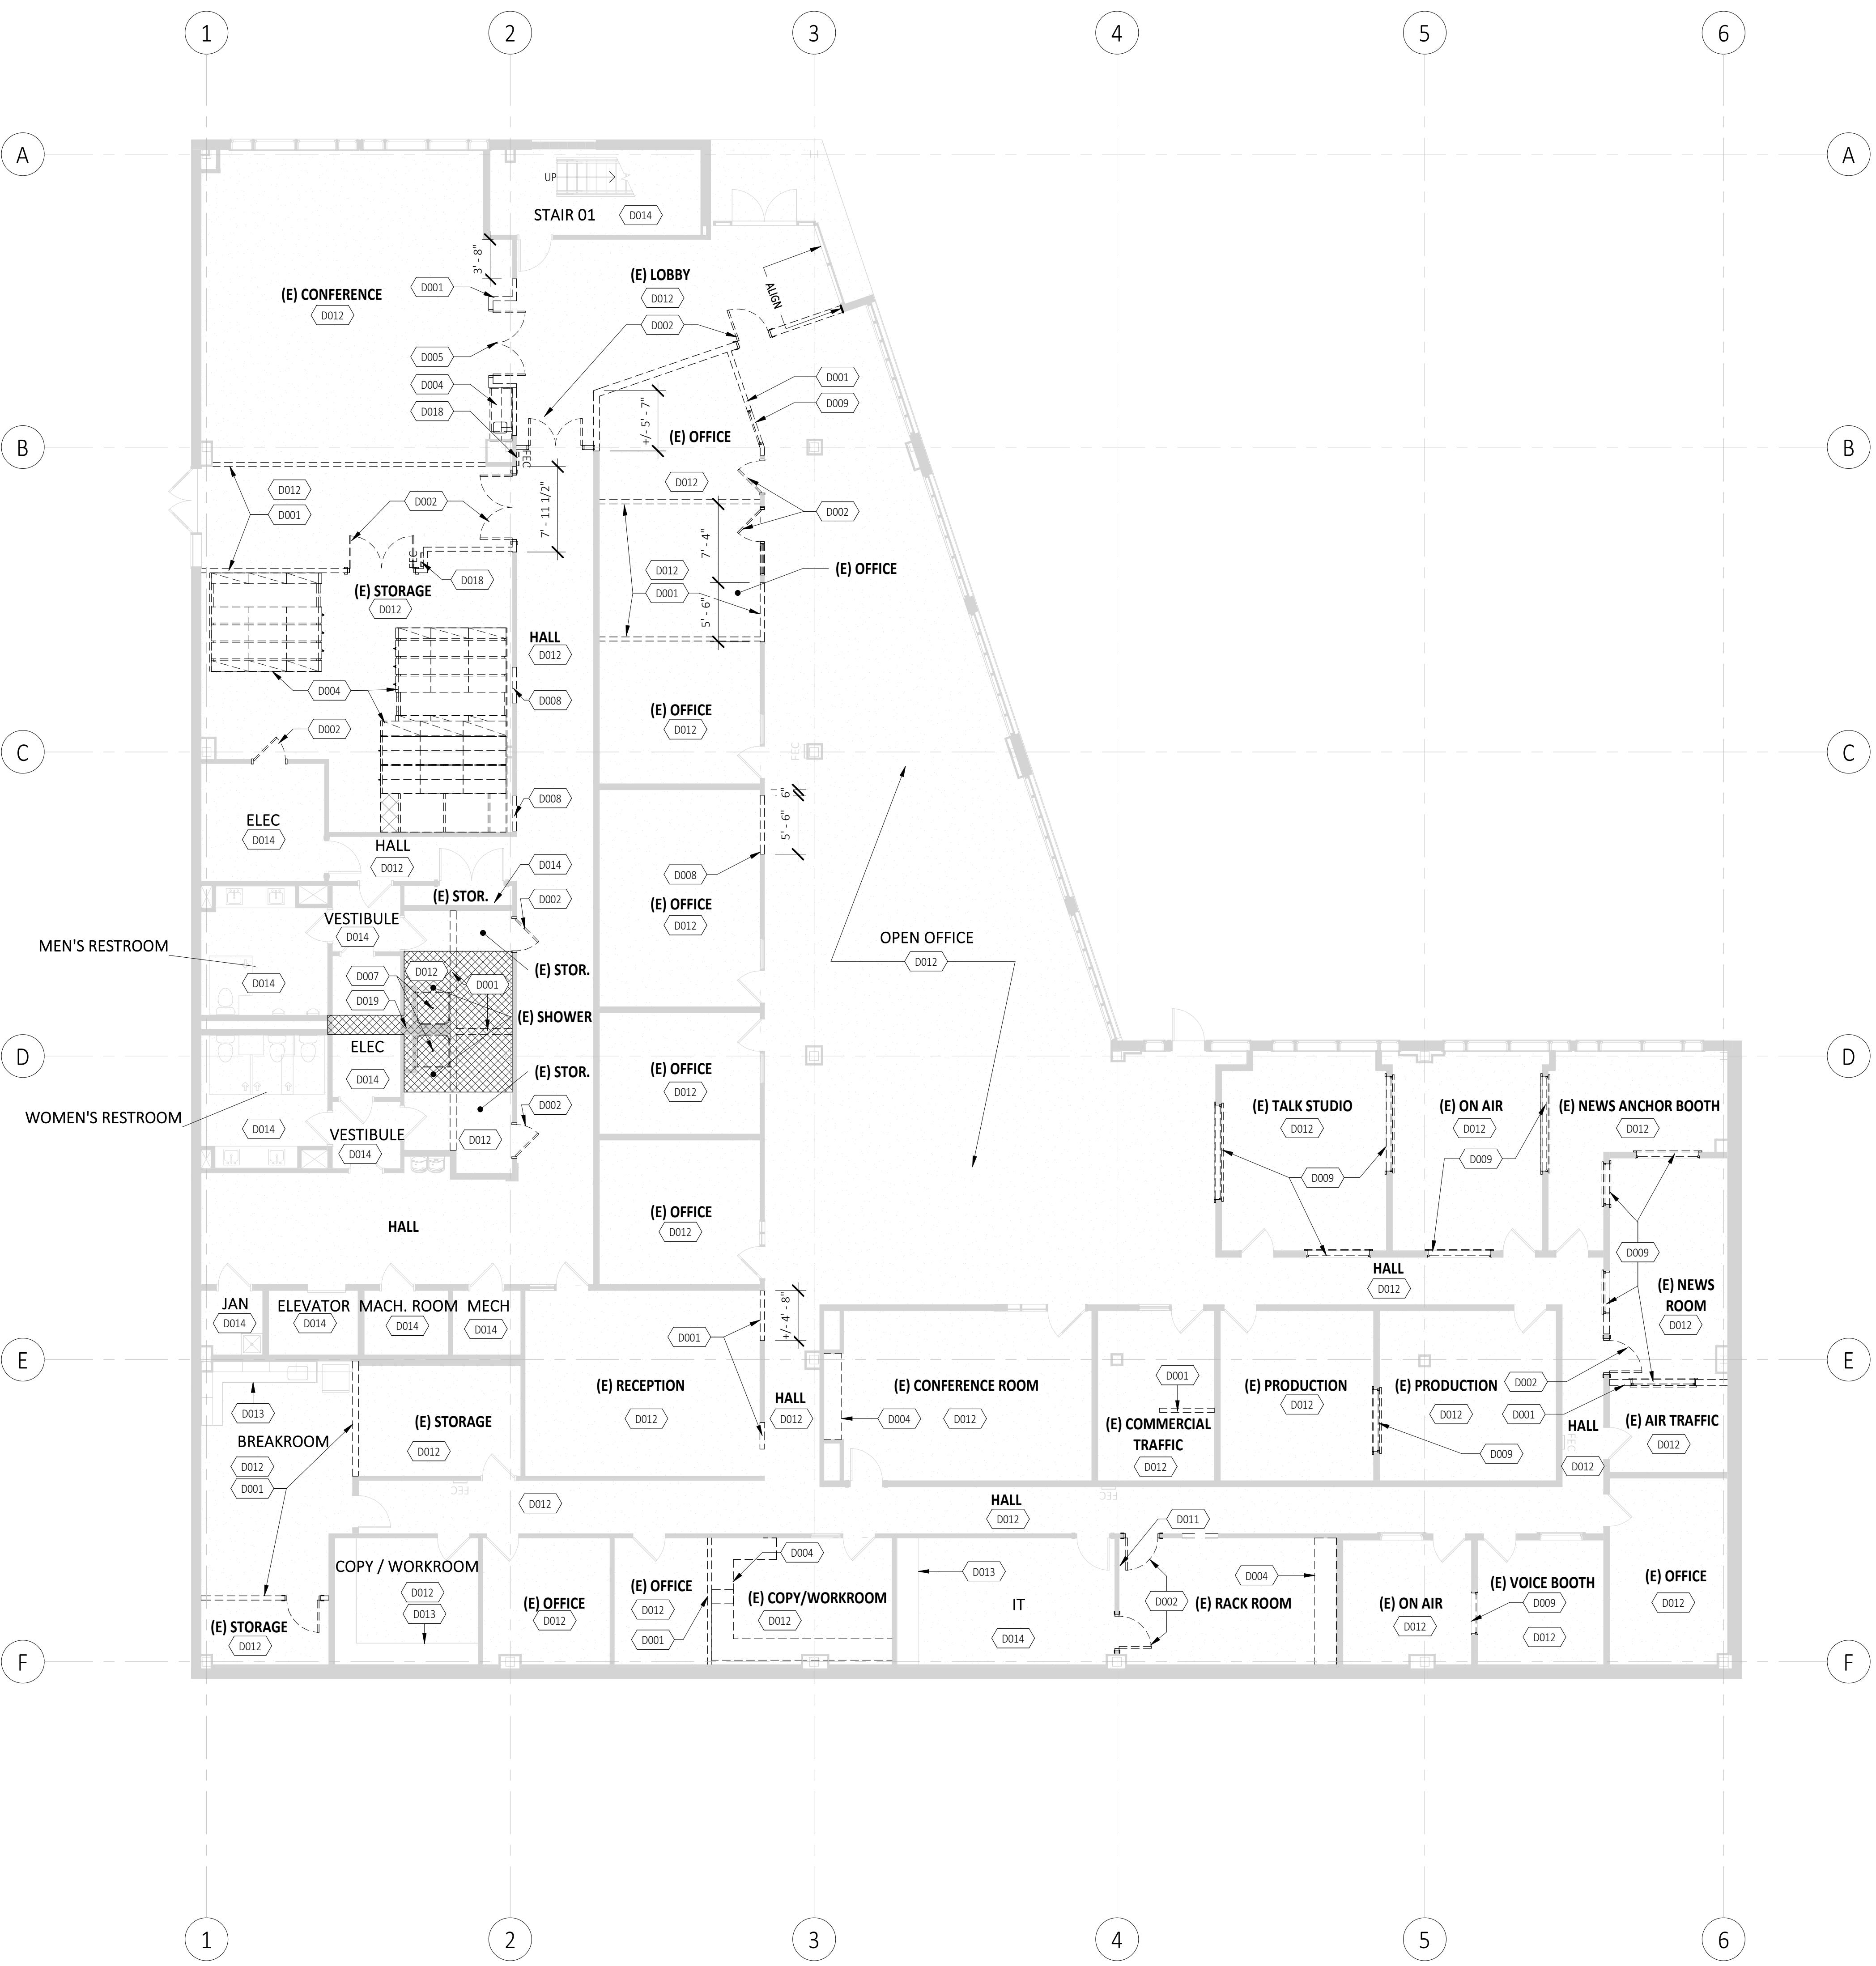

1 LEVEL_01-DEMO
1/8" = 1'-0"

A black circular icon containing a white stylized arrow pointing upwards and to the right, indicating the direction of North.

AD1.11

GENERAL DEMO PLAN NOTES


1. DEMO WALLS IN THEIR ENTIRETY WHERE INDICATED ON PLANS.
2. ALL FIRE DEVICES, THERMOSTATS, AND ELECTRICAL DEVICES IN DEMOLISHED WALLS TO BE RELOCATED.
3. WHERE INDICATED ON PLANS DEMO ALL FINISH FLOOR MATERIAL AND PREP SURFACE FOR INSTALLATION OF NEW FINISH MATERIAL PER MANUFACTURER'S INSTRUCTIONS.
4. VINTAGE ITEMS AS REMOVED, PATCH AND REPAIR AS REQUIRED FOR NEW WORK.
5. CONTRACTOR SHALL PROVIDE MEANS TO PROTECT THE PUBLIC AND WORKERS DURING THE DEMOLITION PROCESS.
6. SALVAGE EXISTING DOORS ON SITE FOR REUSE.
7. SALVAGE EXISTING CEILING TILE AND GRID SYSTEM WHERE POSSIBLE; REPLACE CEILING TILES AS NEEDED FOR NEW LAYOUTS AND FOR DAMAGED TILES.

pinnacle
architecture, inc.

"ENHANCING LIVES AND COMMUNITIES"

1001 SW DISK DRIVE, SUITE 105
BEND OR 97702
541.388.9897
WWW.PINNACLEARCHITECTURE.COM

DEMO PLAN LEGEND

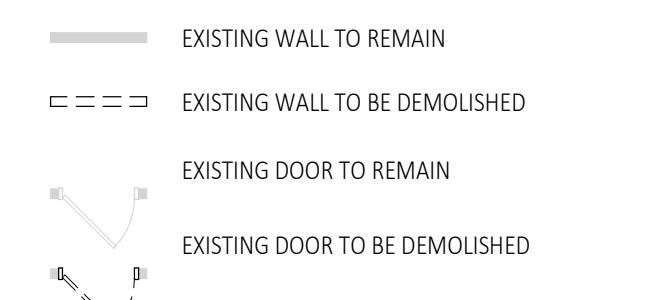

KEYNOTES - DEMO PLANS

Key Value	Keynote Text
D001	DEMO IN ITS ENTIRETY EXISTING WALL
D002	DEMO IN ITS ENTIRETY EXISTING DOOR, TRIM AND THRESHOLD; SALVAGE EXISTING DOOR FOR REUSE AS POSSIBLE
D004	DEMO IN ITS ENTIRETY EXISTING COUNTERTOP AND/OR CASEWORK AND/OR EQUIPMENT
D008	DEMO WALL AREA FOR NEW DOOR OPENING, SEE FLOOR PLAN FOR DOOR TAG. PREP AND REPAIR FOR NEW OPENING
D012	DEMO IN ITS ENTIRETY EXISTING FLOOR AND WALL BASE; PATCH AND PREP SUBFLOOR AND WALLS AS RECD FOR (N) FINISH FLOOR AND BASE
D013	(E) CASEWORK TO REMAIN IN PLACE
D014	NO WORK ANTICIPATED IN THIS ROOM, REFER TO FINISH SCHEDULE AND PLAN FOR ANY PAINT UPDATES

REGISTERED ARCHITECT
PETER E. BAER
BEND, OREGON
STATE OF OREGON
3078

LAKE ROAD HEALTH CENTER

CLIENT:
CLACKAMAS COUNTY

PROJECT ADDRESS:
6605 SE Lake Rd, Milwaukie, OR
97222



GENERAL DEMO PLAN NOTES

1. DEMO WALLS IN THEIR ENTIRETY WHERE INDICATED ON PLANS.
2. ALL FIRE DEVICES, THERMOSTATS, AND ELECTRICAL DEVICES IN DEMOLISHED WALLS TO BE RELOCATED.
3. WHERE INDICATED ON PLANS DEMO ALL FINISH FLOOR MATERIAL AND PREP SURFACE FOR INSTALLATION OF NEW FINISH MATERIAL PER MANUFACTURER'S INSTRUCTIONS.
4. WHERE ITEMS ARE REMOVED, PATCH AND REPAIR AS REQUIRED FOR NEW WORK.
5. CONTRACTOR SHALL PROVIDE MEANS TO PROTECT THE PUBLIC AND WORKERS DURING THE DEMOLITION PROCESS.
6. SALVAGE EXISTING DOORS ON SITE FOR REUSE.
7. SALVAGE EXISTING CEILING TILE AND GRID SYSTEM WHERE POSSIBLE; REPLACE CEILING TILES AS NEEDED FOR NEW LAYOUTS AND FOR DAMAGED TILES.

pinnacle
architecture, inc.

"ENHANCING LIVES AND COMMUNITIES"

1001 SW DISK DRIVE, SUITE 105
BEND OR 97702
541.388.9897
WWW.PINNACLEARCHITECTURE.COM


REGISTERED ARCHITECT
PETER E. BAER
BEND, OREGON
3078

LAKE ROAD HEALTH CENTER

CLIENT:
CLACKAMAS COUNTY

PROJECT ADDRESS:
6605 SE Lake Rd, Milwaukie, OR
97222

DEMO PLAN LEGEND

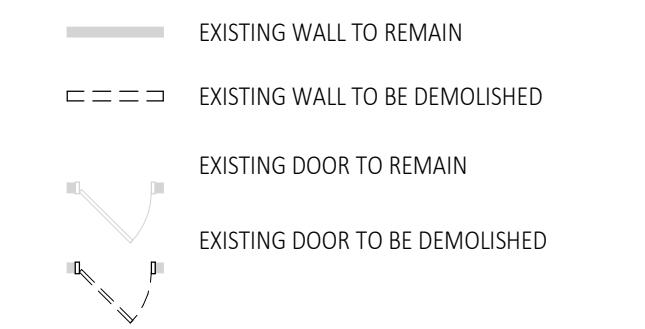


KEYNOTES - DEMO PLANS

Key Value	Keynote Text
D001	DEMO IN ITS ENTIRETY EXISTING WALL.
D002	DEMO IN ITS ENTIRETY EXISTING DOOR, TRIM AND THRESHOLD. SALVAGE EXISTING DOOR FOR REUSE AS POSSIBLE.
D004	DEMO IN ITS ENTIRETY EXISTING COUNTERTOP AND/OR CASEWORK AND/OR EQUIPMENT.
D008	DEMO WALL AND FOR NEW DOOR OPENING, SEE FLOOR PLAN FOR DOOR TAG. PREP AND REPAIR FOR NEW OPENING.
D009	DEMO IN ITS ENTIRETY EXISTING GLAZING, PATCH AND REPAIR AS NECESSARY.
D012	DEMO IN ITS ENTIRETY EXISTING FINISH FLOOR AND WALL BASE; PATCH AND PREP SUBFLOOR AND WALL AS REQ'D FOR (N) FINISH FLOOR AND BASE.
D013	(E) CASEWORK TO REMAIN IN PLACE.
D014	NO WORK ANTICIPATED IN THIS ROOM, REFER TO FINISH SCHEDULE AND PLAN FOR ANY PAINT UPDATES.
D020	DEMO IN ITS ENTIRETY EXISTING CARPET, LEAVE (E) WALL BASE AND PANELING IN PLACE; PREP FLOOR AS REQ'D FOR NEW FINISH FLOOR.
D021	(E) FLOOR FINISH AND WALL PANELING TO REMAIN IN ITS ENTIRETY; PREP WALL AS REQ'D FOR (N) PAINT ABOVE WANSOC.




1 LEVEL 03 - DEMO
1/8" = 1'-0"

A3 324 GROUP ROOM DEMO ELEVATION
1/4" = 1'-0"

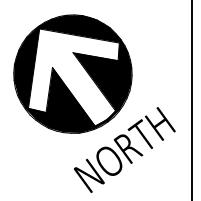

AD1.13

APPROVED FOR DATE BY
BUILDING PERMIT 02.02.24 KK

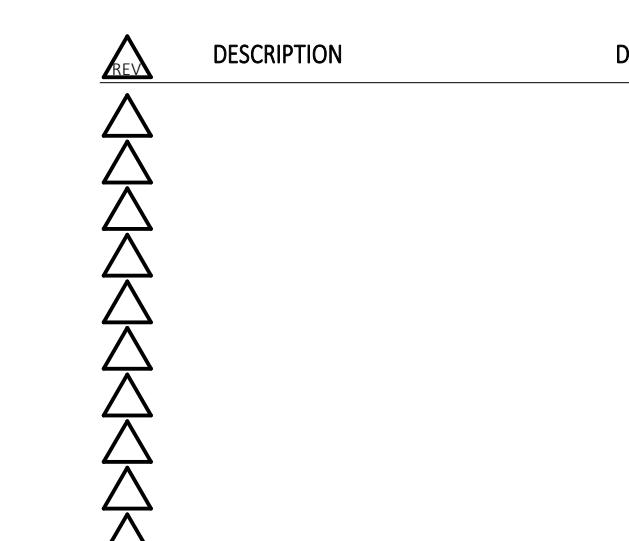

PROJECT NO: 2221 HCR
DRAWN BY: BJL
CHECKED BY: PETER BAER
© PINNACLE ARCHITECTURE, INC. 2024 ORIGINAL SHEET SIZE: 30" x 42"

3RD FLOOR PLAN - DEMO

2/5/2024 4:48:47 PM

PLUMBING FIXTURE SCHEDULE

ALL FIXTURES TO BE CLACKAMAS COUNTY STANDARDS.

WATER CLOSET

MFR: CAROMA
PRODUCT: CARAVELLE 270 ELONGATED, ADA
SEAT: CARAVELLE COM. ELONGATED, OPEN FRON 326013
NOTES: DUAL FLUSH, WATER-SAVING WATER CLOSET

LAVATORY

MFR: KOHLER
PRODUCT: FARMINGTON K-2905-4 (BARRIER FREE)
FAUCET: SLOAN ETF-600 BDT WITH ETF-233 TRANSFORMER AND MIXING VALVE
NOTES:

SINK

MFR: ELKAY
PRODUCT: LRAD 1517-6 LUSTERTONE, STAINLESS STEEL, 15" X 17-1/2" X 6-1/2", SINGLE BOWL DROP-IN ADA SINK
FAUCET: DELTA SINGLE HANDLE
NOTES:


GENERAL FLOOR PLAN NOTES

- SEE SHEET A6.10 FOR WALL, FLOOR AND ROOF ASSEMBLIES.
- SEE G5.10 FOR MOUNTING HEIGHTS AND ACCESSIBILITY DETAILS.
- WALL DIMENSIONS ARE TO CENTER OF ROUGH OPENING, UNLESS NOTED OTHERWISE.
- WALL DIMENSIONS ARE TO FACE OF STUD AND/OR FACE OF CMU/CONCRETE, UNLESS NOTED OTHERWISE.
- CONTRACTORS TO FELD VERIFY EXISTING ROUGH OPENING DIMENSIONS PRIOR TO ORDERING DOORS AND WINDOWS.
- ALL DOORS WITH GLAZING TO HAVE SAFETY GLAZING PER CODE.
- DOOR AND WINDOW SUPPLIER RESPONSIBLE FOR LOCATING HARDWARE IN ACCESSIBLE SPACES TO BE LESS THAN 48" ABOVE FINISH FLOOR INCLUDING BUMPER CONTROLS.
- RESILIENT CHANNEL TO NOT BE INSTALLED ON WALLS WITH MOUNTED FIXTURES. USE OPPOSITE SIDE WHEN POSSIBLE.
- SEE FINISH FLOOR PLAN SHEETS FOR CORNER GUARD LOCATIONS.
- DOORS PERPENDICULAR TO WALLS TO BE MIN. 6" FROM ADJACENT WALL TYP. U.N.O.
- ALL WALL TYPES WITHOUT HEAD CONDITIONS NOTED ARE EXISTING TO REMAIN OR TYPE C, WITH INSULATION OVER THE TOP OF THE HEAD CONNECTION. SEE 1.2 AND 3.6A.10.
- ALL MECHANICAL AND ELECTRICAL SYSTEMS TO MEET CURRENT ENERGY CODE STANDARDS.

pinnacle
architecture, inc.


"ENHANCING LIVES AND COMMUNITIES"

1001 SW DISK DRIVE, SUITE 105
BEND OR 97702
541.388.9897
WWW.PINNACLEARCHITECTURE.COM

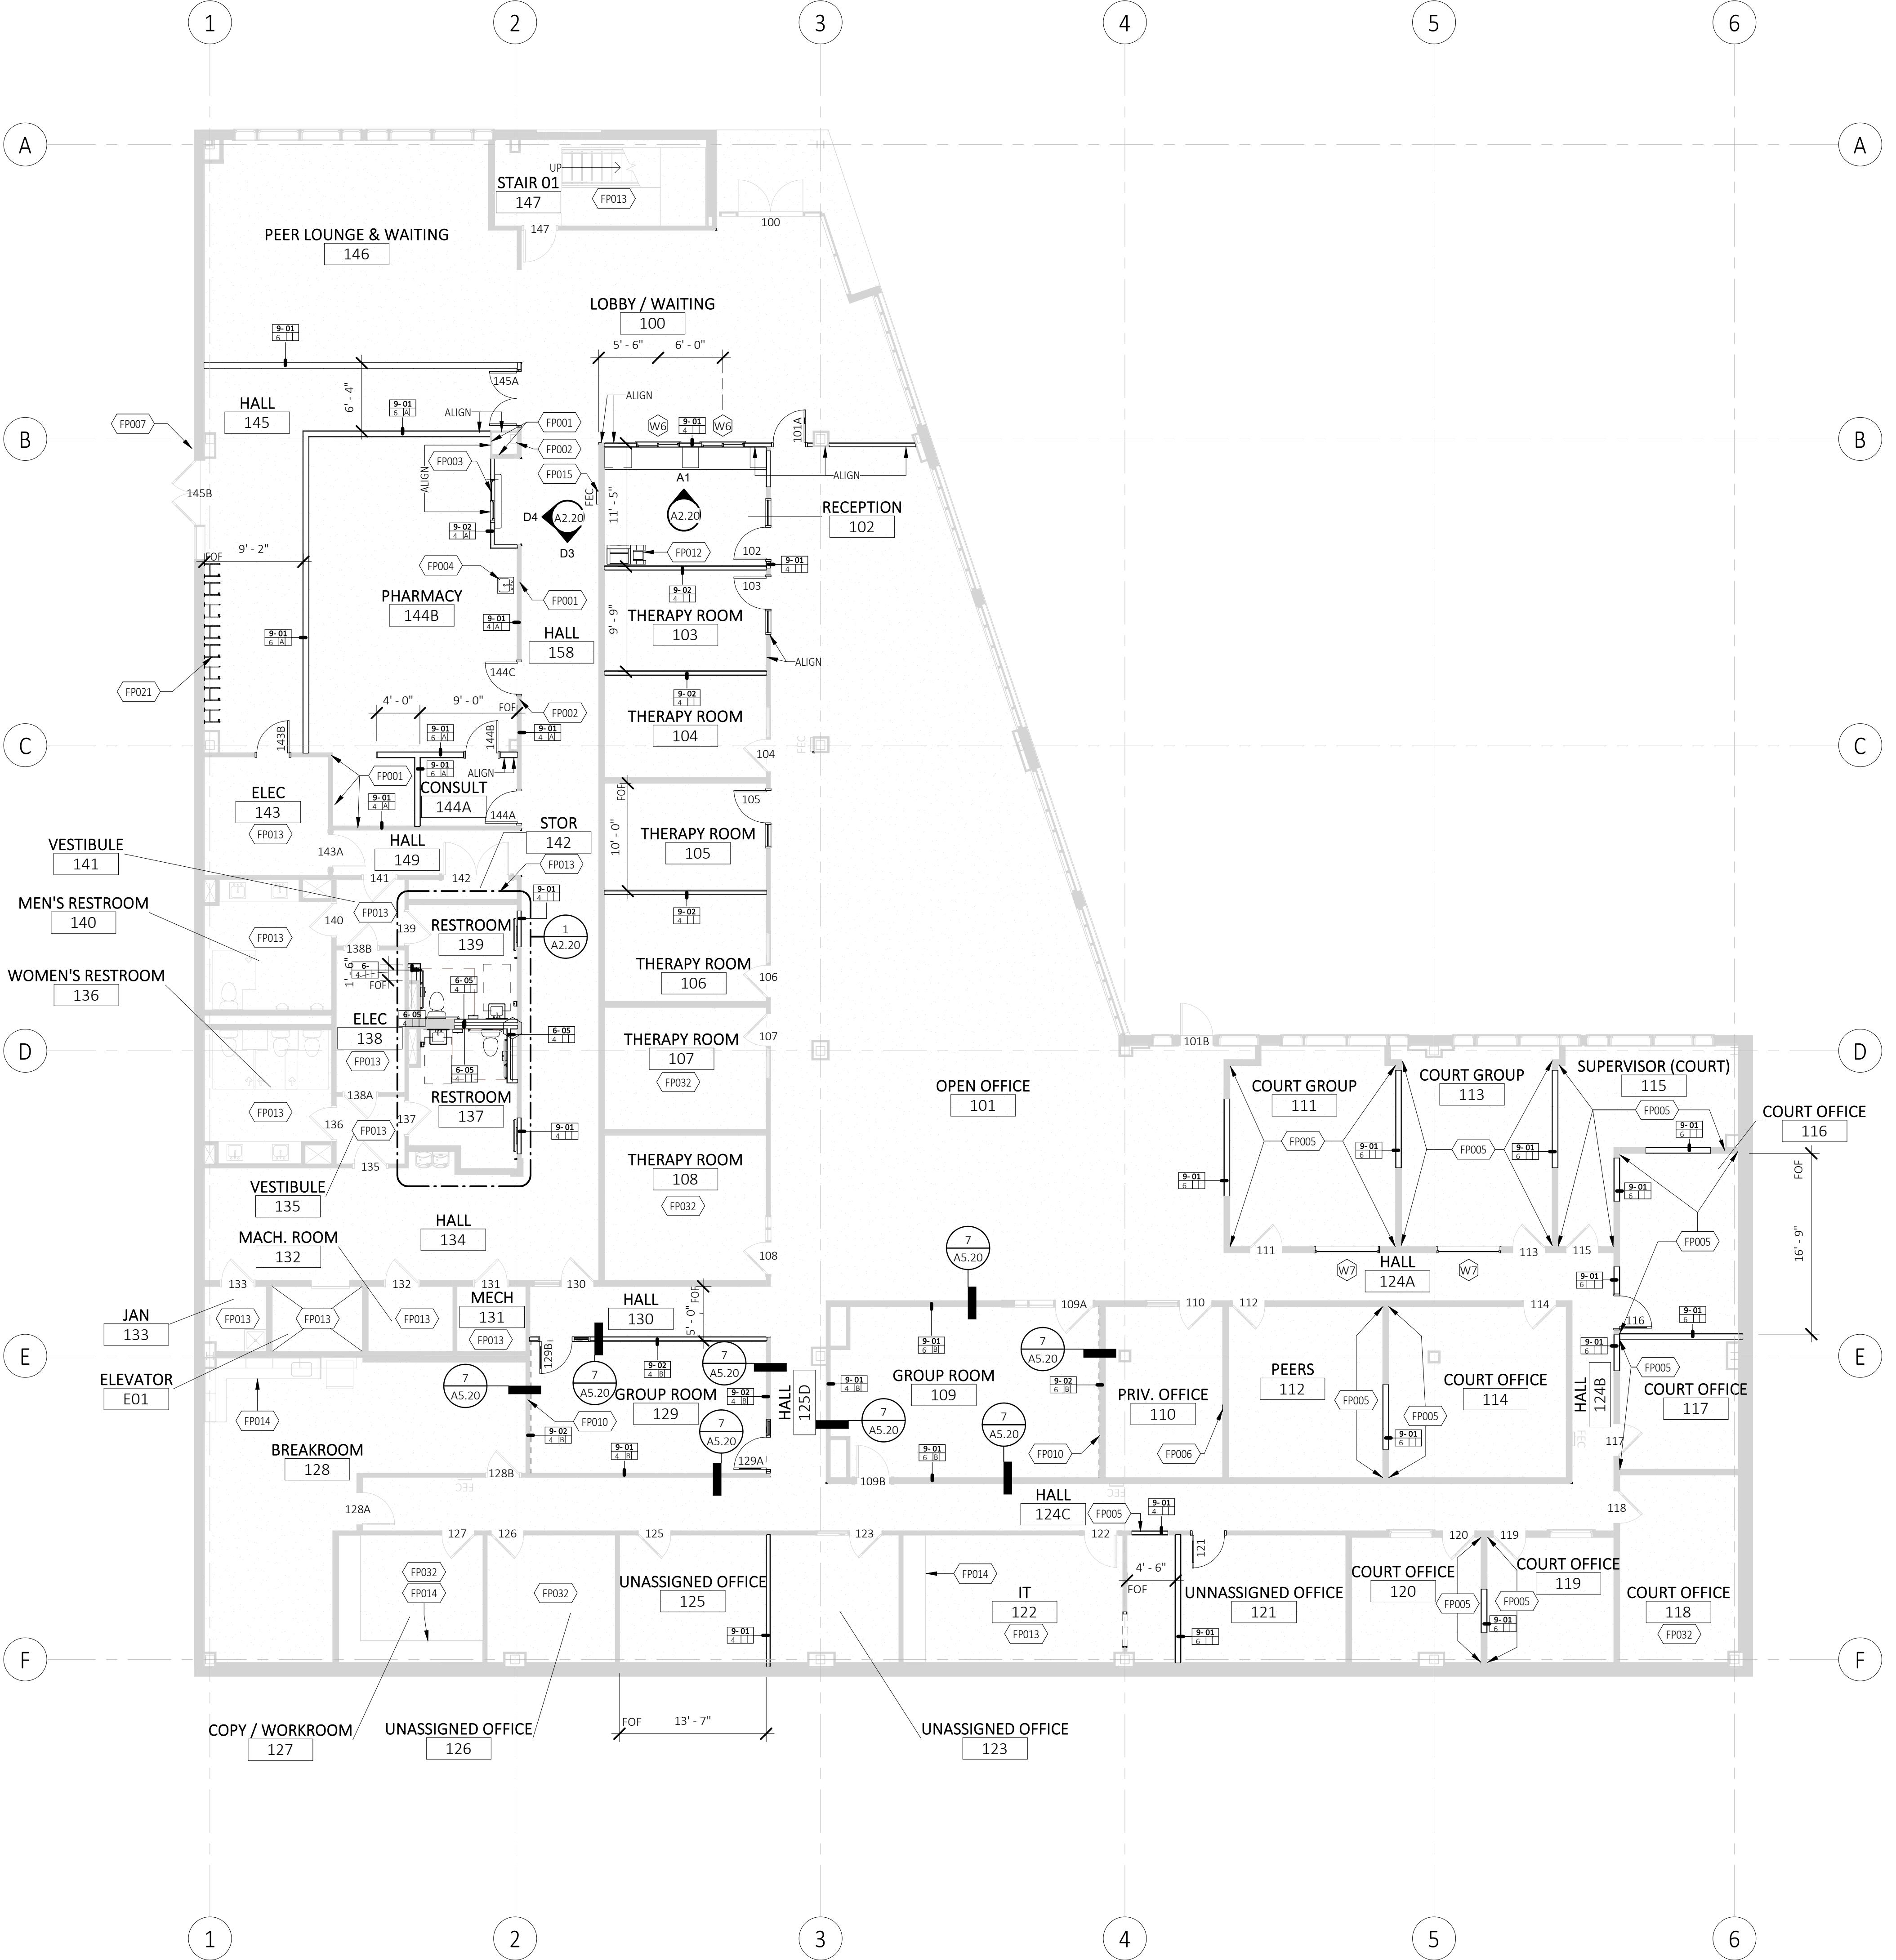

1 LEVEL_01
1/8" = 1'-0"

FLOOR PLAN LEGEND

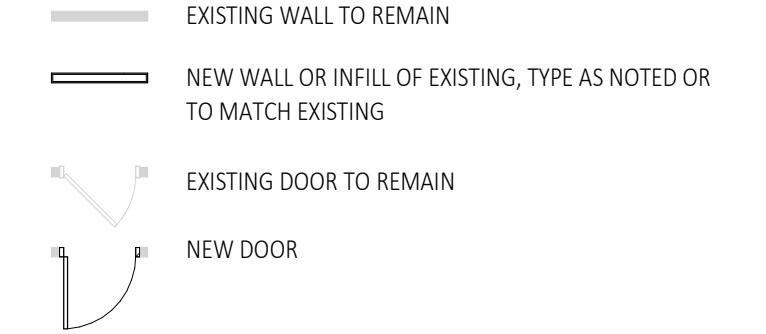

KEYNOTES - FLOOR PLANS

Key Value	Keynote Text
FP001	FULL HEIGHT WALL UP TO STRUCTURE, IF NOT ALREADY EXISTING
FP002	PLYWOOD REINFORCEMENT PER GENOA PHARMACY INTERIOR DRAWINGS
FP003	INTERIOR WINDOW PER GENOA PHARMACY DRAWINGS
FP004	INSTALL SINK PER GENOA DRAWINGS, SAW CUT CONCRETE FOR NEW DRAIN
FP005	PATCH AND PAINT (E) WALL AND (N) WALL INFILL AS REQUIRED
FP006	INTERCOM CALL BUTTON FOR DELIVERIES, CONNECT TO RECEPTION DESK 102
FP007	(N) 5/8" GYP BOARD ON RC CHANNEL SOUND ASSEMBLY OVER EXISTING WALL. ACCUSTICALLY SEAL ALL PERIMETER EDGES OF GYP BOARD TO ADJACENT WALL
FP010	(O) FULL-SIZED COPIER - PROVIDE POWER AND DATA
FP012	(E) CASEWORK TO REMAIN IN PLACE
FP014	NO WORK ANTICIPATED IN THIS ROOM, REFER TO FINISH SCHEDULE AND PLAN FOR ANY PAINT UPDATES
FP015	(E) CASEWORK AND REINSTALL EXISTING FIRE EXTINGUISHER 16 / A5.20
FP021	INDOOR WALL MOUNTED BIKE PARKING RACKS, PROVIDE BLOCKING FOR SYSTEM; BASIS OF DESIGN: THE PARK 9 BIKE WALL MOUNTED BIKE RACK - GALVANIZED.
FP032	NO WORK ANTICIPATED IN THIS ROOM BEYOND NEW FINISH FLOOR, WALL BASE, OR WALL PAINT. REFER TO FINISH PLANS.

REGISTERED ARCHITECT
PETER E. BAER
BEND, OREGON
3078

LAKE ROAD HEALTH CENTER
CLIENT:
CLACKAMAS COUNTY

PROJECT ADDRESS:
6605 SE Lake Rd, Milwaukie, OR
97222

APPROVED FOR DATE BY
BUILDING PERMIT 02.02.24 KK


DESCRIPTION DATE
PROJECT NO: 2221 HCR
DRAWN BY: MALLORY FAIR
CHECKED BY: PETER BAER
© PINNACLE ARCHITECTURE, INC. 2024 ORIGINAL SHEET SIZE: 30" x 42"

1ST FLOOR PLAN

NORTH

A1.10

2/5/2024 4:48:51 PM

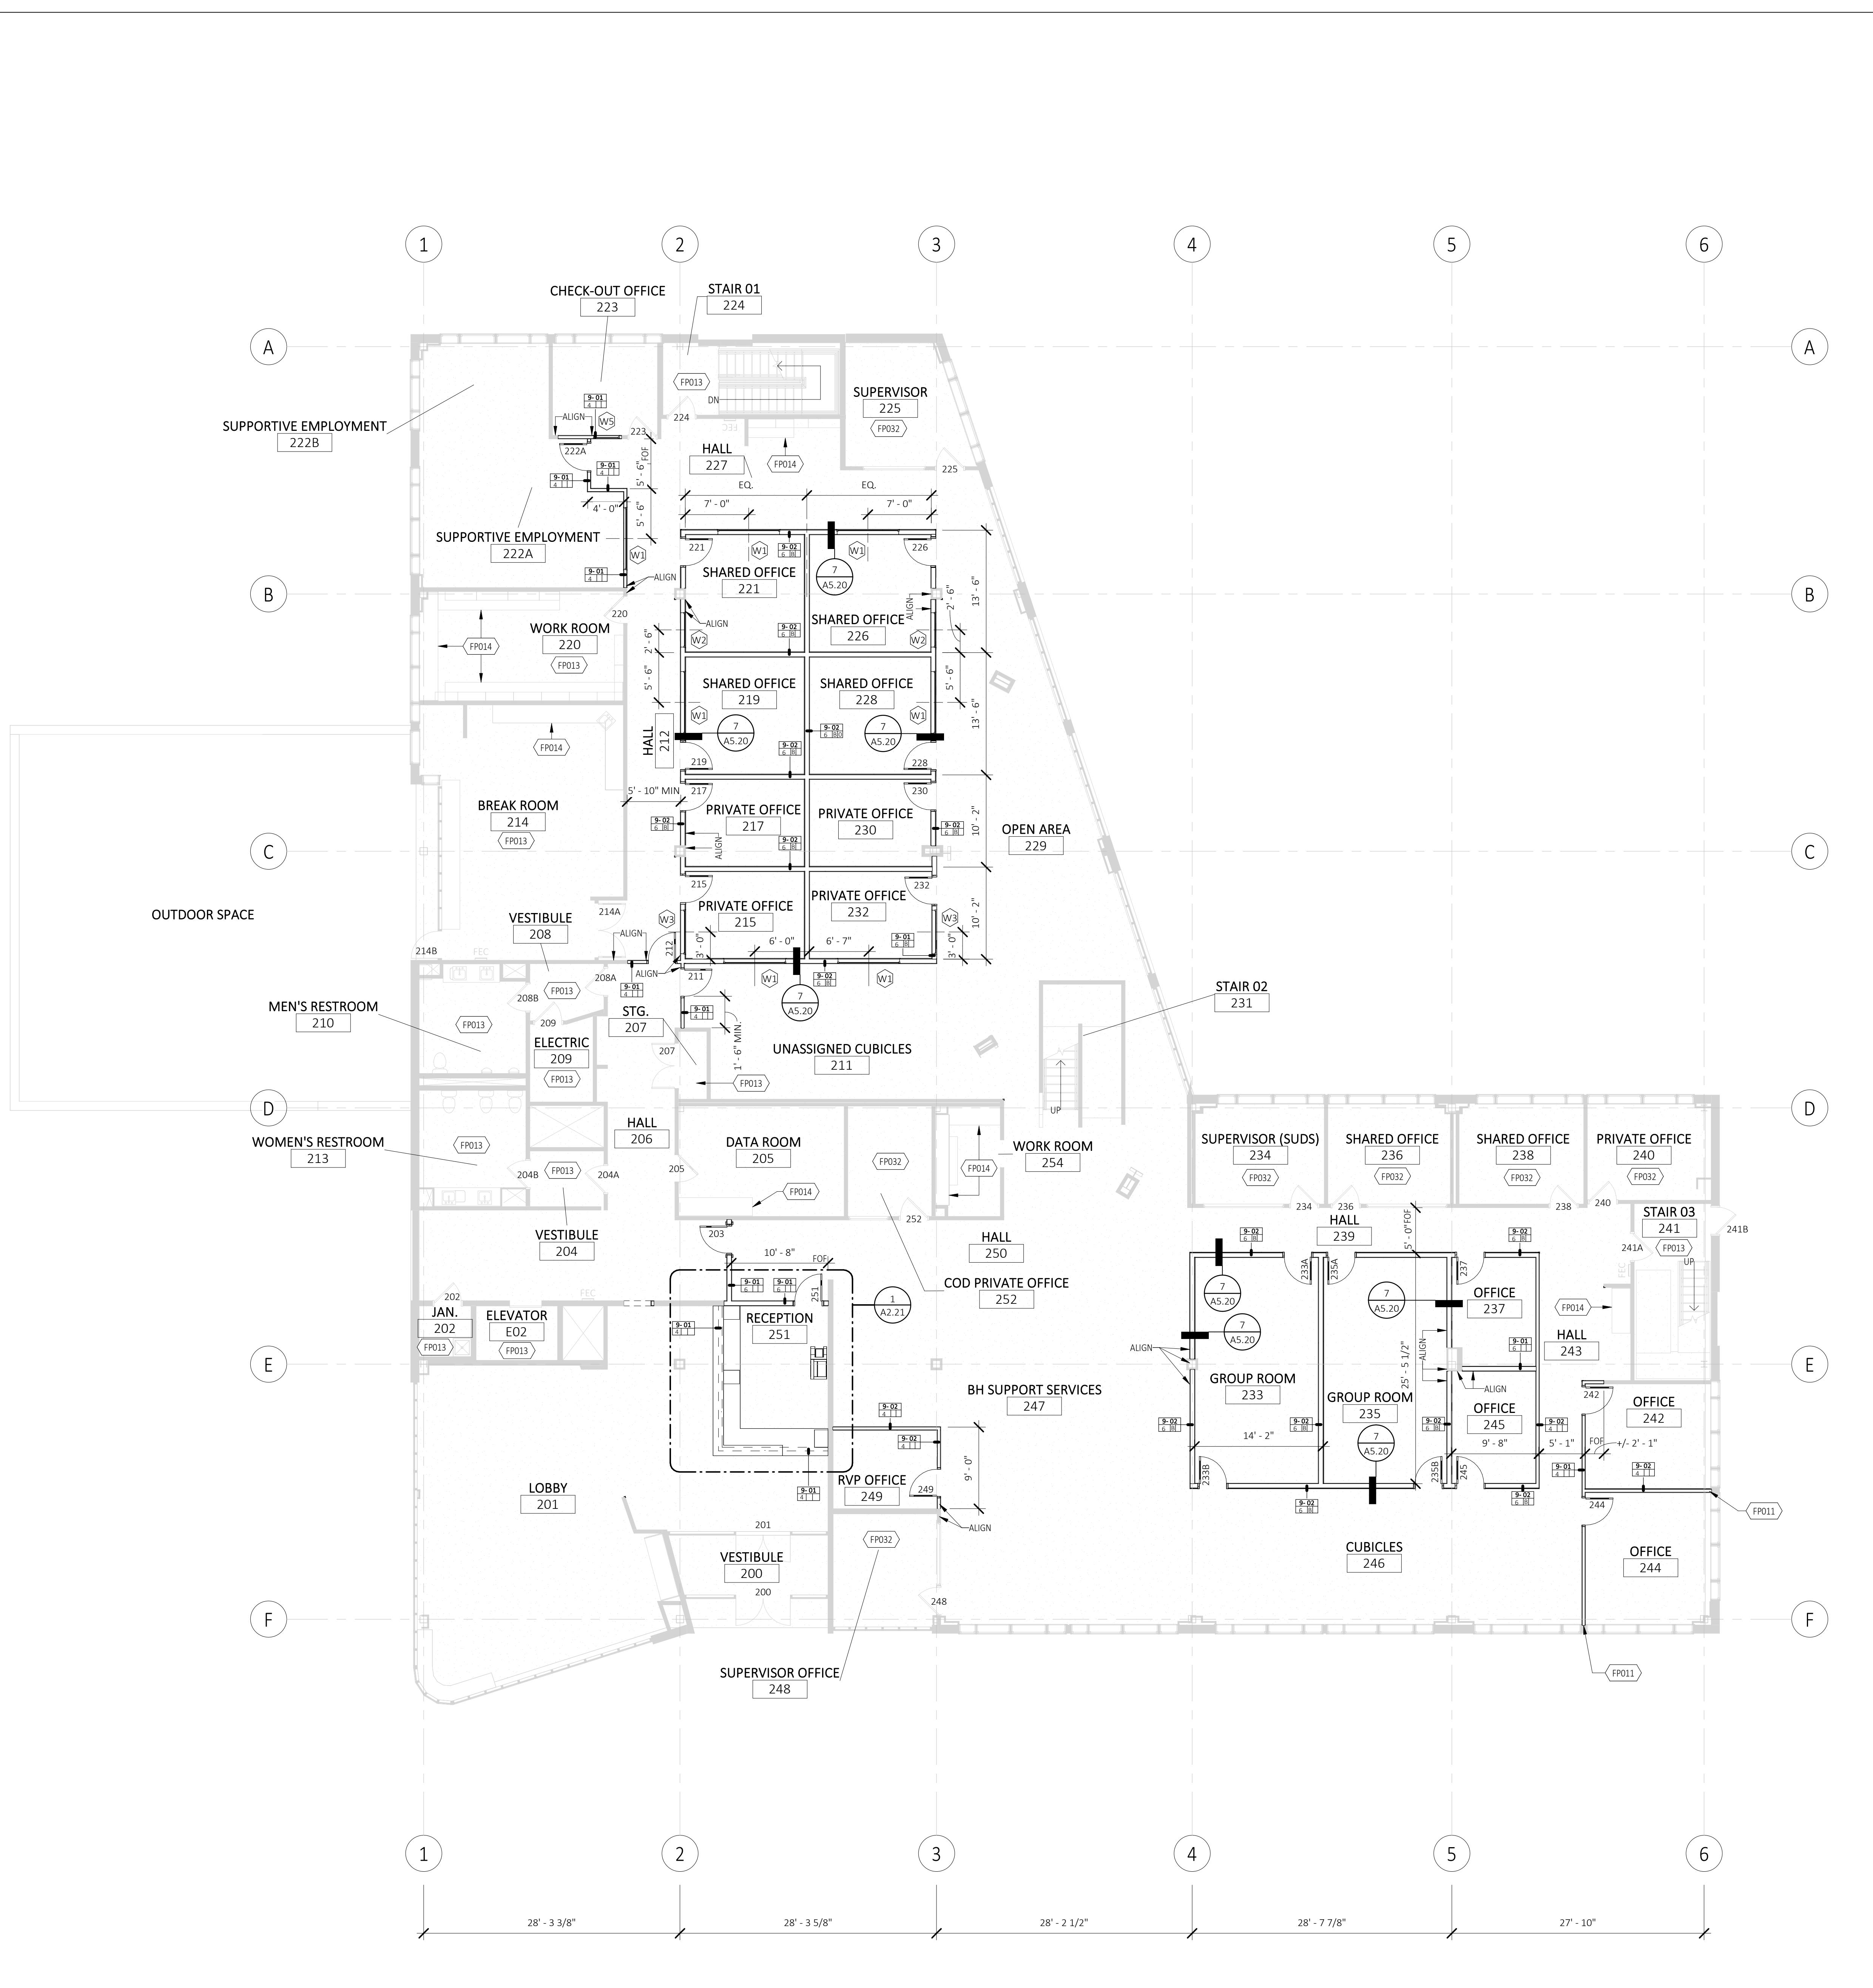

GENERAL FLOOR PLAN NOTES


- SEE SHEET A6.10 FOR WALL, FLOOR AND ROOF ASSEMBLIES.
- SEE G5.10 FOR MOUNTING HEIGHTS AND ACCESSIBILITY DETAILS.
- DOOR AND WINDOW DIMENSIONS ARE TO CENTER OF ROUGH OPENING, UNLESS NOTED OTHERWISE.
- WALL DIMENSIONS ARE TO FACE OF STUD AND/OR FACE OF CMU/CONCRETE, UNLESS NOTED OTHERWISE.
- CONTRACTORS TO FIELD VERIFY EXISTING ROUGH OPENING DIMENSIONS PRIOR TO ORDERING DOORS AND WINDOWS.
- ALL DOORS WITH GLAZING TO HAVE SAFETY GLAZING PER CODE.
- CONTRACTOR SHALL PROVIDE MEANS TO PROTECT THE PUBLIC AND WORKERS DURING THE DEMOLITION PROCESS.
- DOOR AND WINDOW SUPPLIER RESPONSIBLE FOR LOCATING HARDWARE IN ACCESSIBLE SPACES TO BE LESS THAN 48" ABOVE FINISH FLOOR INCLUDING BLIND CONTROLS.
- WINDOW SUPPLIER RESPONSIBLE FOR GLAZING WITHIN 24" OF DOORS TO BE TEMPERED.
- SEE FINISH FLOOR PLAN SHEETS FOR CORNER GUARD LOCATIONS.
- 1. RESILIENT CHANNEL TO NOT BE INSTALLED ON WALLS WITH MOUNTED FIXTURES. USE OPPOSITE SIDE WHEN POSSIBLE.
- 2. DOORS PERPENDICULAR TO WALLS TO BE MIN. 6" FROM ADJACENT WALL TYP. U.N.O.
- 3. ALL WALL TYPES WITHOUT HEAD CONDITIONS NOTED ARE EXISTING TO REMAIN OR TYPE C, WITH INSULATION OVER THE TOP OF THE HEAD CONNECTION. SEE 1,2 AND 3/A6.10.
- 4. ALL MECHANICAL AND ELECTRICAL SYSTEMS TO MEET CURRENT ENERGY CODE STANDARDS.

pinnacle architecture, inc.

"ENHANCING LIVES AND COMMUNITIES

1001 SW DISK DRIVE, SUITE 105
BEND OR 97702
541.388.9897
WWW.PINNACLEARCHITECTURE.COM

FLOOR PLAN LEGEND

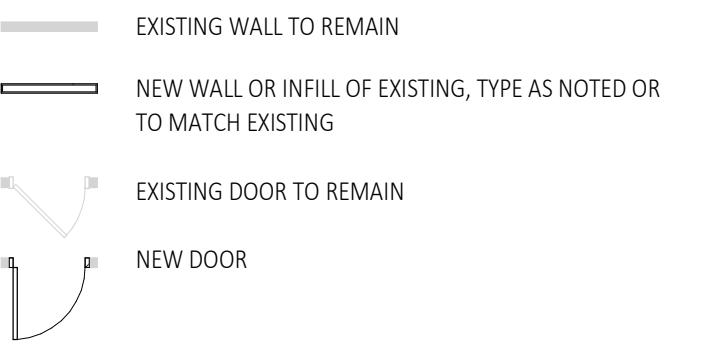

KEYNOTES - FLOOR PLANS

Key Value	Keynote Text
FP011	ALIGN NEW WALL WITH EXISTING MULLION
FP013	NO WORK ANTICIPATED IN THIS ROOM, REFER TO FINISH SCHEDULE AND PLAN FOR ANY PAINT UPDATES
FP014	(E) CASEWORK TO REMAIN IN PLACE
FP032	NO WORK ANTICIPATED IN THIS ROOM BEYOND NEW FINISH FLOOR, WALL BASE, OR WALL PAINT. REFER TO FINISH PLANS.

Lake Road Health Center

CLIENT:
CLACKAMAS COUNTY

PROJECT ADDRESS:
6605 SE Lake Rd, Milwaukie, OR
97222

APPROVED FOR DATE BY

 REV	DESCRIPTION	DATA
		
		
		
		
		
		
		
		
		
		
		
		
		
		

PROJECT NO: 2221.H
DRAWN BY: MALLORY FA
CHECKED BY: PETER BA
© PINNACLE ARCHITECTURE, INC. 2024 ORIGINAL SHEET SIZE: 30" x 42"

2ND FLOOR PLAN

A1.11


1 LEVEL_02
1/8" = 1'-0"



GENERAL RCP NOTES

1. EXISTING CEILING PLAN IS FOR GENERAL REFERENCE ONLY, FOR GENERAL COORDINATION OF FIXTURE TYPES AND LOCATIONS.
2. CEILING HEIGHTS AND TYPES TO BE VERIFIED IN FIELD.
3. REPLACE DAMAGED CEILING TILES AS REQUIRED.
4. REPLACE CEILING TILES AS REQUIRED FOR NEW LAYOUTS AND ACOUSTICAL PERFORMANCE PER WALL HEAD CONDITION.
5. MECHANICAL GRILLES, LOUVERS, LIGHTING, SPRINKLERS AND OTHER CEILING ITEMS TO BE ADJUSTED AS REQUIRED FOR NEW LAYOUTS.

REFLECTED CEILING PLAN LEGEND

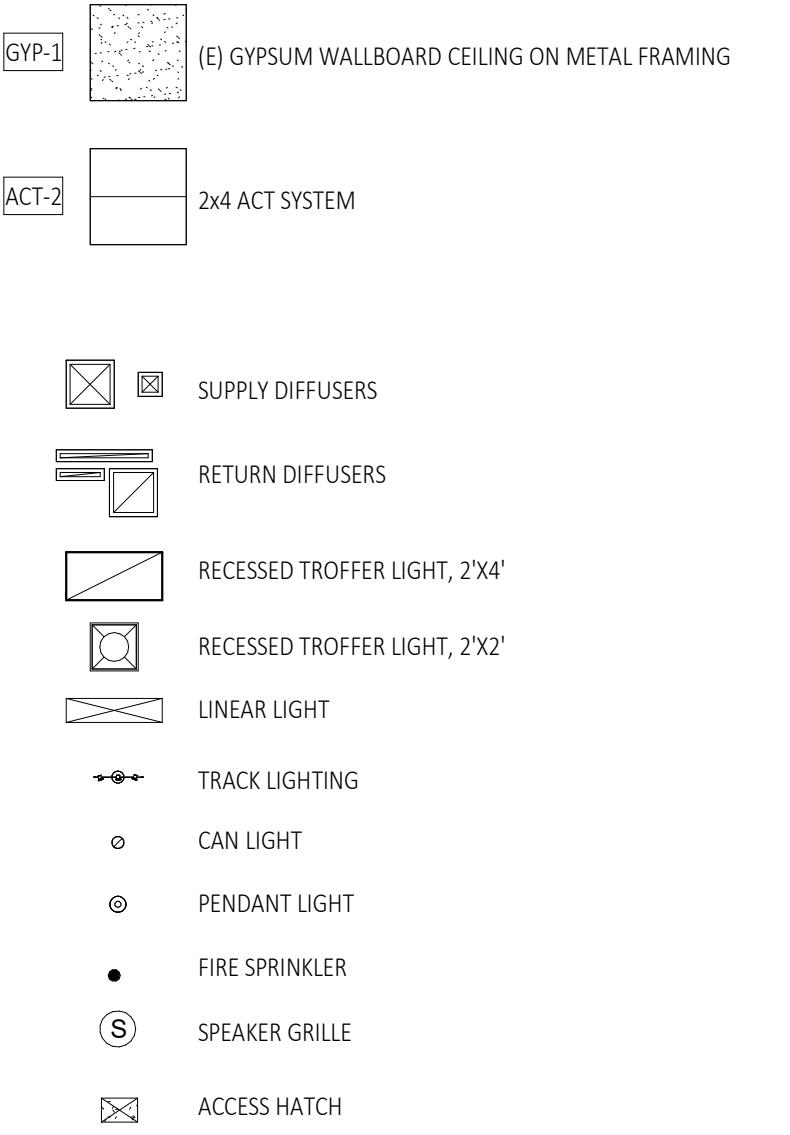

KEYNOTES

"ENHANCING LIVES AND COMMUNITIES"

1001 SW DISK DRIVE, SUITE 105
BEND OR 97702
541.388.9897
WWW.PINNACLEARCHITECTURE.COM



LAKE ROAD HEALTH CENTER

CLIENT:
CLACKAMAS COUNTY

PROJECT ADDRESS:
6605 SE Lake Rd, Milwaukie, OR
97222

APPROVED FOR DATE BY
BUILDING PERMIT 02.02.24 KK

	DESCRIPTION	DATE
		
		
		
		
		
		
		
		
		
		
		
		
		

PROJECT NO: 2221.HCR
DRAWN BY: MALLORY FAIR
CHECKED BY: PETER BAER
© PINNACLE ARCHITECTURE, INC. 2024 ORIGINAL SHEET SIZE: 30"x42"

1ST FLOOR EXISTING REFLECTED CEILING PLAN



A1.20

1 LEVEL_01 - EXISTING RCP
1/8" = 1'-0"

Autodesk Docs://2221.HCR Clackamas County Behavioral Health/2221.HCR Clackamas County Behavioral Health.rvt

Autodesk Docs://2221.HCR Clackamas County Behavioral Health/2221.HCR Clackamas County Behavioral Health.rvt

GENERAL RCP NOTES


1. EXISTING CEILING PLAN IS FOR GENERAL REFERENCE ONLY, FOR GENERAL COORDINATION OF FIXTURE TYPES AND LOCATIONS.
2. CEILING HEIGHTS AND TYPES TO BE VERIFIED IN FIELD.
3. REPLACE DAMAGED CEILING TILES AS REQUIRED.
4. REPLACE CEILING TILES AS REQUIRED FOR NEW LAYOUTS AND ACOUSTICAL PERFORMANCE PER WALL HEAD CONDITION.
5. MECHANICAL GRILLES, LOUVERS, LIGHTING, SPRINKLERS AND OTHER CEILING ITEMS TO BE ADJUSTED AS REQUIRED FOR NEW LAYOUTS.

ALL HEAD PENAS pinnacle architecture, inc.

"ENHANCING LIVES AND COMMUNITIES"

1001 SW DISK DRIVE, SUITE 105
BEND OR 97702
541.388.9897
WWW.PINNACLEARCHITECTURE.COM

REFLECTED CEILING PLAN LEGEND

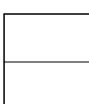GYP-1		(E) GYPSUM WALLBOARD CEILING ON METAL FRAMING
ACT-2		2x4 ACT SYSTEM
		SUPPLY DIFFUSERS
		RETURN DIFFUSERS
		RECESSED TROFFER LIGHT, 2'X4'
		RECESSED TROFFER LIGHT, 2'X2'
		LINEAR LIGHT
		TRACK LIGHTING
		CAN LIGHT
		PENDANT LIGHT
		FIRE SPRINKLER
		SPEAKER GRILLE
		ACCESS HATCH

KEYNOTES	
Key	Value
Keynote Text	

A circular registration stamp for Peter E. Baer. The outer ring contains the text "REGISTERED ARCHITECT" at the top and "STATE OF OREGON" at the bottom. The center of the stamp contains "PETER E. BAER" on the top line and "BEND, OREGON" on the bottom line, with the number "3079" centered below "BEND, OREGON".

LAKE ROAD HEALTH CENTER

CLIENT:
CLACKAMAS COUNTY

PROJECT ADDRESS:
6605 SE Lake Rd, Milwaukie, OR
97222

APPROVED FOR	DATE	BY
BUILDING PERMIT	02.02.24	KK

 REV	DESCRIPTION	DATE
		
		
		
		
		
		
		
		
		
		
		
		
		

PROJECT NO: 2221.HCR
DRAWN BY: MALLORY FAIR
CHECKED BY: PETER BAER
© PINNACLE ARCHITECTURE, INC. 2024 ORIGINAL SHEET SIZE: 30"X42"

2ND FLOOR EXISTING REFLECTED CEILING PLAN

A1.21

A black circular icon containing a white stylized 'N' shape, representing the cardinal direction North.

A1.21

This is a detailed architectural floor plan of a multi-story building, likely a residential or institutional structure. The plan is oriented with a grid system and various rooms, windows, and structural elements. Key features include:

- Rooms:** The building contains numerous rooms, many of which are labeled with letters (A, B, C, D, E, F) and numbers (1, 2, 3, 4, 5, 6) at the perimeter. Some rooms are indicated by dashed lines.
- Windows:** Windows are represented by various symbols: solid circles, open circles, squares with diagonal lines, and squares with 'X' marks. Some windows are labeled with 'S'.
- Staircase:** A central staircase is shown with a diagonal line and a small platform. It is labeled "OPEN TO ABOVE" with dashed lines indicating the upper levels.
- Structural Elements:** The plan shows columns, beams, and other structural components. A label "GFCI" is visible near the bottom left.
- Labels:** The perimeter of the plan is labeled with letters A through F and numbers 1 through 6, corresponding to specific points on the grid.

2 LEVEL_02 - EXISTING RCP
1/8" = 1'-0"

GENERAL RCP NOTES

1. EXISTING CEILING PLAN IS FOR GENERAL REFERENCE ONLY, FOR GENERAL COORDINATION OF FIXTURE TYPES AND LOCATIONS.
2. CEILING HEIGHTS AND TYPES TO BE VERIFIED IN FIELD.
3. REPLACE DAMAGED CEILING TILES AS REQUIRED.
4. REPLACE CEILING TILES AS REQUIRED FOR NEW LAYOUTS AND ACOUSTICAL PERFORMANCE PER WALL HEAD CONDITION.
5. MECHANICAL GRILLES, LOUVERS, LIGHTING, SPRINKLERS AND OTHER CEILING ITEMS TO BE ADJUSTED AS REQUIRED FOR NEW LAYOUTS.

ALL HEAD ED AS pinnacle architecture, inc.

"ENHANCING LIVES AND COMMUNITIES"

1001 SW DISK DRIVE, SUITE 105
BEND OR 97702
541.388.9897
WWW.PINNACLEARCHITECTURE.COM

REFLECTED CEILING PLAN LEGEND

 GYP-1 (E) GYPSUM WALLBOARD CEILING ON METAL FRAMING

 ACT-2 2x4 ACT SYSTEM

  SUPPLY DIFFUSERS

 RETURN DIFFUSERS

 RECESSED TROFFER LIGHT, 2'X4'

 RECESSED TROFFER LIGHT, 2'X2'

 LINEAR LIGHT

 TRACK LIGHTING

 CAN LIGHT

 PENDANT LIGHT

 FIRE SPRINKLER

 SPEAKER GRILLE

 ACCESS HATCH

KEYNOTES	
Key	Value
Key	Value

A circular seal for a registered architect. The outer ring contains the text "REGISTERED ARCHITECT" at the top and "STATE OF OREGON" at the bottom, both in a bold, sans-serif font. The inner circle contains "PETER E. BAER" at the top and "BEND, OREGON" at the bottom, with the number "3079" centered below "BEND, OREGON".

LAKE ROAD HEALTH CENTER

PROJECT ADDRESS:
6605 SE Lake Rd, Milwaukie, OR
97222

PROJECT ADDRESS:
6605 SE Lake Rd, Milwaukie, OR
97222

PROJECT ADDRESS:
6605 SE Lake Rd, Milwaukie, OR
97222


APPROVED FOR DATE BY
BUILDING PERMIT 02.02.24 K

PROJECT NO: 2221.HC
DRAWN BY: MALLORY FA
CHECKED BY: PETER BA
© PINNACLE ARCHITECTURE, INC. 2024 ORIGINAL SHEET SIZE: 30" x 42"

3RD FLOOR EXISTING REFLECTED CEILING PLAN

A1.22

2/5/2024 4:49:03 PM

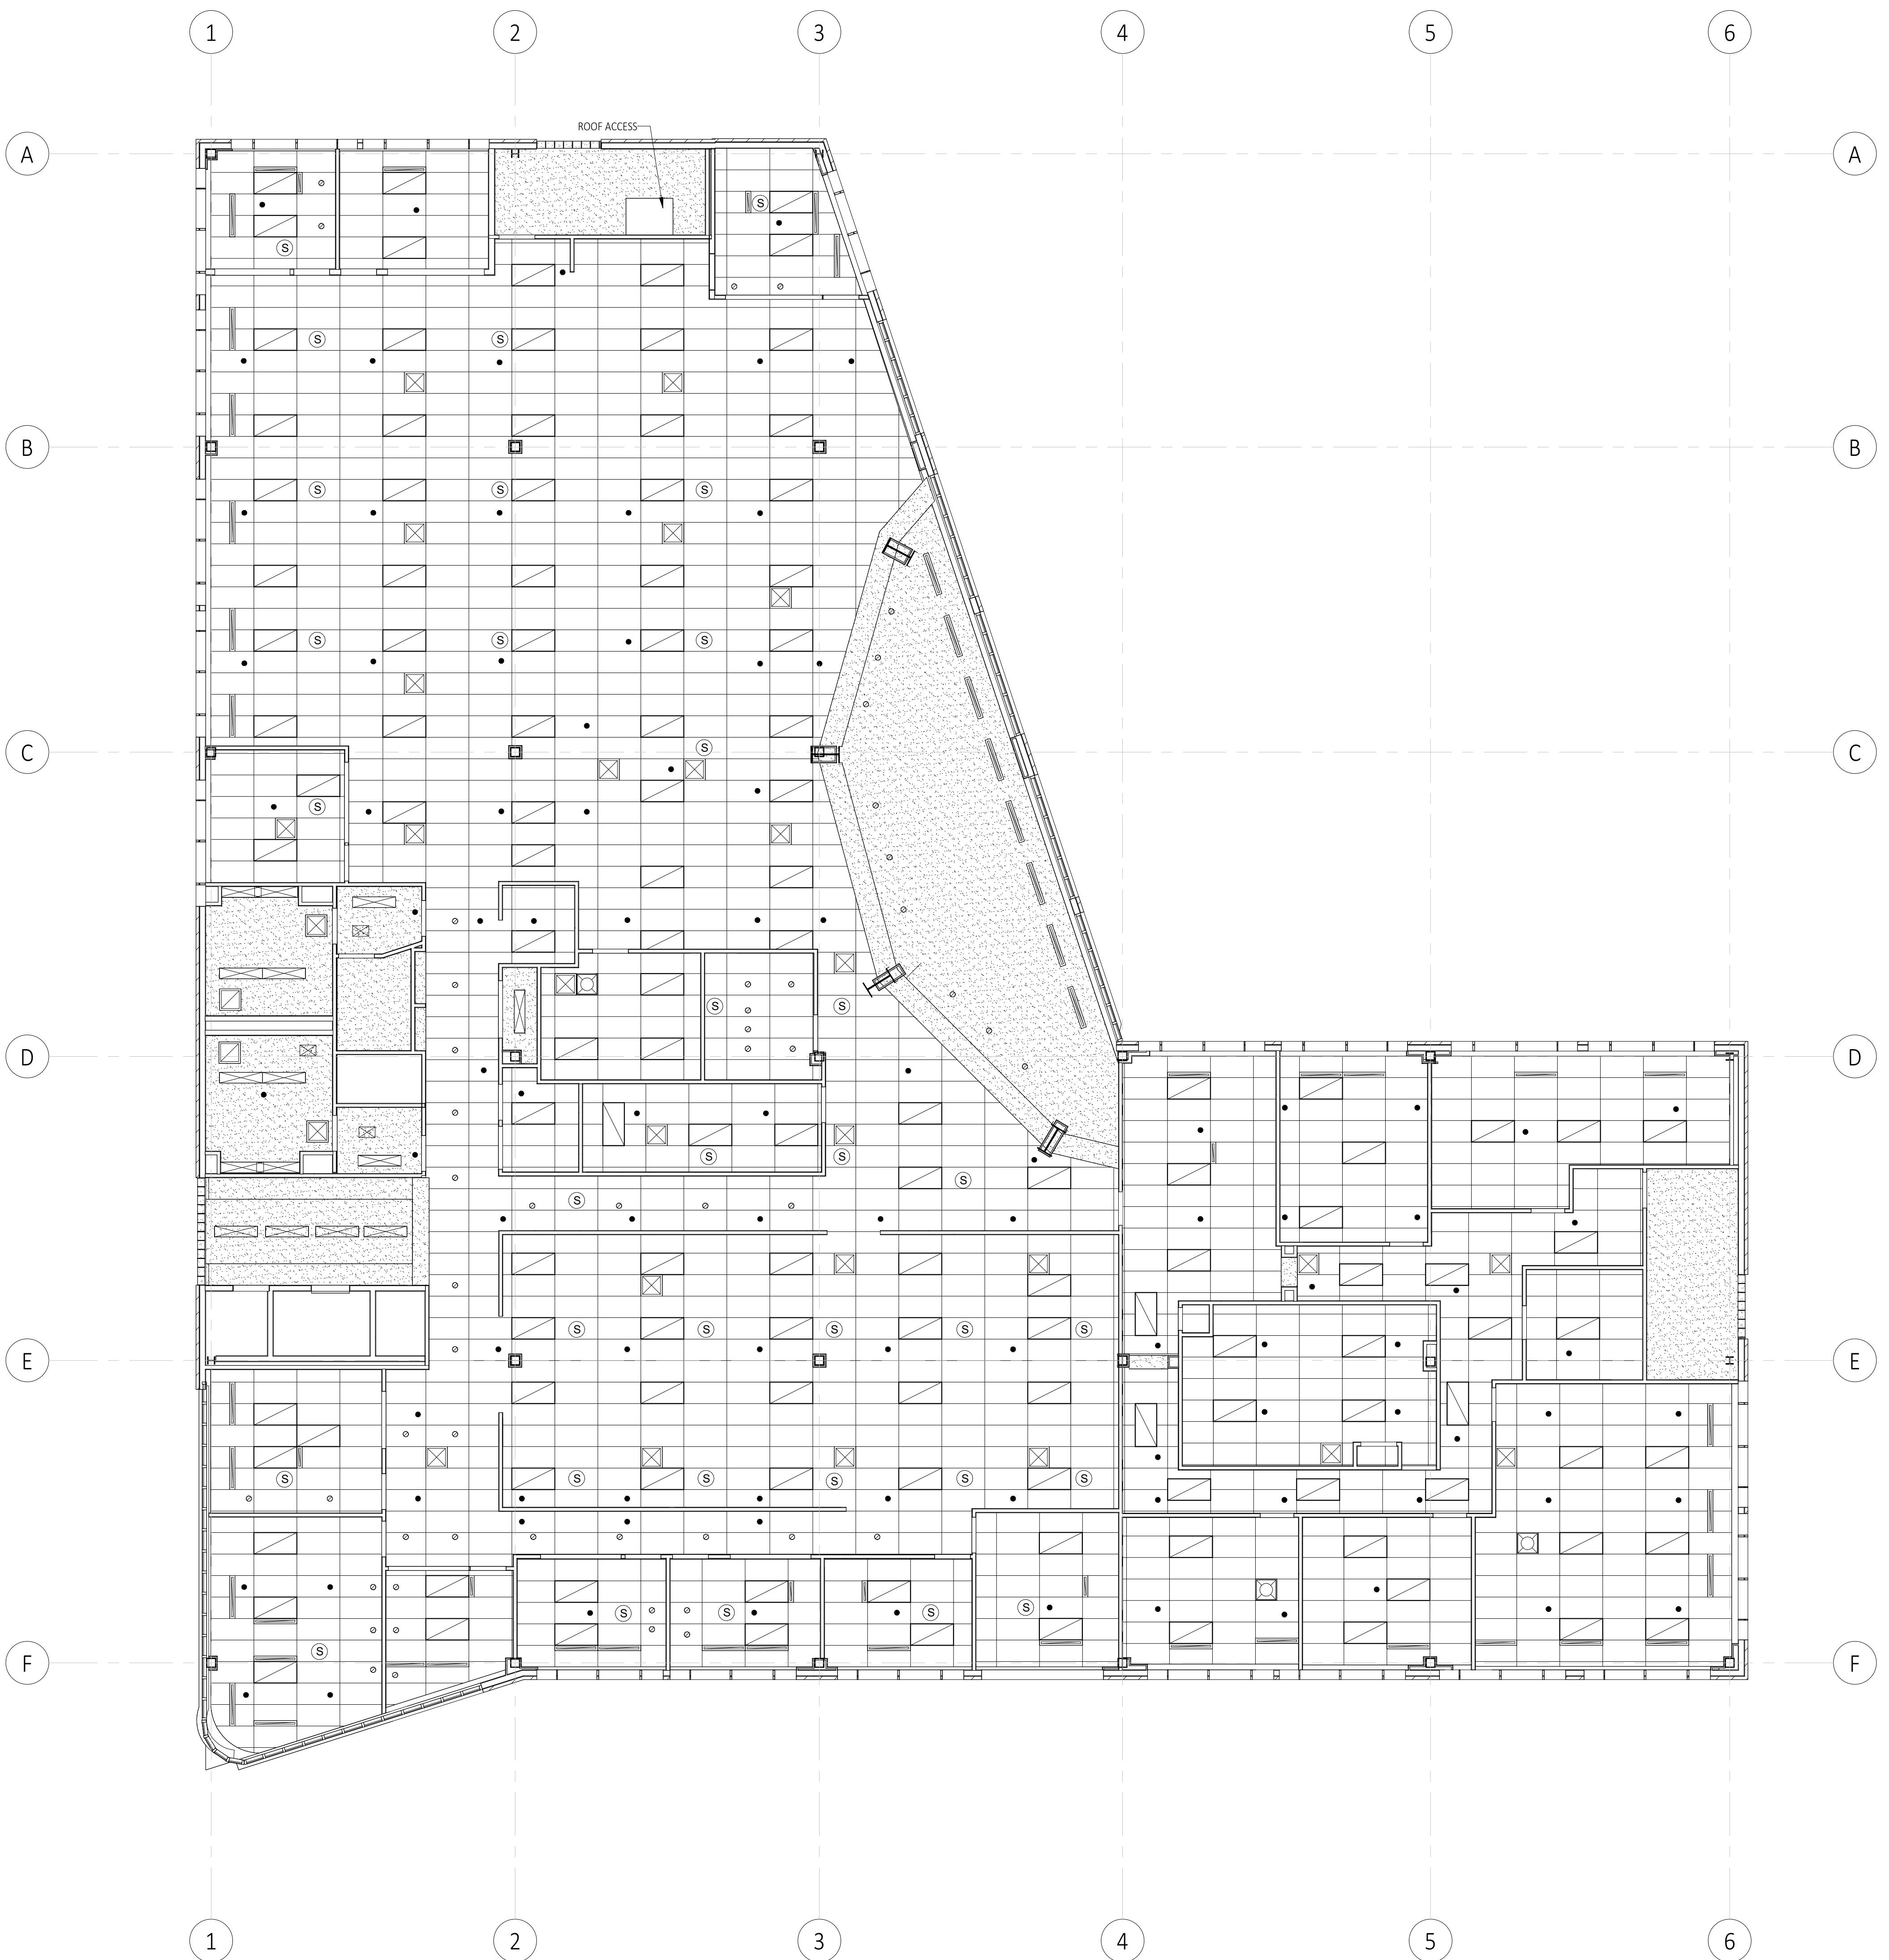

2 LEVEL_03 - EXISTING RCF
1/8" = 1'-0"

A1.22


GENERAL FINISH FLOOR PLAN NOTES

1. NEW FINISHES TO BE ADDED TO AREAS WITH WORK ONLY, UNO.
2. REFER TO SHEET G0.11 FOR ABBREVIATIONS.
3. REFER TO SHEET A1.43 FOR INTERIOR FINISH SCHEDULE.
4. REFER TO SHEET A1.43 FOR INTERIOR FINISH KEY.
5. ALL WALLS AND GWB CEILING TO BE PAINTED P-1, UNLESS NOTED OTHERWISE.
6. ALL OFFICE WALLS TO BE PAINTED P-2, UNLESS NOTED OTHERWISE.
7. TYPE "L" WALL BASE TO BE RB1, UNO.
8. WALL BASE TO BE PAINTED, PANTRY'S, CLOSETS, RESTROOMS, AND OTHER WET AREAS, UNO.
9. PATCH AND REPAIR EXISTING WALL AS REQUIRED BEFORE APPLYING NEW PAINT.
10. ANY EXISTING WALLS TO RECEIVE NEW PAINT TO BE PAINTED THE FULL LENGTH OF THE WALL.
11. "CG X" INDICATES CORNER GUARD LOCATION, WITH "X" INDICATING TYPE PER FINISH KEY.



"ENHANCING LIVES AND COMMUNITIES"


1001 SW DISK DRIVE, SUITE 105
BEND OR 97702
541.388.9897
WWW.PINNACLEARCHITECTURE.COM

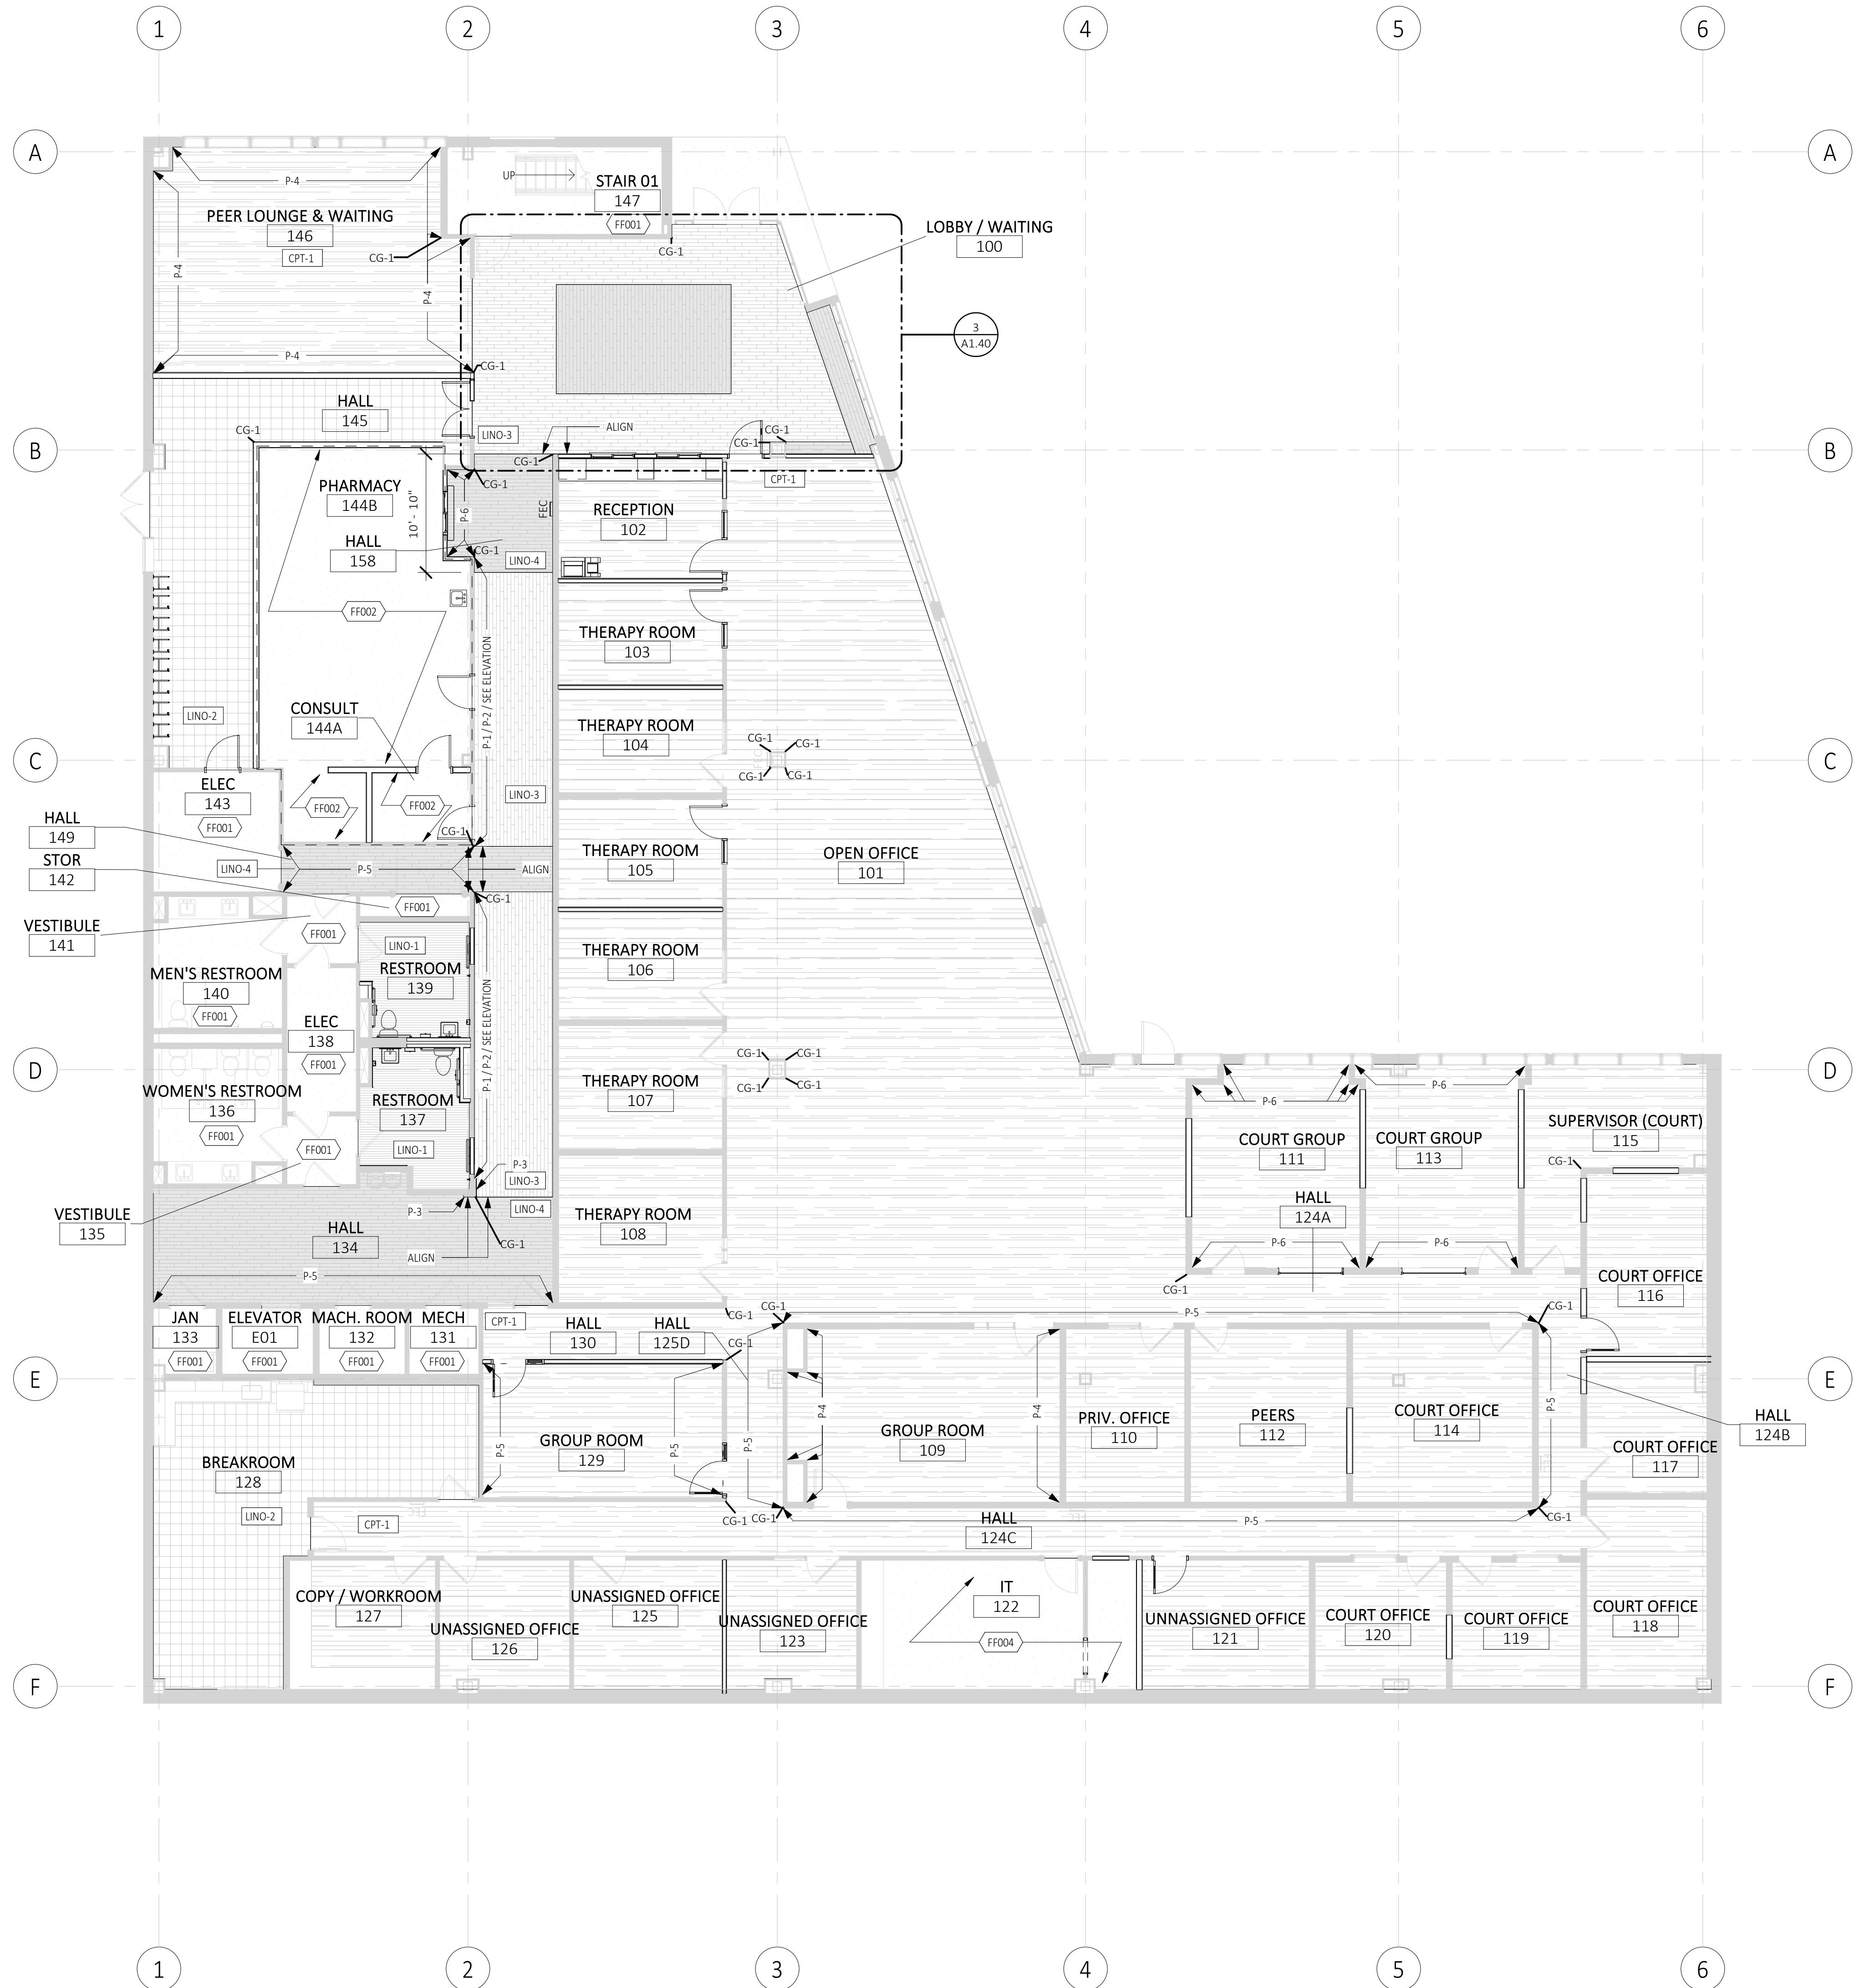

1 LEVEL_01 - FINISH FLOOR PLAN
1/8" = 1'-0"


Autodesk Docs/2221 HCR Clackamas County Behavioral Health/2221 HCR Clackamas County Behavioral Health.rvt

3 LEVEL_01 - FINISH FLOOR PLAN - Callout 1
1/4" = 1'-0"

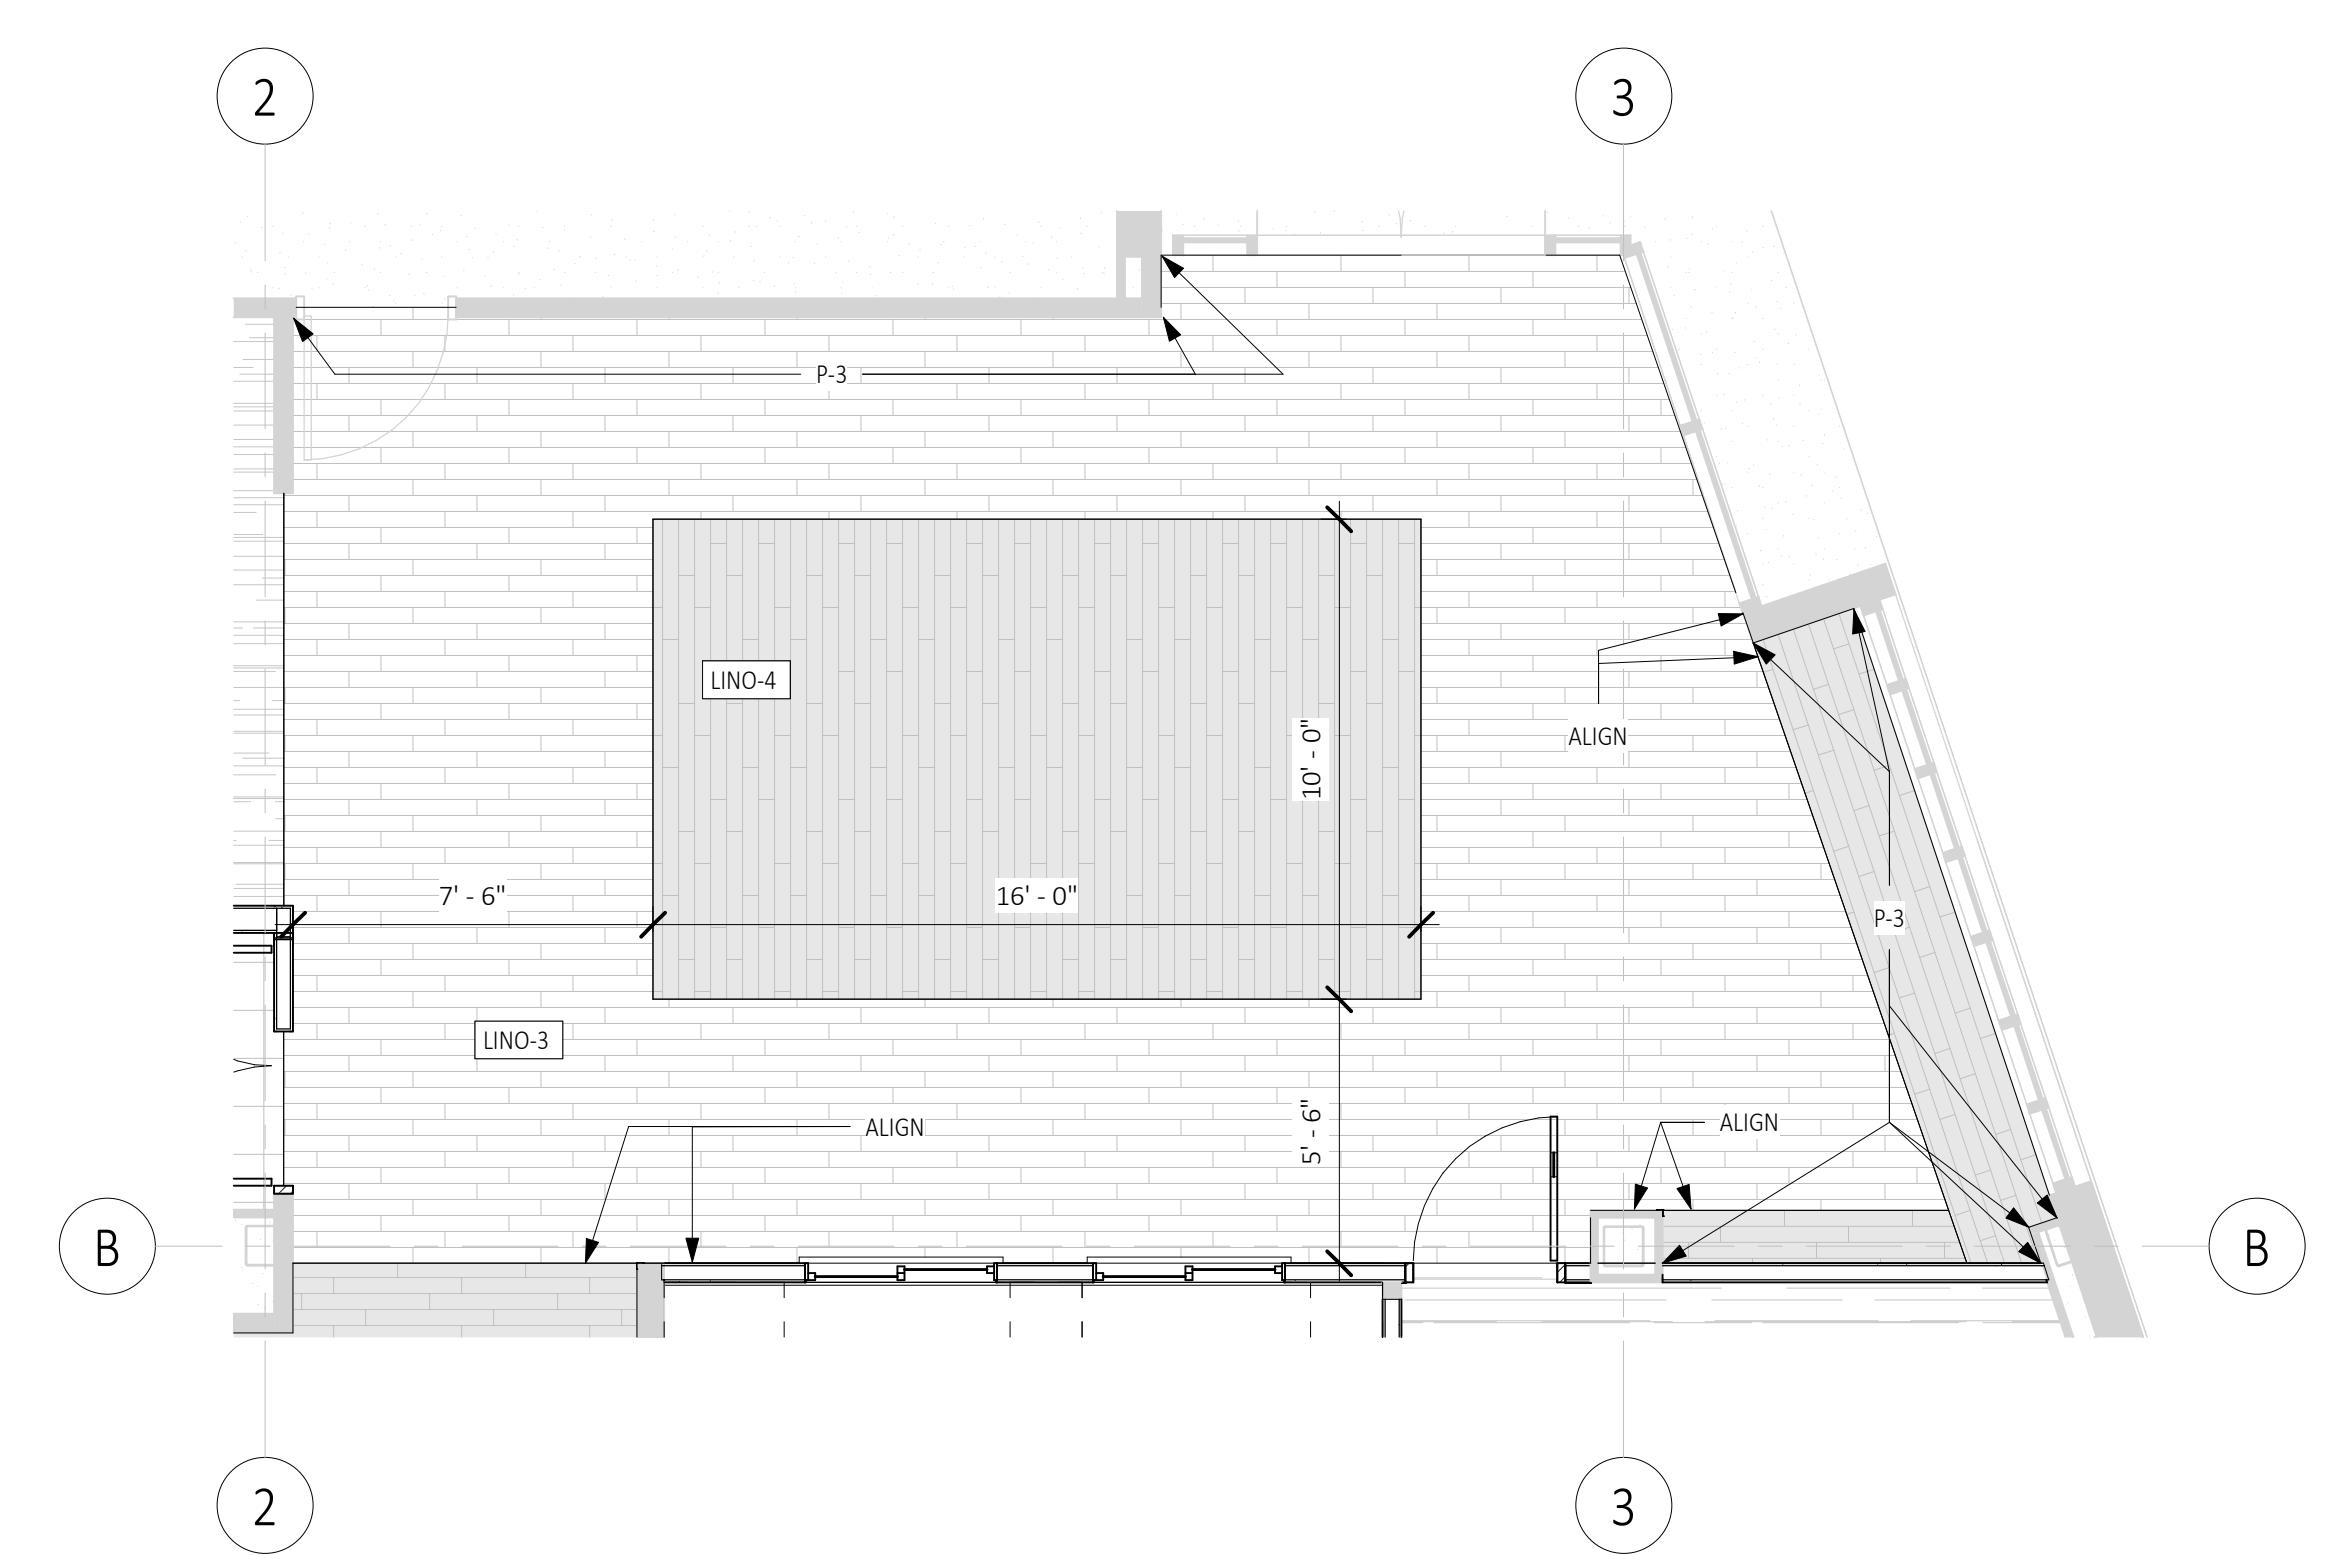

A1.40
NORTH

FINISH FLOOR LEGEND

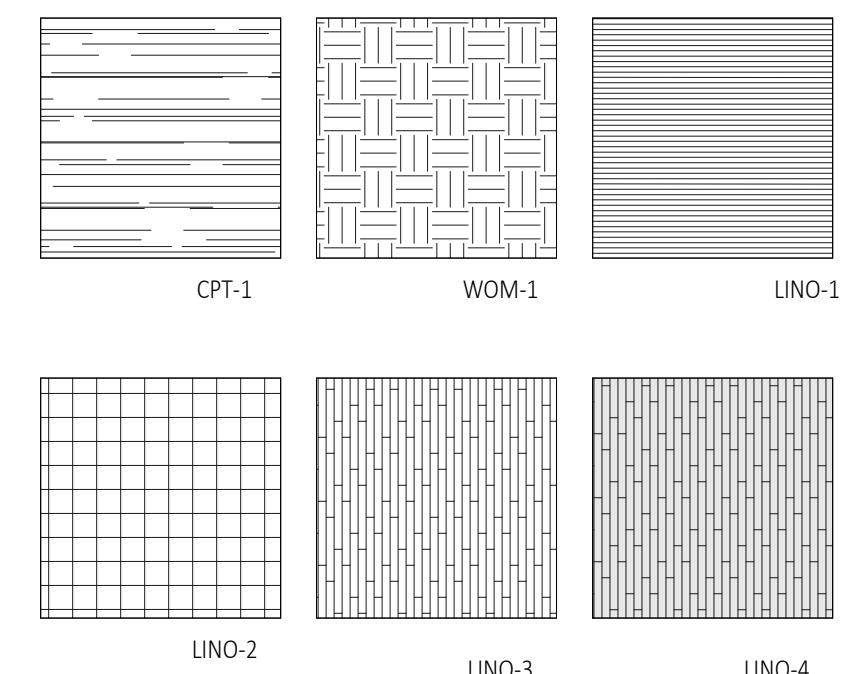

KEYNOTES - FINISH FLOOR PLANS

Key Value	Keynote Text
FF001	NO WORK ANTICIPATED IN THIS ROOM
FF002	AREA OF WORK BY OTHERS; SEE GENOA DRAWINGS
FF004	NO NEW FLOORING ANTICIPATED IN THIS ROOM; PATCH & PAINT OR REPLACE FLOORING AS REQ'D AS AFFECTED BY CONSTRUCTION



LAKE ROAD HEALTH CENTER

CLIENT:
CLACKAMAS COUNTY

PROJECT ADDRESS:
6605 SE Lake Rd, Milwaukie, OR
97222

APPROVED FOR DATE BY

BUILDING PERMIT 02.02.24 KK

DESCRIPTION DATE

PROJECT NO: 2221 HCR
DRAWN BY: MALLORY FAIR
CHECKED BY: PETER BAER
© PINNACLE ARCHITECTURE, INC. 2024 ORIGINAL SHEET SIZE: 30" x 42"

1ST FLOOR FINISH FLOOR PLAN

2/5/2024 4:49:06 PM

GENERAL FINISH FLOOR PLAN NOTES



1. NEW FINISHES TO BE ADDED TO EXISTING WORK ONLY, UNO.
2. REFER TO SHEET A1.43 FOR EXISTING FINISH.
3. REFER TO SHEET A1.43 FOR INTERIOR FINISH SCHEDULE.
4. REFER TO SHEET A1.43 FOR INTERIOR FINISH KEY.
5. ALL WALLS AND GWA CEILING TO BE PAINTED P-1, UNLESS NOTED OTHERWISE.
6. ALL OFFICE WALLS TO BE PAINTED P-2, UNLESS NOTED OTHERWISE.
7. TYPICAL WALL BASE TO BE RE-B-1, UNO.
8. WALL BASE, RB-2, TO BE USED IN JANITOR'S CLOSETS, RESTROOMS, AND OTHER WET AREAS, UNO.
9. PATCH AND REPAIR EXISTING WALLS AS REQUIRED BEFORE APPLYING NEW PAINT.
10. ANY EXISTING WALLS TO RECEIVE NEW PAINT TO BE PAINTED THE FULL LENGTH OF THE WALL.
11. "CG-X" INDICATES CORNER GUARD LOCATION, WITH "X" INDICATING TYPE PER FINISH KEY.

pinnacle
architecture, inc.

"ENHANCING LIVES AND COMMUNITIES"

1001 SW DISK DRIVE, SUITE 105
BEND OR 97702
541.388.9897
WWW.PINNACLEARCHITECTURE.COM

FINISH FLOOR LEGEND

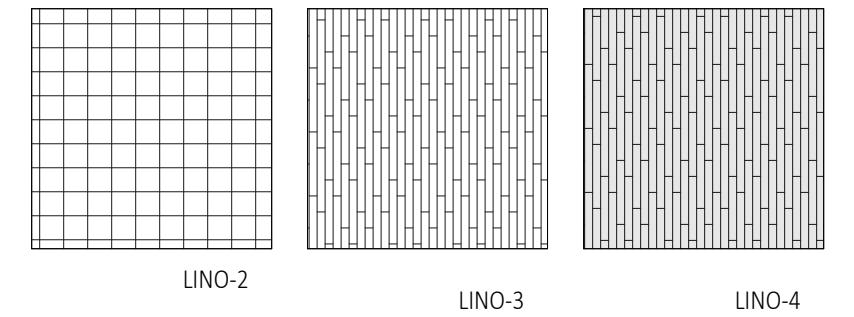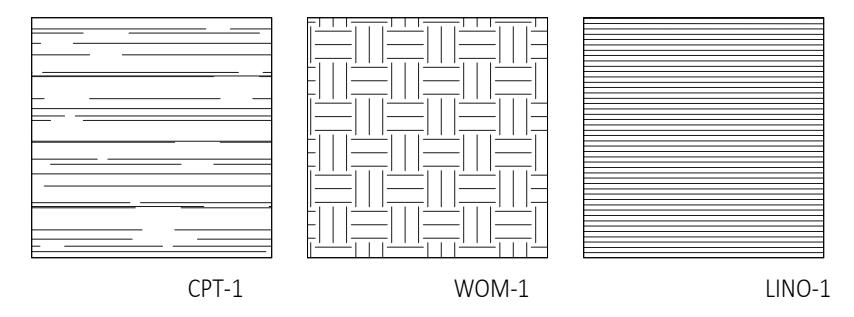

KEYNOTES - FINISH FLOOR PLANS

Key Value	Keynote Text
FF001	NO WORK ANTICIPATED IN THIS ROOM
FF004	NO NEW FLOORING ANTICIPATED IN THIS ROOM; PATCH & PAINT OR REPLACE FLOORING AS REQ'D AS AFFECTED BY CONSTRUCTION

REGISTERED ARCHITECT
PETER E. BAER
BEND, OREGON
STATE OF OREGON
3078

LAKE ROAD HEALTH CENTER


CLIENT:
CLACKAMAS COUNTY

PROJECT ADDRESS:
6605 SE Lake Rd, Milwaukie, OR
97222


APPROVED FOR DATE BY
BUILDING PERMIT 02.02.24 KK

DESCRIPTION DATE
PROJECT NO: 2221 HCR
DRAWN BY: MALLORY FAIR
CHECKED BY: PETER BAER
© PINNACLE ARCHITECTURE, INC. 2024 ORIGINAL SHEET SIZE: 30" x 42"

2ND FLOOR FINISH FLOOR PLAN

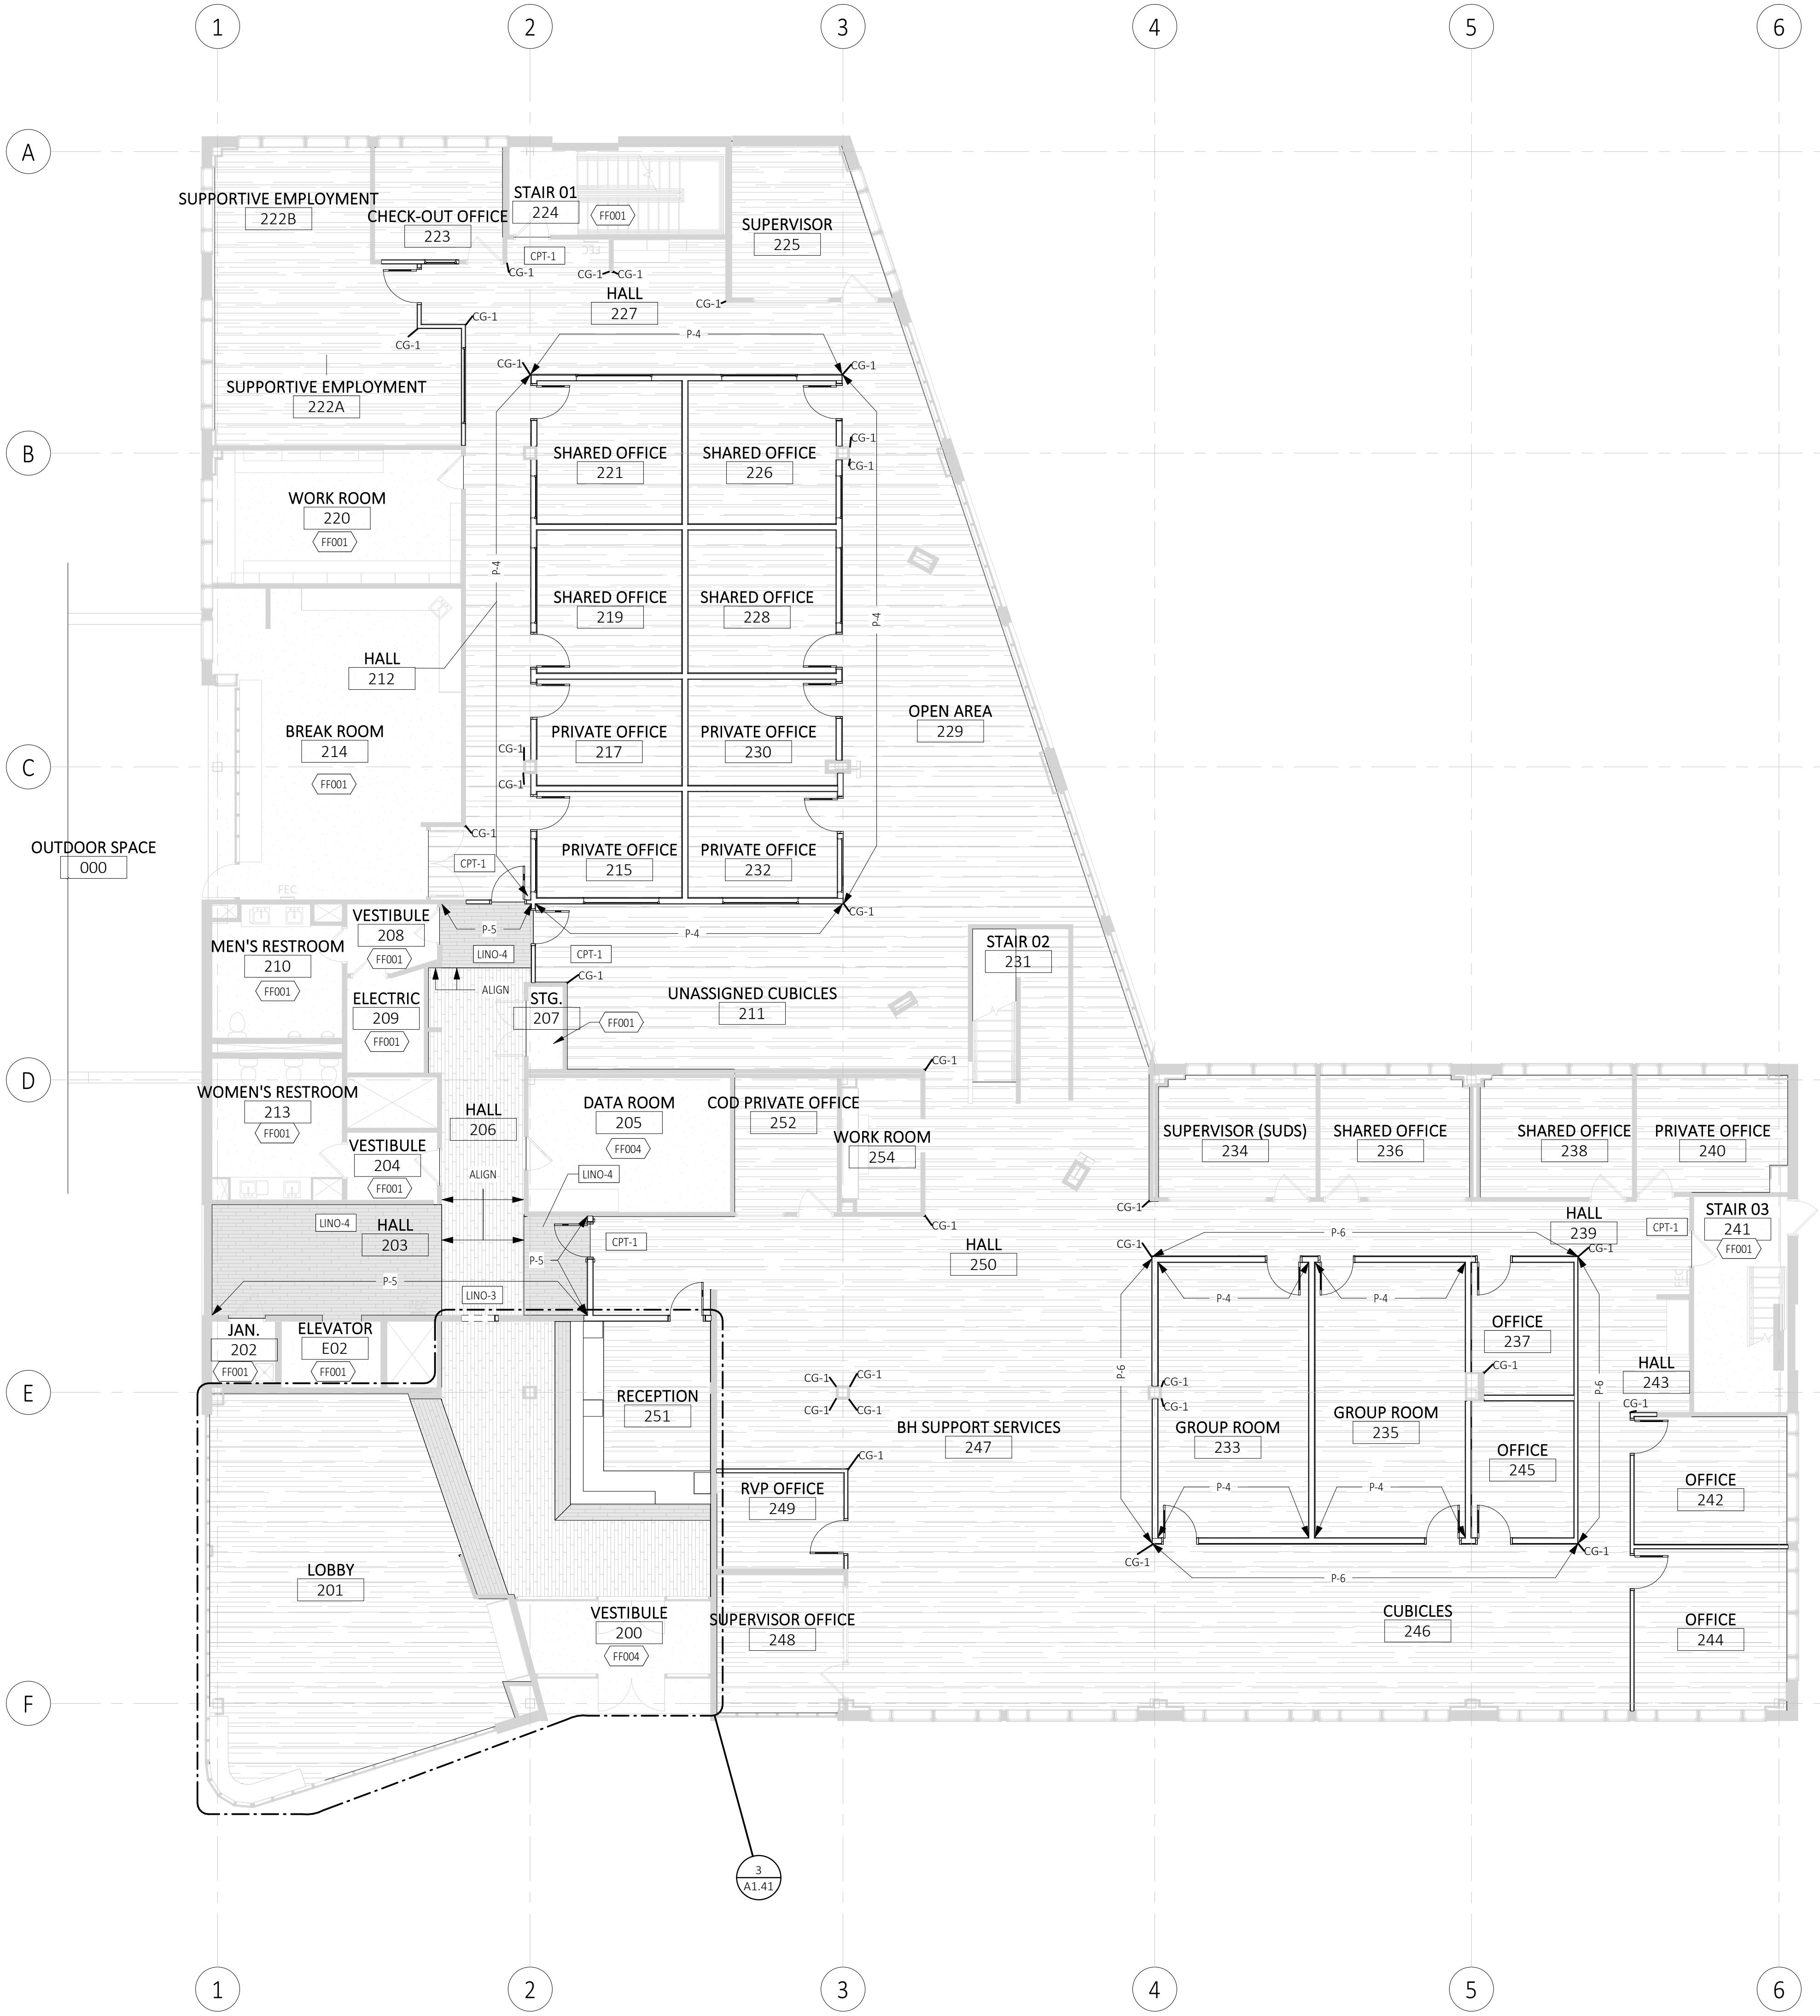

1 LEVEL_02 - FINISH FLOOR PLAN
1/8" = 1'-0"

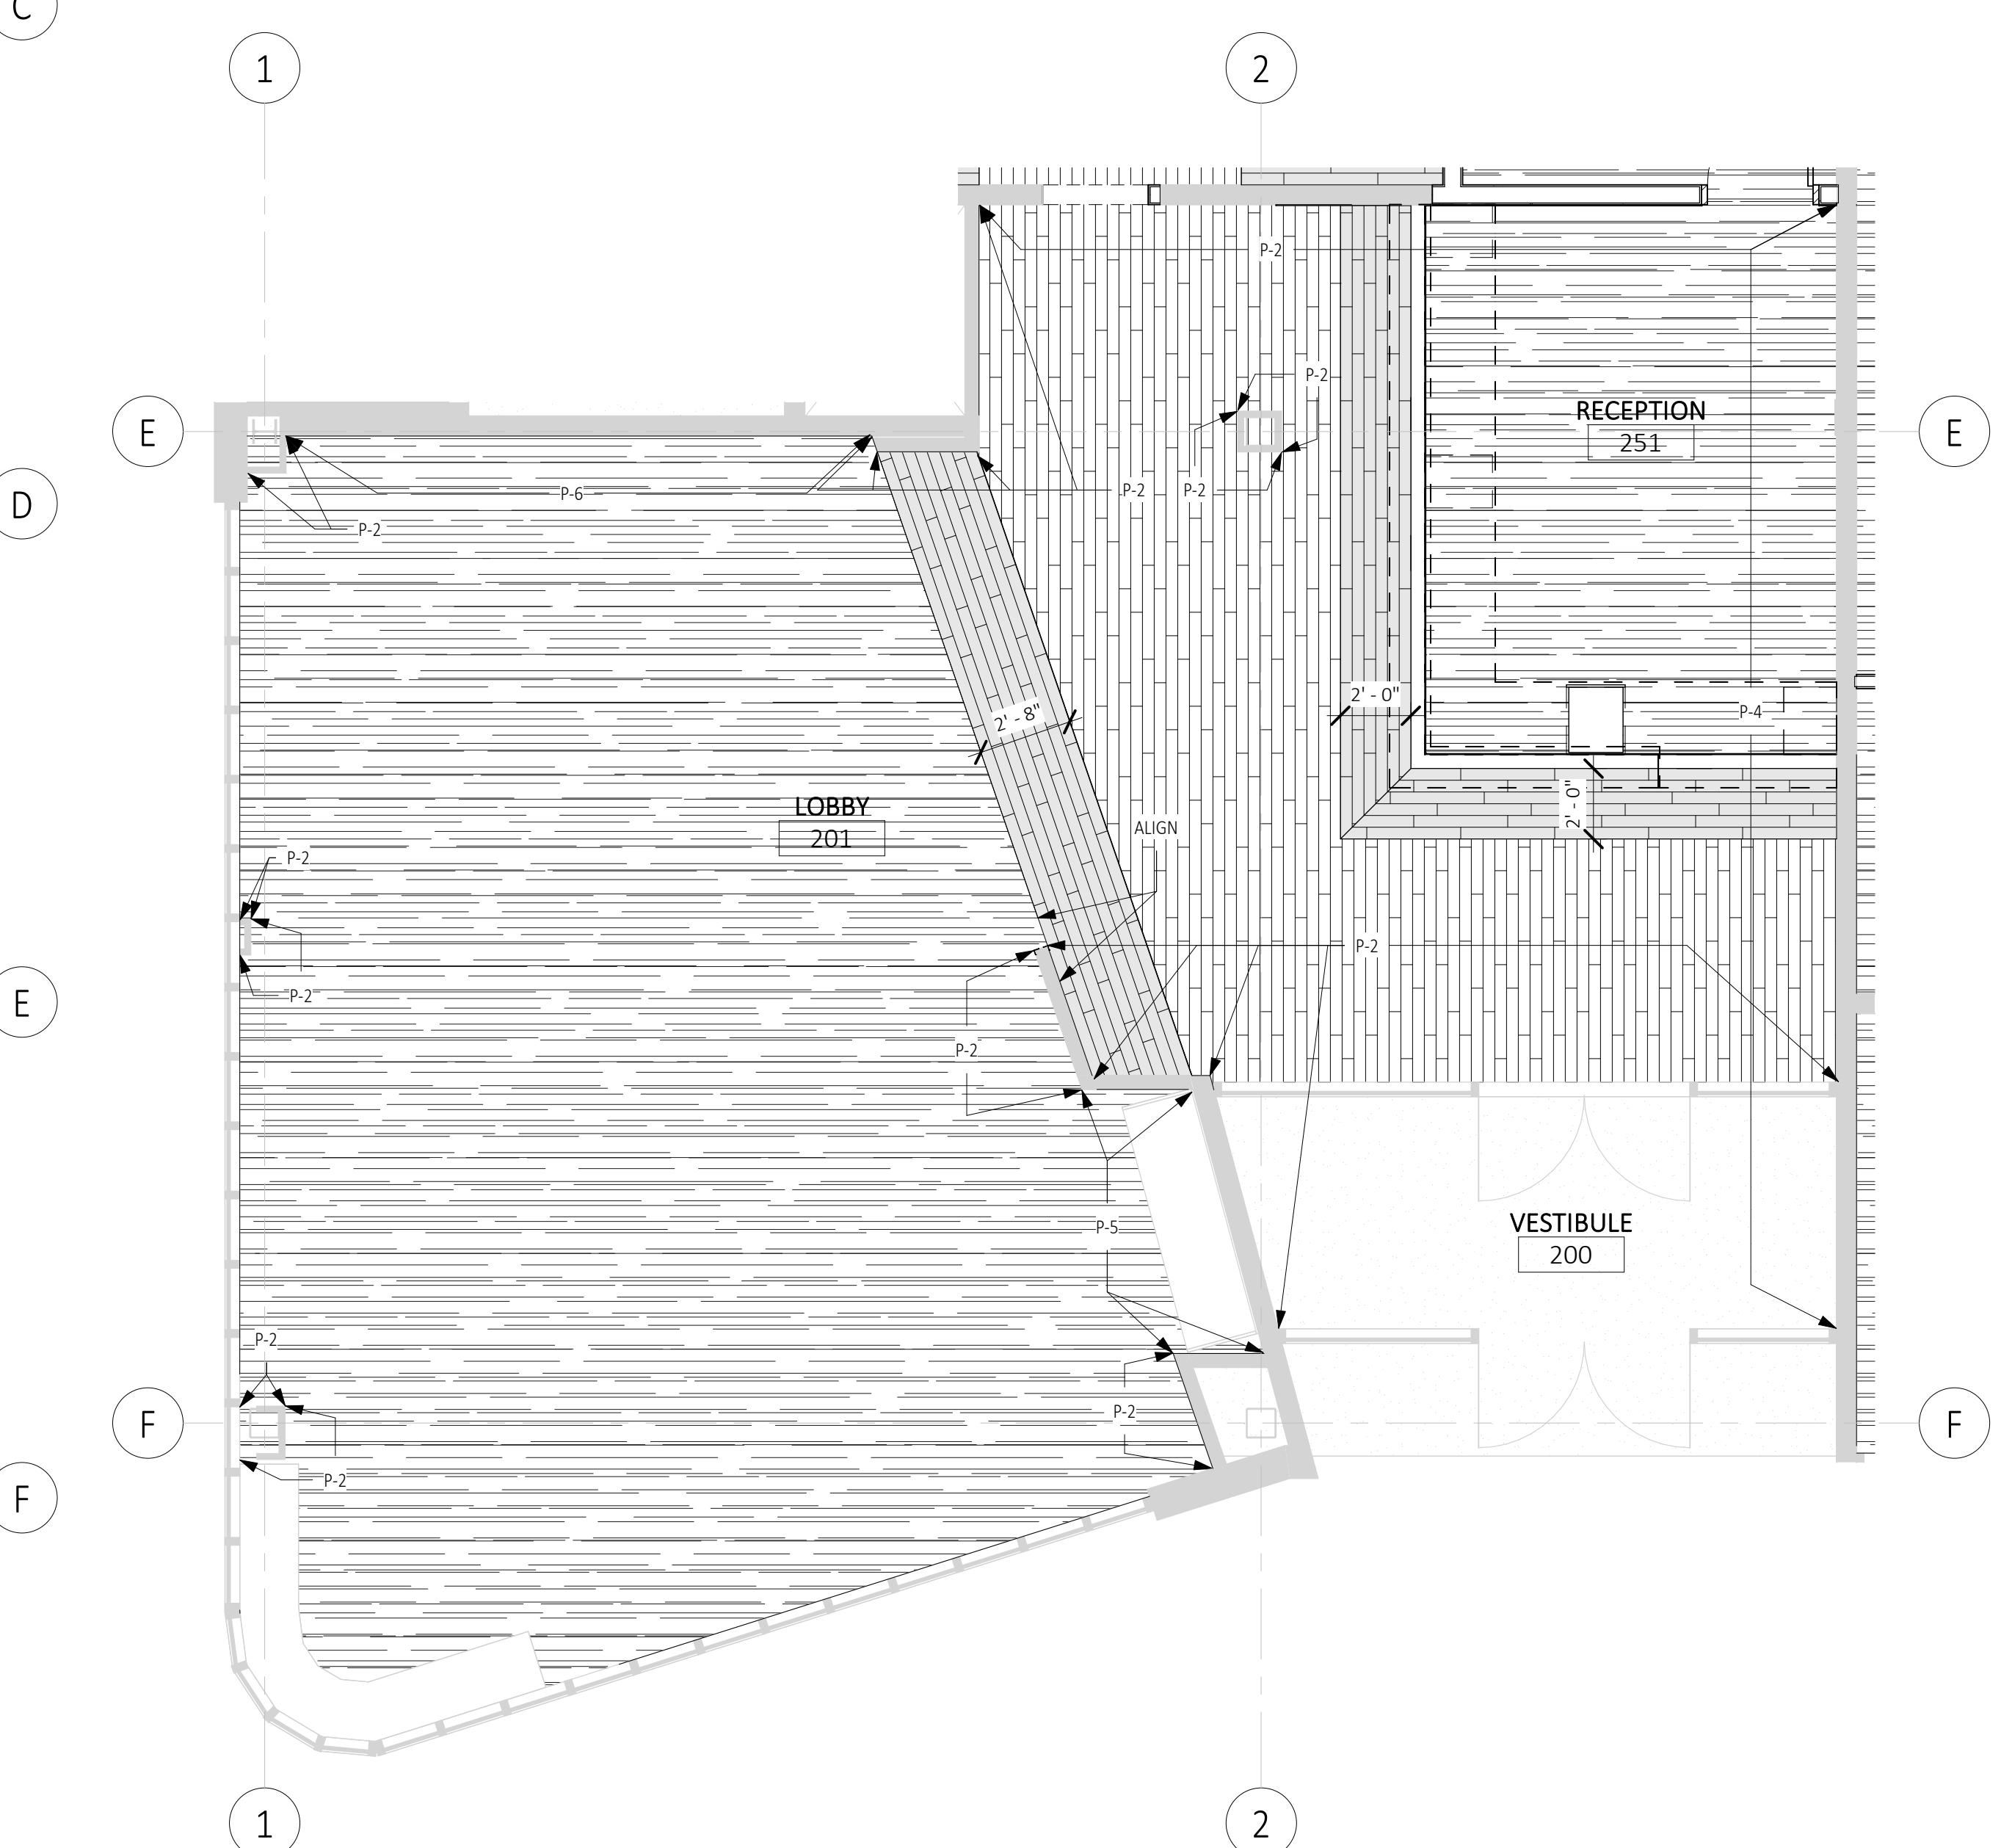

3 LEVEL_02 - FINISH FLOOR PLAN - Callout 1
1/4" = 1'-0"



A1.41



GENERAL FINISH FLOOR PLAN NOTES

1. NEW FINISHES TO BE ADDED TO AREAS WITH WORK ONLY, UNO.
2. REFER TO SHEET G0.11 FOR ABBREVIATIONS.
3. REFER TO SHEET A1.43 FOR INTERIOR FINISH SCHEDULE.
4. REFER TO SHEET A1.43 FOR INTERIOR FINISH KEY.
5. ALL WALLS AND GWB CEILING TO BE PAINTED P-1, UNLESS NOTED OTHERWISE.
6. ALL OFFICE WALLS TO BE PAINTED P-2, UNLESS NOTED OTHERWISE.
7. TYPICAL WALL BASE TO BE RB-1, UNO.
8. WALL BASE, RB-2, TO BE USED IN JANITOR'S CLOSETS, RESTROOMS, AND OTHER WET AREAS, UNO.
9. PATCH AND REPAIR EXISTING WALLS AS REQUIRED BEFORE APPLYING NEW PAINT.
10. ANY EXISTING WALLS TO RECIEVE NEW PAINT TO BE PAINTED THE FULL LENGTH OF THE WALL.
11. "CG-X" INDICATES CORNER GUARD LOCATION, WITH "X" INDICATING TYPE PER FINISH KEY.

"ENHANCING LIVES AND COMMUNITIES"

1001 SW DISK DRIVE, SUITE 105
BEND OR 97702
541.388.9897
WWW.PINNACLEARCHITECTURE.COM

FINISH FLOOR LEGEND

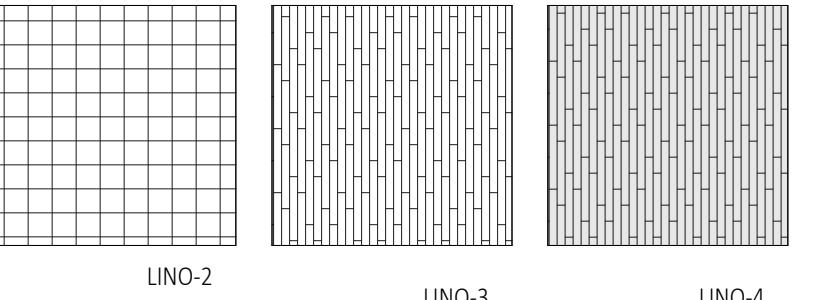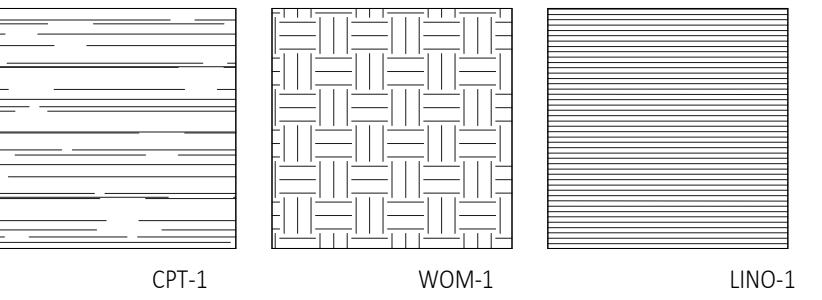


KEYNOTES - FINISH FLOOR PLANS	
Key	Value
FF001	NO WORK ANTICIPATED IN THIS ROOM
FF004	NO NEW FLOORING ANTICIPATED IN THIS ROOM; PATCH & PAINT OR REPLACE FLOORING AS REQ'D AS Affected BY CONSTRUCTION

LAKE ROAD HEALTH CENTER


CLIENT:
CLACKAMAS COUNTY

PROJECT ADDRESS:
6605 SE Lake Rd, Milwaukie, OR
97222

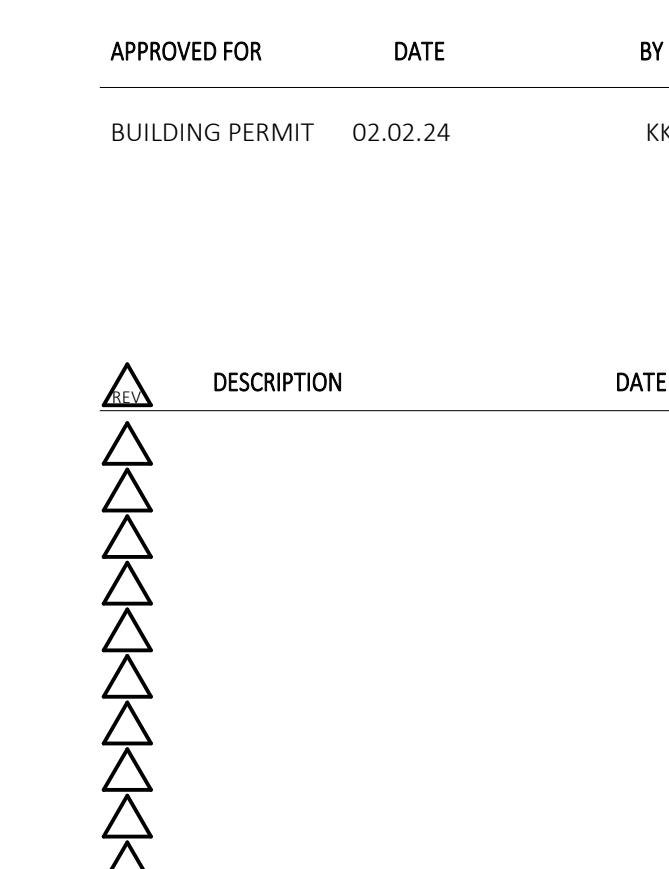

PROJECT NO: 2221.HCR
DRAWN BY: MALLORY FAIR
CHECKED BY: PETER BAER

3RD FLOOR FINISH FLOOR PLAN

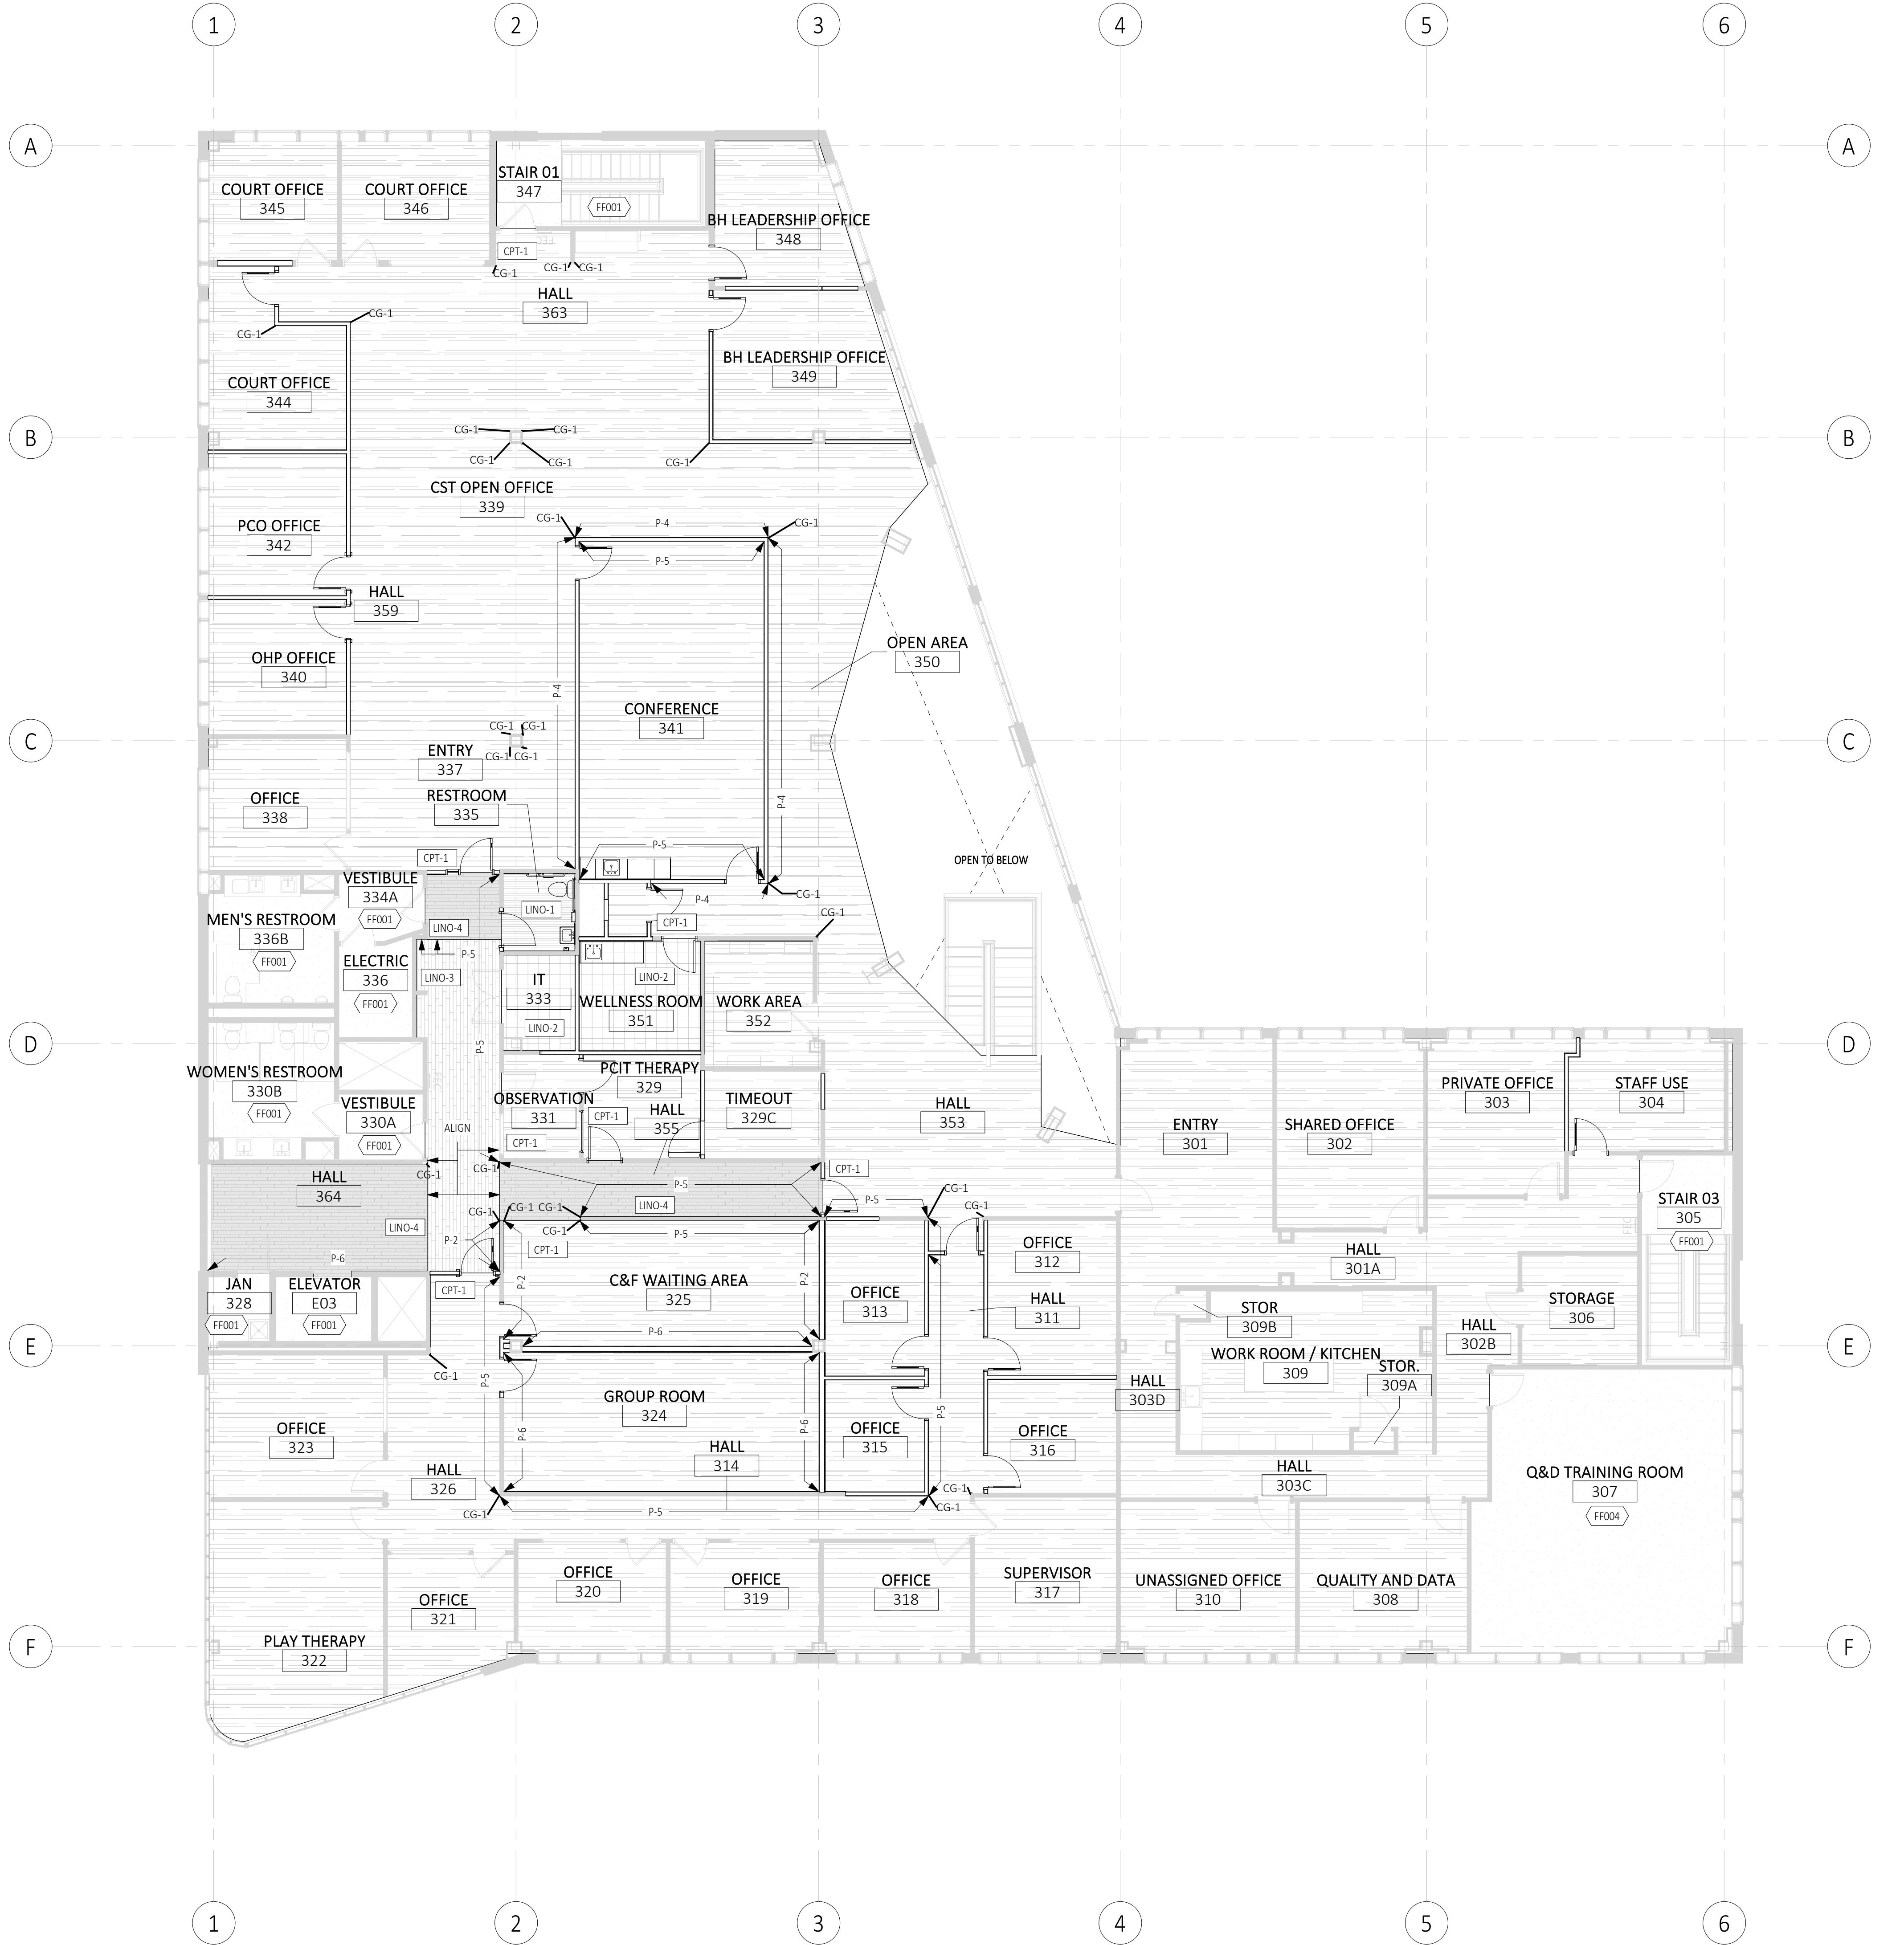

1 LEVEL_03 - FINISH FLOOR PLAN
1/8" = 1'-0"

Page 10 of 10

A black circle containing a white stylized 'N' shape, representing the cardinal direction North.

A1.42

INTERIOR FINISH SCHEDULE - 1ST FLOOR												
ROOM NUMBER	ROOM NAME	BASE	FLOOR	WALLS			CASEWORK			NOTES		
				PLAN NORTH	PLAN EAST	PLAN SOUTH	PLAN WEST	CABINET	COUNTER			
100	LOBBY / WAITING	RB-1	UNO-3 / UNO-4	SEE FINISH FLOOR PLANS	N/A	N/A						
101	OPEN OFFICE	RB-1	CPT-1	P-1	P-1	P-1 / P-5	P-1	N/A	N/A			
102	RECEPTION	RB-1	CPT-1	P-2	P-2	P-2	P-2	N/A	PLAM-3			
103	Therapy Room	RB-1	CPT-1	P-2	P-2	P-2	P-2	N/A	N/A			
104	Therapy Room	RB-1	CPT-1	P-2	P-2	P-2	P-2	N/A	N/A			
105	Therapy Room	RB-1	CPT-1	P-2	P-2	P-2	P-2	N/A	N/A			
106	Therapy Room	RB-1	CPT-1	P-2	P-2	P-2	P-2	N/A	N/A			
107	Therapy Room	RB-1	CPT-1	P-2	P-2	P-2	P-2	N/A	N/A			
108	Therapy Room	RB-1	CPT-1	P-2	P-2	P-2	P-2	N/A	N/A			
109	Group Room	RB-1	CPT-1	P-1	P-4	P-1	P-4	N/A	N/A			
110	PRV. OFFICE	RB-1	CPT-1	P-2	P-2	P-2	P-2	N/A	N/A			
111	Court Room	RB-1	CPT-1	P-6	P-1	P-6	P-1	N/A	N/A			
112	PEERS	RB-1	CPT-1	P-2	P-2	P-2	P-2	N/A	N/A			
113	Court Group	RB-1	CPT-1	P-6	P-1	P-6	P-1	N/A	N/A			
114	Court Office	RB-1	CPT-1	P-2	P-2	P-2	P-2	N/A	N/A			
115	Supervisor (Court)	RB-1	CPT-1	P-2	P-2	P-2	P-2	N/A	N/A			
116	Court Office	RB-1	CPT-1	P-2	P-2	P-2	P-2	N/A	N/A			
117	Court Office	RB-1	CPT-1	P-2	P-2	P-2	P-2	N/A	N/A			
118	Court Office	RB-1	CPT-1	P-2	P-2	P-2	P-2	N/A	N/A			
119	Court Office	RB-1	CPT-1	P-2	P-2	P-2	P-2	N/A	N/A			
120	Court Office	RB-1	CPT-1	P-2	P-2	P-2	P-2	N/A	N/A			
121	UNASSIGNED OFFICE	RB-1	CPT-1	P-2	P-2	P-2	P-2	N/A	N/A			
122	IT	RB-1	EXIST	P-1	P-1	P-1	P-1	N/A	EXIST			
123	UNASSIGNED OFFICE	RB-1	CPT-1	P-2	P-2	P-2	P-2	N/A	N/A			
124A	HALL	RB-1	CPT-1	P-1	P-1	P-5	P-1	N/A	N/A			
124B	HALL	RB-1	CPT-1	P-1	P-1	P-5	P-1	N/A	N/A			
125	UNASSIGNED OFFICE	RB-1	CPT-1	P-2	P-2	P-2	P-2	N/A	N/A			
125D	HALL	RB-1	CPT-1	N/A	P-5	N/A	P-1	N/A	N/A			
126	UNASSIGNED OFFICE	RB-1	CPT-1	P-2	P-2	P-2	P-2	N/A	N/A			
127	COPY / WORKROOM	RB-1	CPT-1	P-1	P-1	P-1	P-1	EXIST	EXIST			
128	BREAKROOM	RB-1	UNO-2	P-1	P-1	P-1	P-1	EXIST	EXIST			
129	GROUP ROOM	RB-1	CPT-1	P-1	P-5	P-1	P-5	N/A	N/A			
130	HALL	RB-1	CPT-1	P-1	N/A	P-1	P-1	N/A	N/A			
131	MECH	EXIST	EXIST	EXIST	EXIST	EXIST	EXIST	N/A	N/A	2		
132	MACH ROOM	EXIST	EXIST	EXIST	EXIST	EXIST	EXIST	N/A	N/A	2		
133	JAN	EXIST	EXIST	EXIST	EXIST	EXIST	EXIST	N/A	N/A	2		
134	HALL	RB-1	UNO-4	EXIST	P-1	P-5	P-1	N/A	N/A			
135	VESTIBULE	EXIST	EXIST	EXIST	EXIST	EXIST	EXIST	N/A	N/A	2		
136	WOMEN'S RESTROOM	EXIST	EXIST	EXIST	EXIST	EXIST	EXIST	N/A	EXIST	2		
137	RESTROOM	RB-2	UNO-1	EPX-1	EPX-1	EPX-1	EPX-1	N/A	N/A			
138	ELEC	EXIST	EXIST	EXIST	EXIST	EXIST	EXIST	N/A	N/A	2		
139	RESTROOM	RB-2	UNO-1	EPX-1	EPX-1	EPX-1	EPX-1	N/A	N/A			
140	MEN'S RESTROOM	EXIST	EXIST	EXIST	EXIST	EXIST	EXIST	N/A	EXIST	2		
141	VESTIBULE	EXIST	EXIST	EXIST	EXIST	EXIST	EXIST	N/A	N/A	2		
142	STOR	EXIST	EXIST	EXIST	EXIST	EXIST	EXIST	N/A	N/A	2		
143	ELEC	EXIST	EXIST	EXIST	EXIST	EXIST	EXIST	N/A	N/A	2		
144A	CONSULT	N/A	N/A	N/A	N/A	N/A	N/A	N/A	N/A			
144B	PHARMACY	N/A	N/A	N/A	N/A	N/A	N/A	N/A	N/A			
145	HALL	RB-1	UNO-1	P-1	P-1	P-1	P-1	N/A	N/A			
146	PEER LOUNGE & WAITING	RB-1	CPT-1	P-4	P-4	P-4	P-4	N/A	N/A			
147	STAIR 01	EXIST	EXIST	EXIST	EXIST	EXIST	EXIST	N/A	N/A	2		
149	HALL	RB-1	UNO-4	P-5	N/A	P-5	P-5	N/A	N/A			
158	HALL	RB-1	UNO-3 / UNO-4	N/A	P-1	N/A	SEE FINISH FLOOR PLAN	N/A	N/A			





INTERIOR FINISH SCHEDULE - 2ND FLOOR												
ROOM NUMBER	ROOM NAME	BASE	FLOOR	WALLS			CASEWORK			NOTES		
				PLAN NORTH	PLAN EAST	PLAN SOUTH	PLAN WEST	CABINET	COUNTER			
200	VESTIBULE	EXIST	EXIST	EXIST	EXIST	P-4	EXIST	P-2	N/A	N/A		
201	LOBBY	RB-1	UNO-3 / UNO-4 / CPT-1	SEE FINISH FLOOR PLANS	EXIST	EXIST						
202	JAN	EXIST	EXIST	EXIST	EXIST	P-5	EXIST	N/A	N/A	2		
203	HALL	RB-1	UNO-3 / UNO-4	P-1	P-5	P-5	P-1	N/A	N/A			
204	VESTIBULE	EXIST	EXIST	EXIST	EXIST	P-1	EXIST	N/A	N/A	2		
205	DATA ROOM	EXIST	EXIST	P-1	P-1	P-1	P-1	N/A	N/A			
206	HALL	RB-1	UNO-3 / UNO-4	P-5	P-1	N/A	P-1	N/A	N/A			
207	STG.	EXIST	EXIST	EXIST	EXIST	P-1	EXIST	N/A	N/A	2		
208	VESTIBULE	EXIST	EXIST	EXIST	EXIST	P-2	EXIST	N/A	N/A	2		
209	Electric	EXIST	EXIST	EXIST	EXIST	P-2	EXIST	N/A	N/A	2		
210	MEN'S RESTROOM	EXIST	EXIST	EXIST	EXIST	P-1	EXIST	N/A	N/A	2		
211	UNASSIGNED CUBICLES	RB-1	CPT-1	P-4	N/A	P-1	P-1	N/A	N/A			
212	HALL	RB-1	CPT-1	P-4	P-1	P-1	P-1	N/A	N/A			
213	WOMEN'S RESTROOM	EXIST	EXIST	EXIST	EXIST	P-4	EXIST	N/A	N/A	2		
214	BREAK ROOM	EXIST	EXIST	EXIST	EXIST	P-2	EXIST	P-2	P-2	2		
215	PRIVATE OFFICE	RB-1	CPT-1	P-2	P-2	P-2	P-2	N/A	N/A			
217	PRIVATE OFFICE	RB-1	CPT-1	P-2	P-2	P-2	P-2	N/A	N/A			
219	SHARED OFFICE	RB-1	CPT-1	P-2	P-2	P-2</td						

GENERAL INTERIOR ELEVATION NOTES

1. REFER TO FLOOR PLANS FOR ACCESSIBILITY DETAILS.
2. OWNER FURNISHED, OWNER INSTALLED EQUIPMENT SHOWN FOR COORDINATION ONLY.
3. REFER TO FINISH PLANS FOR FINISH INFORMATION.
4. ALL CASEWORK SHELVING TO BE ADJUSTABLE, UNO.
5. CONTRACTOR TO COORDINATE UTILITIES FOR OWNER FURNISHED ITEMS.
6. REFER TO FLOOR PLANS FOR ELEVATION LOCATIONS NOT INCLUDED WITH ENLARGED PLANS.

KEYNOTES - INTERIOR ELEVATIONS

Key Value	Keynote Text
IE001	RESILIENT WALL BASE, 4", RB-3
IE002	RESILIENT WALL BASE, 4", RB-2
IE005	GRAB BAR, BORRICK 1 1/4 INCH OUTSIDE DIA., WITH CONCEALED FLANGE MOUNTING, CLACKAMAS COUNTY STANDARDS; PROVIDE BLOCKING
IE006	SURFACE-MOUNTED SOAP DISPENSER, BORRICK LIQUID SOAP DISPENSER, CLACKAMAS COUNTY STANDARD
IE007	SURFACE-MOUNTED TOILET PAPER DISPENSER, GEORGIA PACIFIC COMPACT HIGH CAPACITY TISSUE DISPENSER GP #56783, CLACKAMAS COUNTY STANDARD
IE008	SURFACE-MOUNTED SEAT COVER DISPENSER, BORRICK B-221, CLACKAMAS COUNTY STANDARD
IE009	SURFACE-MOUNTED PAPER TOWEL DISPENSER, BORRICK B-2621, CLACKAMAS COUNTY STANDARD
IE010	MIRROR, 24" X 36", BORRICK 6MM FLOAT GLASS, CLACKAMAS COUNTY STANDARD; CENTER ABOVE SINK
IE011	SURFACE-MOUNTED DIAPER CHANGING STATION, KOALA BEAR KARE, CLACKAMAS COUNTY STANDARD; PROVIDE BLOCKING
IE013	PROVIDE INSULATED PIPE COVERS AT EXPOSED PIPES
IE015	CORNER GUARDS, CG-1, MOUNT WITH BOTTOM 1 INCH ABOVE WALL BASE
IE016	INTERIOR WINDOW AND COUNTERTOP BY OTHERS; REFER TO GENOA DRAWINGS

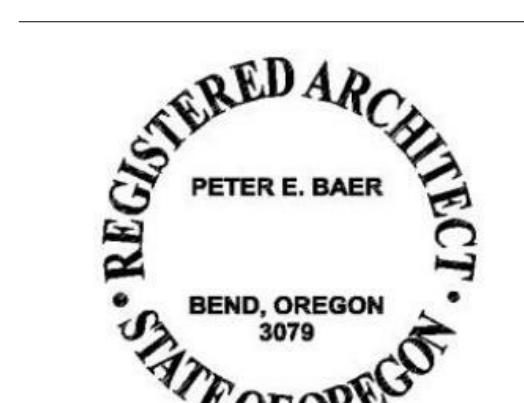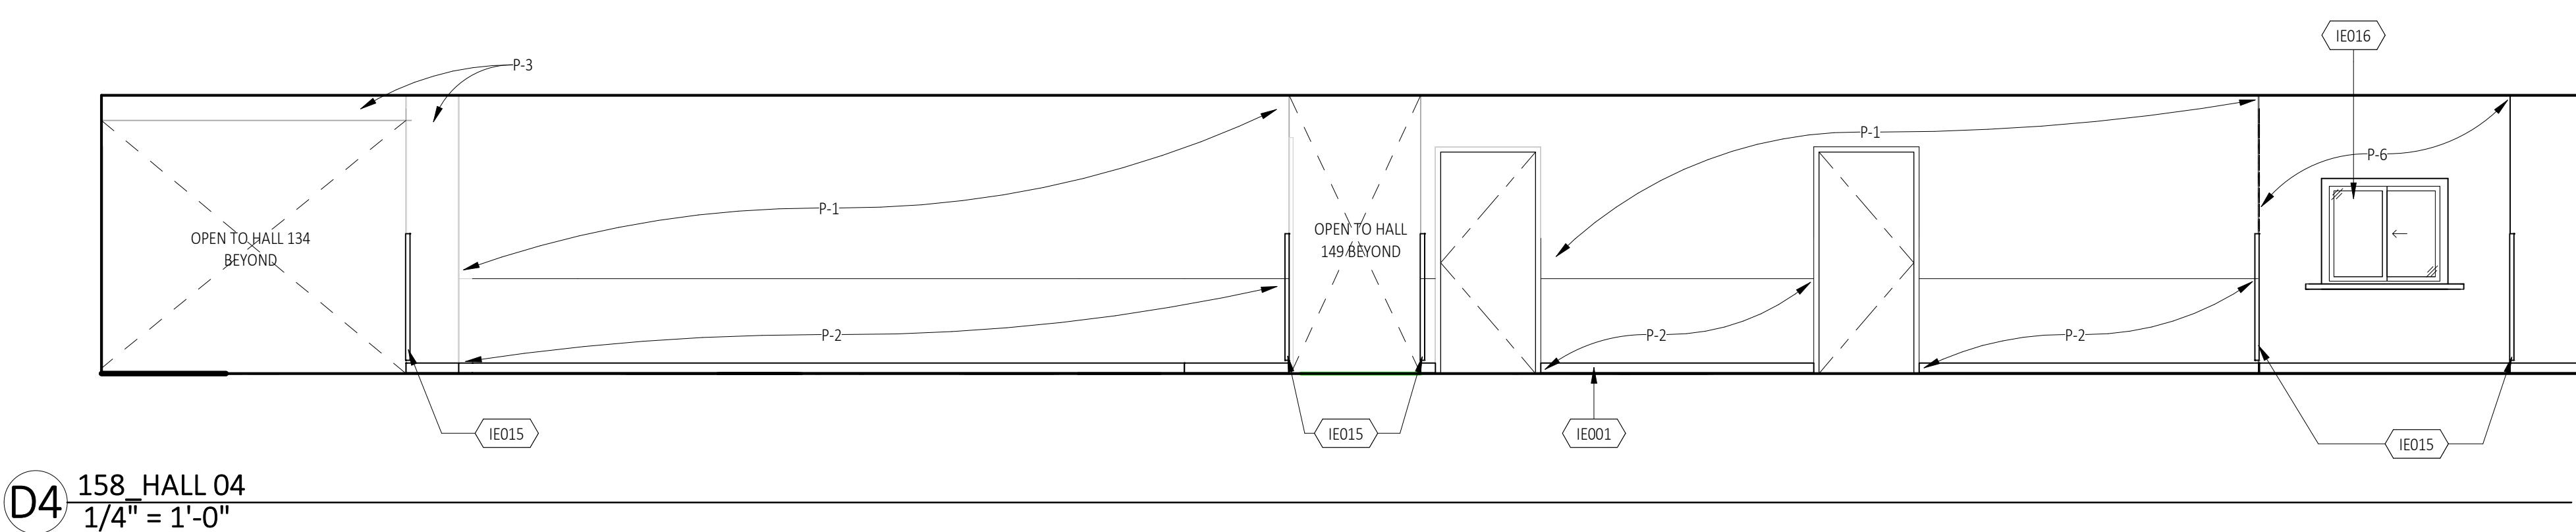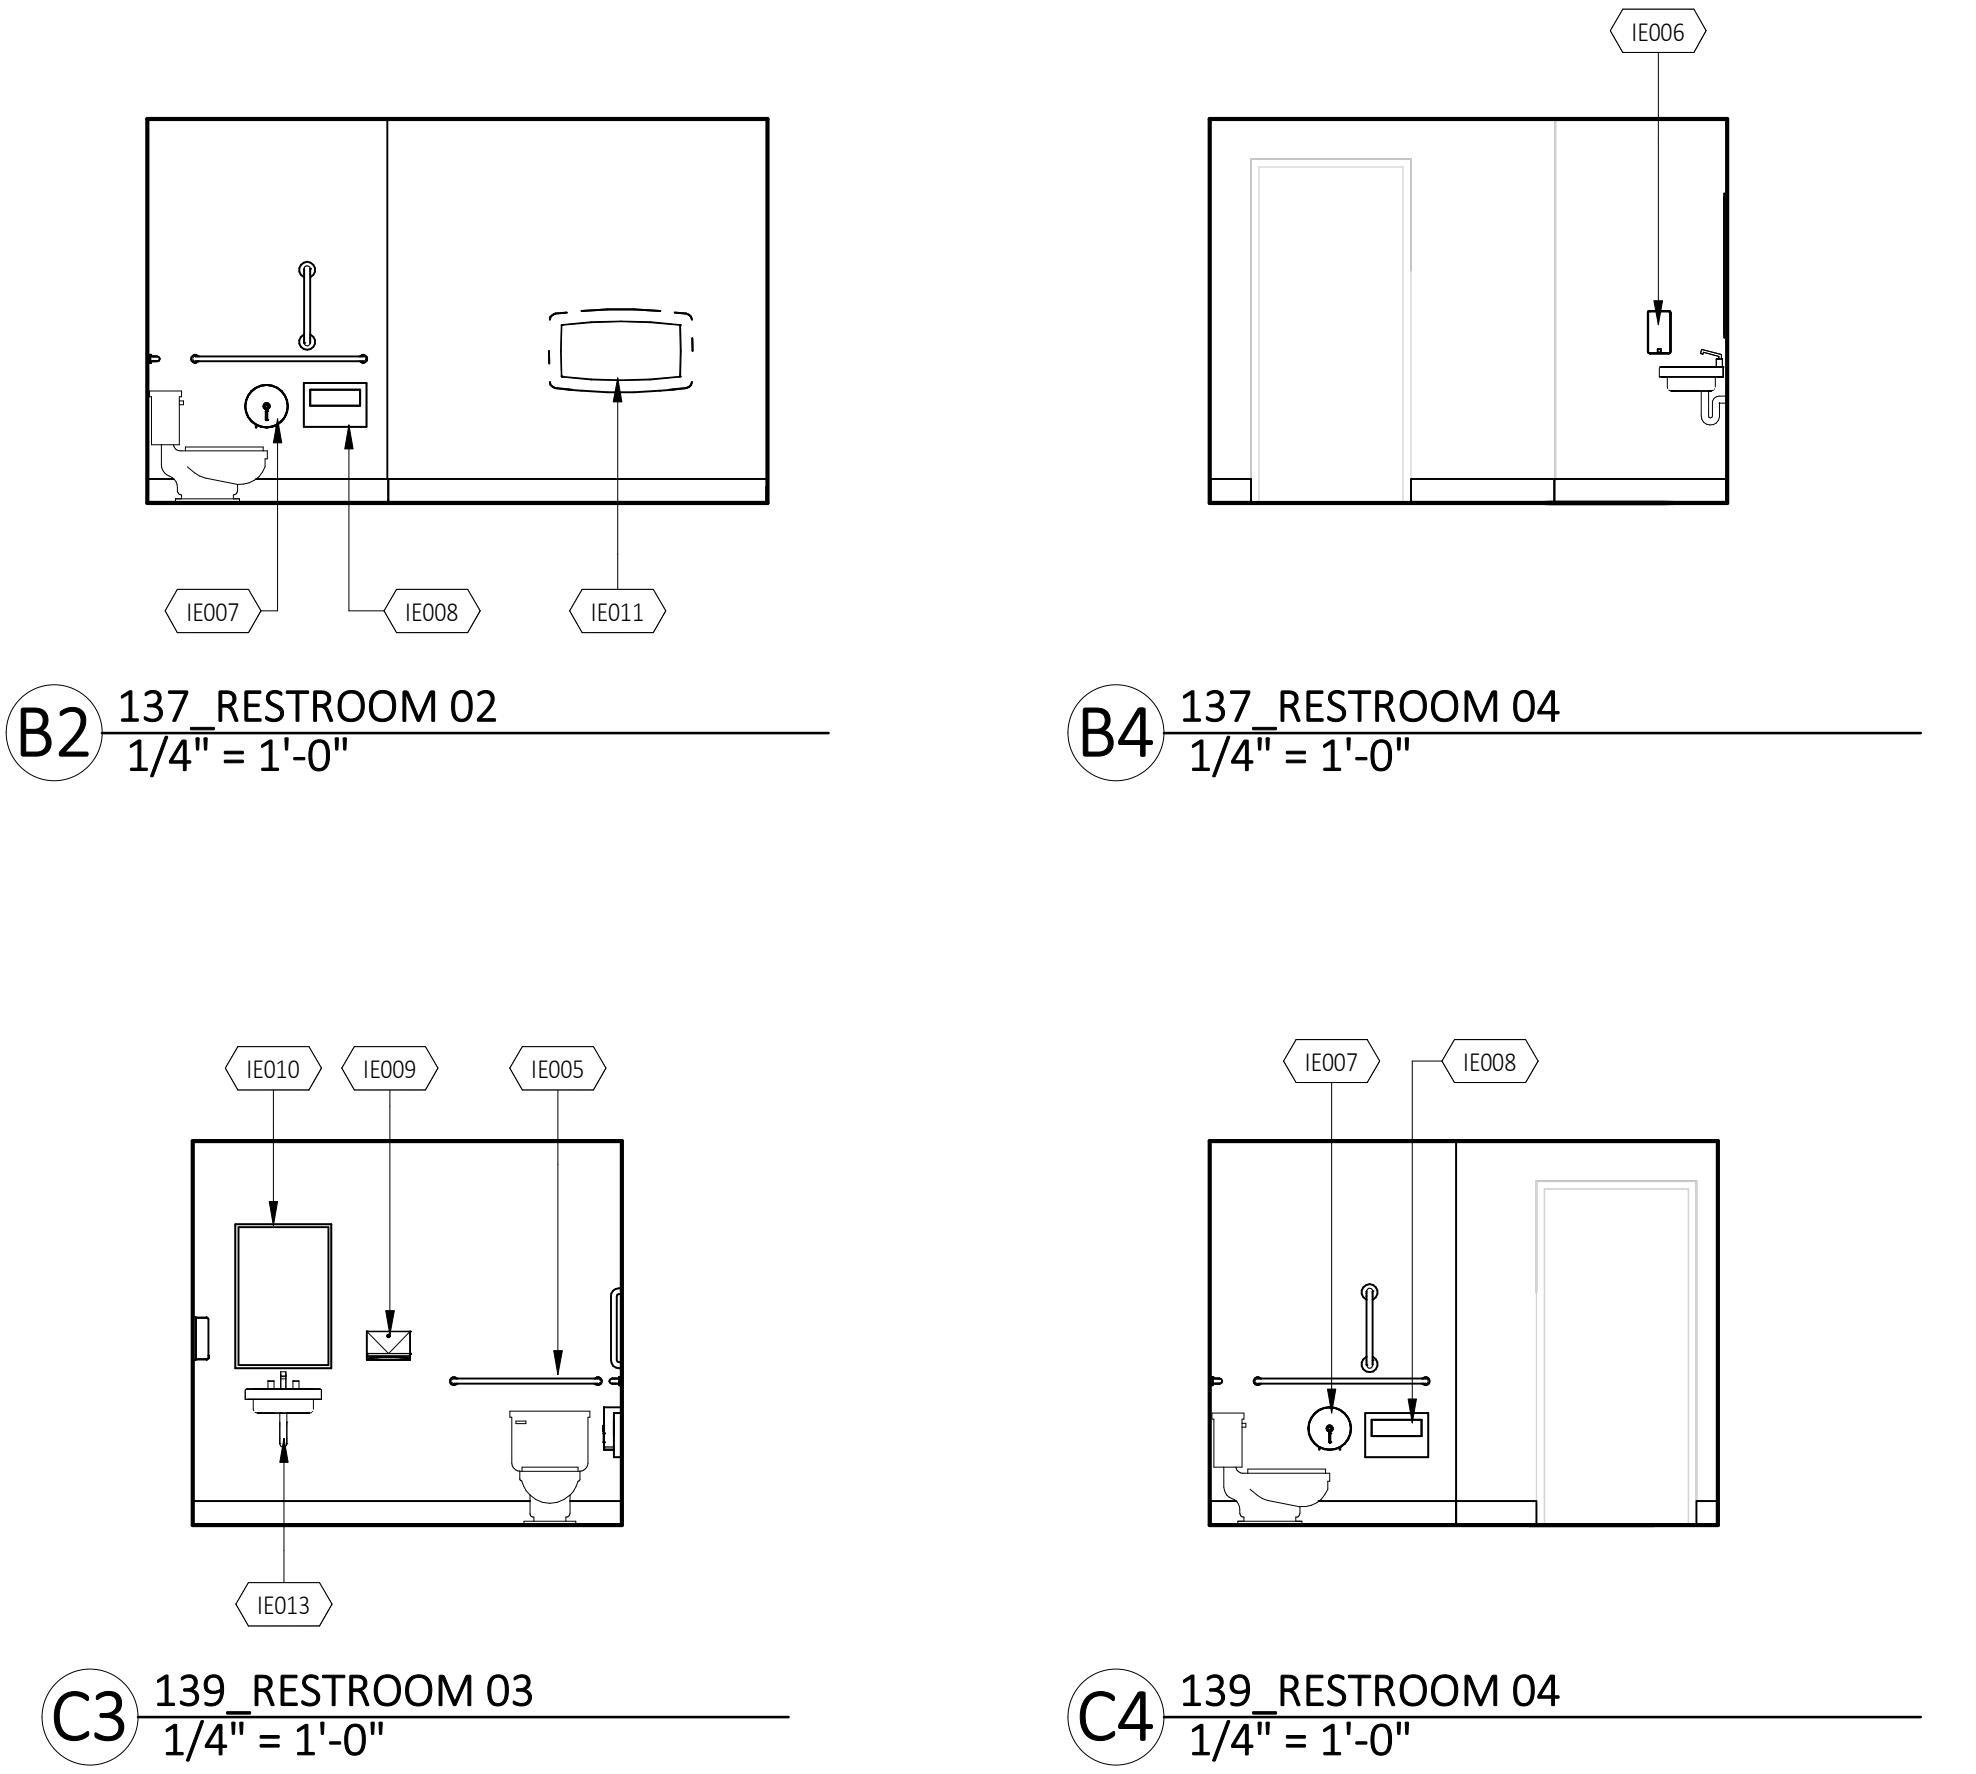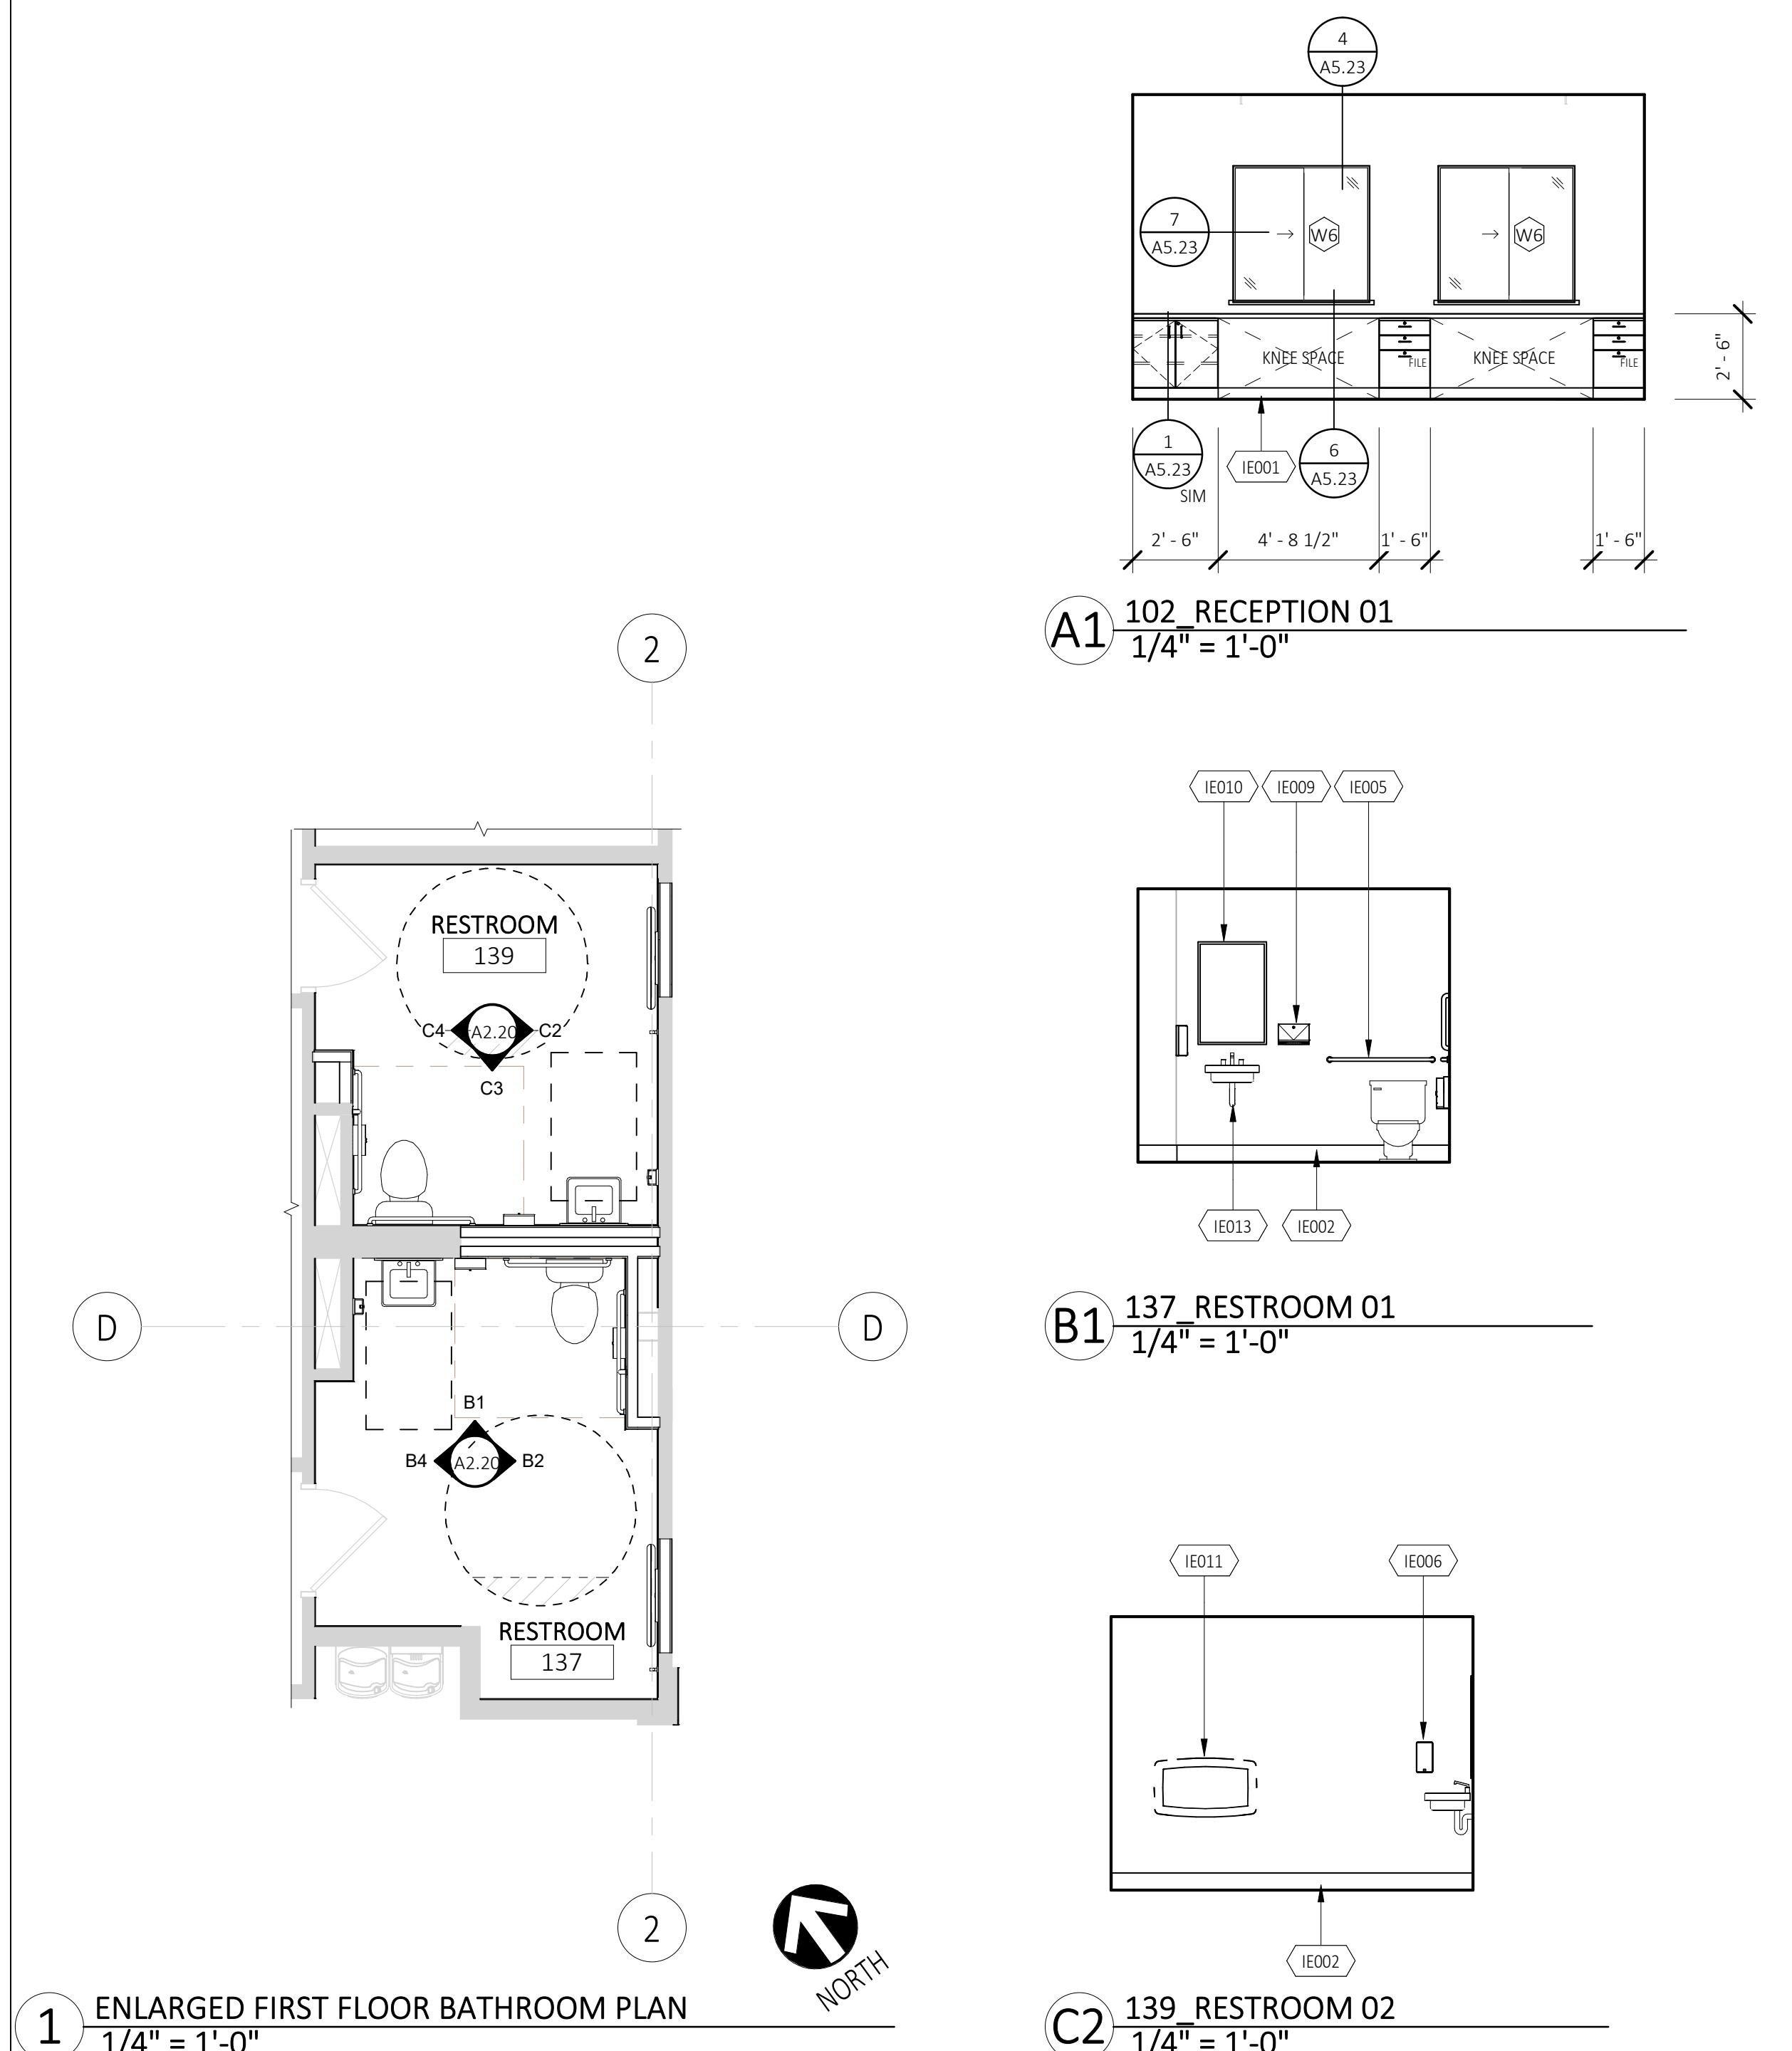


LAKE ROAD HEALTH CENTER

CLIENT:
CLACKAMAS COUNTY

PROJECT ADDRESS:
6605 SE Lake Rd, Milwaukie, OR
97222

APPROVED FOR DATE BY
BUILDING PERMIT 02.02.24 KK

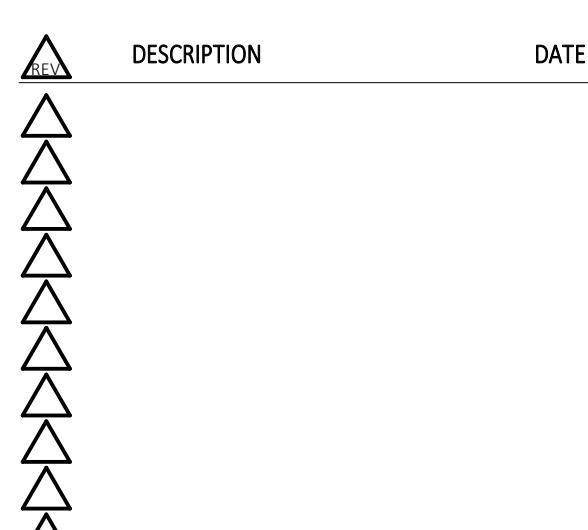

PROJECT NO: 2221 HCR
DRAWN BY: MALLORY FAIR
CHECKED BY: PETER BAER
© PINNACLE ARCHITECTURE, INC. 2024 ORIGINAL SHEET SIZE: 30"X42"

















ENLARGED PLANS & INTERIOR ELEVATIONS


A2.20



LAKE ROAD HEALTH CENTER

 CLIENT:
 CLACKAMAS COUNTY

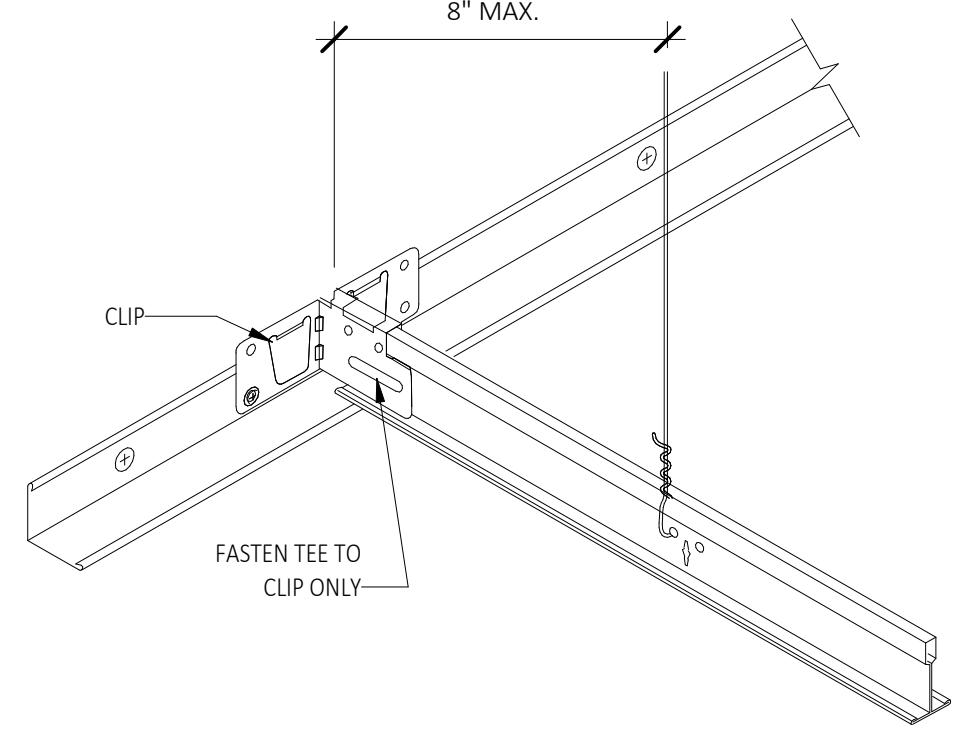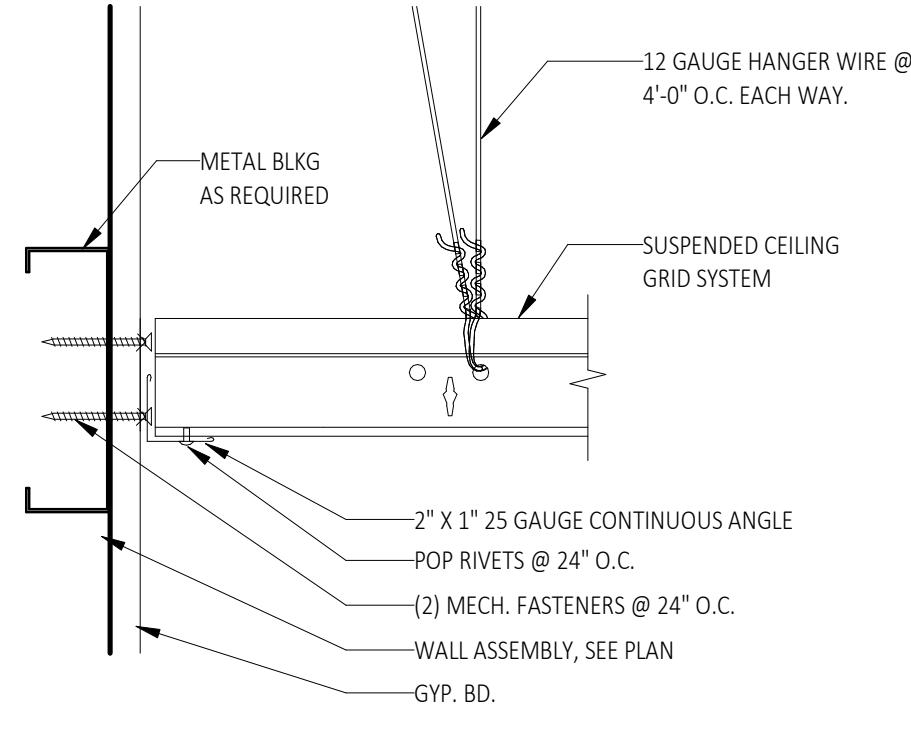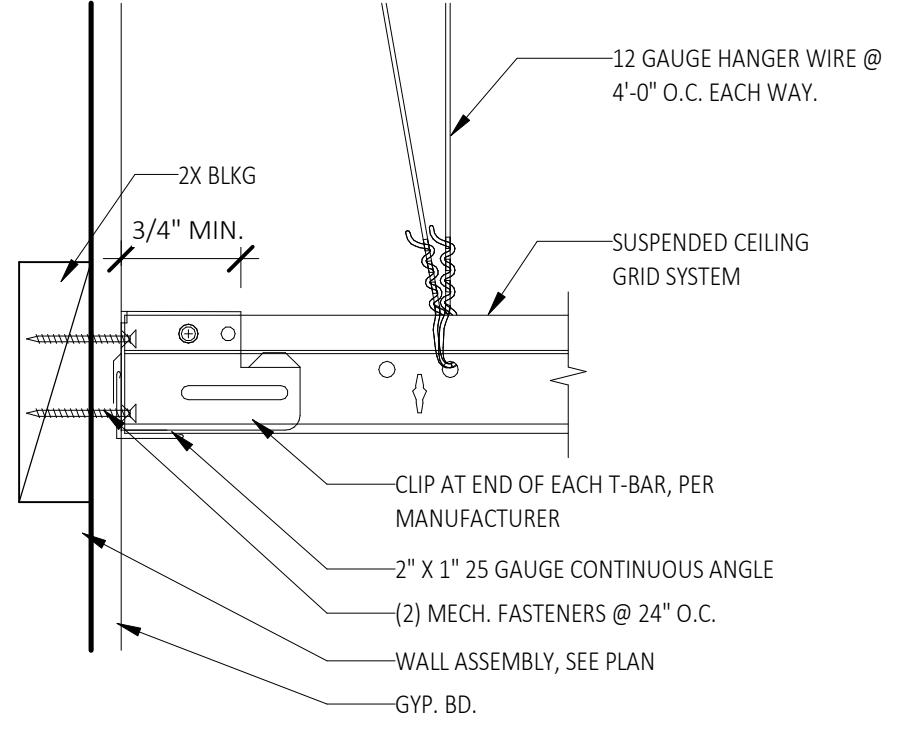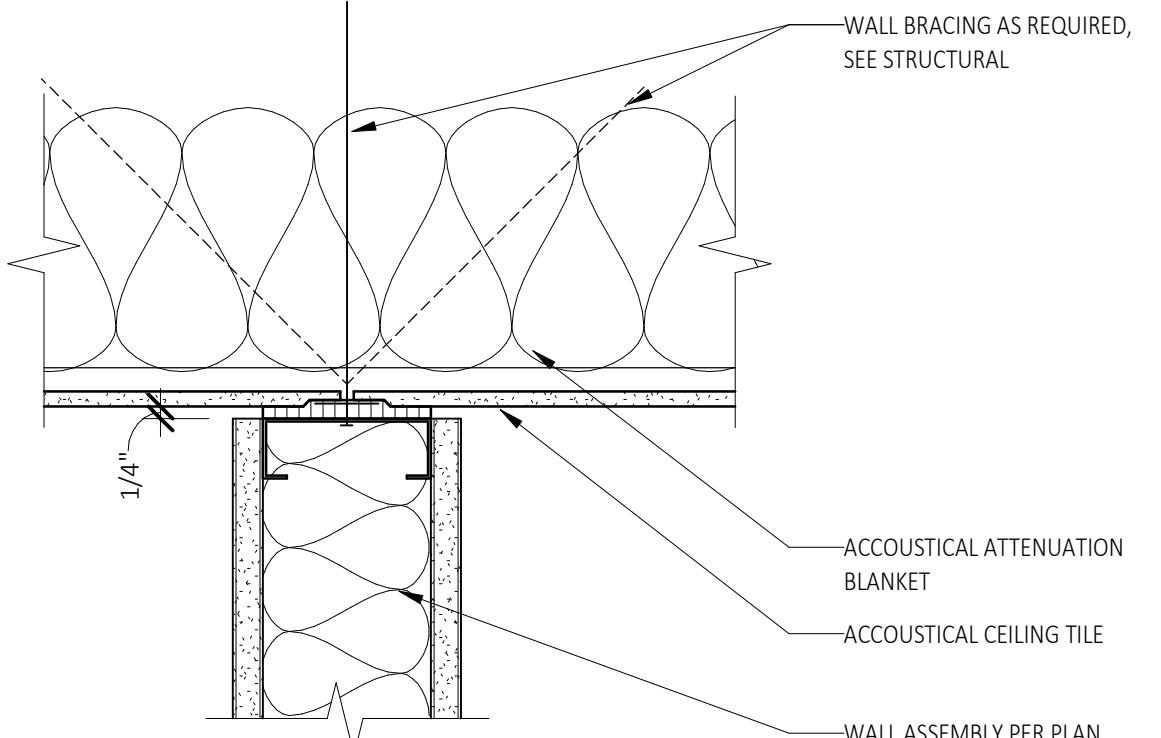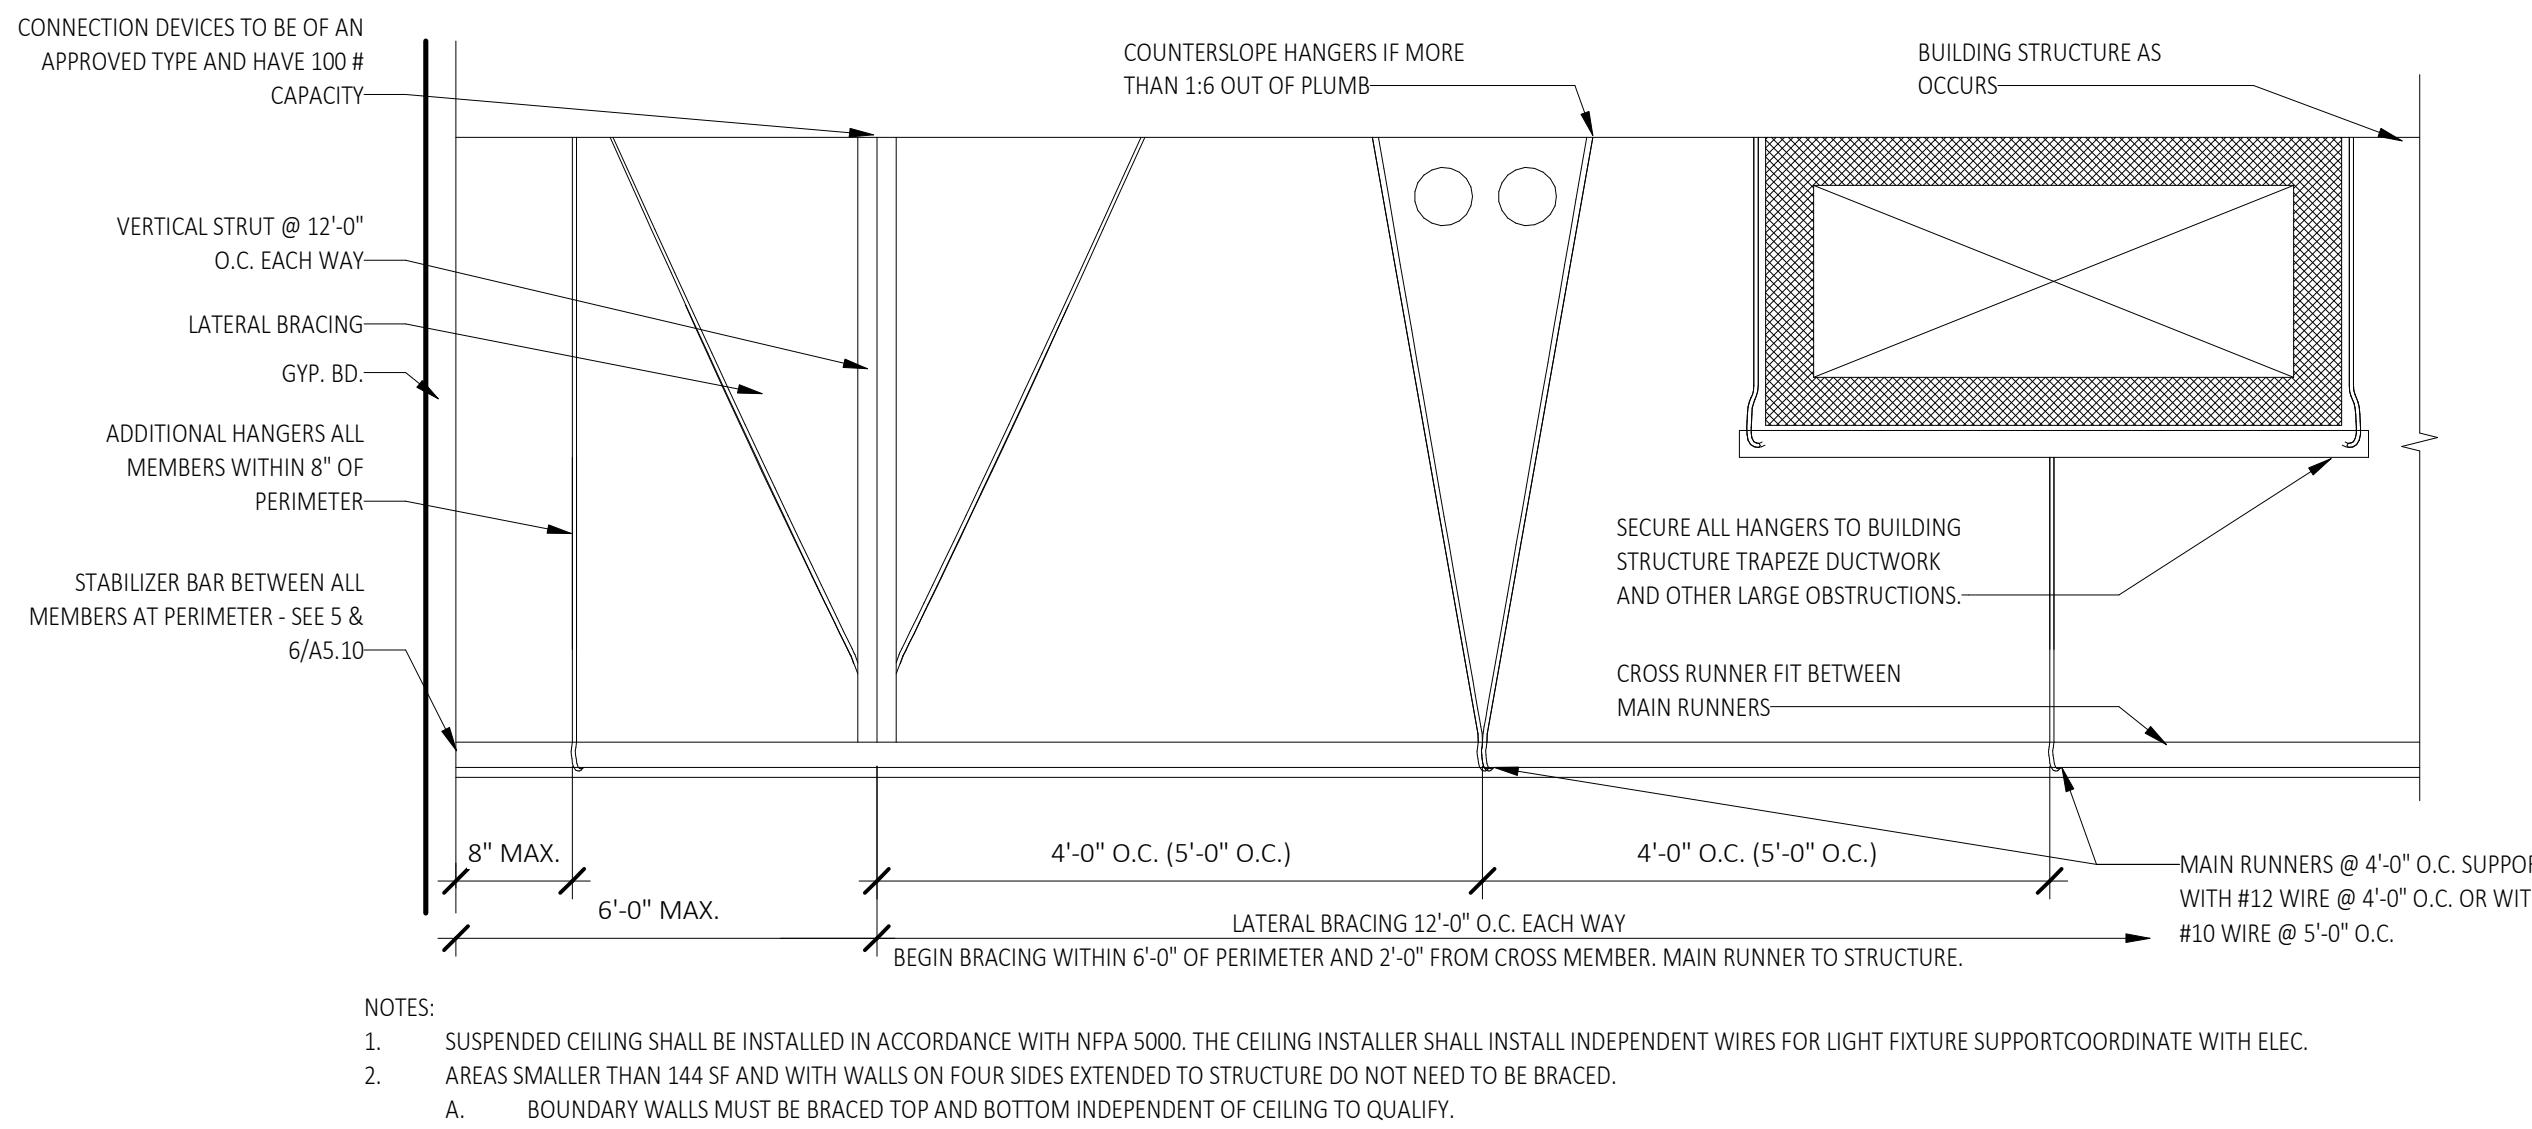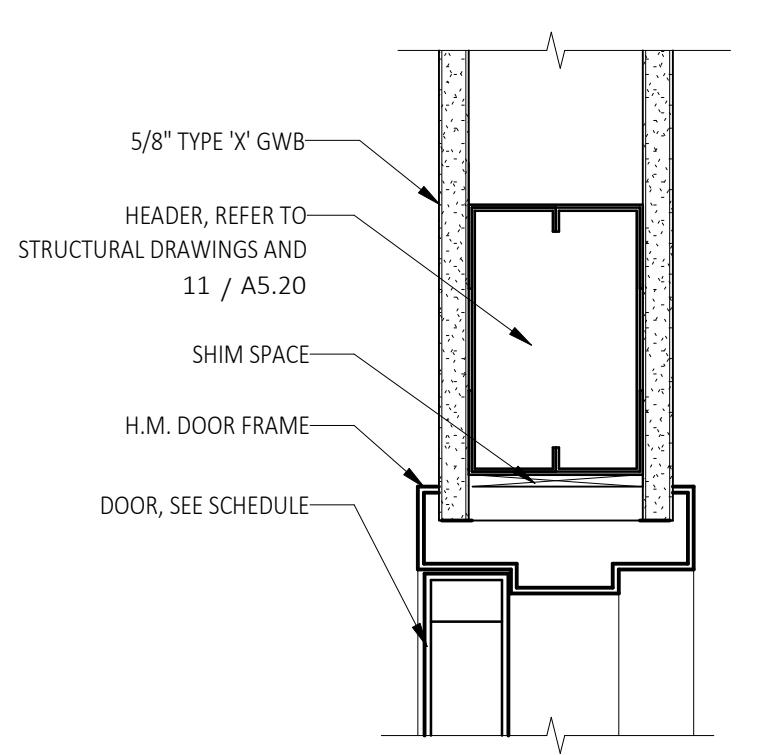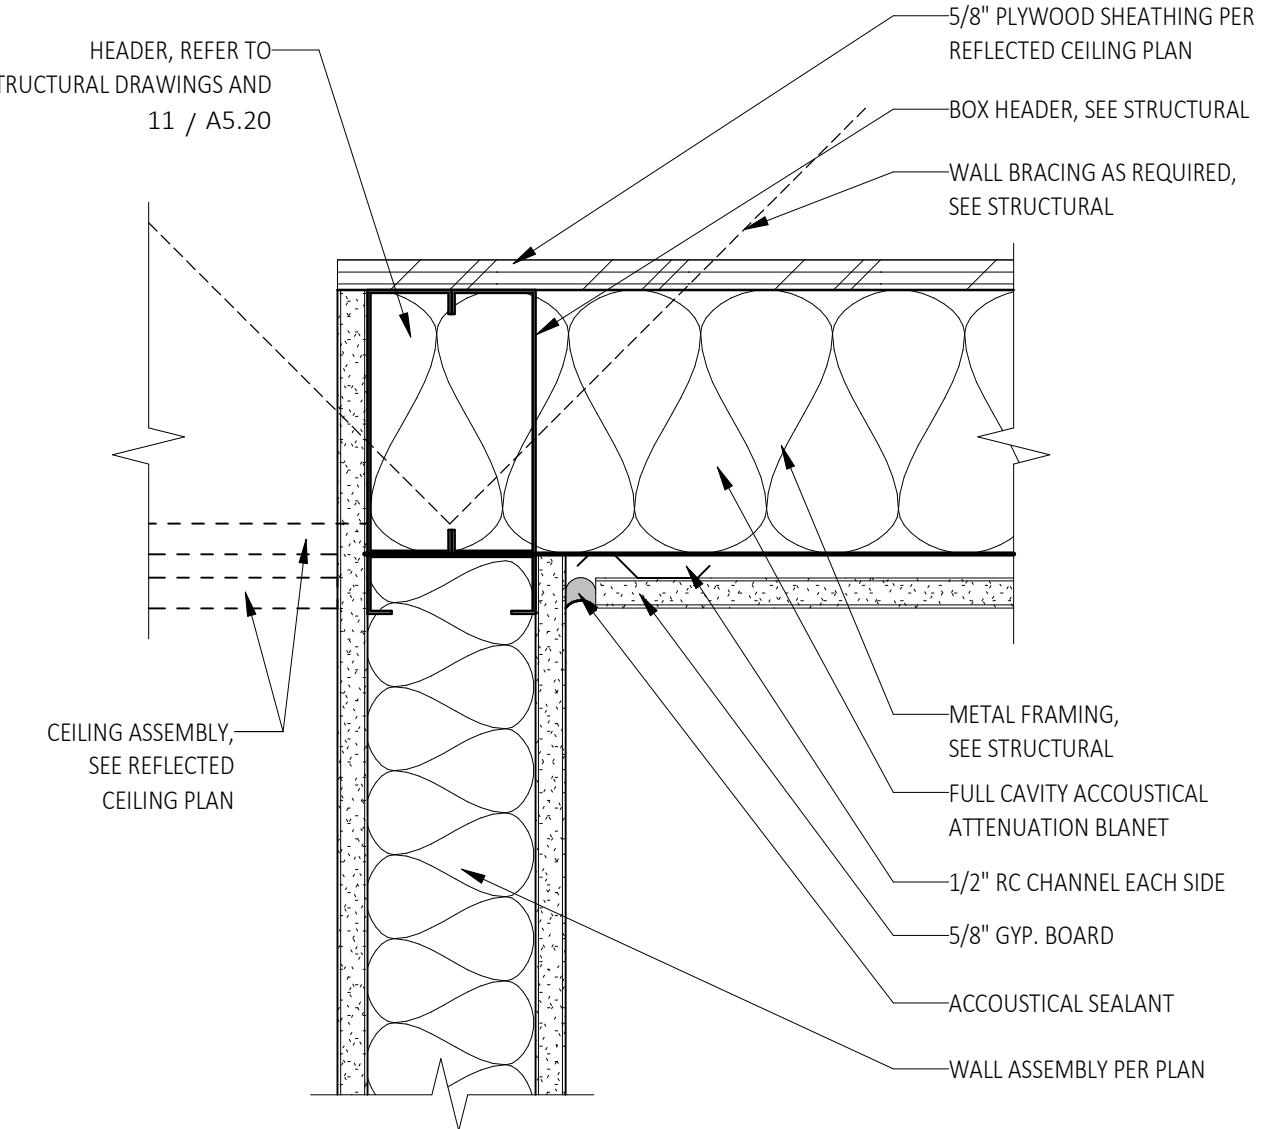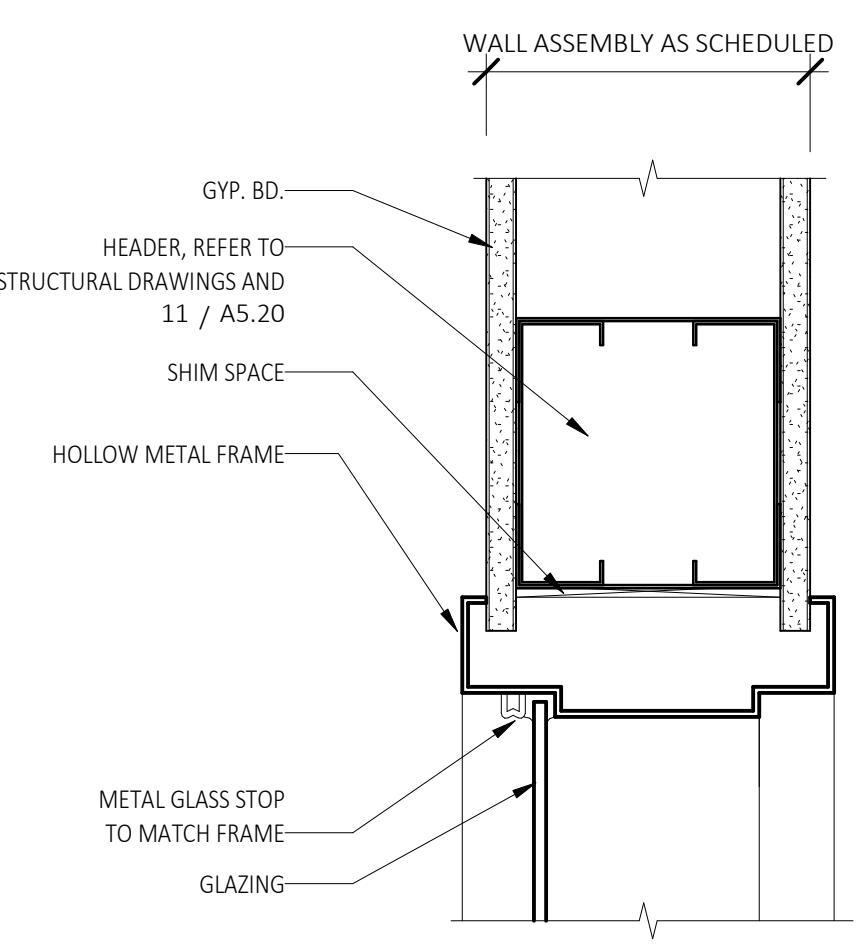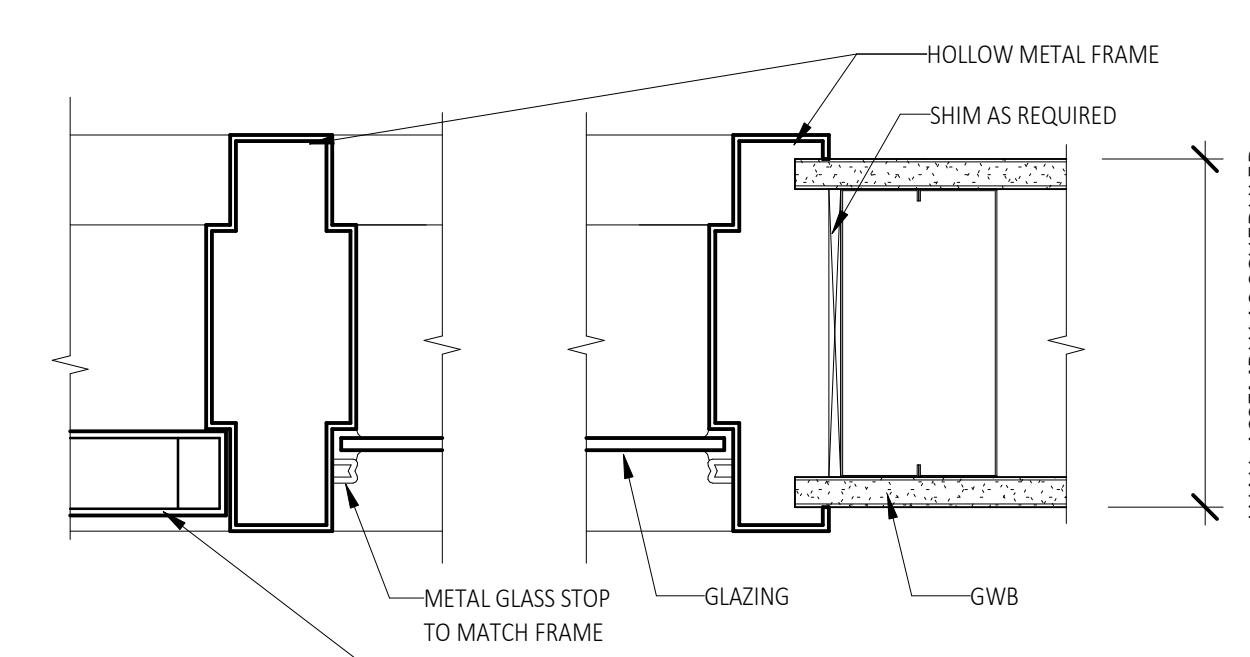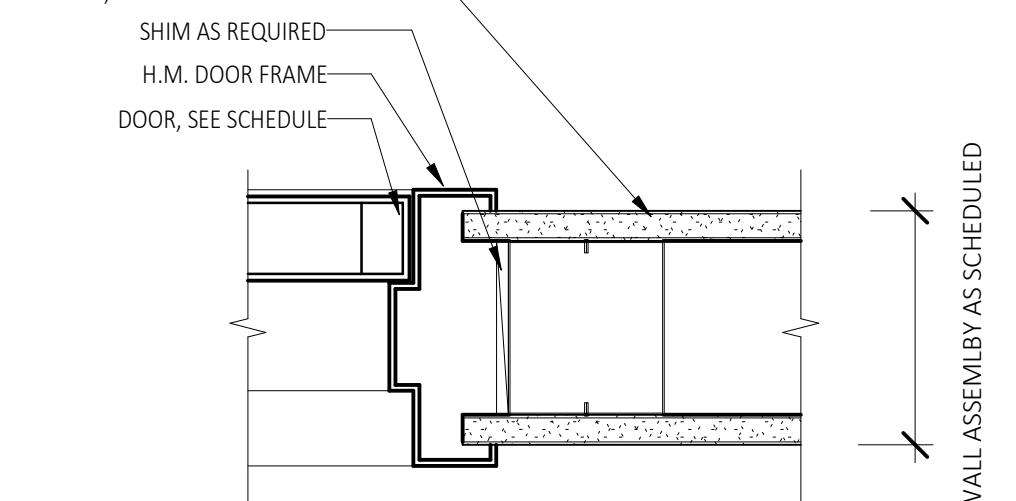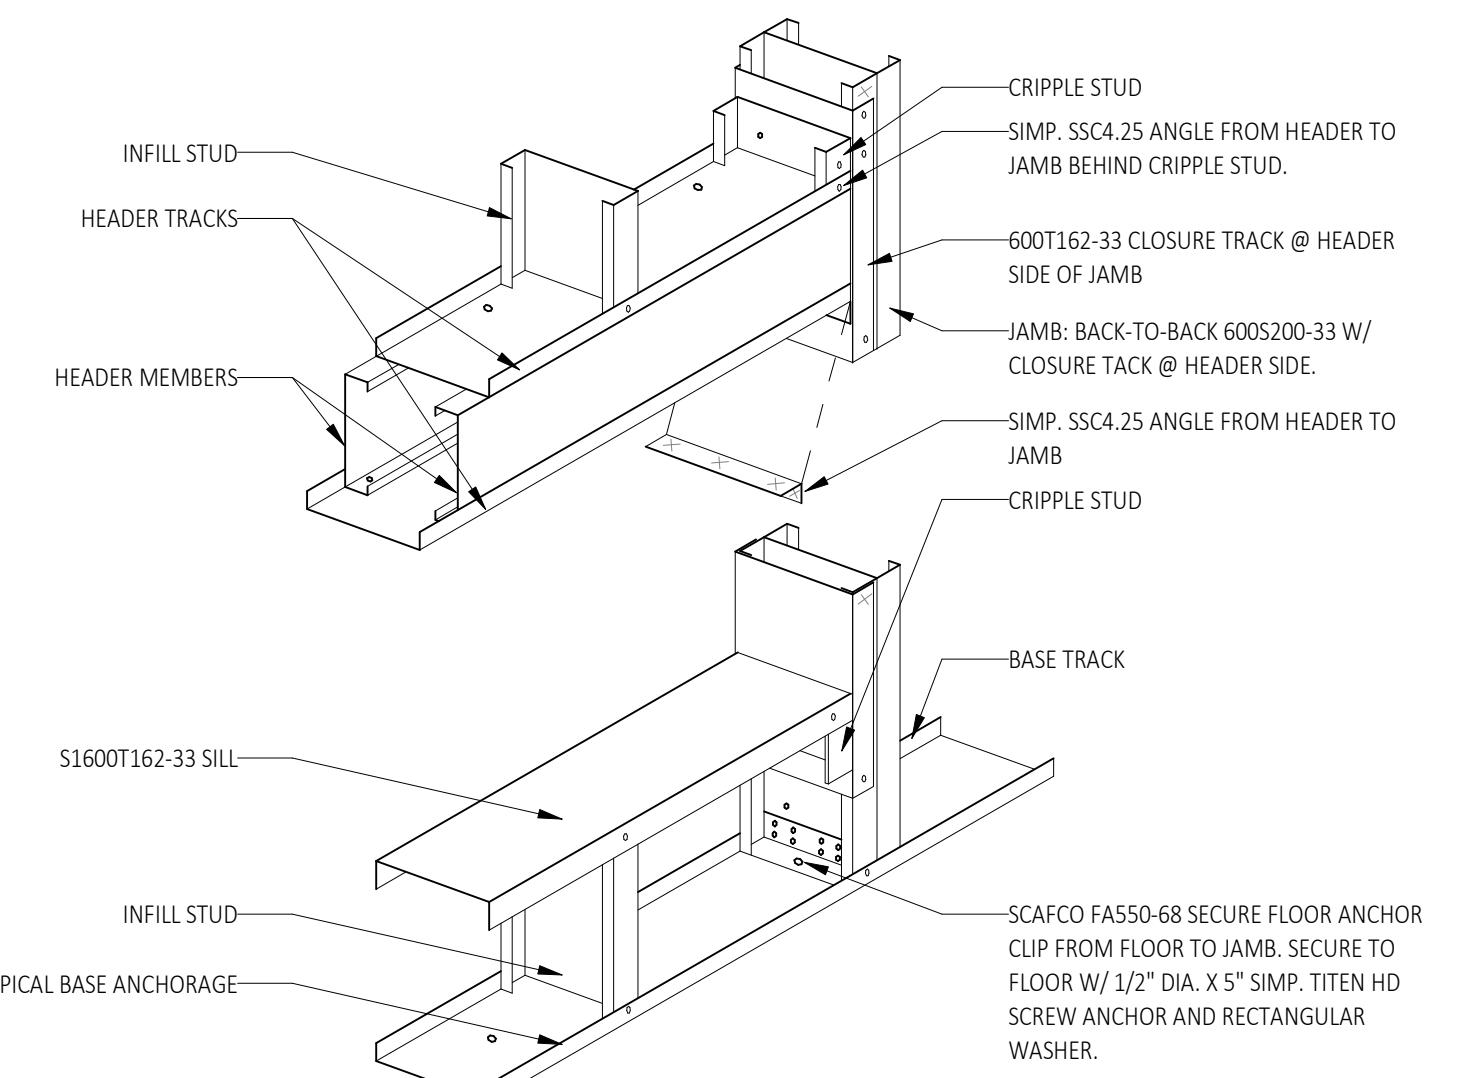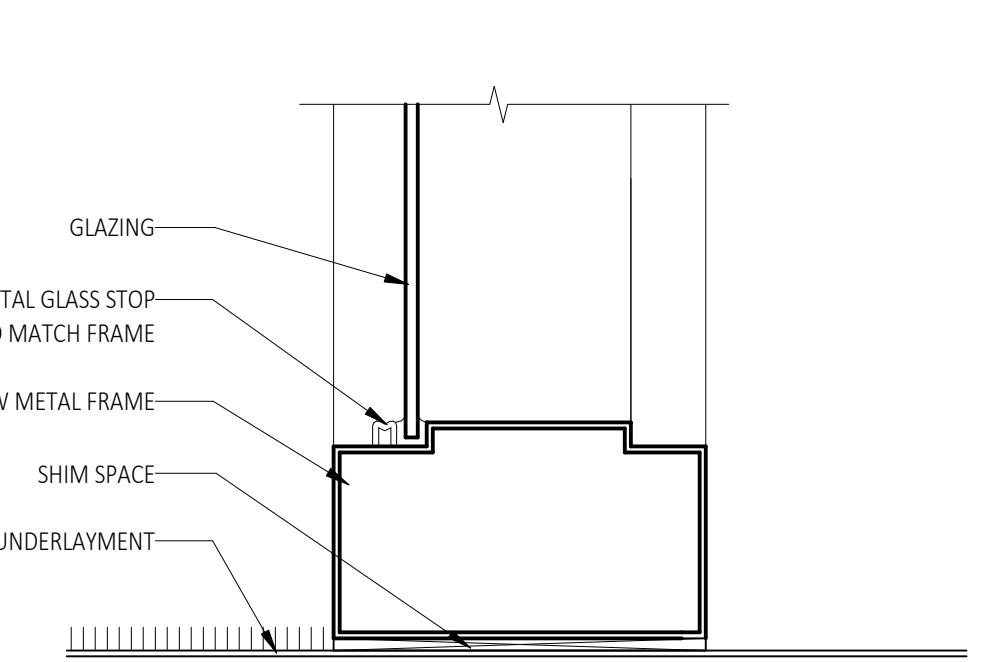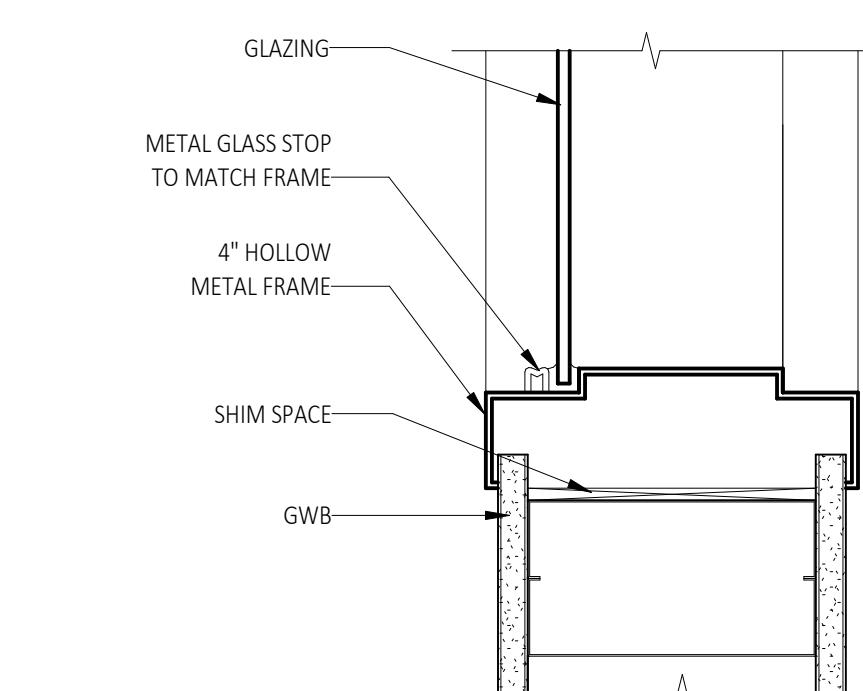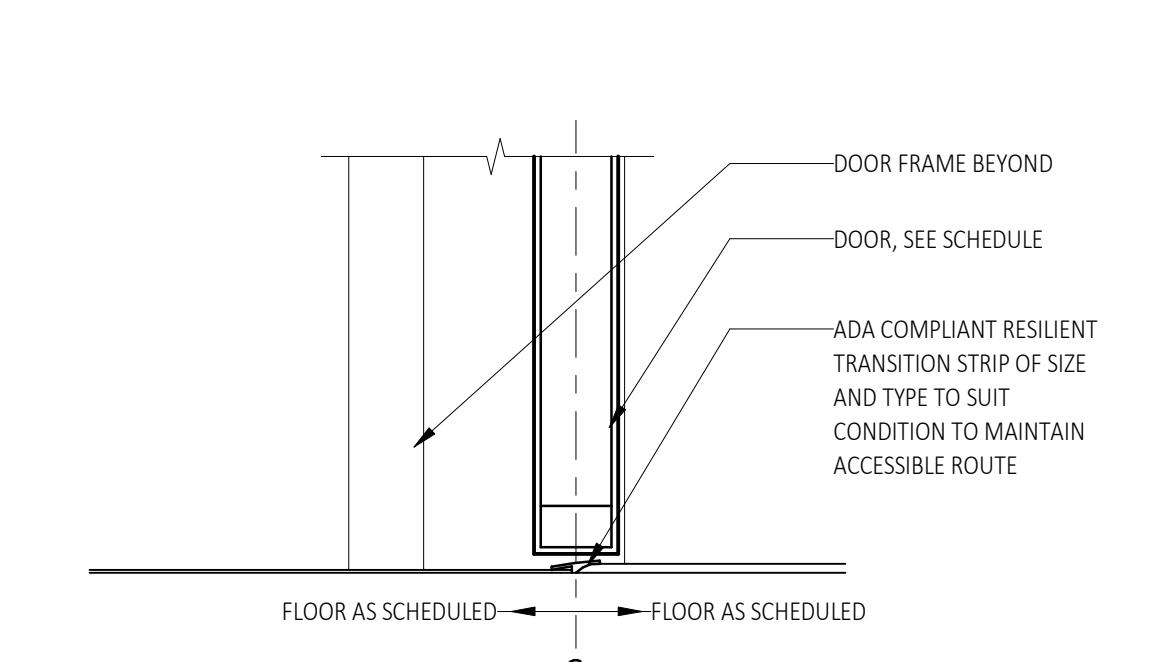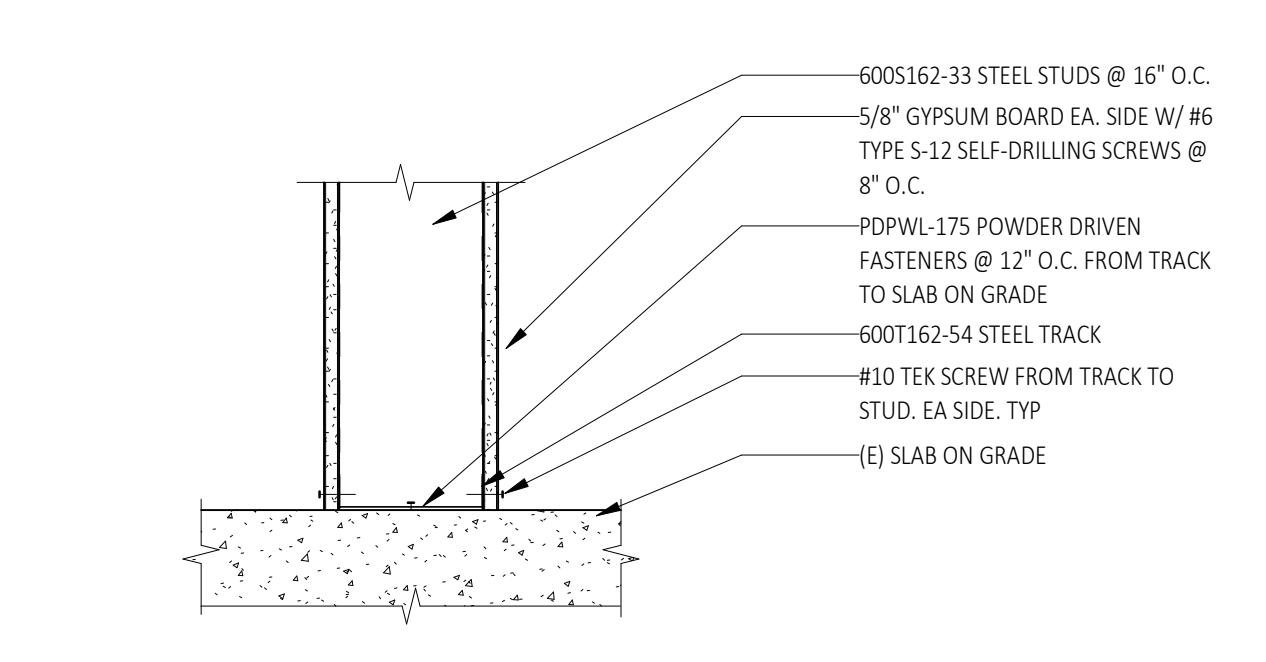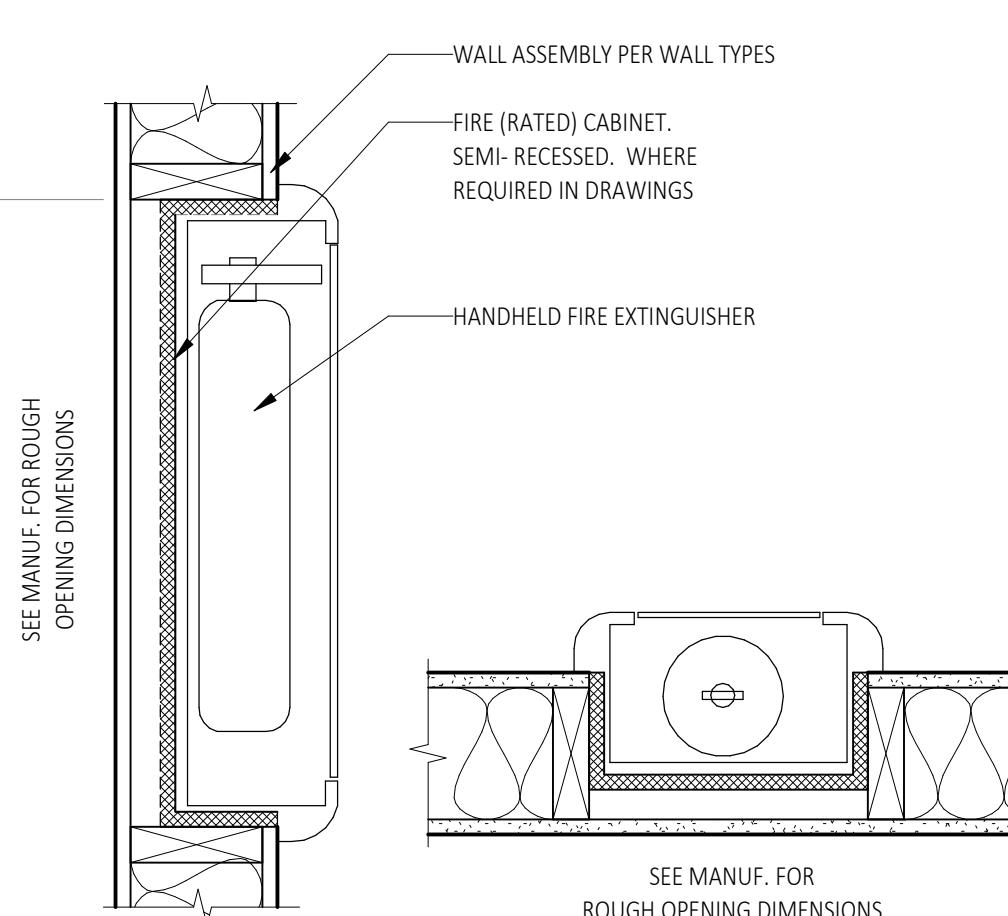 PROJECT ADDRESS:
 6605 SE Lake Rd, Milwaukie, OR
 97222

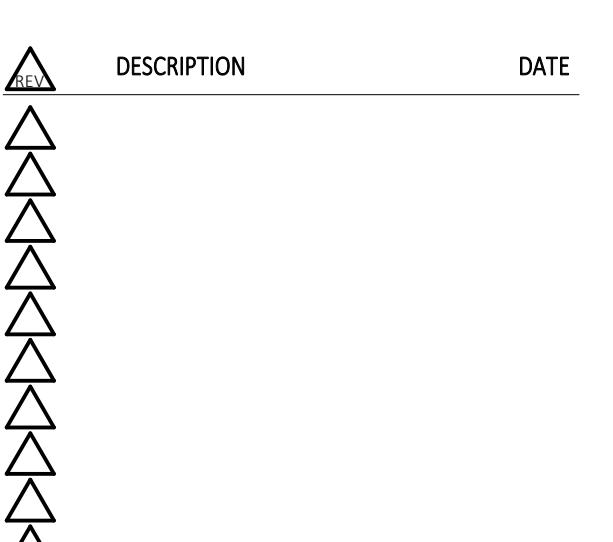 1 CEILING EDGE DETAIL - CLIP
 3" = 1'-0"

 2 CEILING JOINT - ATTACHED
 3" = 1'-0"

 3 CEILING JOINT - UNATTACHED
 3" = 1'-0"

 4 TYPICAL PARTITION HEAD AT CEILING
 3" = 1'-0"

 5 ACCOUSTICAL CEILING TILE STANDARD DETAIL
 3" = 1'-0"

 6 H.M. DOOR HEAD
 3" = 1'-0"

 7 HARD LID SOUND BARRIER CEILING DETAIL
 3" = 1'-0"

 8 H.M. WINDOW HEAD
 3" = 1'-0"

 9 H.M. RELITE JAMBS
 3" = 1'-0"

 10 H.M. DOOR JAMB
 3" = 1'-0"

 11 TYPICAL OPENING CONNECTION
 1 1/2" = 1'-0"

 12 H.M. RELITE SILL
 3" = 1'-0"

 13 H.M. WINDOW SILL
 3" = 1'-0"

 14 FLOORING TRANSITION @ DOORS
 3" = 1'-0"

 15 WALL CONNECTION TO (E) SLAB ON GRADE - NON BEARING
 1 1/2" = 1'-0"

 16 FIRE EXTINGUISHER CABINET (RECESSED)
 1 1/2" = 1'-0"

 APPROVED FOR DATE BY
 BUILDING PERMIT 02.02.24 KK

 PROJECT NO: 2221 HCR
 DRAWN BY: MALLORY FAIR
 CHECKED BY: PETER BAER
 © PINNACLE ARCHITECTURE, INC. 2024

 ORIGINAL SHEET SIZE: 30" x 42"
 INTERIOR DETAILS - REFLECTED
 CEILING & DOOR DETAILS


INTERIOR ASSEMBLIES

	<p>5/8" TYPE 'X' GYPSUM WALLBOARD METAL FRAMING TO MATCH EXISTING ACOUSTIC BATT INSULATION 5/8" TYPE 'X' GYPSUM WALLBOARD</p> <p>MARK: 9-01 FIRE RESISTANCE: 1 HOUR(S) SOURCE: GA WP 3514 STC RATING: 35-39</p>
--	---


	<p>5/8" TYPE 'X' GYPSUM WALLBOARD 1/2" RESILIENT CHANNEL LOCATED ON NON-CASEWORK/FIXTURES/GRAB BARS WHEN POSSIBLE METAL FRAMING TO MATCH EXISTING ACOUSTIC BATT INSULATION FULL CAVITY 5/8" TYPE 'X' GYPSUM WALLBOARD</p> <p>MARK: 9-02 FIRE RESISTANCE: 1 HOUR(S) SOURCE: GA WP 3242 STC RATING: 50-54</p>
--	---

GENERAL ASSEMBLY NOTES


- PARTITION TYPE TAGS ARE NOTED ON THE FLOOR PLANS. TYPICAL NEW INTERIOR WALLS SHALL BE WALL TYPE 9-01.1 WITH WALL CONFIGURATION A1, UNLESS OTHERWISE NOTED ON DRAWINGS.
- REFERENCE G1.10 & G1.11 SERIES DRAWINGS FOR LOCATION AND EXTENT OF RATED PARTITION. ANY INCONSISTENCY TO BE REVIEWED BY ARCHITECT FOR CLARIFICATION BEFORE CONSTRUCTION.
- ALL FIRE-RATED ASSEMBLIES ARE BASED UPON BC, AMERICAN WOOD COUNCIL (AWC), U.L. OR U.S. GYPSUM ASSOCIATION (GA) TEST DATA. FIRE RATED ASSEMBLIES ARE CONSTRUCTED IN ACCORDANCE WITH THE REQUIREMENTS OF THE TESTING AGENCIES. REFER TO SPECIFIC TEST REPORTS PROVIDED IN SECTION 09 2116.1.
- MANTAIN FIRE RESISTANCE RATING FOR ALL CONSTRUCTION INDICATED AT THROUGH-WALL PENETRATIONS, BUILT-IN WALL FIXTURES, ACCESSORIES, AND BEHIND MAILBOXES, FIRE EXTINGUISHER CABINETS, PLUMBING FIXTURES, ELECTRIC PANELS AND SIMILAR ITEMS, IN COMPLIANCE WITH REQUIREMENTS OF APPLICABLE CODE. COORDINATE CONSTRUCTION OF FIRE-RATED ASSEMBLIES WITH DESIGNATED DESIGN NUMBER.
- ALL EXPOSED STUDS AND COLUMNS SHALL EXTEND FROM STRUCTURAL FLOOR TO UNDERNEATH FLOOR DECK OR ROOF ABOVE, UNLESS SPECIFICALLY NOTED OTHERWISE. ALL OPENINGS AND JOINTS SHALL BE PROTECTED AS REQUIRED BY CODE.
- ACOUSTIC PARTITIONS ARE TO BE CONSTRUCTED IN ACCORDANCE WITH THE REQUIREMENTS OF TESTING AGENCIES. REFER TO SPECIFIC TEST REPORTS FOR REQUIRED COMPONENTS AND ASSEMBLY. PROVIDE 07 9005 ACOUSTIC SEALANT AROUND WALL PERIMETER & OPENINGS AT BASE GYP LAYER. IRREGULAR STUD RUNNED WITH ACOUSTIC FOAM TAPE WHERE DESIGNATED BY ASSEMBLY.
- COMPLETELY SEAL AROUND PENETRATIONS THROUGH ACOUSTICAL WALLS. FILL DEPTH OF GAPS AROUND CUT-OUTS FOR ELECTRICAL BOXES, PIPES AND PLUMBING, AND OTHER PENETRATIONS. OFFSET PENETRATIONS BY ONE STUD MINIMUM. PROVIDE INSULATION BETWEEN THE CONCEALED FACE OF FINISH MATERIALS (WITHIN THE STUD OR JOIST CAVITY) AND PIPES, PLUMBING, THE BACK OF BOXES, OR OTHER RECESSED FIXTURES.
- ALL OTHER PARTITIONS ARE TO BE CONSTRUCTED IN ACCORDANCE WITH THE REQUIREMENTS OF THE SPECIFIC MATERIALS PER APPLICABLE STANDARDS. RATED WALL CONTINUES THROUGH INTERSECTIONS WITH NON-RATED WALL, TYP.
- SEE STRUCTURAL DRAWINGS FOR STUD SPACING.
- COORDINATE WITH STRUCTURAL DRAWINGS FOR REQUIRED SHEARWALL SHEATHING. PROVIDE IN ADDITION TO COMPONENTS INDICATED ON WALL TYPE DETAILS AS REQUIRED.
- WHERE LARGER STUDS OR FURRING ARE REQUIRED TO COVER SUCCTS, PIPING, CONDUIT, ETC, THE LARGER STUD SIZE OR FURRING SHALL BE PROVIDED AND SHALL EXTEND THE FULL SURFACE OF THE WALL LENGTH AND HEIGHT WHERE THE FURRING OCCURS.
- PROVIDE ALL NECESSARY ANCHORAGE BLOCKING, BACKING AND FRAMING FOR HANDRAILS, DOOR STOPS, ELECTRO-MAGNETIC HOLD-OPENS, CASEWORK, SHELVING, MIRRORS, WALL MOUNTED EQUIPMENT AND ALL OTHER ITEMS AS REQUIRED FOR COMPLETE INSTALLATION.
- FRAME AND FINISH OPENINGS FOR MECHANICAL AND ELECTRICAL SYSTEMS AS REQUIRED BY MECHANICAL/ELECTRICAL DOCUMENTS.
- AT ALL TOILET ROOMS AND BATHROOMS, SUBSTITUTE FACE LAYER GYP BD VS. GYP BOARD FOR RESISTANCE TO FIRE STOPPING.
- FRAME WALL INTERSECTIONS AS THE CALIFORNIA CORNER OR WITH FLAT BLOCKING TO MAXIMIZE THERMAL AND ACOUSTIC PERFORMANCE.
- SEE SPEC SECTION 07 84 00 FIRESTOPPING FOR FIRE STOPPING AND FIRE JOINT SYSTEM SCHEDULE, CALCULATED PER OSSC.
- WHERE ASSEMBLY TYPE UTILIZES ADDITIONAL LAYERS (GWB, RESILIENT CHANNEL, INSULATION, ETC) BEYOND REFERENCED STANDARDS, BUILD ASSEMBLY TO MEET STANDARDS PLUS ADDITIONALLY LAYER AS OUTLINED HEREIN.
- COMPLY WITH STRUCTURAL DEPTH AND SPACING. INCREASED DEPTH IS ACCEPTABLE PER GENERAL EXPLANATORY NOTE 15 OF GA FIRE RESISTANCE DESIGN MANUAL.
- PROVIDE FIRE BLOCKING PER CODE.

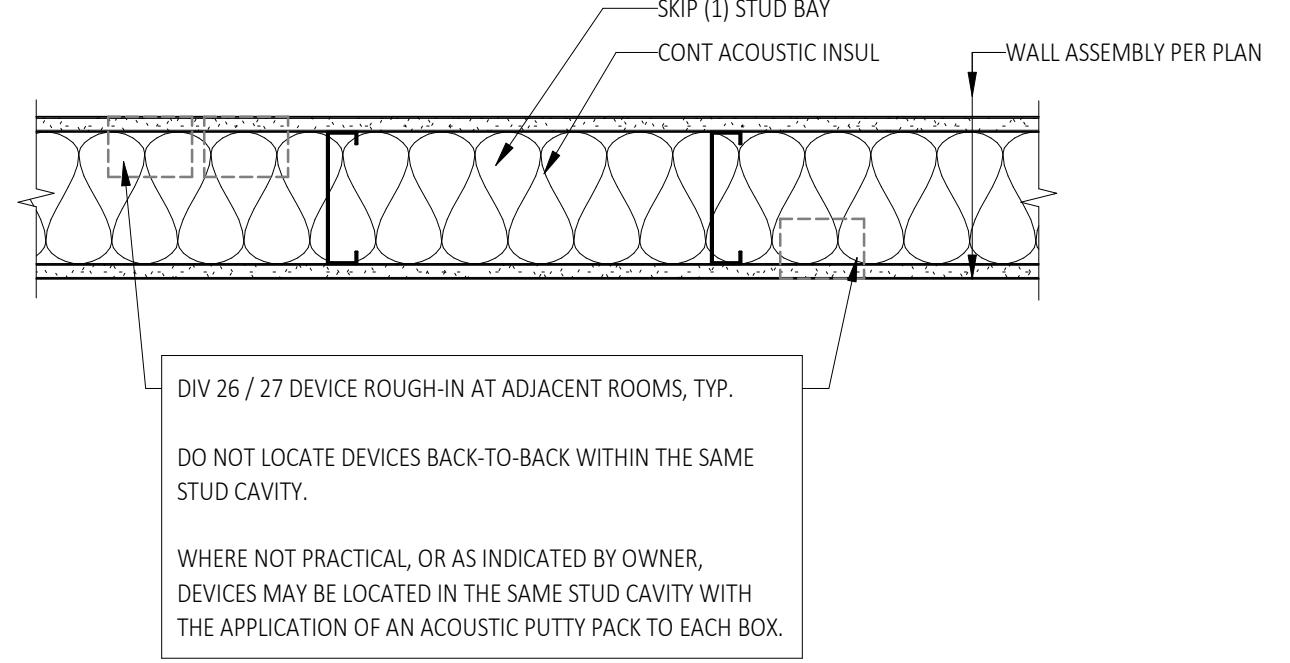

1 ACOUSTIC DEVICE SEPARATION
1 1/2" = 1'-0"

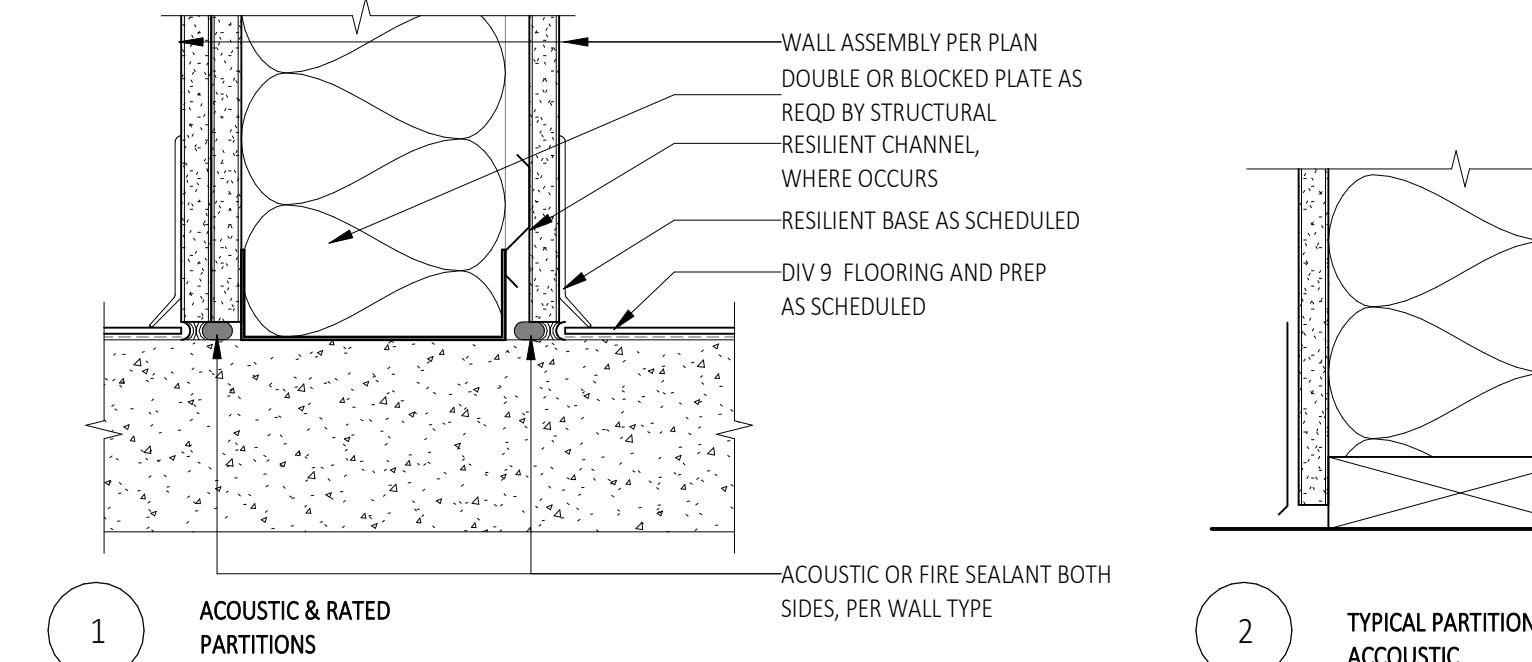

2 PARTITION BASE CONDITIONS
3" = 1'-0"

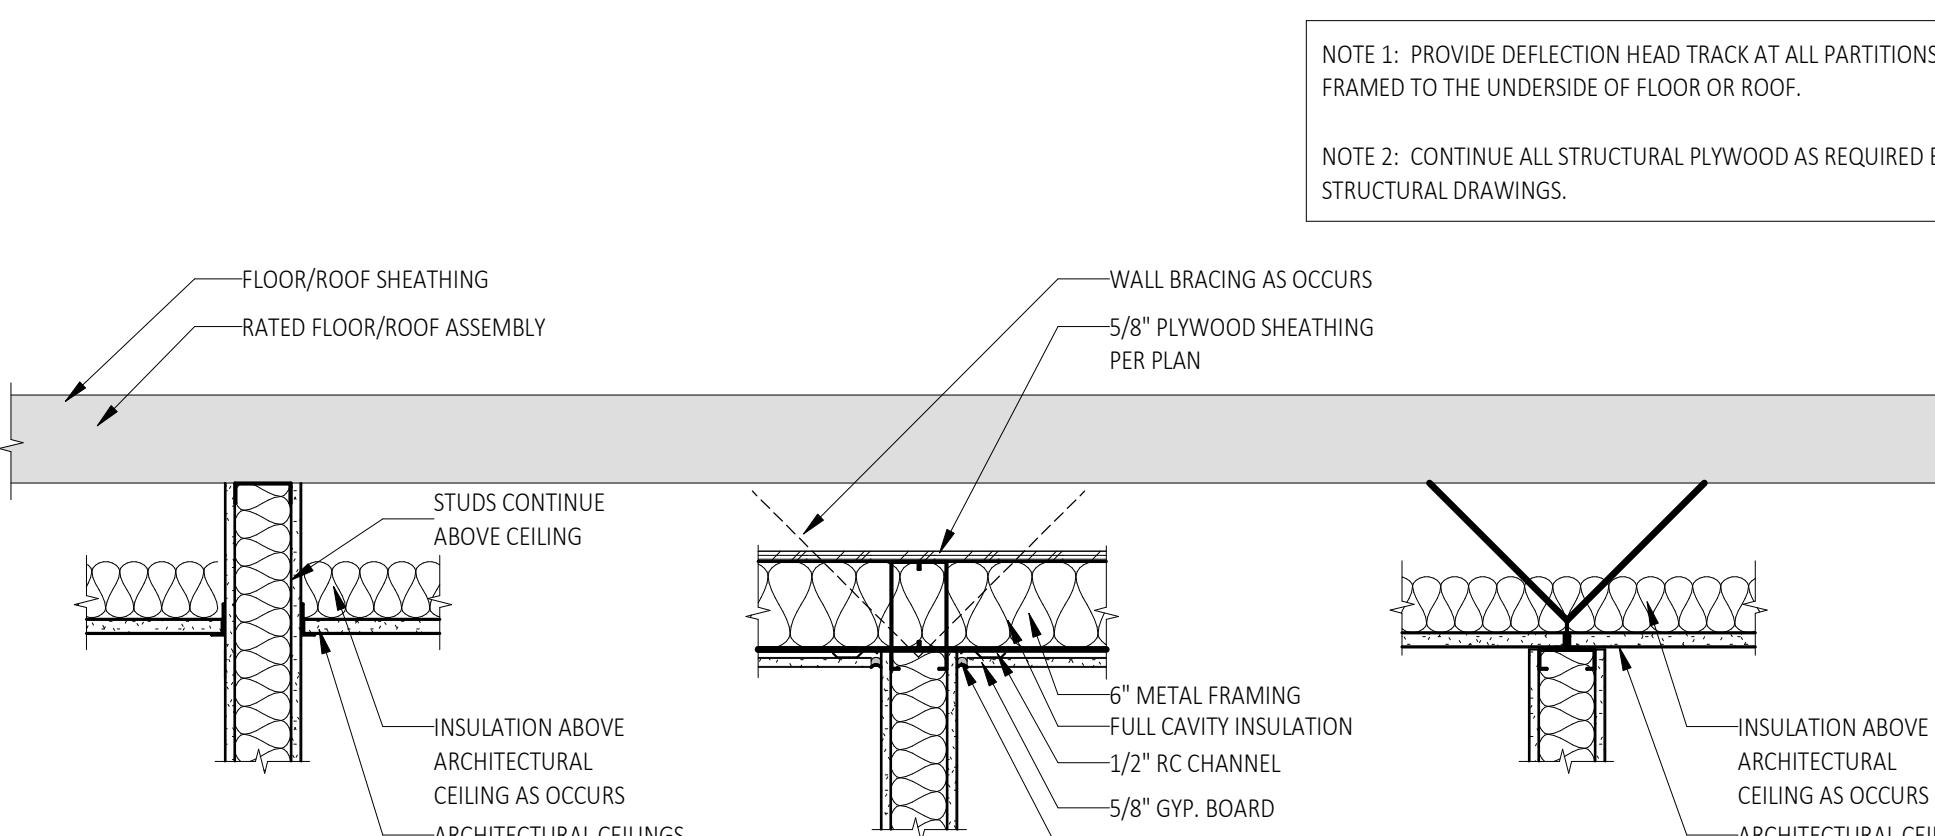

3 PARTITION TOP CONDITIONS
1" = 1'-0"

LAKE ROAD HEALTH CENTER
CLIENT:
CLACKAMAS COUNTY

PROJECT ADDRESS:
6605 SE Lake Rd, Milwaukie, OR
97222

APPROVED FOR DATE BY
BUILDING PERMIT 02.02.24 KK

DESCRIPTION DATE
ASSEMBLIES
NOTE 1: PROVIDE DEFLECTION HEAD TRACK AT ALL PARTITIONS
FRAMED TO THE UNDERSIDE OF FLOOR OR ROOF.
NOTE 2: CONTINUE ALL STRUCTURAL PLYWOOD AS REQUIRED BY
STRUCTURAL DRAWINGS.

PROJECT NO: 2221.HCR
DRAWN BY: BUL
CHECKED BY: PETER BAER
© PINNACLE ARCHITECTURE, INC. 2024 ORIGINAL SHEET SIZE: 30" x 42"

ASSEMBLIES

A6.10



LAKE ROAD HEALTH CENTER

CLIENT:
CLACKAMAS COUNTY

PROJECT ADDRESS:
6605 SE Lake Rd, Milwaukie, OR
97222

APPROVED FOR DATE BY
BUILDING PERMIT 02.02.24 KK

DESCRIPTION DATE
PROJECT NO: 2221.HCR
DRAWN BY: B JL
CHECKED BY: PETER BAER
© PINNACLE ARCHITECTURE, INC. 2024 ORIGINAL SHEET SIZE: 30" x 42"

DOORS & WINDOWS

NUMBER	Door Schedule									
	WIDTH	HEIGHT	THICKNESS	DOOR TYPE	DOOR MATERIAL	DOOR FINISH	FRAME MATERIAL	FRAME FINISH	HARDWARE GROUP	COMMENTS
100	6' - 0"	7' - 0"	1 3/4"	SF FFG	EXIST	EXIST				ACCESS CONTROLLED DOOR WITH CARD READER AND ELECTRIFIED HARDWARE
101A	3' - 0"	7' - 0"	1 3/4"	FG2	SCWD	MATCH (E) WOOD	HM	PAINT		ACCESS CONTROLLED DOOR WITH CARD READER AND ELECTRIFIED HARDWARE
101B	3' - 0"	7' - 0"	1 3/4"	F	EXIST	EXIST				ACCESS CONTROLLED DOOR WITH CARD READER AND ELECTRIFIED HARDWARE
102	3' - 0"	7' - 0"	1 3/4"	FG5	SCWD	MATCH (E) WOOD	HM	PAINT		
103	3' - 0"	7' - 0"	1 3/4"	FG5	SCWD	MATCH (E) WOOD	HM	PAINT		
104	3' - 0"	7' - 0"	1 3/4"	FG5	EXIST	EXIST				
105	3' - 0"	7' - 0"	1 3/4"	FG5	SCWD	MATCH (E) WOOD	HM	PAINT		
106	3' - 0"	7' - 0"	1 3/4"	FG5	EXIST	EXIST				
107	3' - 0"	7' - 0"	1 3/4"	FG5	EXIST	EXIST				
108	3' - 0"	7' - 0"	1 3/4"	FG5	EXIST	EXIST				
109A	3' - 0"	7' - 0"	1 3/4"	FG5	EXIST	EXIST				
109B	3' - 0"	7' - 0"	1 3/4"	F	EXIST	EXIST				
110	3' - 0"	7' - 0"	1 3/4"	FG5	EXIST	EXIST				
111	3' - 0"	7' - 0"	1 3/4"	FG3	EXIST	EXIST				NEW HALF UTE RELITE KIT
112	3' - 0"	7' - 0"	1 3/4"	FG3	EXIST	EXIST				NEW HALF UTE RELITE KIT
113	3' - 0"	7' - 0"	1 3/4"	FG3	EXIST	EXIST				NEW HALF UTE RELITE KIT
114	3' - 0"	7' - 0"	1 3/4"	FG3	EXIST	EXIST				NEW HALF UTE RELITE KIT
115	3' - 0"	7' - 0"	1 3/4"	FG3	EXIST	EXIST				NEW HALF UTE RELITE KIT
116	3' - 0"	7' - 0"	1 3/4"	FG4	SCWD	MATCH (E) WOOD	HM	PAINT		
117	3' - 0"	7' - 0"	1 3/4"	FG3	EXIST	EXIST				NEW HALF UTE RELITE KIT
118	3' - 0"	7' - 0"	1 3/4"	FG3	EXIST	EXIST				NEW HALF UTE RELITE KIT
119	3' - 0"	7' - 0"	1 3/4"	FG3	EXIST	EXIST				NEW HALF UTE RELITE KIT
120	3' - 0"	7' - 0"	1 3/4"	FG3	EXIST	EXIST				NEW HALF UTE RELITE KIT
121	3' - 0"	7' - 0"	1 3/4"	FG4	SCWD	MATCH (E) WOOD	HM	PAINT		
122	3' - 0"	7' - 0"	1 3/4"	F	EXIST	EXIST				
123	3' - 0"	7' - 0"	1 3/4"	FG5	EXIST	EXIST				NEW HALF UTE RELITE KIT
125	3' - 0"	7' - 0"	1 3/4"	FG3	EXIST	EXIST				NEW HALF UTE RELITE KIT
126	3' - 0"	7' - 0"	1 3/4"	FG3	EXIST	EXIST				NEW HALF UTE RELITE KIT
127	3' - 0"	7' - 0"	1 3/4"	FG3	EXIST	EXIST				NEW HALF UTE RELITE KIT
128A	3' - 0"	7' - 0"	1 3/4"	FG4	EXIST	EXIST				NEW HALF UTE RELITE KIT
128B	3' - 0"	7' - 0"	1 3/4"	F	EXIST	EXIST				
129A	3' - 0"	7' - 0"	1 3/4"	FG4	SCWD	MATCH (E) WOOD	HM	PAINT		
129B	3' - 0"	7' - 0"	1 3/4"	FG4	SCWD	MATCH (E) WOOD	HM	PAINT		
130	3' - 0"	7' - 0"	1 3/4"	FG5	EXIST	EXIST				ACCESS CONTROLLED DOOR WITH CARD READER AND ELECTRIFIED HARDWARE
131	3' - 0"	7' - 0"	1 3/4"	F	EXIST	EXIST				
132	3' - 0"	7' - 0"	1 3/4"	F	EXIST	EXIST				ACCESS CONTROLLED DOOR WITH CARD READER AND ELECTRIFIED HARDWARE
133	3' - 0"	7' - 0"	1 3/4"	F	EXIST	EXIST				
135	3' - 0"	7' - 0"	1 3/4"	F	EXIST	EXIST				
136	3' - 0"	7' - 0"	1 3/4"	F	EXIST	EXIST				
137	3' - 0"	7' - 0"	1 3/4"	F	EXIST	EXIST				
138A	3' - 0"	7' - 0"	1 3/4"	F	EXIST	EXIST				
138B	3' - 0"	7' - 0"	1 3/4"	F	EXIST	EXIST				
139	3' - 0"	7' - 0"	1 3/4"	F	EXIST	EXIST				
140	3' - 0"	7' - 0"	1 3/4"	F	EXIST	EXIST				
141	3' - 0"	7' - 0"	1 3/4"	F	EXIST	EXIST				
142	6' - 0"	7' - 0"	1 3/4"	FF	EXIST	EXIST				
143A	3' - 0"	7' - 0"	1 3/4"	F	EXIST	EXIST				
144A	3' - 0"	7' - 0"	1 3/4"	F	SCWD	MATCH (E) WOOD	HM	PAINT		
144B	3' - 0"	7' - 0"	1 3/4"	F	SCWD	MATCH (E) WOOD	HM	PAINT		
144C	3' - 0"	7' - 0"	1 3/4"	F	SCWD	MATCH (E) WOOD	HM	PAINT		
145A	5' - 0"	7' - 0"	1 3/4"	FF	EXIST	EXIST				SALVAGED DOORS FROM DEMO ROOM 146, ACCESS CONTROLLED DOOR WITH CARD READER AND ELECTRIFIED HARDWARE
145B	6' - 0"	7' - 0"	1 3/4"	FF	EXIST	EXIST				
147	3' - 0"	7' - 0"	1 3/4"	F	EXIST	EXIST				ACCESS CONTROLLED DOOR WITH CARD READER AND ELECTRIFIED HARDWARE
200	6' - 0"	7' - 0"	1 3/4"	SF FFG	EXIST	EXIST				ACCESS CONTROLLED DOOR WITH CARD READER AND ELECTRIFIED HARDWARE
201	6' - 0"	7' - 0"	1 3/4"	SF FFG	EXIST	EXIST				
202	3' - 0"	7' - 0"	1 3/4"	F	EXIST	PAINT				
203	3' - 0"	7' - 0"	1 3/4"	FG2	SCWD	PAINT	HM	PAINT		
204A	3' - 0"	7' - 0"	1 3/4"	F	EXIST	PAINT				ACCESS CONTROLLED DOOR WITH CARD READER AND ELECTRIFIED HARDWARE
204B	3' - 0"	7' - 0"	1 3/4"	F	EXIST	PAINT				
205	3' - 0"	7' - 0"	1 3/4"	FG2	EXIST	PAINT				
207	5' - 0"	7' - 0"	1 3/4"	FF	EXIST	PAINT				
208A	3' - 0"	7' - 0"	1 3/4"	F	EXIST	PAINT				
208B	3' - 0"	7' - 0"	1 3/4"	F	EXIST	PAINT				
209	3' - 0"	7' - 0"	1 3/4"	F	EXIST	PAINT				
211	3' - 0"	7' - 0"	1 3/4"	FG2	SCWD	PAINT	HM	PAINT		
212	3' - 0"	7' - 0"	1 3/4"	FG2	SCWD	PAINT	HM	PAINT		
214A	6' - 0"	7' - 0"	1 3/4"	FG2	EXIST	PAINT				
214B	3' - 0"	7' - 0"	1 3/4"	F	EXIST	PAINT				
215	3' - 0"	7' - 0"	1 3/4"	F	EXIST	PAINT				
217	3' - 0"	7' - 0"	1 3/4"	FG3	SCWD	PAINT				
219	3' - 0"	7' - 0"	1 3/4"	FG3	SCWD	PAINT				
220	3' - 0"	7' - 0"	1 3/4"	FG2	EXIST	PAINT				
221	3' - 0"	7' - 0"	1 3/4"	FG3	SCWD	PAINT	HM	PAINT		
222A	3' - 0"	7' - 0"	1 3/4"	FG3	SCWD	PAINT	HM	PAINT		
223	3' - 0"	7' - 0"	1 3/4"	F	EXIST	PAINT	EXIST	PAINT		

||
||
||

PLUMBING FIXTURE SCHEDULE

ALL FIXTURES TO BE CLACKAMAS COUNTY STANDARDS.

WATER CLOSET

MFR: CAROMA
PRODUCT: CARAVELLE 270 ELONGATED, ADA
SEAT: CARAVELLE COM. ELONGATED, OPEN FRON 326013
NOTES: DUAL FLUSH, WATER-SAVING WATER CLOSET

LAVATORY

MFR: KOHLER
PRODUCT: FARMINGTON K-2905-4 (BARRIER FREE)

FAUCET: SLOAN EFT-600 BDT WITH EFT-233 TRANSFORMER AND MIXING VALVE

SINK

MFR: ELKAY
PRODUCT: LRAD 1517-6 LUSTERTONE, STAINLESS STEEL, 15" X 17-1/2" X 6-1/2", SINGLE BOWL DROP-IN ADA SINK

FAUCET: DELTA SINGLE HANDLE

NOTES:

GENERAL FLOOR PLAN NOTES

1. SEE SHEET A6.10 FOR WALL, FLOOR AND ROOF ASSEMBLIES.

2. SEE G5.10 FOR MOUNTING HEIGHTS AND ACCESSIBILITY DETAILS.

3. OUTSIDE WINDOW DIMENSIONS ARE TO CENTER OF ROUGH OPENING, UNLESS NOTED OTHERWISE.

4. WALL DIMENSIONS ARE TO FACE OF STUD AND/OR FACE OF CMU/CONCRETE, UNLESS NOTED OTHERWISE.

5. CONTRACTORS TO FELD VERIFY EXISTING ROUGH OPENING DIMENSIONS PRIOR TO ORDERING DOORS AND WINDOWS.

6. ALL DOORS WITH GLAZING TO HAVE SAFETY GLAZING PER CODE.

7. CONTRACTOR SHALL PROVIDE MEANS TO PROTECT THE PUBLIC AND WORKERS DURING THE DEMOLITION PROCESS.

8. DOOR AND WINDOW SUPPLIER RESPONSIBLE FOR LOCATING HARDWARE IN ACCESSIBLE SPACES TO BE LESS THAN 48" ABOVE FINISH FLOOR INCLUDING BUMPER CONTROLS.

9. UNLISTED DOORS RESPONSIBLE FOR GLAZING WITHIN 24" OF DOORS TO BE TEMPERED.

10. SEE FINISH FLOOR PLAN SHEETS FOR CORNER GUARD LOCATIONS.

11. RESILIENT CHANNEL TO NOT BE INSTALLED ON WALLS WITH MOUNTED FIXTURES. USE OPPOSITE SIDE WHEN POSSIBLE.

12. DOORS PERPENDICULAR TO WALLS TO BE MIN. 6' FROM ADJACENT WALL TYP. U.N.O.

13. ALL WALL TYPES WITHOUT HEAD CONDITIONS NOTED ARE EXISTING TO REMAIN OR TYPE C, WITH INSULATION OVER THE TOP OF THE HEAD CONNECTION. SEE 1.2 AND 3.6A.10.


14. ALL MECHANICAL AND ELECTRICAL SYSTEMS TO MEET CURRENT ENERGY CODE STANDARDS.

FLOOR PLAN LEGEND

- EXISTING WALL TO REMAIN
- NEW WALL OR INFILL OF EXISTING, TYPE AS NOTED OR TO MATCH EXISTING
- EXISTING DOOR TO REMAIN
- NEW DOOR

KEYNOTES - FLOOR PLANS

Key Value	Keynote Text
FP011	ALIGN NEW WALL WITH EXISTING MULLION
FP012	NO WORK ANTICIPATED IN THIS ROOM, REFER TO FINISH SCHEDULE AND PLAN FOR ANY PAINT UPDATES.
FP014	(E) CASEWORK TO REMAIN IN PLACE
FP022	PROVIDE ACCESS PANEL, MIN 24" X 24", FOR ACCESS TO PLUMBING CHASE
FP025	PROTECT (E) WAINSCOT IN ROOM FROM (N) CONSTRUCTION; SCRIBE NEW WALL TO WAINSCOT AS REQ'D
FP029	(E) CLOSERY GLAZING TO REMAIN IN PLACE
FP030	(N) WALL INFILL AT DEMO' GLAZING, REFER TO DEMO PLANS.
FP031	ACCESS CONTROLLED DOOR
FP032	NO WORK ANTICIPATED IN THIS ROOM BEYOND NEW FINISH FLOOR, WALL BASE, OR WALL PAINT. REFER TO FINISH PLANS.
FP035	PROVIDE ONE-HAN. MIRRORED PRIVACY FILM AT WINDOW BASH OF DESIGNS. 3M MIRROR FILM. LIGHTING LEVELS OF ROOMS TO BE ADJUSTED IN ORDER TO PROVIDE VISIBILITY FROM OBSERVATION 331 INTO POT THERAPY 329, AND AVOID VISIBILITY FROM PCIT THERAPY 329 INTO OBSERVATION 331. COORDINATE WITH ELECTRICAL.

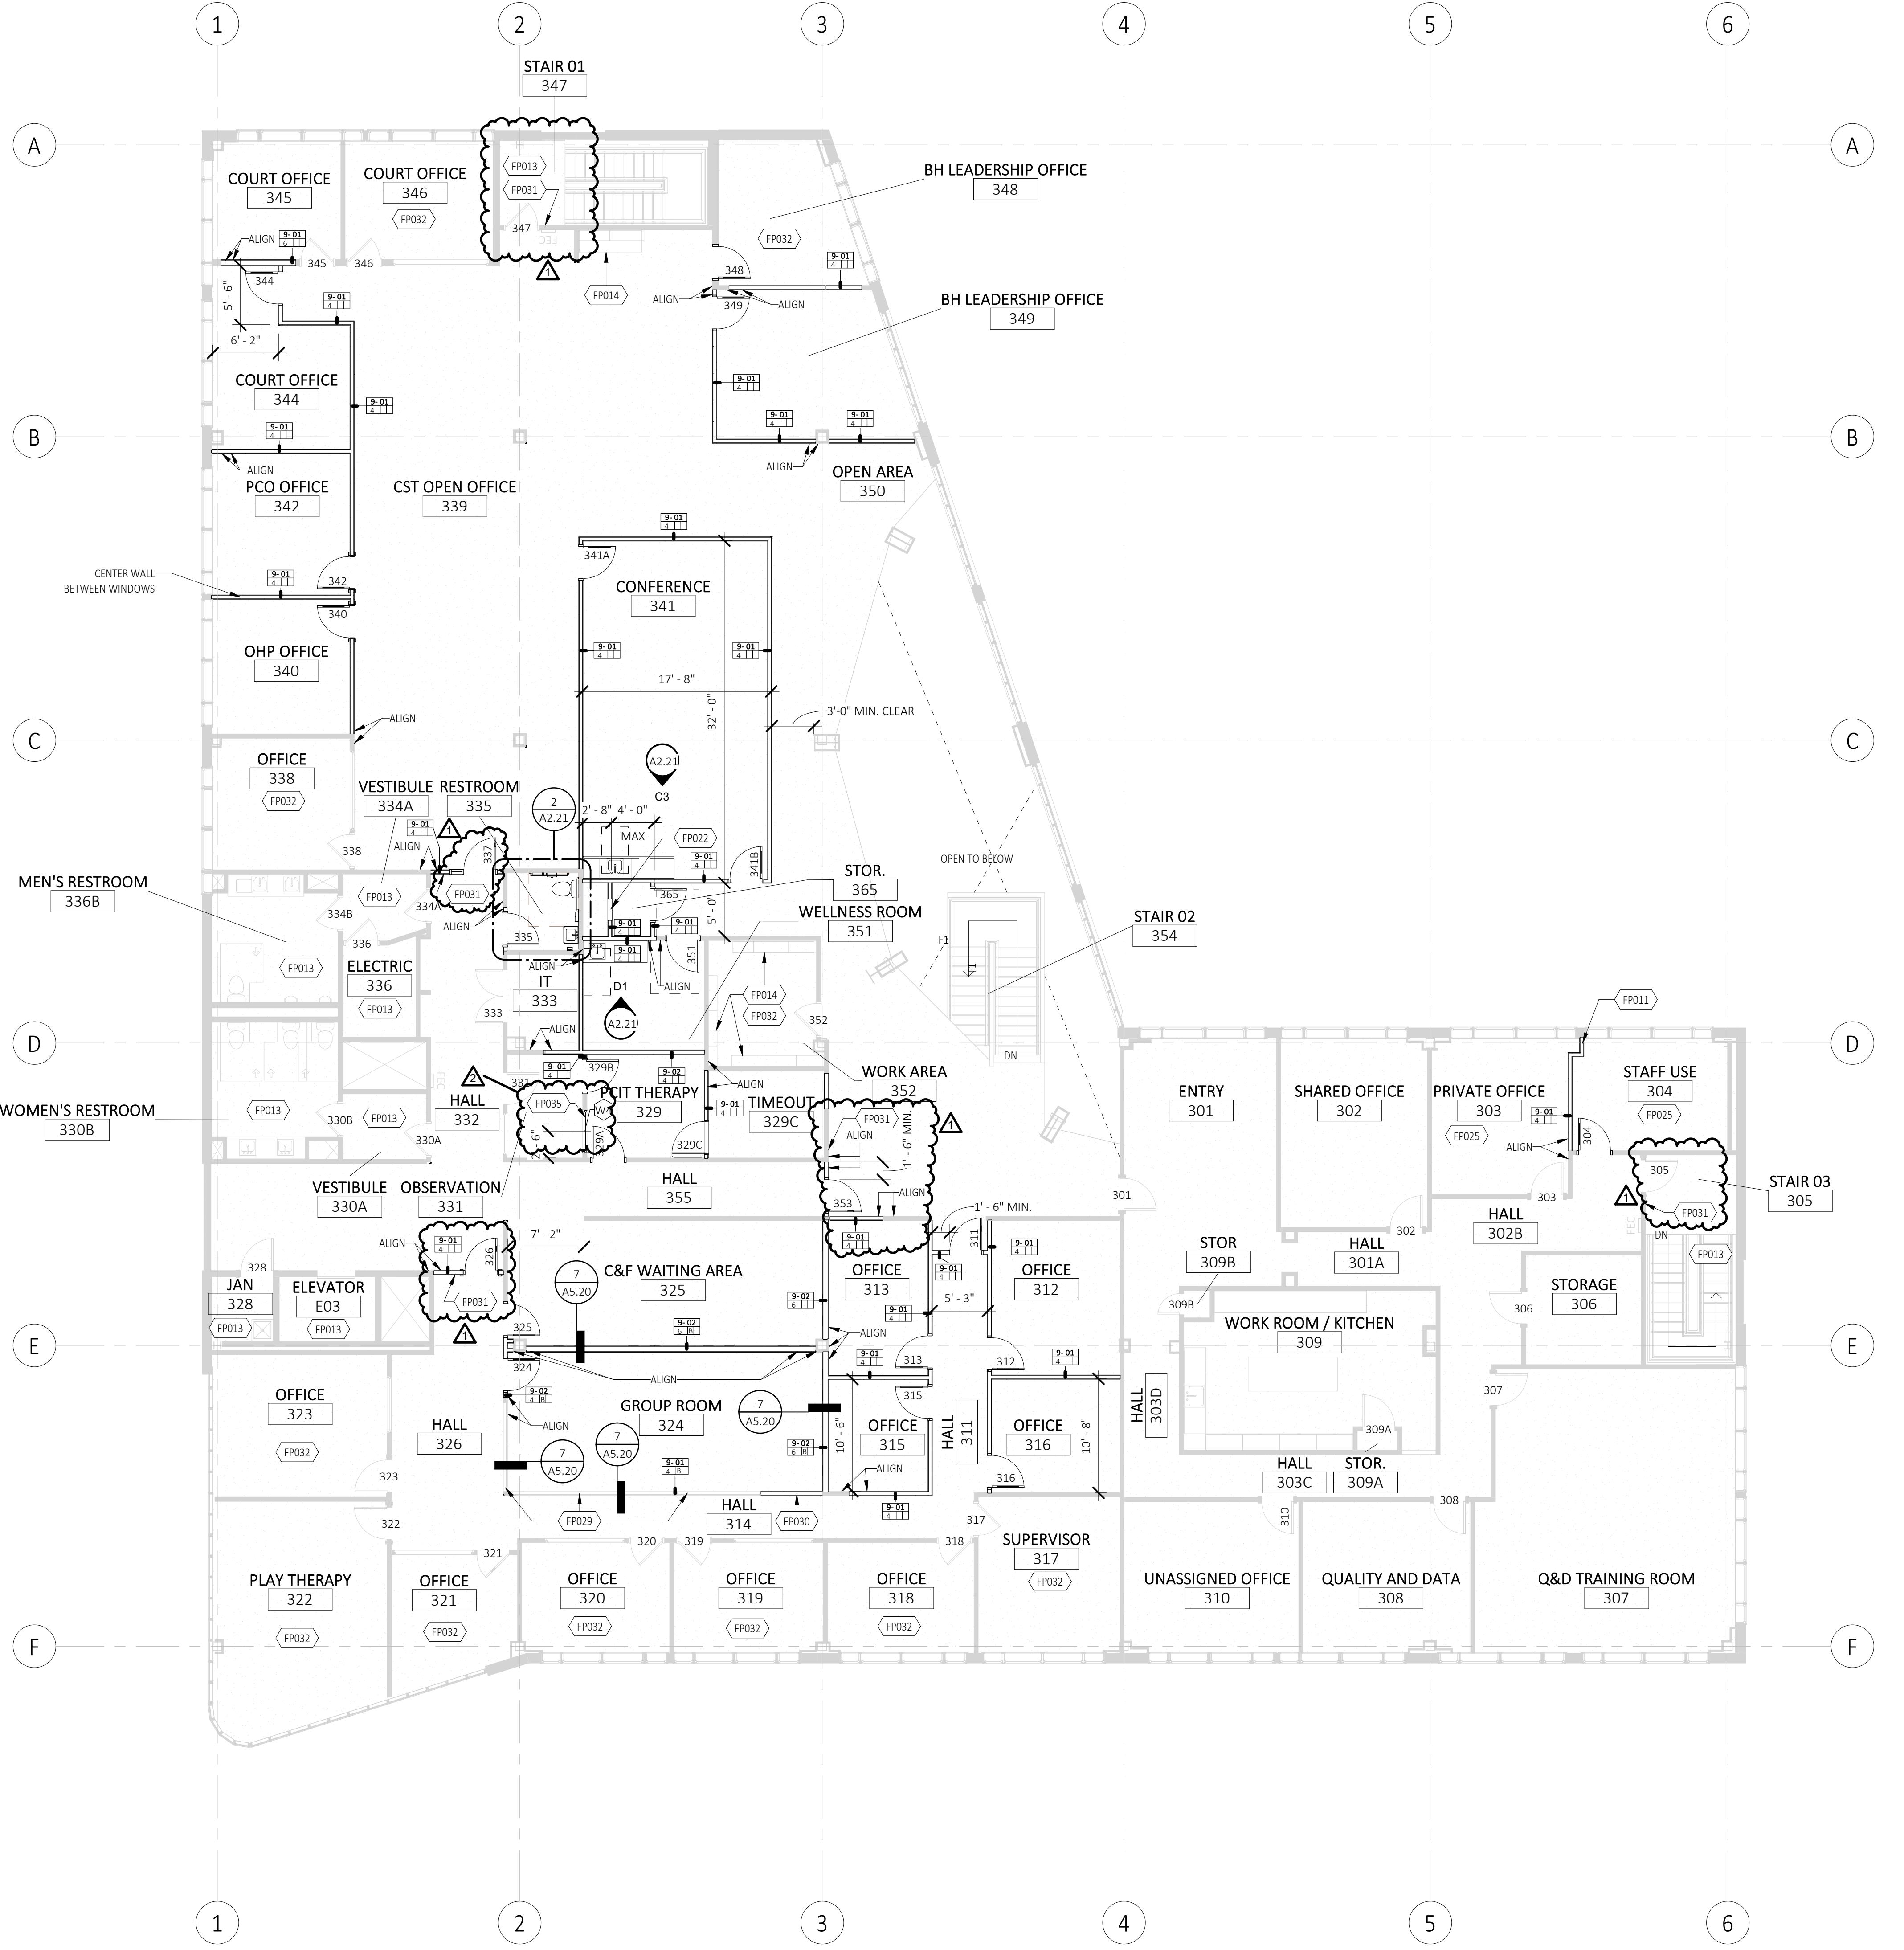

1 LEVEL 03
1/8" = 1'-0"

A1.12
NORTH

APPROVED FOR	DATE	BY
BUILDING PERMIT	02.02.24	KK
PLAN CHECK	04.05.24	
COMMENTS		
ADDENDUM 01	05.03.24	

GENERAL RCP NOTES

- EXISTING CEILING PLAN IS FOR GENERAL REFERENCE ONLY, FOR GENERAL COORDINATION OF FIXTURE TYPES AND LOCATIONS.
- CEILING HEIGHTS AND TYPES TO BE VERIFIED IN FIELD.
- REPLACE DAMAGED CEILING TILES AS REQUIRED.
- REPLACE CEILING TILES AS REQUIRED FOR NEW LAYOUTS AND ACOUSTICAL PERFORMANCE PER WALL HEAD CONDITION.
- MECHANICAL GRILLES, LOUVERS, LIGHTING, SPRINKLERS AND OTHER CEILING ITEMS TO BE ADJUSTED AS REQUIRED FOR NEW LAYOUTS.

pinnacle
architecture, inc.

"ENHANCING LIVES AND COMMUNITIES"

1001 SW DISK DRIVE, SUITE 105
BEND OR 97702
541.388.9897
WWW.PINNACLEARCHITECTURE.COM

REFLECTED CEILING PLAN LEGEND

GYP-1	(E) GYPSUM WALLBOARD CEILING ON METAL FRAMING
ACT-2	2x4 ACT SYSTEM
■	SUPPLY DIFFUSERS
■	RETURN DIFFUSERS
■	RECESSED TROFFER LIGHT, 2'x4'
■	RECESSED TROFFER LIGHT, 2'x2'
■	LINEAR LIGHT
—	TRACK LIGHTING
○	CAN LIGHT
○	PENDANT LIGHT
●	FIRE SPRINKLER
(S)	SPEAKER GRILLE
■	ACCESS HATCH



KEYNOTES	
Key Value	Keynote Text

RCP001 REFER TO FLOOR PLAN ON SHEET A1.12 FOR NOTES ON (N) ONE-WAY MIRRORED WINDOW FOR LIGHT LEVEL COORDINATION.

APPROVED FOR	DATE	BY
BUILDING PERMIT	02.02.24	KK
ADDENDUM 01	05.03.24	

PROJECT NO: 2221 HCR
DRAWN BY: MALLORY FAIR
CHECKED BY: PETER BAER
© PINNACLE ARCHITECTURE, INC. 2024 ORIGINAL SHEET SIZE: 30" x 42"

3RD FLOOR EXISTING REFLECTED
CEILING PLAN



A1.22
NORTH



PETER E. BAER

BEND, OREGON 97703

LAKE ROAD HEALTH CENTER

CLIENT:
CLACKAMAS COUNTY

PROJECT ADDRESS:
6601 SE Lake Rd, Portland, OR
97222

NUMBER	Door Schedule									
	WIDTH	HEIGHT	THICKNESS	DOOR TYPE	DOOR MATERIAL	DOOR FINISH	FRAME MATERIAL	FRAME FINISH	HARDWARE GROUP	COMMENTS
100	6'-0"	7'-0"	1 3/4"	SF FFG	EXIST	EXIST				ACCESS CONTROLLED DOOR WITH CARD READER AND ELECTRIFIED HARDWARE
101A	3'-0"	7'-0"	1 3/4"	FG2	SCWD	MATCH (E) WOOD	HM	PAINT		ACCESS CONTROLLED DOOR WITH CARD READER AND ELECTRIFIED HARDWARE
101B	3'-0"	7'-0"	1 3/4"	F	EXIST	EXIST				ACCESS CONTROLLED DOOR WITH CARD READER AND ELECTRIFIED HARDWARE
102	3'-0"	7'-0"	1 3/4"	FG5	SCWD	MATCH (E) WOOD	HM	PAINT		
103	3'-0"	7'-0"	1 3/4"	FG5	SCWD	MATCH (E) WOOD	HM	PAINT		
104	3'-0"	7'-0"	1 3/4"	FG5	EXIST	EXIST				
105	3'-0"	7'-0"	1 3/4"	FG5	SCWD	MATCH (E) WOOD	HM	PAINT		
106	3'-0"	7'-0"	1 3/4"	FG5	EXIST	EXIST				
107	3'-0"	7'-0"	1 3/4"	FG5	EXIST	EXIST				
108	3'-0"	7'-0"	1 3/4"	FG5	EXIST	EXIST				
109A	3'-0"	7'-0"	1 3/4"	FG5	EXIST	EXIST				
109B	3'-0"	7'-0"	1 3/4"	F	EXIST	EXIST				
110	3'-0"	7'-0"	1 3/4"	FG5	EXIST	EXIST				
111	3'-0"	7'-0"	1 3/4"	FG3	EXIST	EXIST				NEW HALF UTE RELITE KIT
112	3'-0"	7'-0"	1 3/4"	FG3	EXIST	EXIST				NEW HALF UTE RELITE KIT
113	3'-0"	7'-0"	1 3/4"	FG3	EXIST	EXIST				NEW HALF UTE RELITE KIT
114	3'-0"	7'-0"	1 3/4"	FG3	EXIST	EXIST				NEW HALF UTE RELITE KIT
115	3'-0"	7'-0"	1 3/4"	FG3	EXIST	EXIST				NEW HALF UTE RELITE KIT
116	3'-0"	7'-0"	1 3/4"	FG4	SCWD	MATCH (E) WOOD	HM	PAINT		
117	3'-0"	7'-0"	1 3/4"	FG3	EXIST	EXIST				NEW HALF UTE RELITE KIT
118	3'-0"	7'-0"	1 3/4"	FG3	EXIST	EXIST				NEW HALF UTE RELITE KIT
119	3'-0"	7'-0"	1 3/4"	FG3	EXIST	EXIST				NEW HALF UTE RELITE KIT
120	3'-0"	7'-0"	1 3/4"	FG3	EXIST	EXIST				NEW HALF UTE RELITE KIT
121	3'-0"	7'-0"	1 3/4"	FG4	SCWD	MATCH (E) WOOD	HM	PAINT		
122	3'-0"	7'-0"	1 3/4"	F	EXIST	EXIST				
123	3'-0"	7'-0"	1 3/4"	FG5	EXIST	EXIST				NEW HALF UTE RELITE KIT
125	3'-0"	7'-0"	1 3/4"	FG3	EXIST	EXIST				NEW HALF UTE RELITE KIT
126	3'-0"	7'-0"	1 3/4"	FG3	EXIST	EXIST				NEW HALF UTE RELITE KIT
127	3'-0"	7'-0"	1 3/4"	FG3	EXIST	EXIST				NEW HALF UTE RELITE KIT
128A	3'-0"	7'-0"	1 3/4"	FG4	EXIST	EXIST				NEW HALF UTE RELITE KIT
128B	3'-0"	7'-0"	1 3/4"	F	EXIST	EXIST				
129A	3'-0"	7'-0"	1 3/4"	FG4	SCWD	MATCH (E) WOOD	HM	PAINT		
129B	3'-0"	7'-0"	1 3/4"	FG4	SCWD	MATCH (E) WOOD	HM	PAINT		
130	3'-0"	7'-0"	1 3/4"	FG5	EXIST	EXIST				ACCESS CONTROLLED DOOR WITH CARD READER AND ELECTRIFIED HARDWARE
131	3'-0"	7'-0"	1 3/4"	F	EXIST	EXIST				
132	3'-0"	7'-0"	1 3/4"	F	EXIST	EXIST				ACCESS CONTROLLED DOOR WITH CARD READER AND ELECTRIFIED HARDWARE
133	3'-0"	7'-0"	1 3/4"	F	EXIST	EXIST				
135	3'-0"	7'-0"	1 3/4"	F	EXIST	EXIST				
136	3'-0"	7'-0"	1 3/4"	F	EXIST	EXIST				
137	3'-0"	7'-0"	1 3/4"	F	EXIST	EXIST				
138A	3'-0"	7'-0"	1 3/4"	F	EXIST	EXIST				
138B	3'-0"	7'-0"	1 3/4"	F	EXIST	EXIST				
139	3'-0"	7'-0"	1 3/4"	F	EXIST	EXIST				
140	3'-0"	7'-0"	1 3/4"	F	EXIST	EXIST				
141	3'-0"	7'-0"	1 3/4"	F	EXIST	EXIST				
142	6'-0"	7'-0"	1 3/4"	FF	EXIST	EXIST				
143A	3'-0"	7'-0"	1 3/4"	F	EXIST	EXIST				
144A	3'-0"	7'-0"	1 3/4"	F	SCWD	MATCH (E) WOOD	HM	PAINT		
144B	3'-0"	7'-0"	1 3/4"	F	SCWD	MATCH (E) WOOD	HM	PAINT		
144C	3'-0"	7'-0"	1 3/4"	F	SCWD	MATCH (E) WOOD	HM	PAINT		ACCESS CONTROLLED DOOR WITH CARD READER AND ELECTRIFIED HARDWARE
145A	5'-0"	7'-0"	1 3/4"	FF	EXIST	EXIST				ACCESS CONTROLLED DOOR WITH CARD READER AND ELECTRIFIED HARDWARE
145B	6'-0"	7'-0"	1 3/4"	FF	EXIST	EXIST				SALVAGED DOORS FROM DEMO ROOM 146, ACCESS CONTROLLED DOOR WITH CARD READER AND ELECTRIFIED HARDWARE
147	3'-0"	7'-0"	1 3/4"	F	EXIST	EXIST				
200	6'-0"	7'-0"	1 3/4"	SF FFG	EXIST	EXIST				ACCESS CONTROLLED DOOR WITH CARD READER AND ELECTRIFIED HARDWARE
201	6'-0"	7'-0"	1 3/4"	SF FFG	EXIST	EXIST				ACCESS CONTROLLED DOOR WITH CARD READER AND ELECTRIFIED HARDWARE
202	3'-0"	7'-0"	1 3/4"	F	EXIST	PAINT				
203	3'-0"	7'-0"	1 3/4"	FG2	SCWD	PAINT	HM	PAINT		ACCESS CONTROLLED DOOR WITH CARD READER AND ELECTRIFIED HARDWARE
204A	3'-0"	7'-0"	1 3/4"	F	EXIST	PAINT				
204B	3'-0"	7'-0"	1 3/4"	F	EXIST	PAINT				
205	3'-0"	7'-0"	1 3/4"	FG2	EXIST	PAINT				
207	5'-0"	7'-0"	1 3/4"	FF	EXIST	PAINT				
208A	3'-0"	7'-0"	1 3/4"	F	EXIST	PAINT				
208B	3'-0"	7'-0"	1 3/4"	F	EXIST	PAINT				
209	3'-0"	7'-0"	1 3/4"	F	EXIST	PAINT				
211	3'-0"	7'-0"	1 3/4"	FG2	SCWD	PAINT	HM	PAINT		ACCESS CONTROLLED DOOR WITH CARD READER AND ELECTRIFIED HARDWARE
212	3'-0"	7'-0"	1 3/4"	FG2	SCWD	PAINT	HM	PAINT		ACCESS CONTROLLED DOOR WITH CARD READER AND ELECTRIFIED HARDWARE
214A	6'-0"	7'-0"	1 3/4"	FFG2	EXIST	PAINT				
214B	3'-0"	7'-0"	1 3/4"	F	EXIST	PAINT				
215	3'-0"	7'-0"	1 3/4"	FG3	SCWD	PAINT				
217	3'-0"	7'-0"	1 3/4"	FG3	SCWD	PAINT				
219	3'-0"	7'-0"	1 3/4"	FG3	SCWD	PAINT				
220	3'-0"	7'-0"	1 3/4"	FG2	EXIST	PAINT				
221	3'-0"	7'-0"	1 3/4"	FG3	SCWD	PAINT	HM	PAINT		
222A	3'-0"	7'-0"	1 3/4"	FG3	SCWD	PAINT	HM	PAINT		
223	3'-0"	7'-0"	1 3/4"	F	EXIST	PAINT	EXIST	PAINT		

NUMBER	Door Schedule									
	WIDTH	HEIGHT	THICKNESS	DOOR TYPE	DOOR MATERIAL	DOOR FINISH	FRAME MATERIAL	FRAME FINISH	HARDWARE GROUP	COMMENTS
224	3'-0"	7'-0"	1 3/4"	F	EXIST	PAINT	SCWD	PAINT		ACCESS CONTROLLED DOOR WITH CARD READER AND ELECTRIFIED HARDWARE EACH SIDE
225	3'-0"	7'-0"	1 3/4"	F	EXIST	PAINT	SCWD	PAINT		
226	3'-0"	7'-0"	1 3/4"	FG3	SCWD	PAINT	SCWD	PAINT		
228	3									

LRHC Flooring Memorandum

Final Audit Report

2025-03-17

Created:	2025-03-17
By:	Jennifer Johnson (JJohnson@clackamas.us)
Status:	Signed
Transaction ID:	CBJCHBCAABAAPdtUe0XHKuKNV75ebIwh9G6ojNyGJ9L8

"LRHC Flooring Memorandum" History

-  Document created by Jennifer Johnson (JJohnson@clackamas.us)
2025-03-17 - 5:14:53 PM GMT- IP address: 24.20.34.210
-  Document emailed to Elizabeth Comfort (ecomfort@clackamas.us) for signature
2025-03-17 - 5:15:12 PM GMT
-  Email viewed by Elizabeth Comfort (ecomfort@clackamas.us)
2025-03-17 - 7:21:16 PM GMT- IP address: 198.245.132.3
-  Document e-signed by Elizabeth Comfort (ecomfort@clackamas.us)
Signature Date: 2025-03-17 - 7:21:36 PM GMT - Time Source: server- IP address: 198.245.132.3
-  Agreement completed.
2025-03-17 - 7:21:36 PM GMT



Adobe Acrobat Sign